
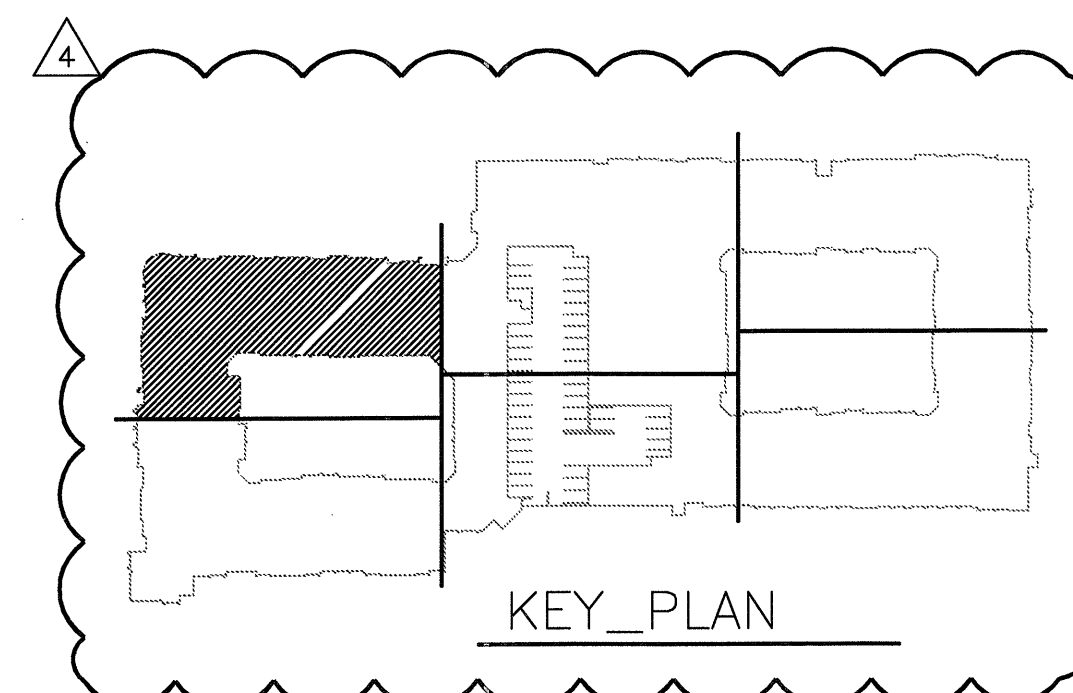


REVISIONS	
1	9-2-2011 DESIGN REVISIONS
2	9-13-2011 ANSI/FHA COMMENTS
3	9-23-2011 DESIGN REVISIONS
4	10-17-2011 CONSTRUCTION ISSUE

# KELLER SPRINGS LOFTS

LOFT APARTMENTS IN ADDISON, TEXAS

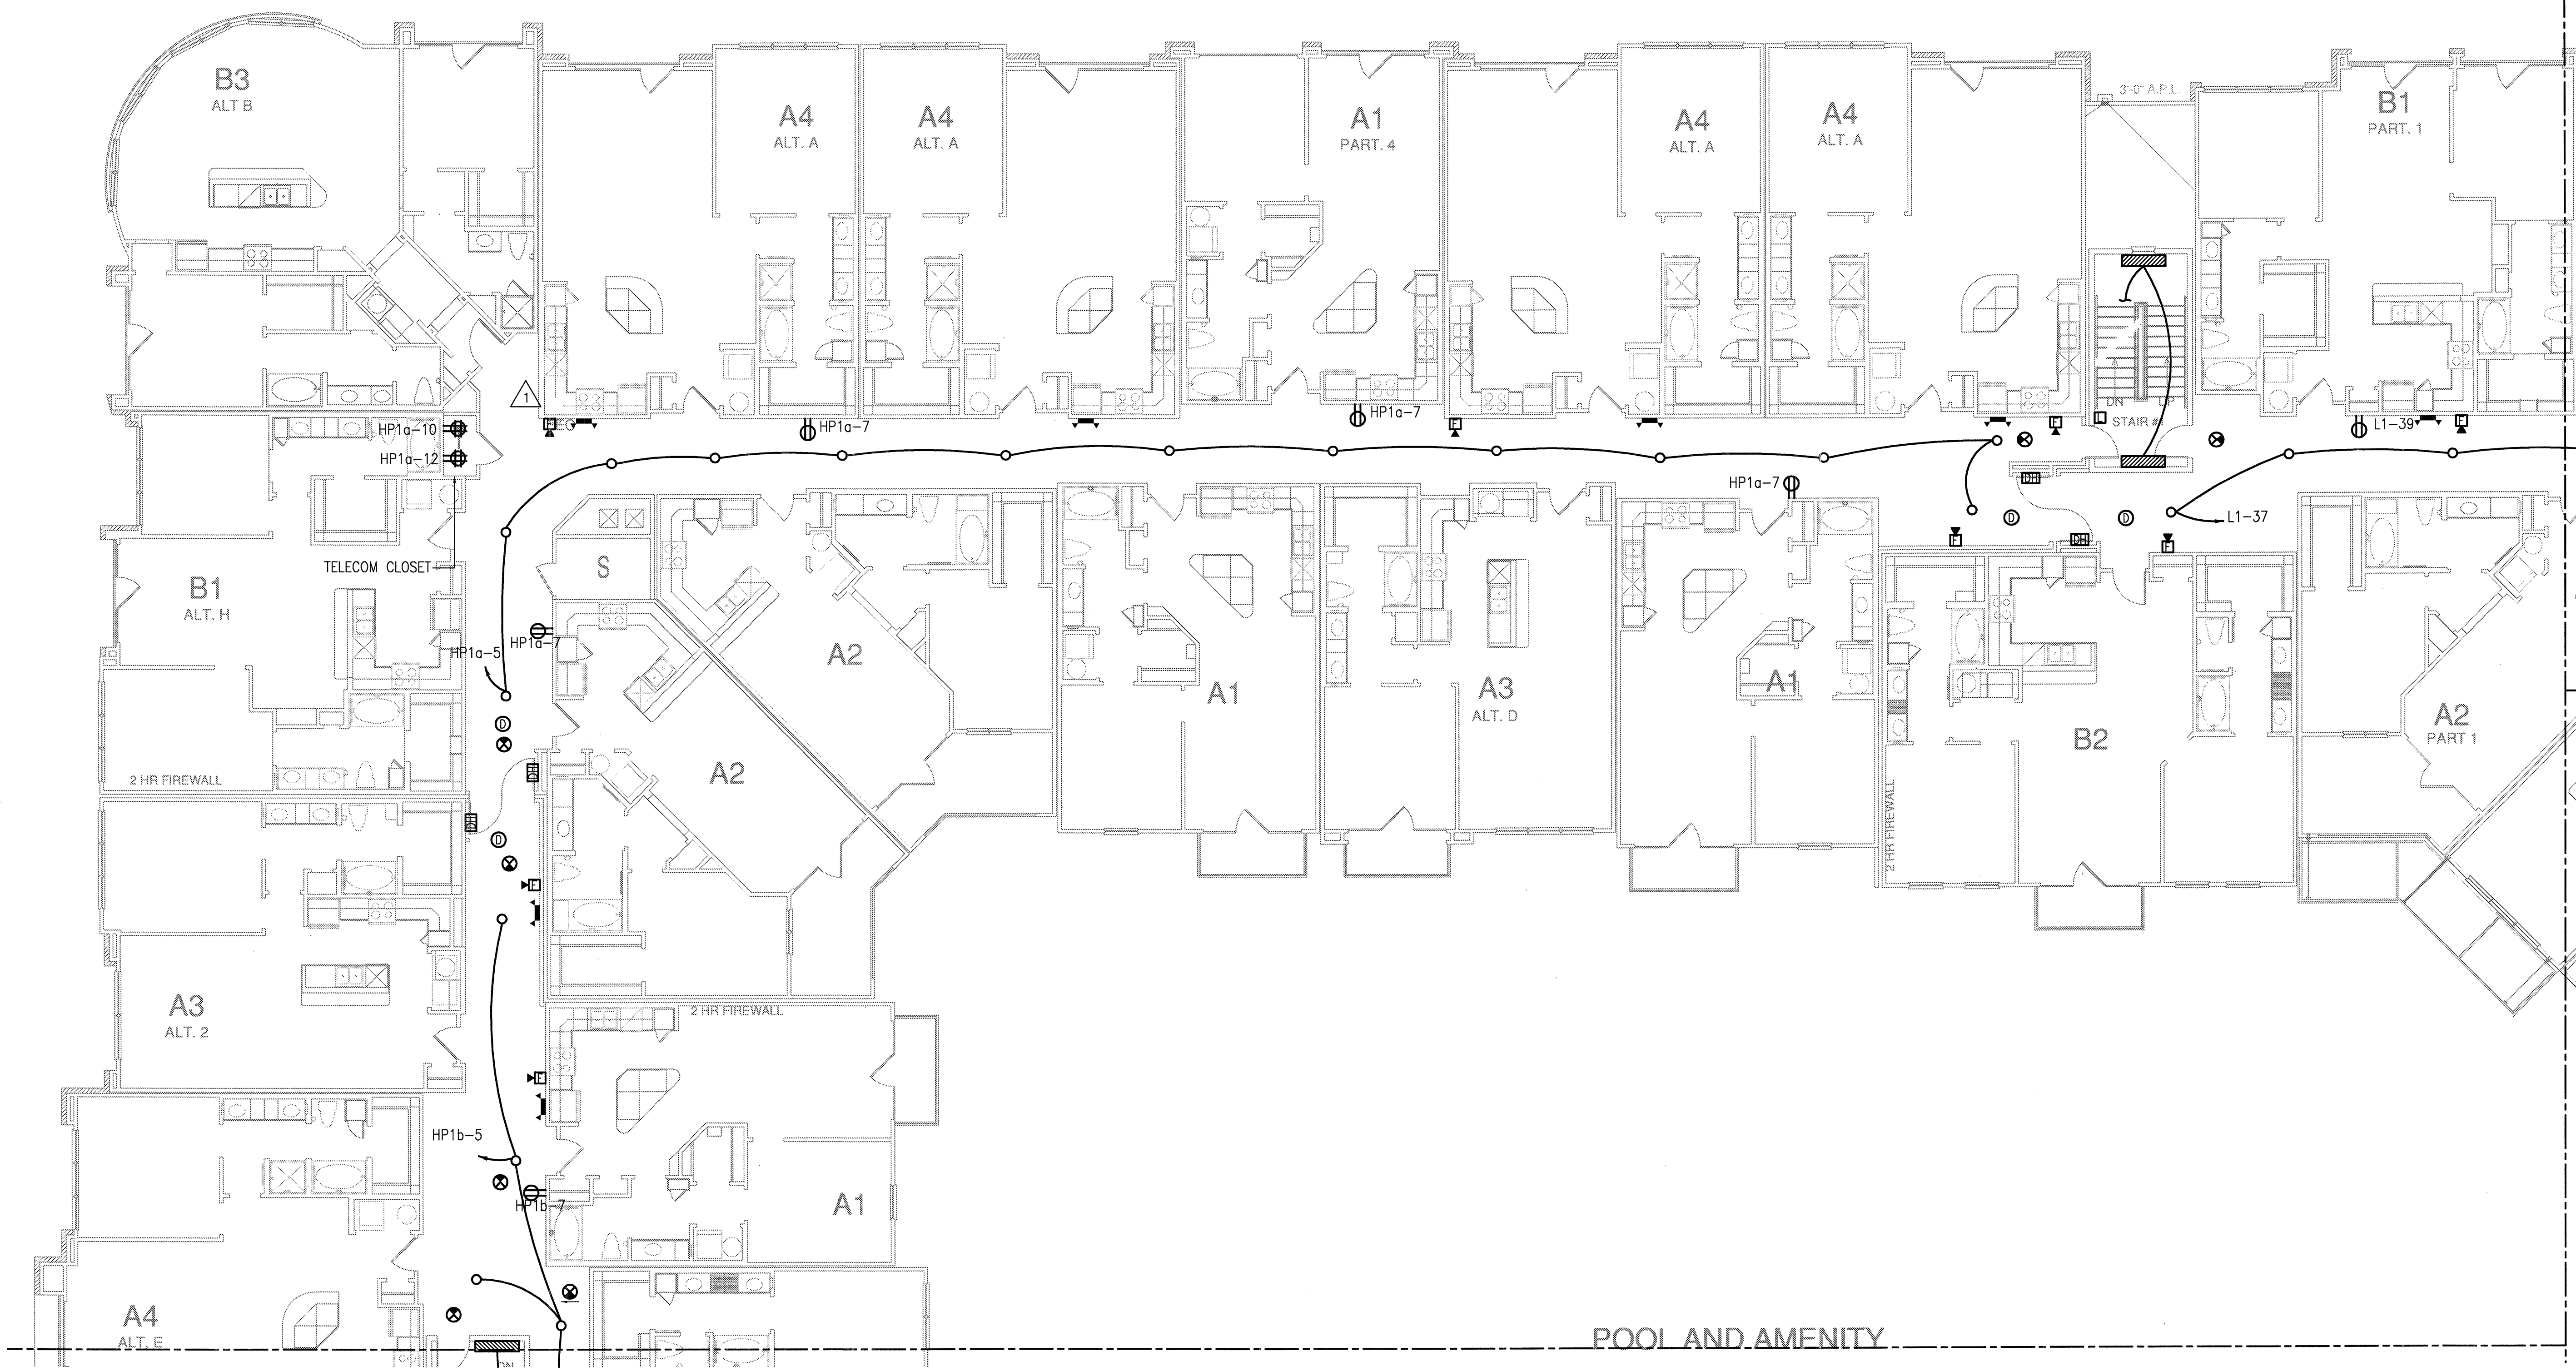

1 DIVISION 'A' SECOND FLOOR PLAN  
SCALE: 1/8" = 1'-0"

**JSE** Jordan & Skala Engineers  
14210 Midway Road, Suite 570  
Dallas, TX 75244-5138  
Project Number - 113-0355 Texas Firm Registration # F-4990  
Drawn By: MJ Checked By: RAD

**BGO** architects  
4144 N. Central Expy.  
Suite 855  
Dallas, TX 75204  
214.520.8878  
bgoarchitects.com

DATE	08-05-11
PROJECT	11129
SHEET NUMBER	<b>E-3.2A</b>