

REVISIONS

1	9-2-2011	DESIGN REVISIONS
2	9-13-2011	ANSI/FHA COMMENTS
3	9-23-2011	DESIGN REVISIONS
4	10-17-2011	CONSTRUCTION ISSUE

**KELLER SPRINGS LOFTS**  
 LOFT APARTMENTS IN ADDISON, TEXAS


**BGO architects**  
 4144 N. Central Exp., Suite 855  
 Dallas, TX 75204  
 214.520.8878  
 bgoarchitects.com

DATE  
 08-05-11


PROJECT  
 11129

SHEET NUMBER

**E-3.2F**

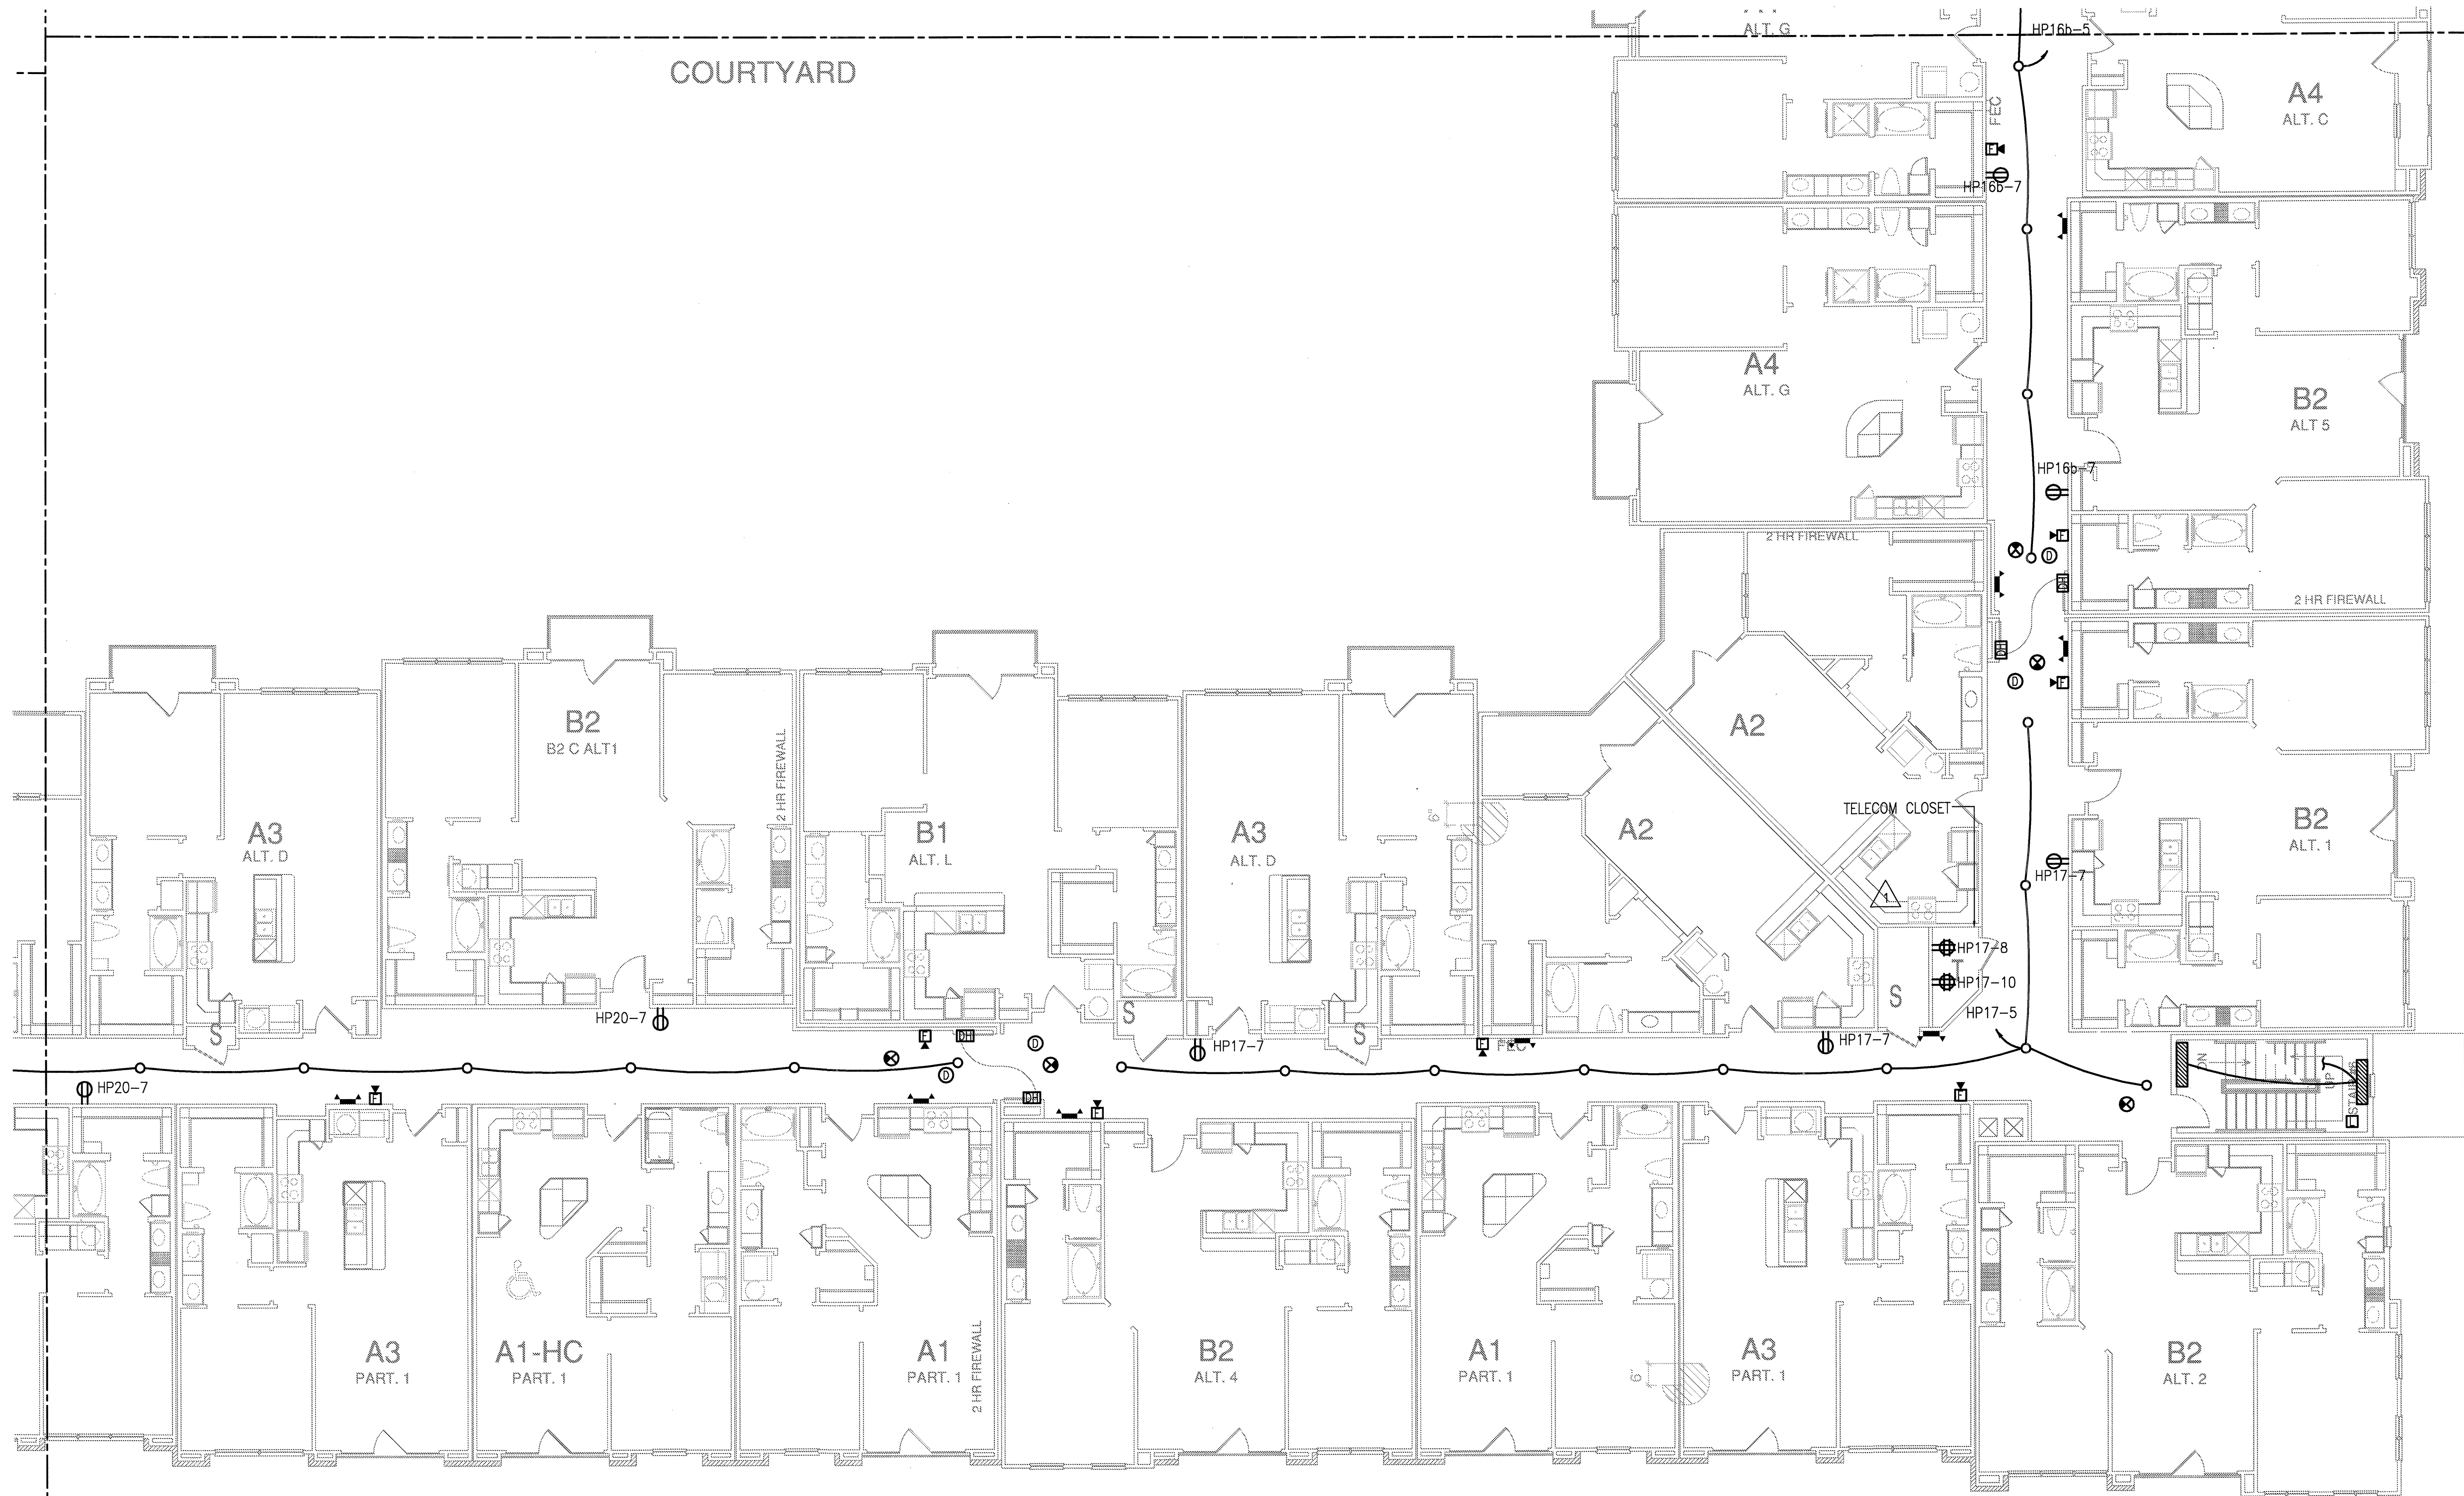

GENERAL NOTES:

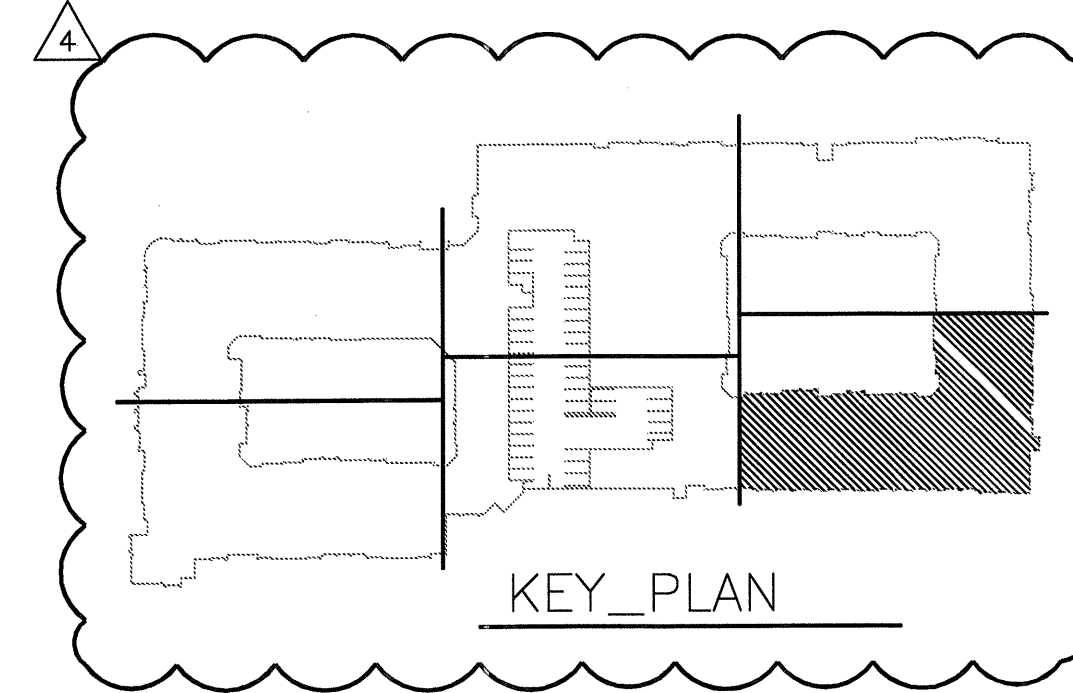

1 DIVISION 'F' SECOND FLOOR PLAN  
 SCALE: 1/8" = 1'-0"

**JSE** Jordan & Skala Engineers  
 14240 Midway Road, Suite 350  
 Dallas, TX 75244-5139  
 Project Number - 113-0355 Texas Firm Registration # F-4990  
 Drawn By: MJ Checked By: RAD