


REVISIONS

1	9-2-2011	DESIGN REVISIONS
2	9-13-2011	ANSI/FHA COMMENTS
3	9-23-2011	DESIGN REVISIONS
4	10-17-2011	CONSTRUCTION ISSUE

KELLER SPRINGS LOFTS

LOFT APARTMENTS IN ADDISON, TEXAS

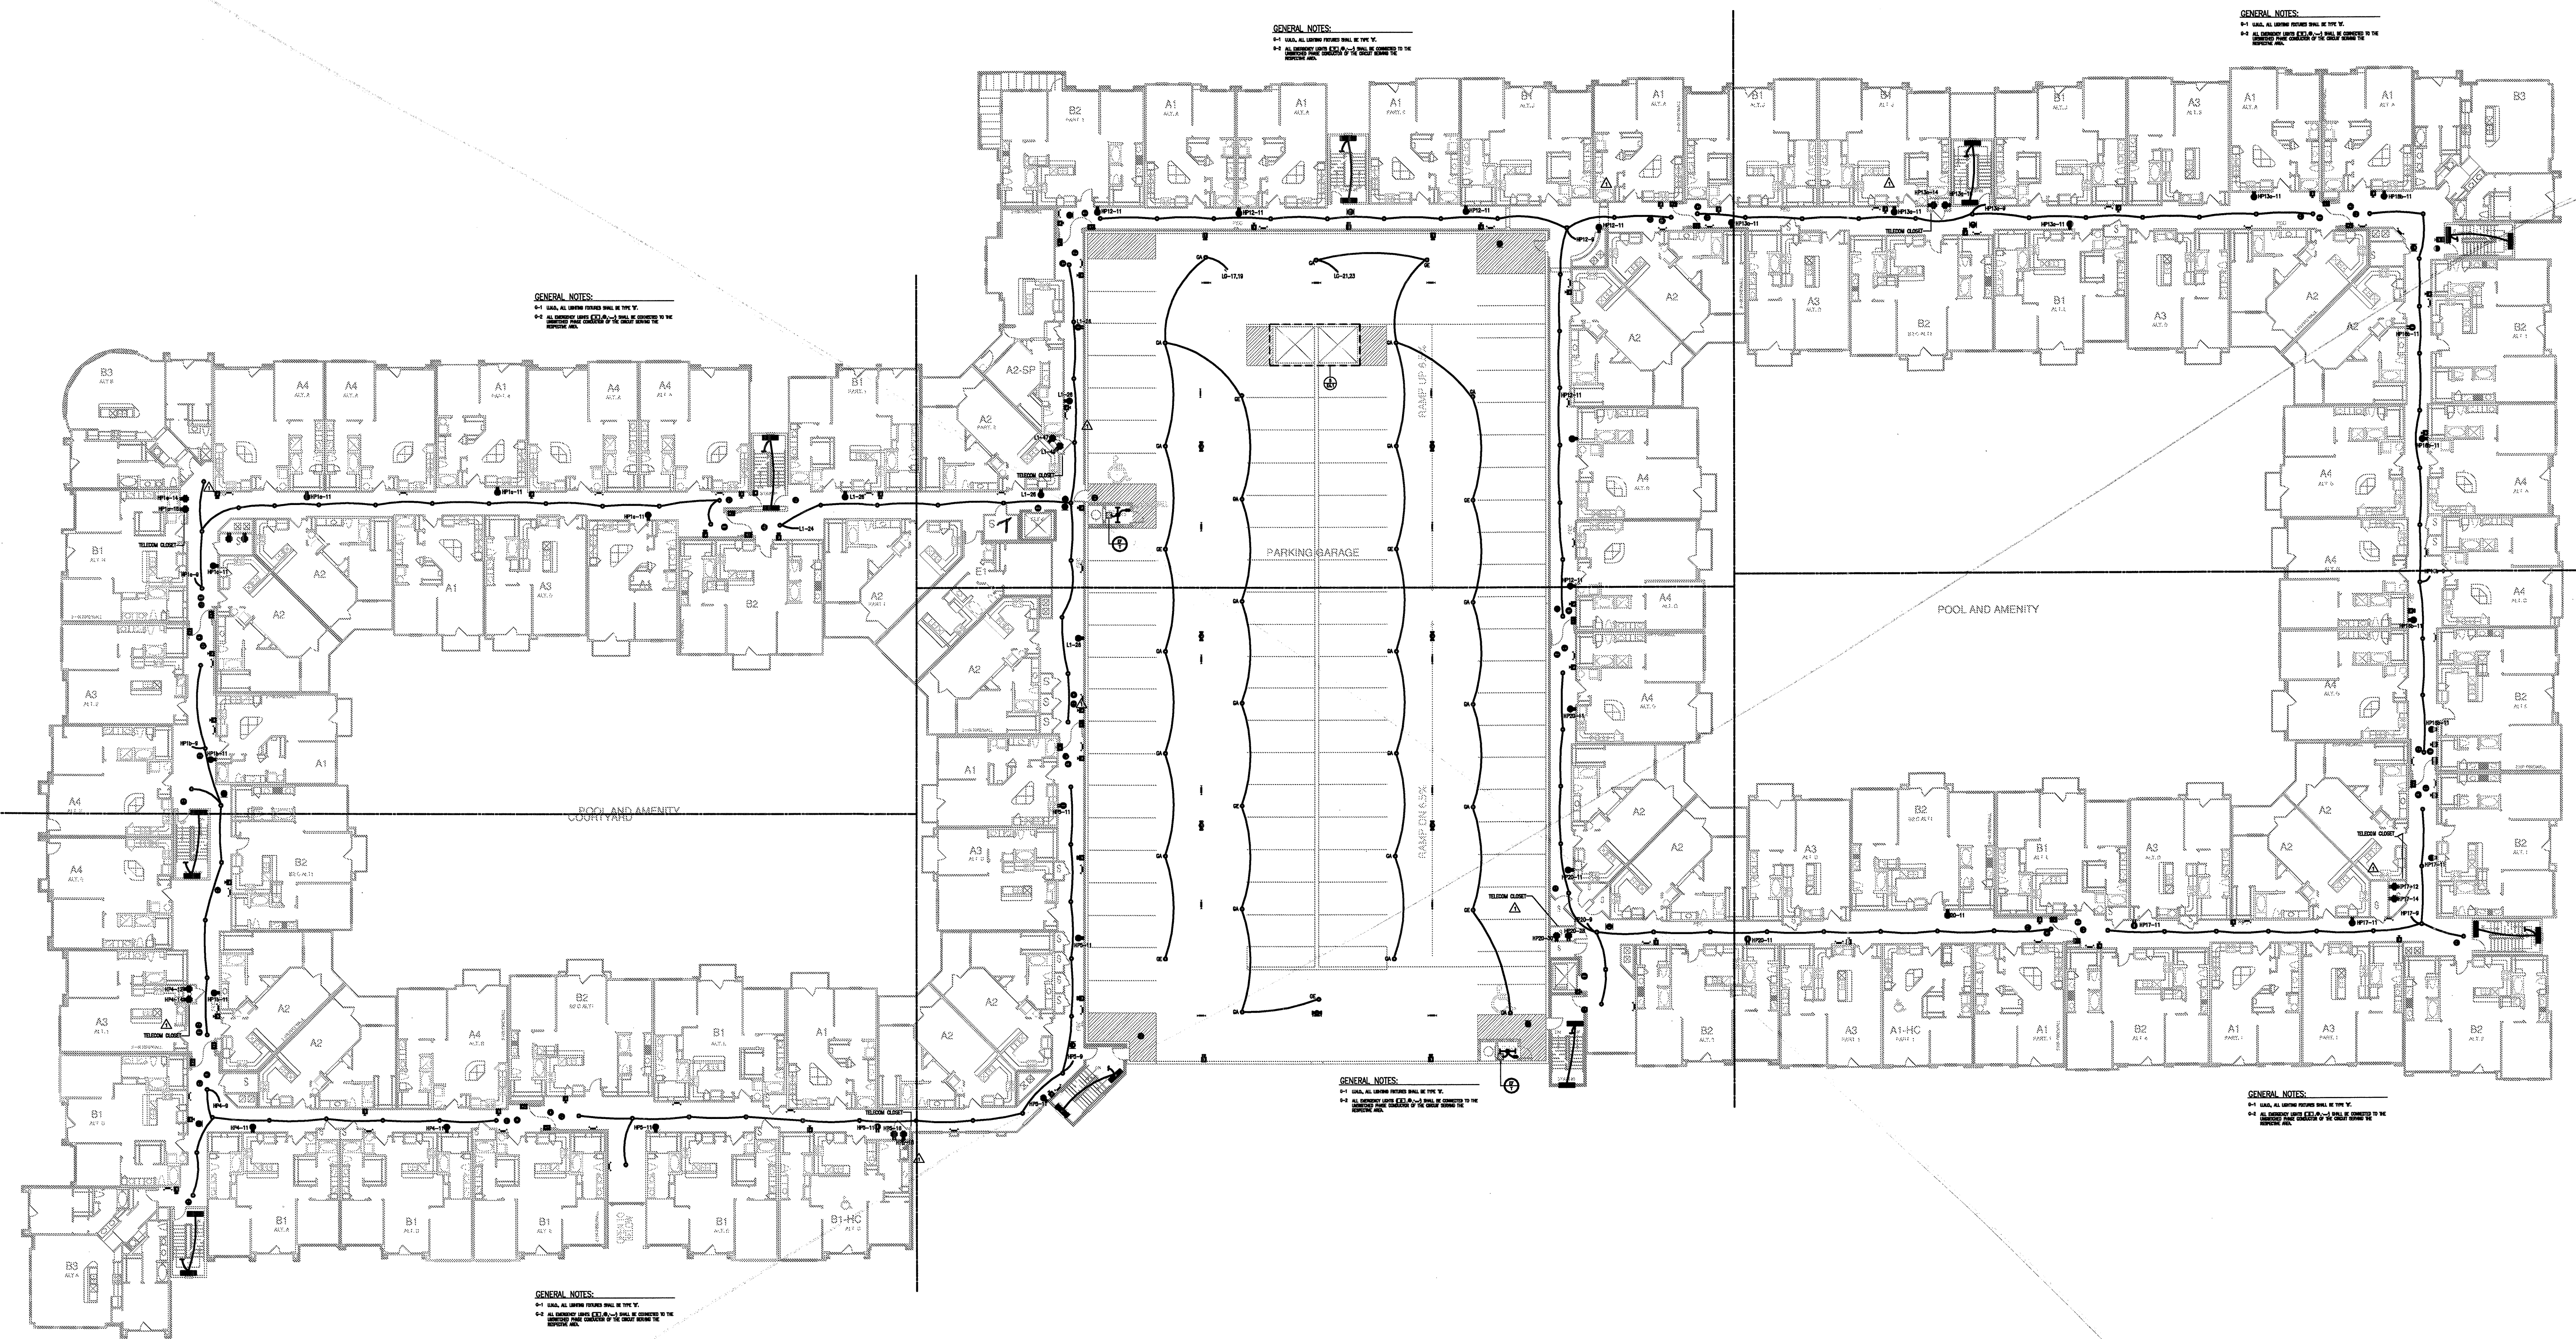

1 FLOOR PLAN - 3-3
SCALE: 1/32" = 1'-0"

BGO
architects

4144 N. Central Expy.
Suite 855
Dallas, TX 75204
214.520.8878
bgoarchitects.com

DATE
08-05-11

PROJECT
11129

SHEET NUMBER

E-3.3

JSE Jordan & Skala Engineers

14240 Midway Road, Suite 350
Dallas, TX 75244-5138
Phone: 972-161-9100 Fax: 972-161-9110
Project Number - 113-0355 Texas Firm Registration # F-4990
Drawn By: MJ Checked By: RAD