


| REVISIONS | |
|-----------|-------------------------------|
| 1 | 9-2-2011 DESIGN REVISIONS |
| 2 | 9-13-2011 ANSI/FHA COMMENTS |
| 3 | 9-23-2011 DESIGN REVISIONS |
| 4 | 10-17-2011 CONSTRUCTION ISSUE |

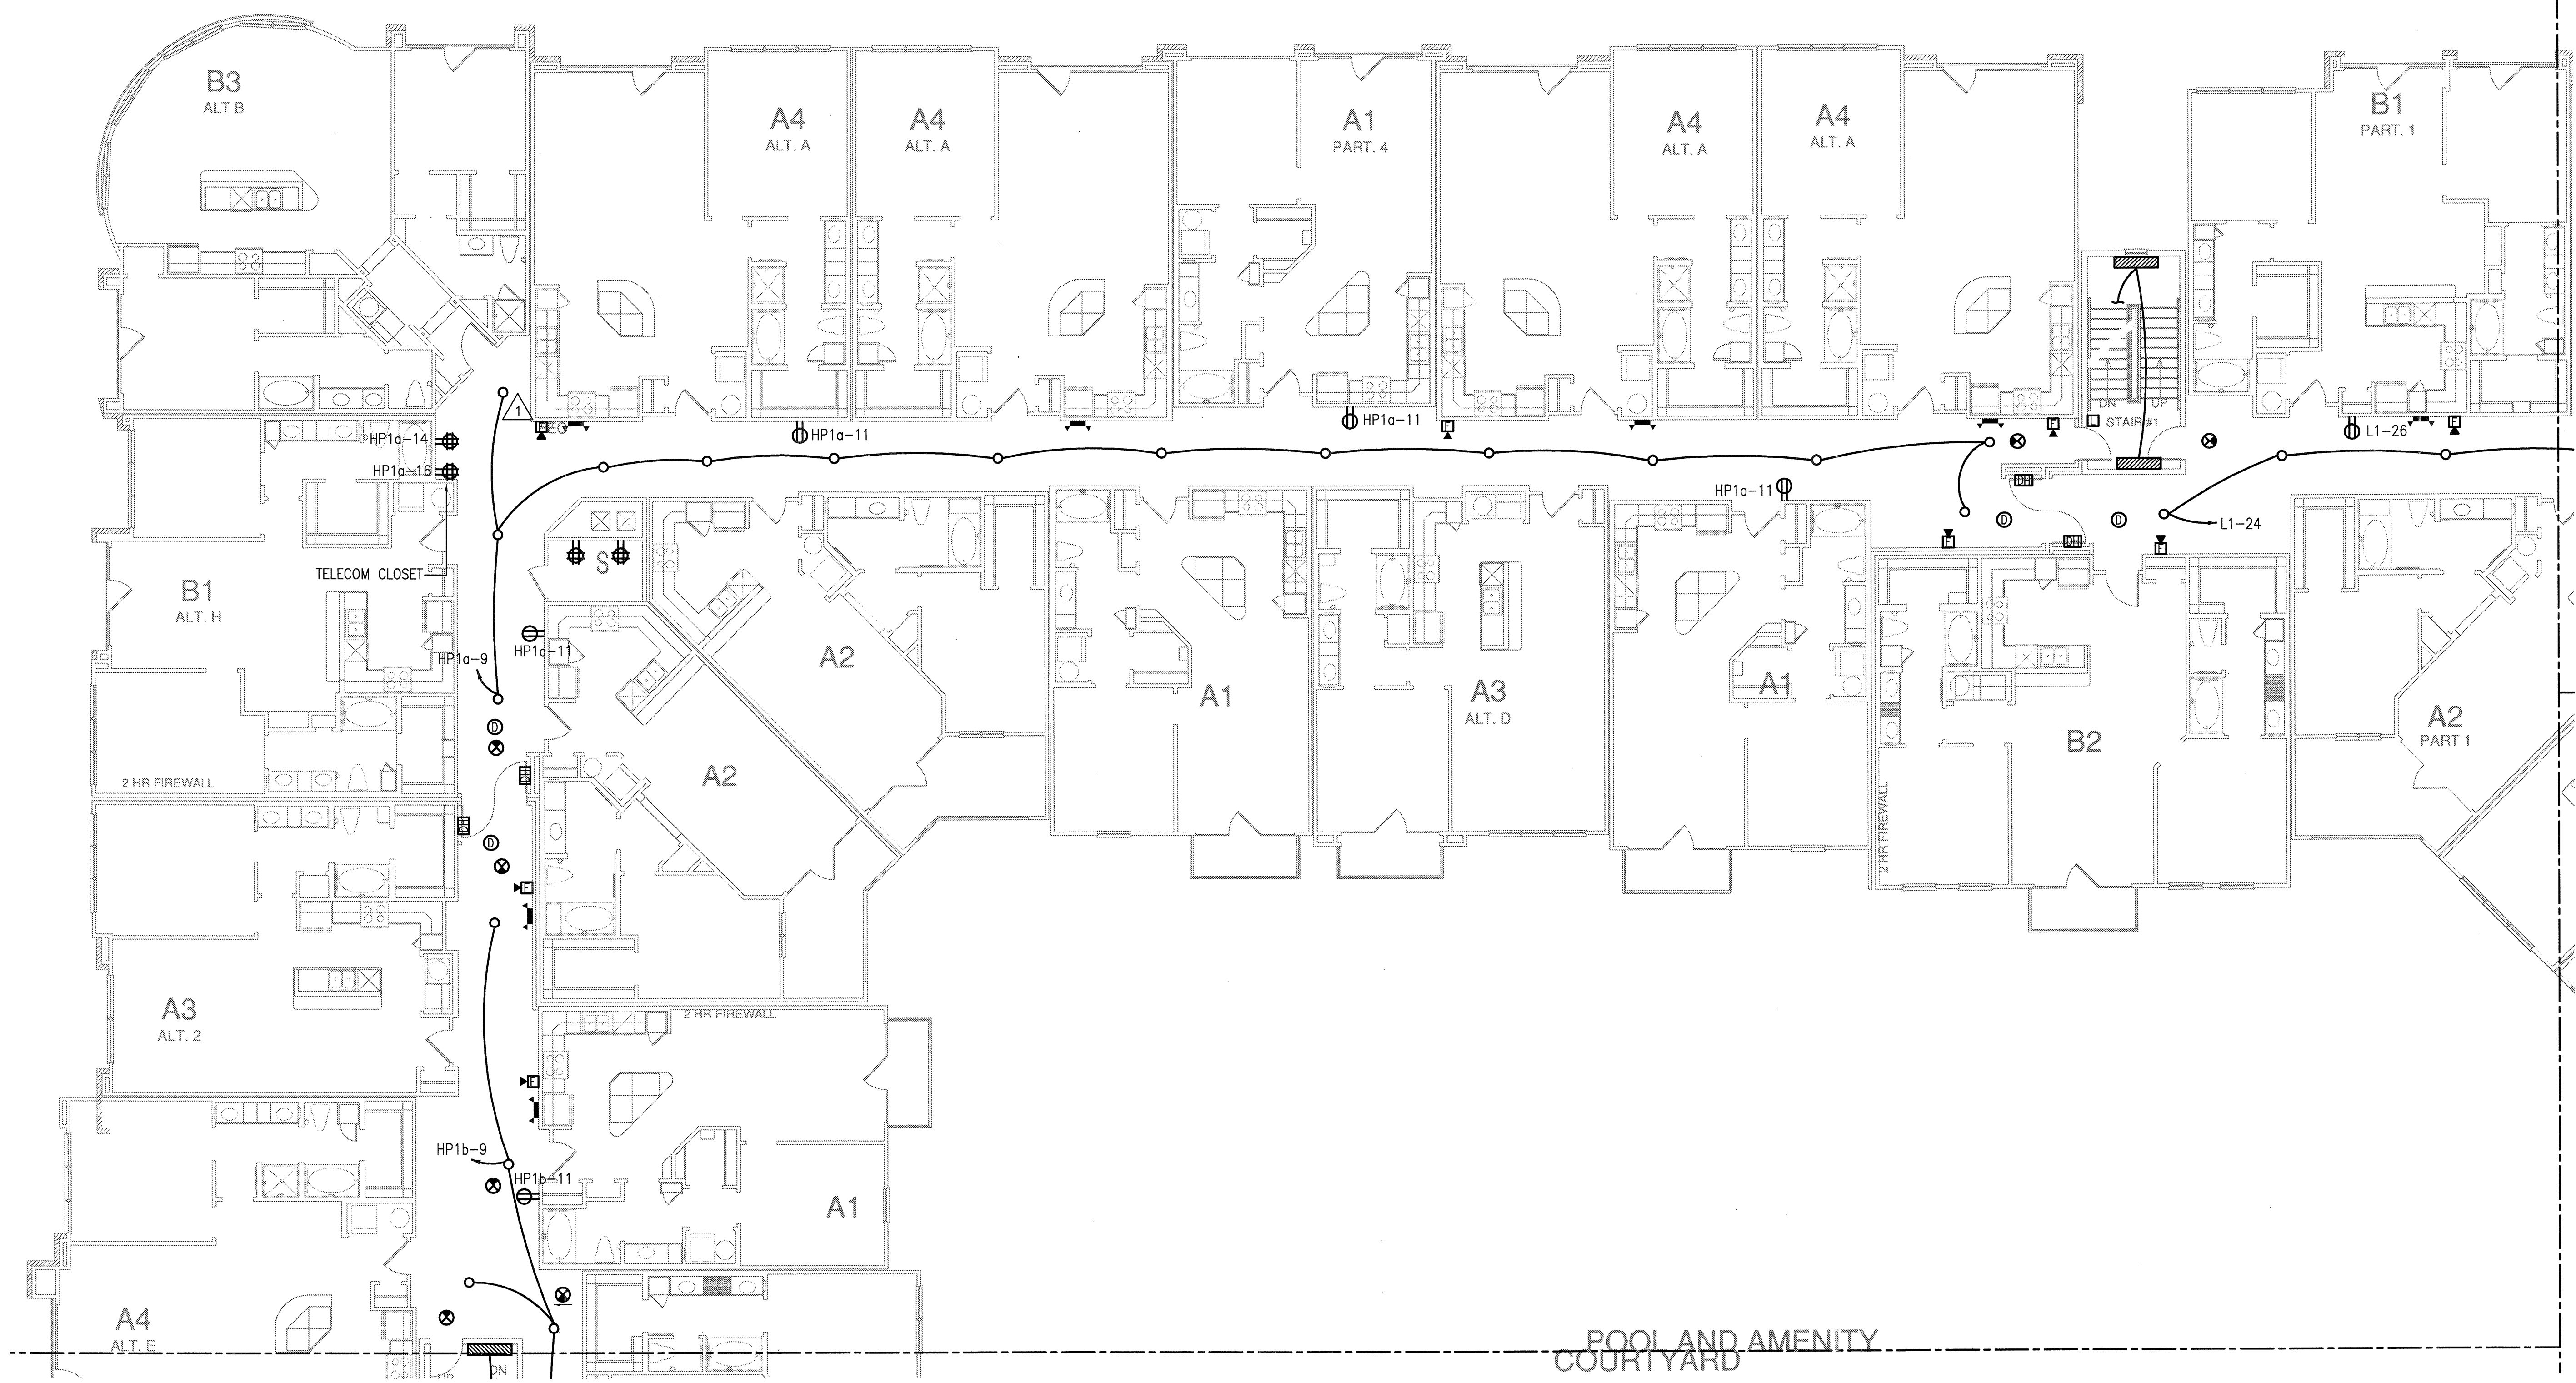

KELLER SPRINGS LOFTS
 LOFT APARTMENTS IN ADDISON, TEXAS


BGO
architects
 4144 N. Central Expy.
 Suite 855
 Dallas, TX 75204
 214.520.8878
 bgoarchitects.com

DATE
 08-05-11

PROJECT
 11129

SHEET NUMBER

E-3.3A

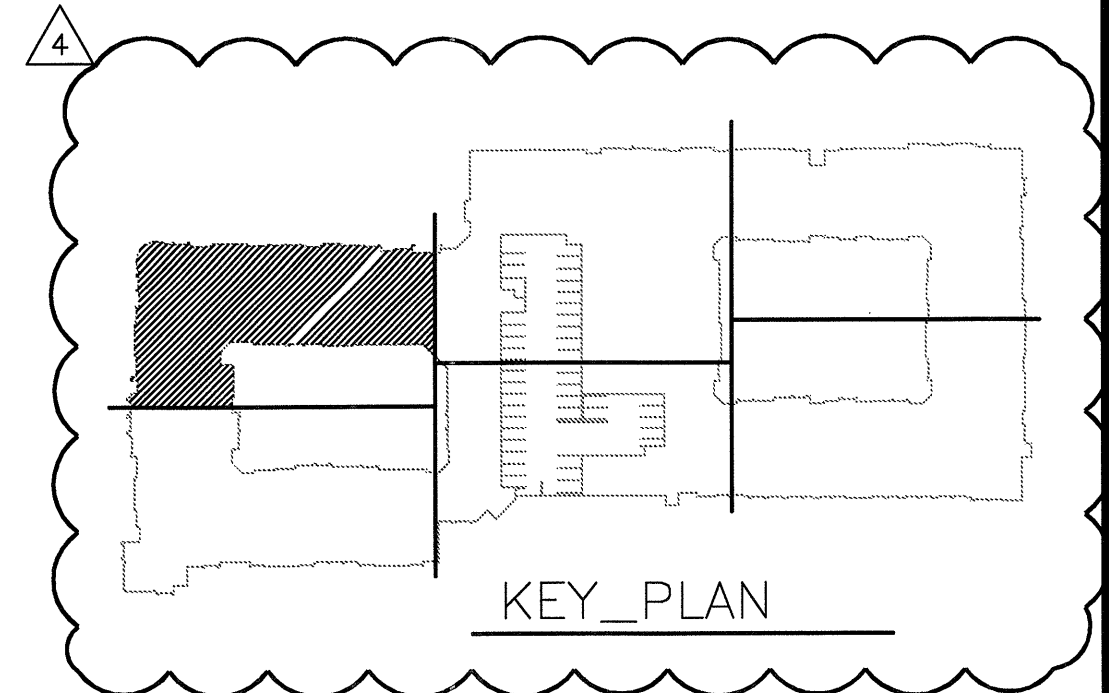

JSE Jordan & Skala Engineers
 14240 Midway Road, Suite 350
 Dallas, TX 75244-2138
 V: 646.938.1615 F: 646.938.1615
 Project Number - 113-0355 Texas Firm Registration # F-4990
 Drawn By: MJ Checked By: RAD

1 DIVISION 'A' THIRD FLOOR PLAN
 SCALE: 1/8" = 1'-0"