


**GENERAL NOTES:**

- G-1 U.N.O., ALL LIGHTING FIXTURES SHALL BE TYPE 'B'.
- G-2 ALL EMERGENCY LIGHTS (EL) SHALL BE CONNECTED TO THE UNSWITCHED PHASE CONDUCTOR OF THE CIRCUIT SERVING THE RESPECTIVE AREA.


**KEY NOTES:**

- (1) PROVIDE J-BOX FOR FIRE SENTINEL RELEASE DEVICE TO LOWER DOOR.

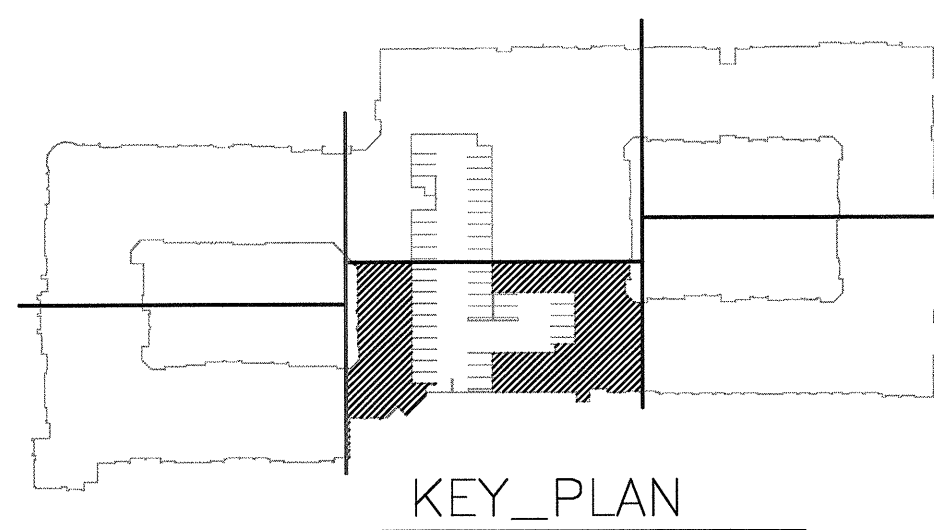

KEY\_PLAN

**1** DIVISION 'D' THIRD FLOOR PLAN  
SCALE: 1/8" = 1'-0"

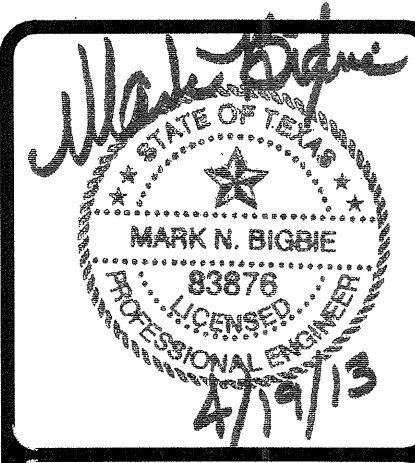

**REVISIONS**

1	9-2-2011	DESIGN REVISIONS
2	9-13-2011	ANSI/FHA COMMENTS
3	9-23-2011	DESIGN REVISIONS
4	10-17-2011	CONSTRUCTION ISSUE
5	12-21-2011	DESIGN REVISIONS
6	1-17-2012	DESIGN REVISIONS
7	2-15-2012	TRANSFORMER REVISIONS
8	3-27-2012	CLUBHOUSE REVISIONS
9	4-17-2012	COORDINATION

**KELLER SPRINGS LOFTS**  
LOFT APARTMENTS IN ADDISON, TEXAS

10	5-15-2012	COORDINATION
11	5-30-2012	SITE COORDINATION
12	6-01-12	LIGHTING REVISIONS
13	6-29-12	SITE COORDINATION
14	9-05-12	CLUB REVISIONS
15	4-19-13	EL, LOBBY REVONS

**BGO architects**  
4144 N. Central Expy.  
Suite 855  
Dallas, TX 75204  
214.520.8878  
bgoarchitects.com

DATE  
08-05-11

PROJECT  
11129

SHEET NUMBER  
**E-3.3D**

**JSE** Jordan & Skala Engineers  
17855 N. Dallas Parkway, Suite 320  
Dallas, TX 75287-6857  
V: (469) 385-1616 F: (469) 385-1615  
Project Number - 113-0355 Texas Firm Registration # F-4990  
Drawn By: MJ Checked By: RAD