


REVISIONS

9-2-2011	DESIGN REVISIONS
9-13-2011	ANSI/FHA COMMENTS
9-23-2011	DESIGN REVISIONS
10-17-2011	CONSTRUCTION ISSUE

# KELLER SPRINGS LOFTS

LOFT APARTMENTS IN ADDISON, TEXAS

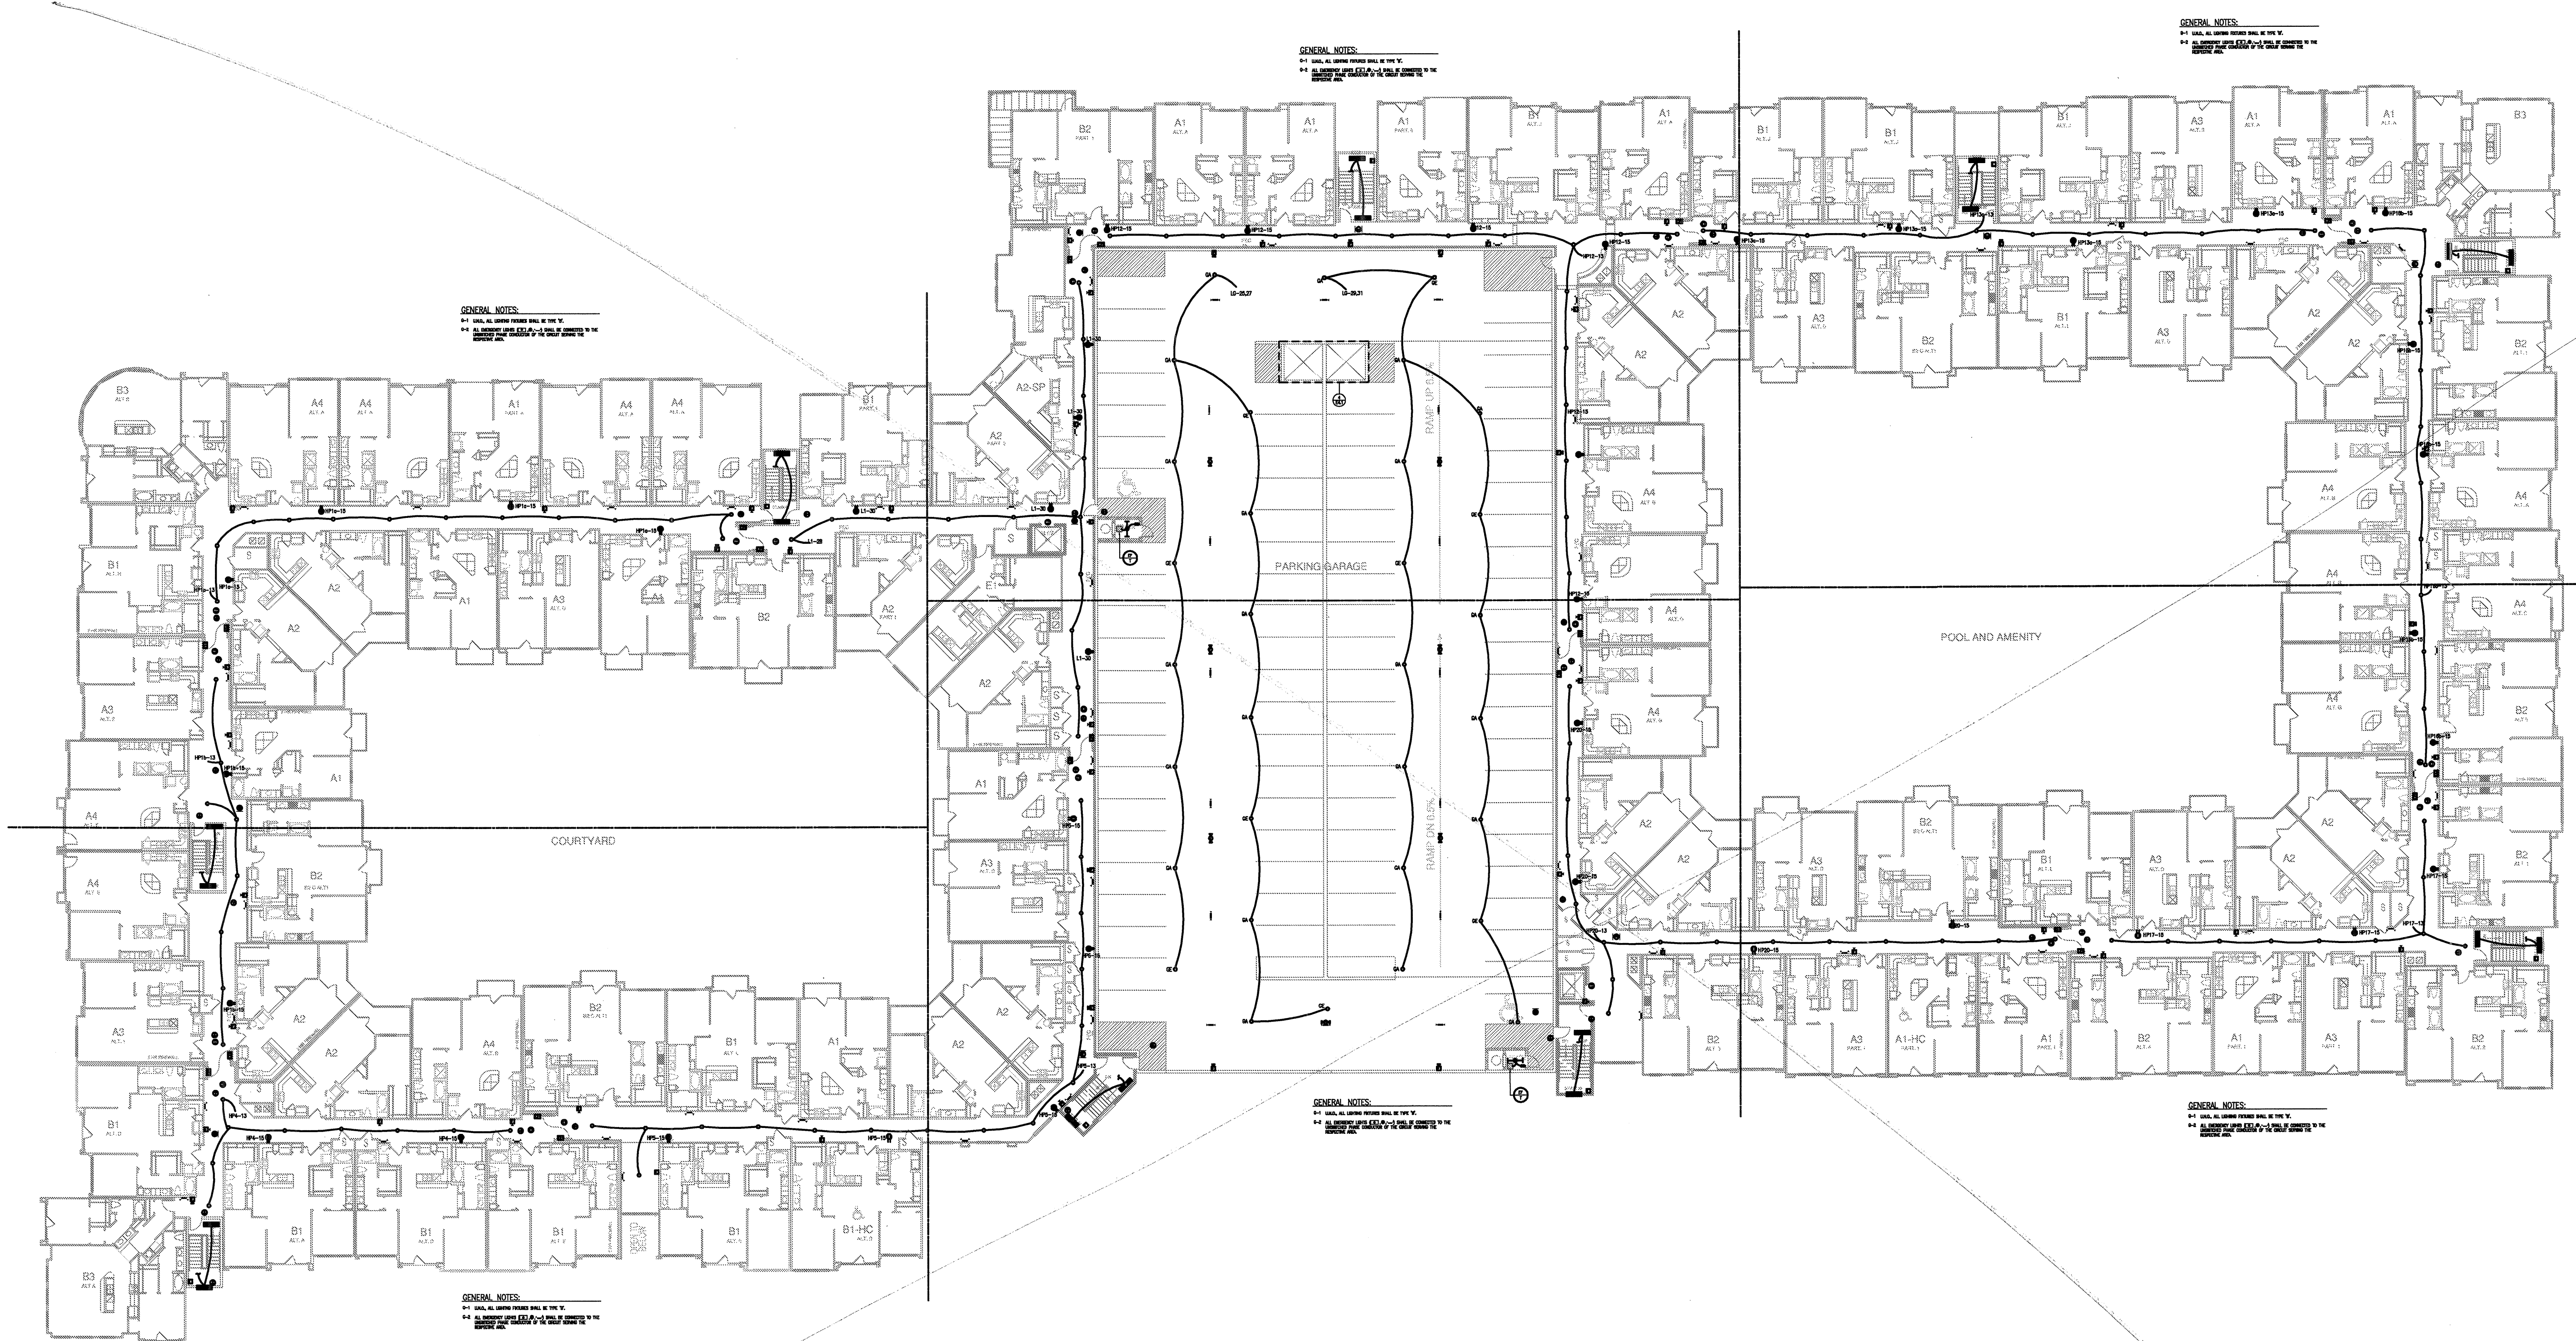

1 FLOOR PLAN - 3-4  
SCALE: 1/32" = 1'-0"

**BGO**  
architects  
4144 N. Central Expy.  
Suite 855  
Dallas, TX 75204  
214.520.8878  
bgoarchitects.com

DATE  
08-05-11

PROJECT  
11129

SHEET NUMBER  
**E-3.4**

**JSE** Jordan & Skala Engineers  
14240 Midway Road, Suite 150  
Dallas, TX 75244-5138  
(469) 382-1616 F: (469) 383-7613  
Project Number - 113-0355 Texas Firm Registration # F-4990  
Drawn By: MJ Checked By: RAD