

REVISIONS	
1	9-2-2011 DESIGN REVISIONS
2	9-13-2011 ANS/FR/A COMMENTS
3	9-23-2011 DESIGN REVISIONS
4	10-17-2011 CONSTRUCTION ISSUE
5	12-21-2011 DESIGN REVISIONS
6	1-17-2012 DESIGN REVISIONS
7	2-15-2012 TRANSFORMER REVISIONS
8	3-27-2012 CLUBHOUSE REVISIONS
9	4-17-2012 COORDINATION

KELLER SPRINGS LOFTS

LOFT APARTMENTS IN ADDISON, TEXAS

10	5-15-2012 COORDINATION
11	5-30-2012 SITE COORDINATION
12	6-01-12 LIGHTING REVISIONS
13	6-29-12 SITE COORDINATION
14	9-05-12 CLUB REVISIONS
15	4-19-13 EL. LOBBY REVISIONS

BGO
architects


4144 N. Central Expy.
Suite 855
Dallas, TX 75204
214.520.8878
bgoarchitects.com

DATE
08-05-11

PROJECT
11129

SHEET NUMBER

E-3.4

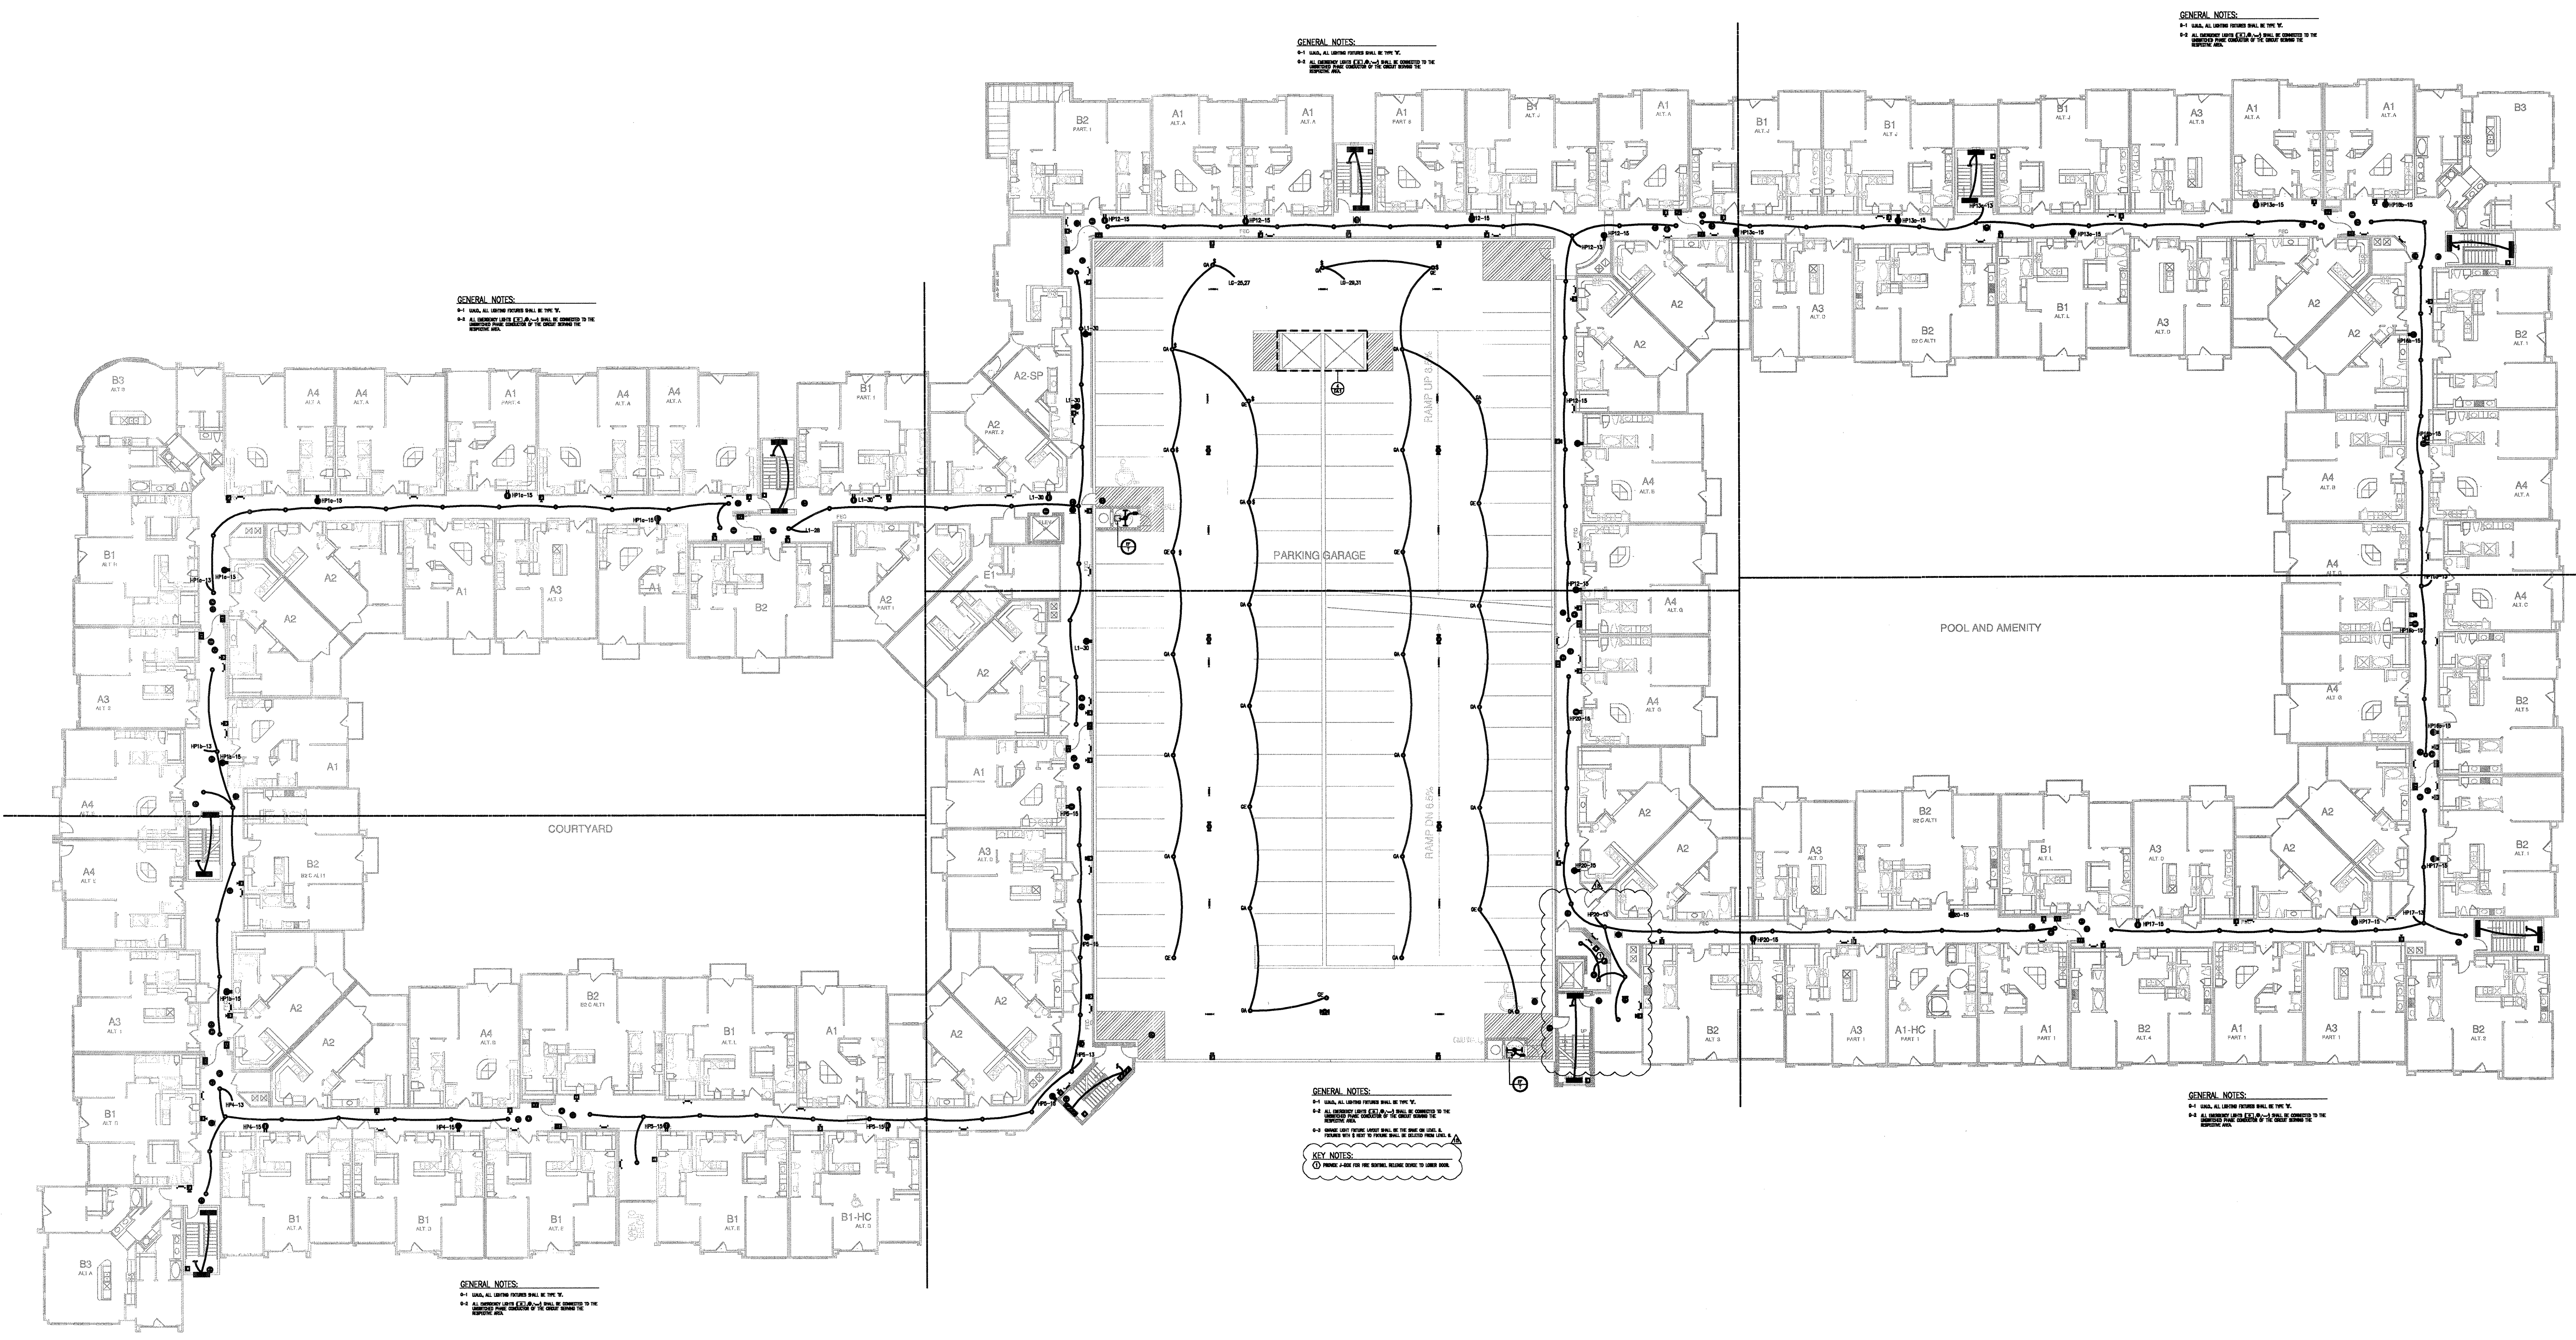

1 FLOOR PLAN - 3-4
SCALE: 1/32" = 1'-0"

JSE Jordan & Skala Engineers

17853 N. Dallas Parkway, Suite 320
Dallas, TX 75287-6857
V: (469) 385-1616 F: (469) 385-1615
Project Number - 113-0355 Texas Firm Registration # F-4990
Drawn By: MJ Checked By: RAD