


GENERAL NOTES:


- G-1 U.N.O., ALL LIGHTING FIXTURES SHALL BE TYPE 'B'.
- G-2 ALL EMERGENCY LIGHTS (S) SHALL BE CONNECTED TO THE UNSWITCHED PHASE CONDUCTOR OF THE CIRCUIT SERVING THE RESPECTIVE AREA.

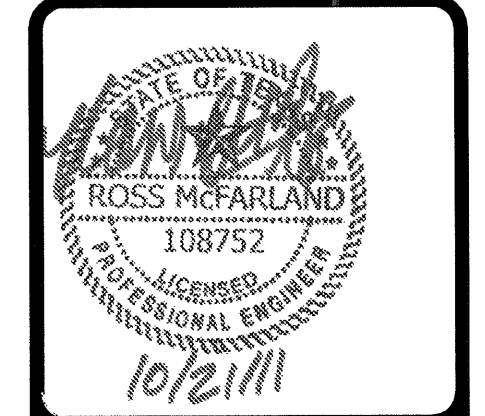

| REVISIONS | |
|-----------|-------------------------------|
| 1 | 9-2-2011 DESIGN REVISIONS |
| 2 | 9-13-2011 ANSI/FHA COMMENTS |
| 3 | 9-23-2011 DESIGN REVISIONS |
| 4 | 10-17-2011 CONSTRUCTION ISSUE |

KELLER SPRINGS LOFTS

LOFT APARTMENTS IN ADDISON, TEXAS

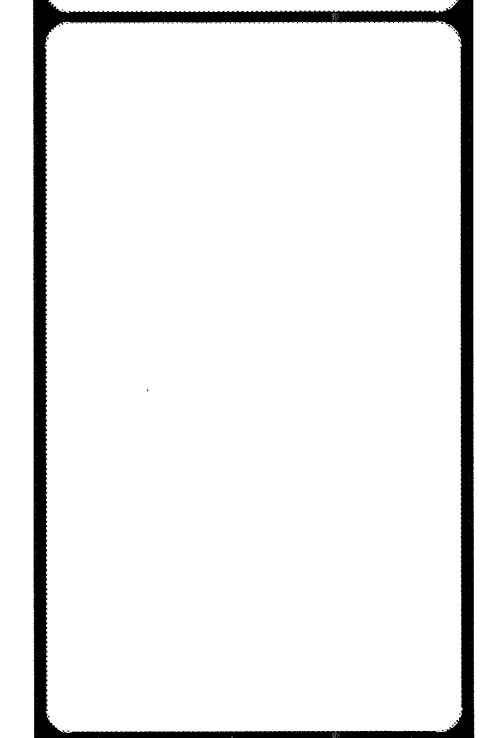


BGO architects
 4144 N. Central Exp.
 Suite 855
 Dallas, TX 75204
 214.520.8878
 bgoarchitects.com

DATE
08-05-11

PROJECT
11129

SHEET NUMBER

E-3.4B

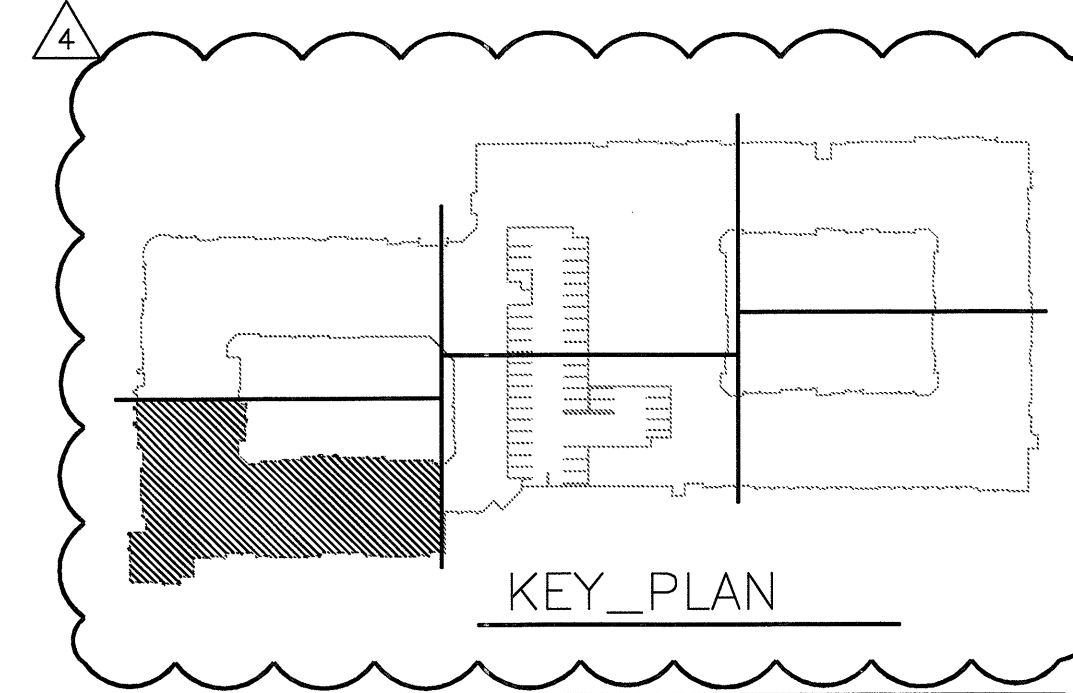

JSE Jordan & Skala Engineers
 14240 Midway Road, Suite 350
 Dallas, TX 75244-5130
 V: (469) 383-1616 F: (469) 383-1613
 Project Number - 113-0355 Texas Firm Registration # F-4990
 Drawn By: MJ Checked By: RAD