


REVISIONS	
△ 9-2-2011	DESIGN REVISIONS
△ 9-13-2011	ANSI/FHA COMMENTS
△ 9-23-2011	DESIGN REVISIONS
△ 10-17-2011	CONSTRUCTION ISSUE

KELLER SPRINGS LOFTS

LOFT APARTMENTS IN ADDISON, TEXAS

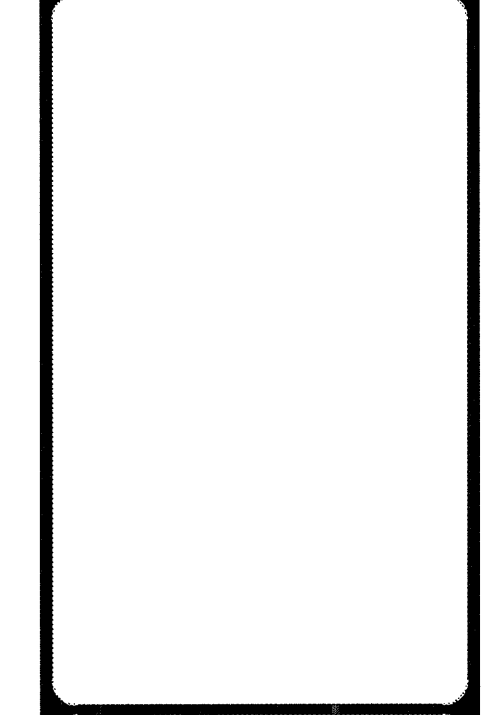

BGO
architects


4144 N. Central Expy.
Suite 855
Dallas, TX 75204
214.520.8878
bgoarchitects.com

DATE
08-05-11

PROJECT
11129

SHEET NUMBER

E-3.4E

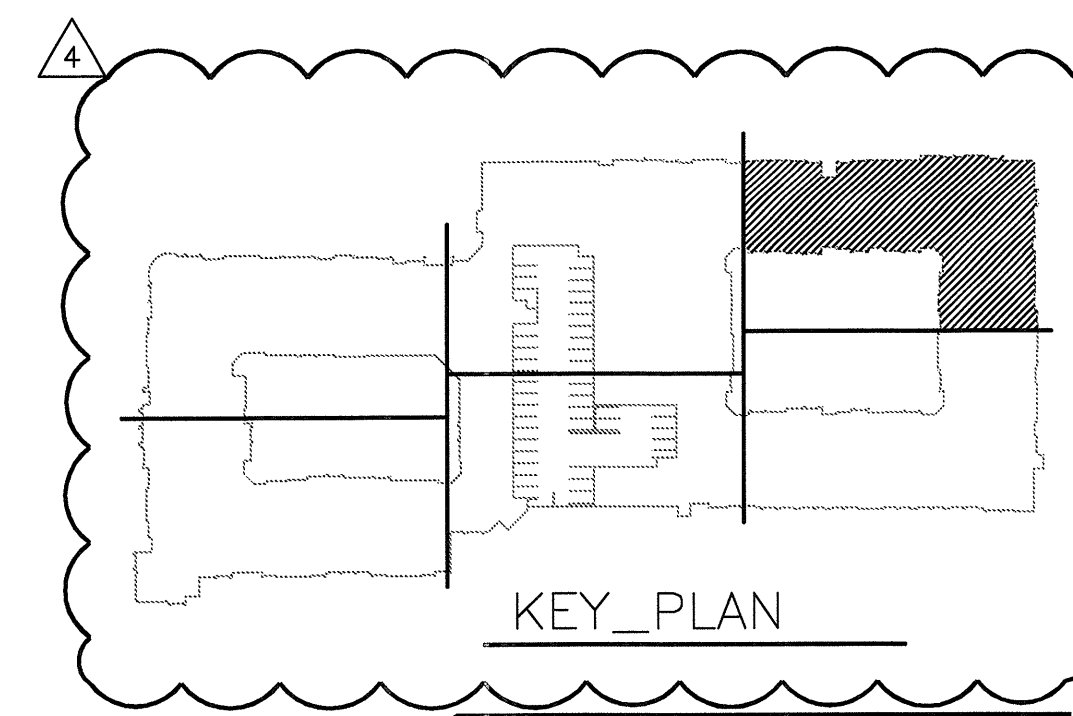

1 DIVISION 'E' FOURTH FLOOR PLAN
SCALE: 1/8" = 1'-0"

JSE Jordan & Skala Engineers
14240 Midway Road, Suite 150
Dallas, TX 75244-3138
Tel: (469) 383-1616 Fax: (469) 383-1615
Project Number - 113-0355 Texas Firm Registration # F-4990
Drawn By: MJ Checked By: RAD