


REVISIONS

1	9-2-2011	DESIGN REVISIONS
2	9-13-2011	ANSI/FHA COMMENTS
3	9-23-2011	DESIGN REVISIONS
4	10-17-2011	CONSTRUCTION ISSUE

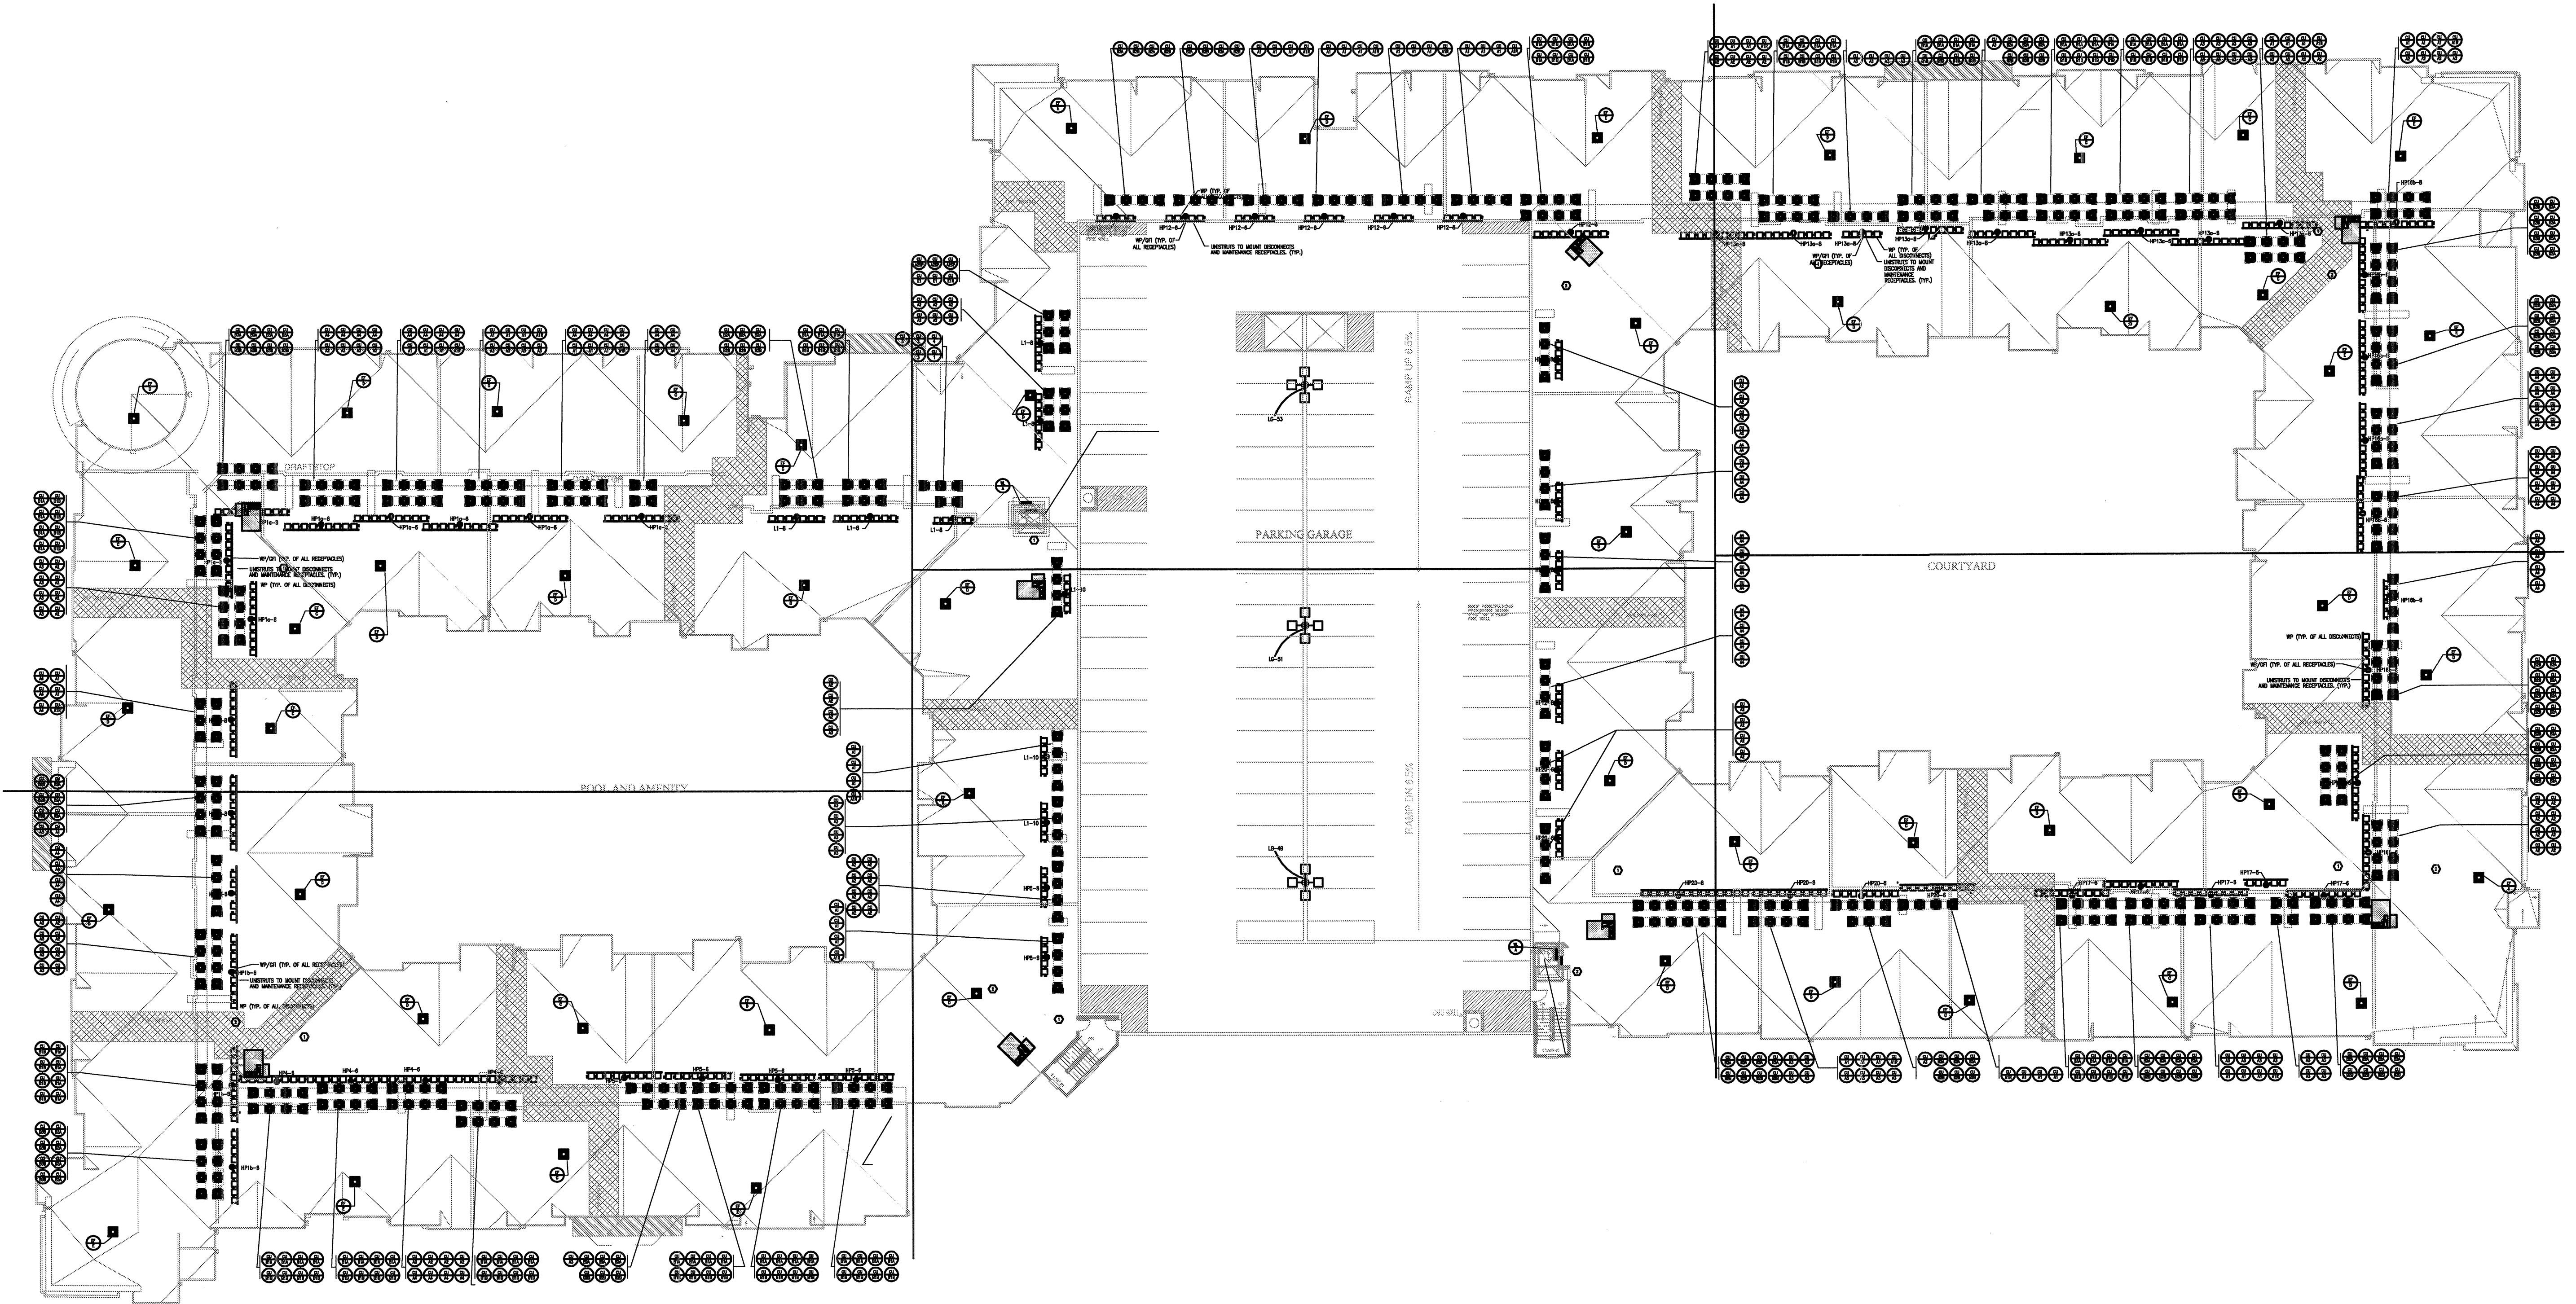

1 ROOF PLAN/GARAGE PLAN - 3-5
SCALE: 1/32" = 1'-0"

KELLER SPRINGS LOFTS

LOFT APARTMENTS IN ADDISON, TEXAS



4144 N. Central Exp.
Suite 855
Dallas, TX 75204
214.520.8878
bgoarchitects.com

DATE
08-05-11

PROJECT
11129

SHEET NUMBER
E-3.5

JSE Jordan & Skala Engineers
14210 Midway Road, Suite 370
Dallas, TX 75244-5138
Project Number - 113-0555 Texas Firm Registration # F-4990
Drawn By: MJ Checked By: RAD