

REVISIONS	
1	9-2-2011 DESIGN REVISIONS
2	9-13-2011 ANSI/FHA COMMENTS
3	9-23-2011 DESIGN REVISIONS
4	10-17-2011 CONSTRUCTION ISSUE

KELLER SPRINGS LOFTS

LOFT APARTMENTS IN ADDISON, TEXAS




4144 N. Central Expy.
Suite 855
Dallas, TX 75204
214.520.8878
bgoarchitects.com

DATE
08-05-11


PROJECT
11129

SHEET NUMBER

E-3.5B

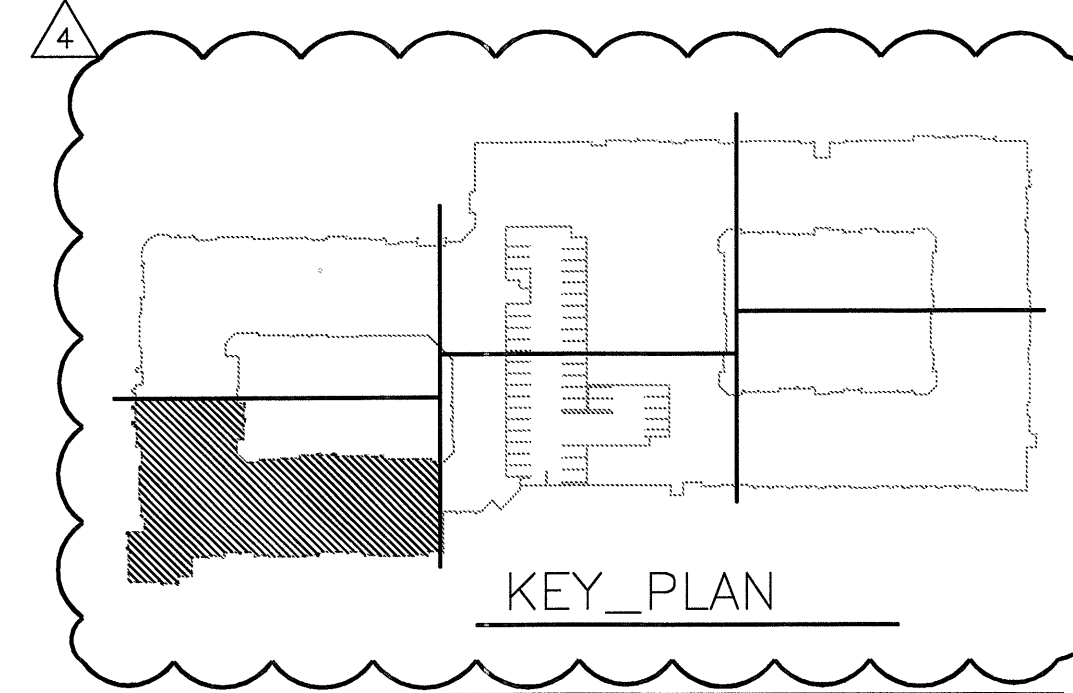

JSE Jordan & Skala Engineers
14240 Midway Road, Suite 350
Dallas, TX 75244-5138
P: (469) 382-1616 F: (469) 382-1615
Project Number - 113-0255 Texas Firm Registration # F-4990
Drawn By: MJ Checked By: RAD

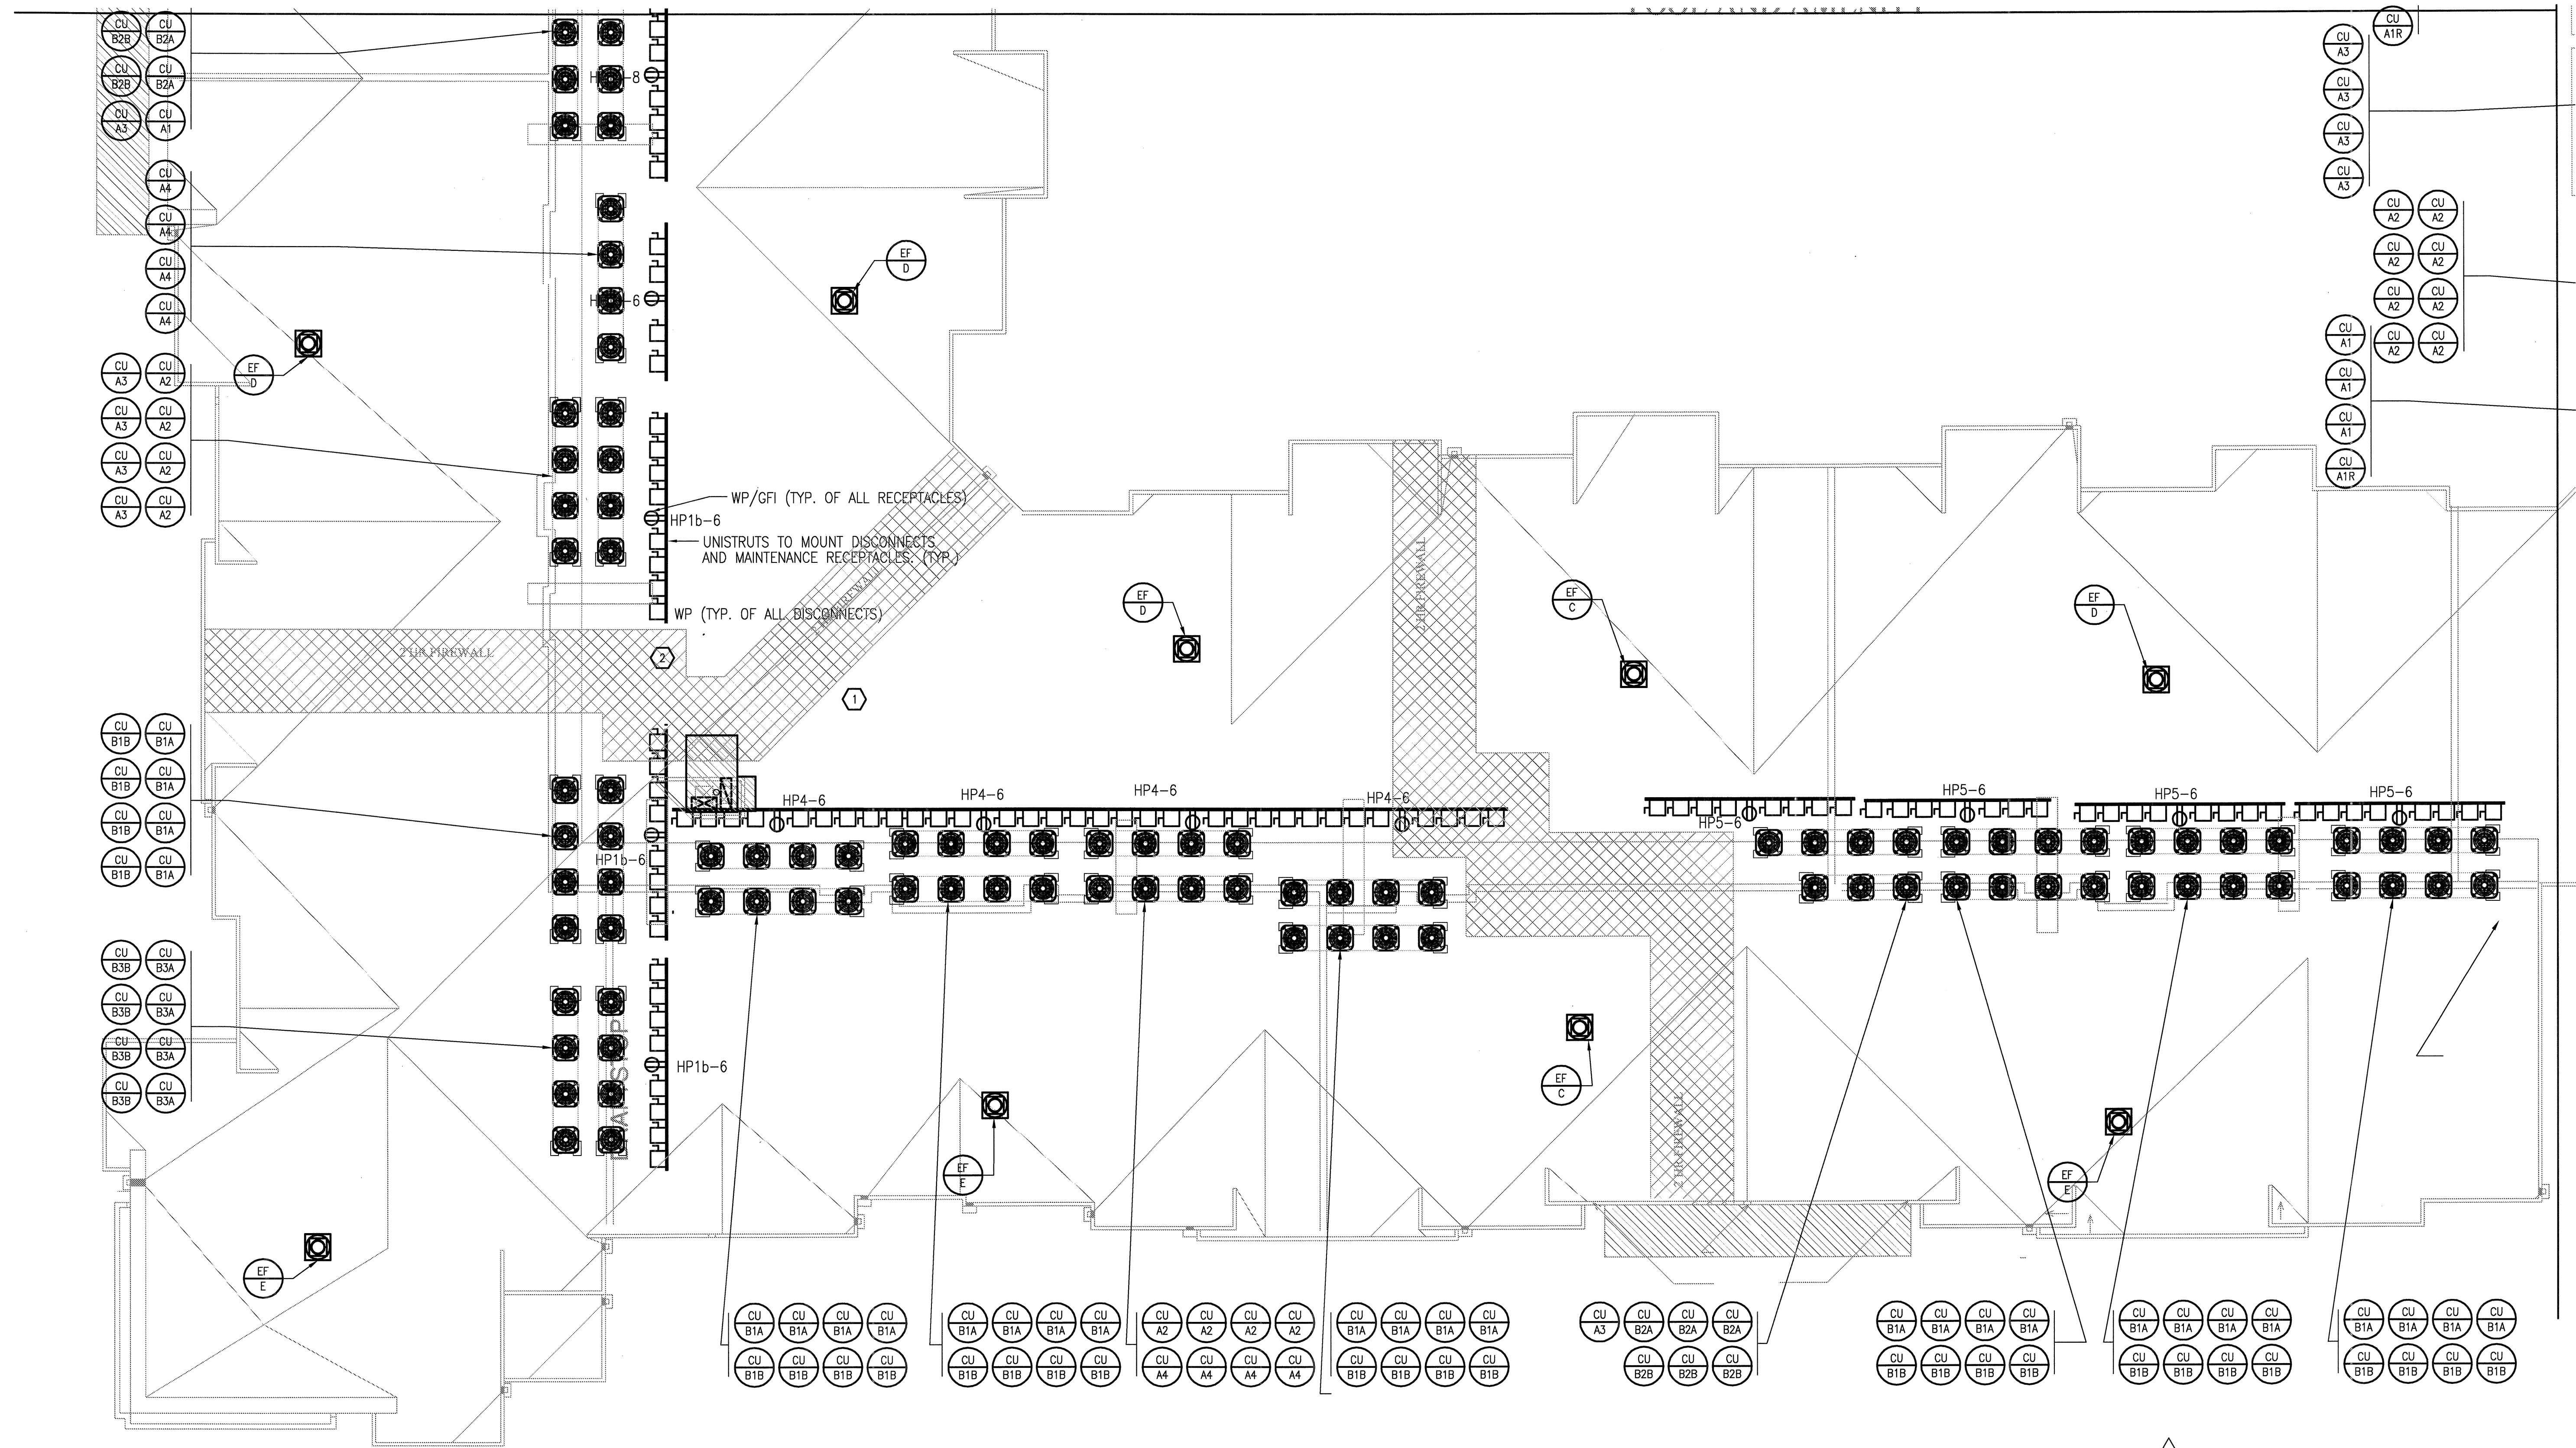

1 DIVISION 'B' ROOF PLAN
SCALE: 1/8" = 1'-0"