


1 DIVISION 'D' ROOF PLAN  
SCALE: 1/8" = 1'-0"

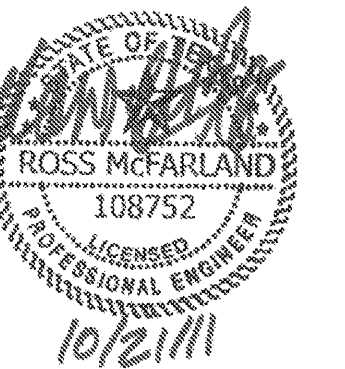

10/2/11

| REVISIONS |                               |
|-----------|-------------------------------|
| 1         | 9-2-2011 DESIGN REVISIONS     |
| 2         | 9-13-2011 ANSI/FHA COMMENTS   |
| 3         | 9-23-2011 DESIGN REVISIONS    |
| 4         | 10-17-2011 CONSTRUCTION ISSUE |

**KELLER SPRINGS LOFTS**

LOFT APARTMENTS IN ADDISON, TEXAS

**BGO**  
architects


4144 N. Central Expy.  
Suite 855  
Dallas, TX 75204  
214.520.8878  
bgoarchitects.com

DATE  
08-05-11

PROJECT  
11129

SHEET NUMBER

**E-3.5D**

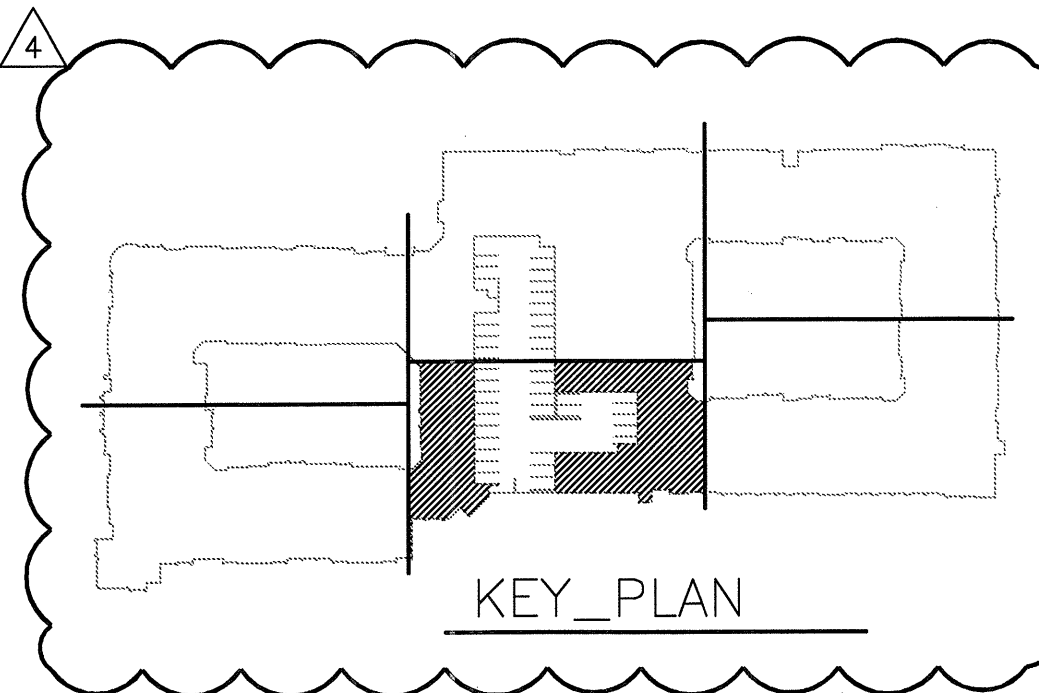

**JSE** Jordan & Skala Engineers

14240 Midway Road, Suite 350  
Dallas, TX 75244-5138  
V: (469) 385-1616, F: (469) 385-1613  
Project Number - 113-0355 Texas Firm Registration # F-4990  
Drawn By: MJ Checked By: RAD