

REVISIONS

| | | |
|---|------------|--------------------|
| 1 | 9-2-2011 | DESIGN REVISIONS |
| 2 | 9-13-2011 | ANSI/FHA COMMENTS |
| 3 | 9-23-2011 | DESIGN REVISIONS |
| 4 | 10-17-2011 | CONSTRUCTION ISSUE |

KELLER SPRINGS LOFTS

LOFT APARTMENTS IN ADDISON, TEXAS


BGO
architects

4144 N. Central Expy.
Suite 855
Dallas, TX 75204
214.520.8878
bgoarchitects.com

DATE
08-05-11

PROJECT
11129

SHEET NUMBER
E-3.5E

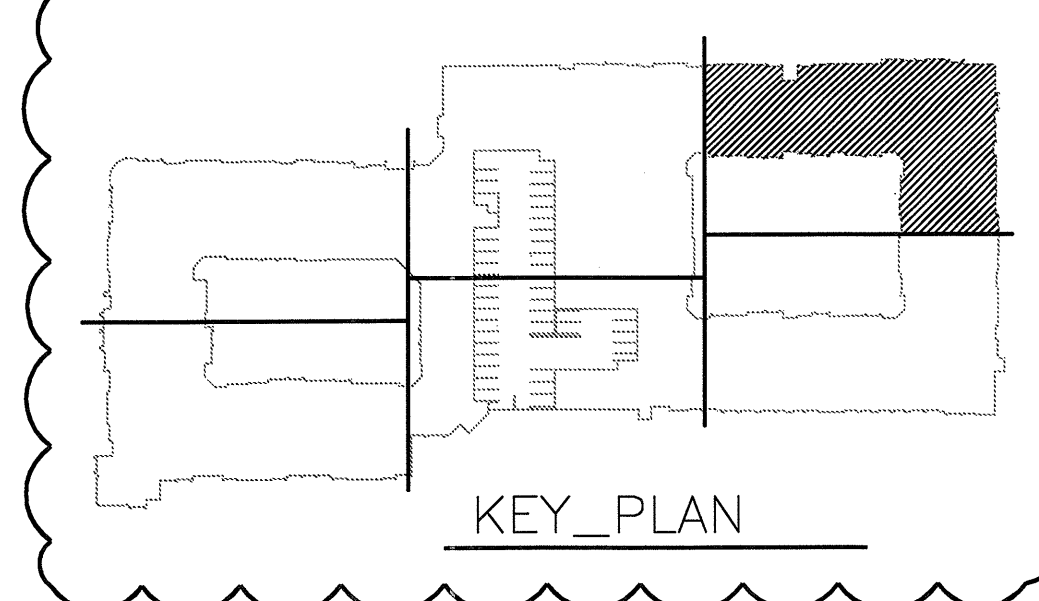

1 DIVISION 'E' ROOF PLAN
SCALE: 1/8" = 1'-0"

JSE Jordan & Skala Engineers
14240 Midway Road, Suite 350
Dallas, TX 75244-0139
Tel: (469) 863-1676 Fax: (469) 383-1613
Project Number - 113-0355 Texas Firm Registration # F-4990
Drawn By: MJ Checked By: RAD