

REVISIONS

1	9-2-2011	DESIGN REVISIONS
2	9-13-2011	ANSI/FHA COMMENTS
3	9-23-2011	DESIGN REVISIONS
4	10-17-2011	CONSTRUCTION ISSUE

KELLER SPRINGS LOFTS

LOFT APARTMENTS IN ADDISON, TEXAS





4144 N. Central Expy. Suite 855
Dallas, TX 75204
214.520.8878
bgoarchitects.com

DATE
08-05-11

PROJECT
11129

SHEET NUMBER
E-3.5F

JSE Jordan & Skala Engineers
14210 Midway Road, Suite 310
Dallas, TX 75244-1138
P: (469) 383-1616 F: (469) 383-1615
Project Number - 113-0355 Texas Firm Registration # F-4990
Drawn By: MJ Checked By: RAD

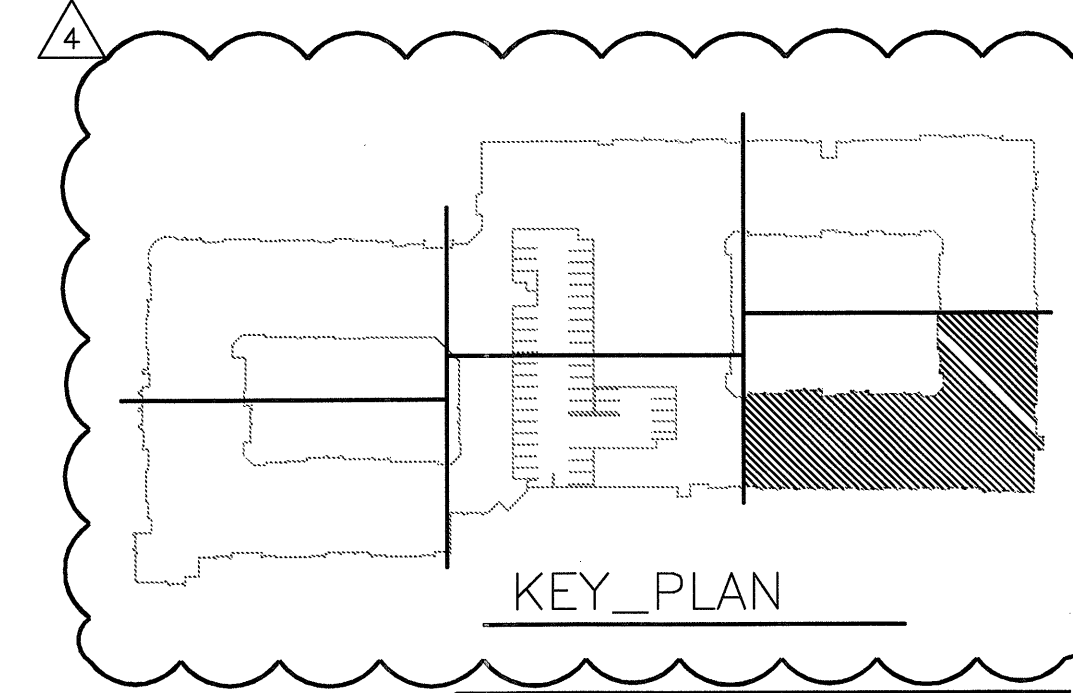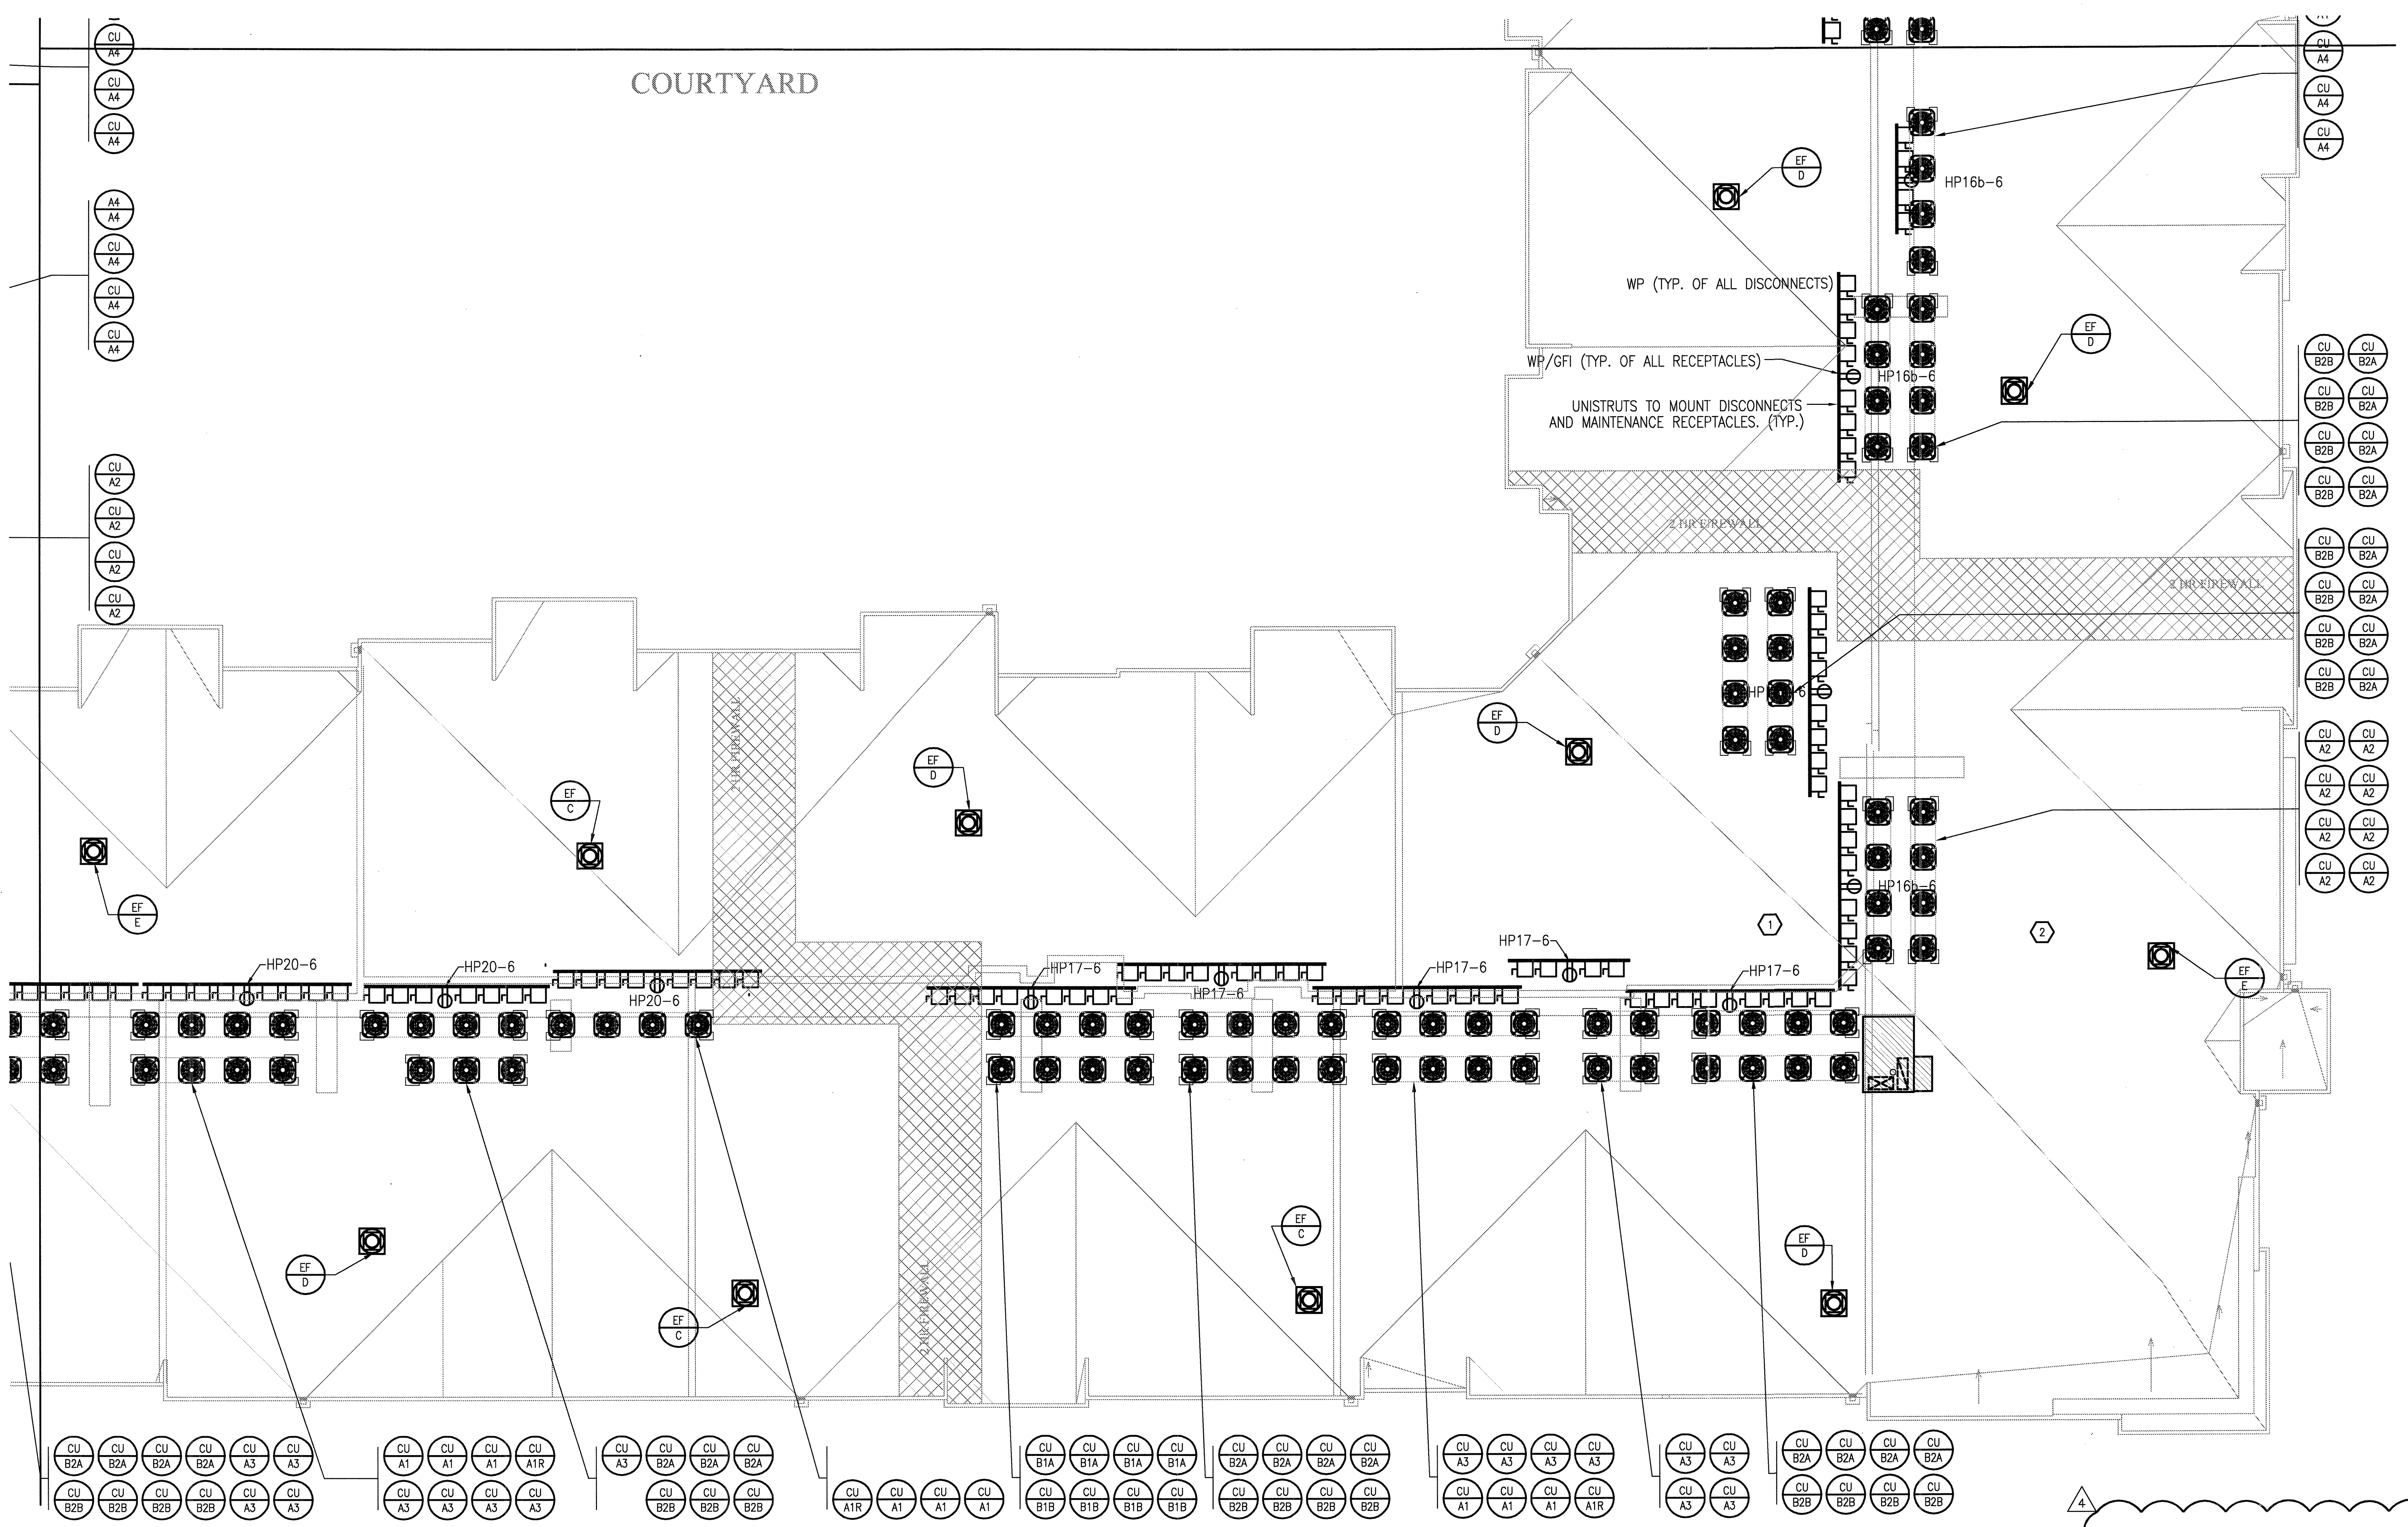

1 DIVISION 'F' ROOF PLAN
SCALE: 1/8" = 1'-0"