



REVISIONS

1	9-2-2011	DESIGN REVISIONS
2	9-13-2011	ANSI/FHA COMMENTS
3	9-23-2011	DESIGN REVISIONS
4	10-17-2011	CONSTRUCTION ISSUE


KELLER SPRINGS LOFTS
 LOFT APARTMENTS IN ADDISON, TEXAS

BGO architects
 4144 N. Central Expy. Suite 855
 Dallas, TX 75204
 214.520.8878
 bgoarchitects.com


DATE
 08-05-11

PROJECT
 11129


SHEET NUMBER
E-4.1
 PARTIAL
 PLANS
 ELECTRICAL

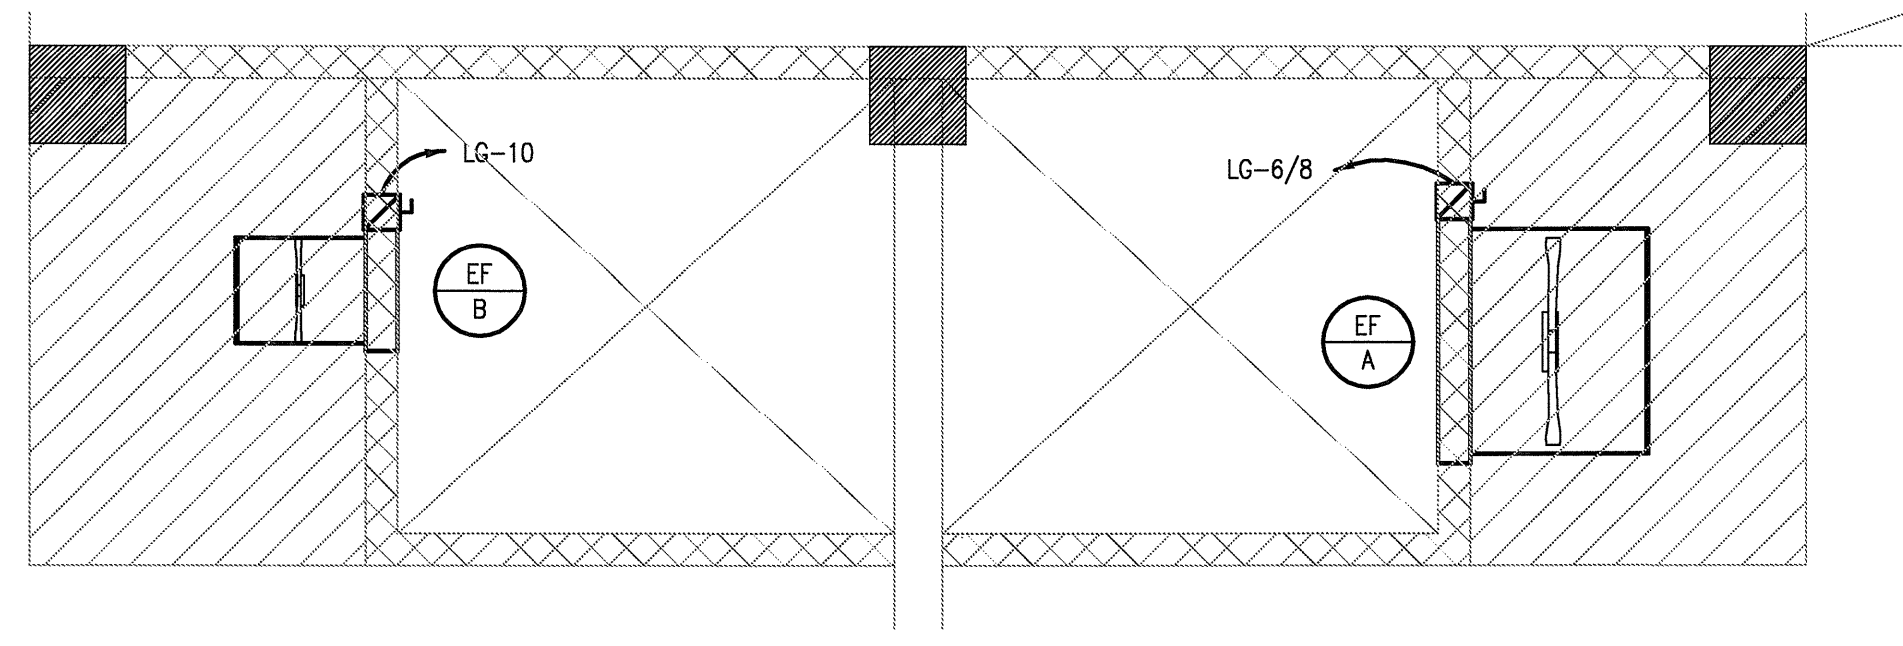


5 GARAGE VENTING - ELECTRICAL
 SCALE: 1/4" = 1'-0" 1ST, 3RD, & 5TH FLOORS

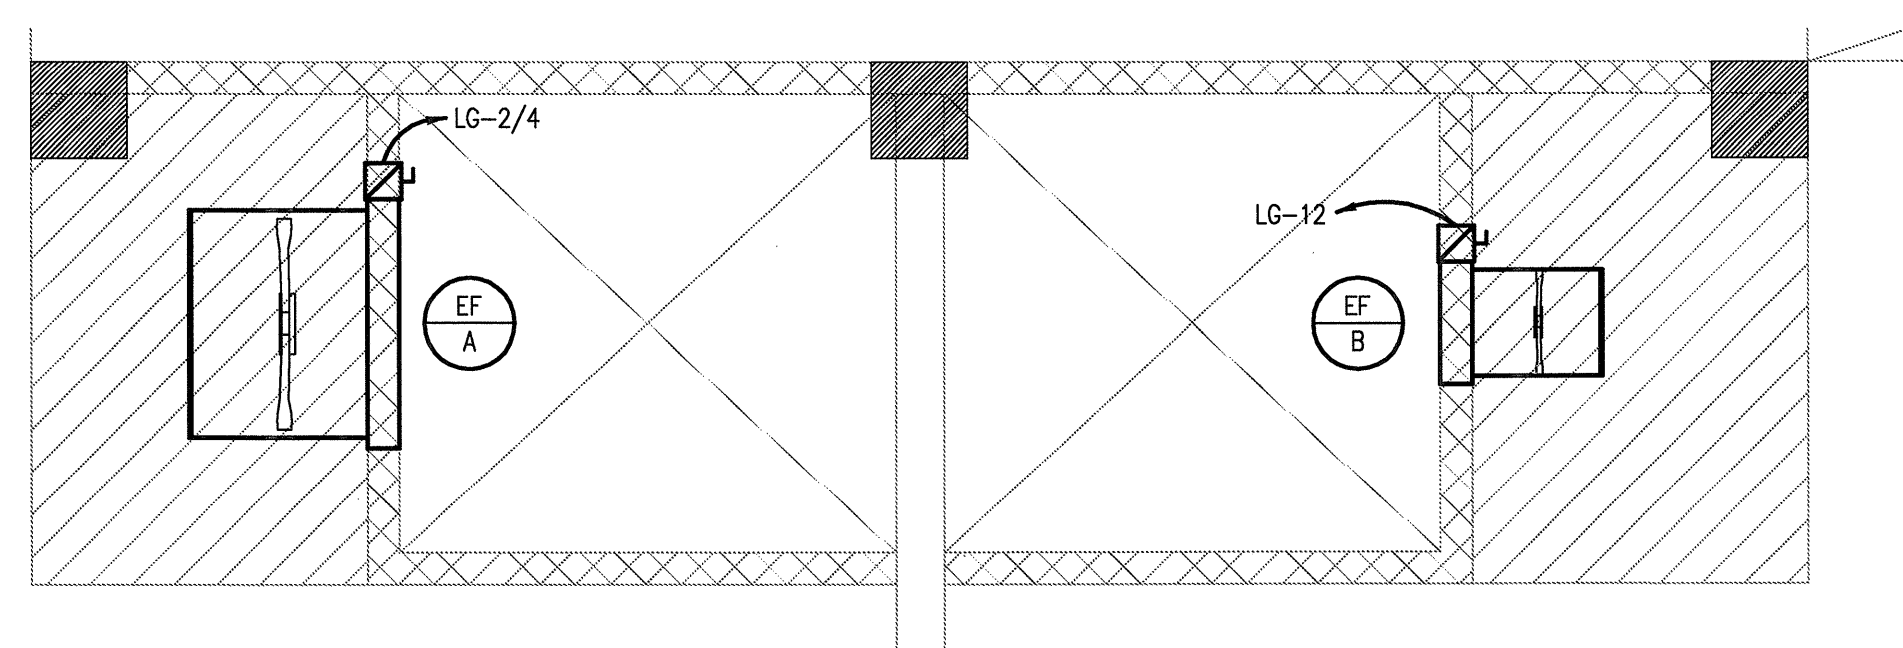


4 GARAGE VENTING - ELECTRICAL
 SCALE: 1/4" = 1'-0" 2ND, 4TH, & 6TH FLOORS

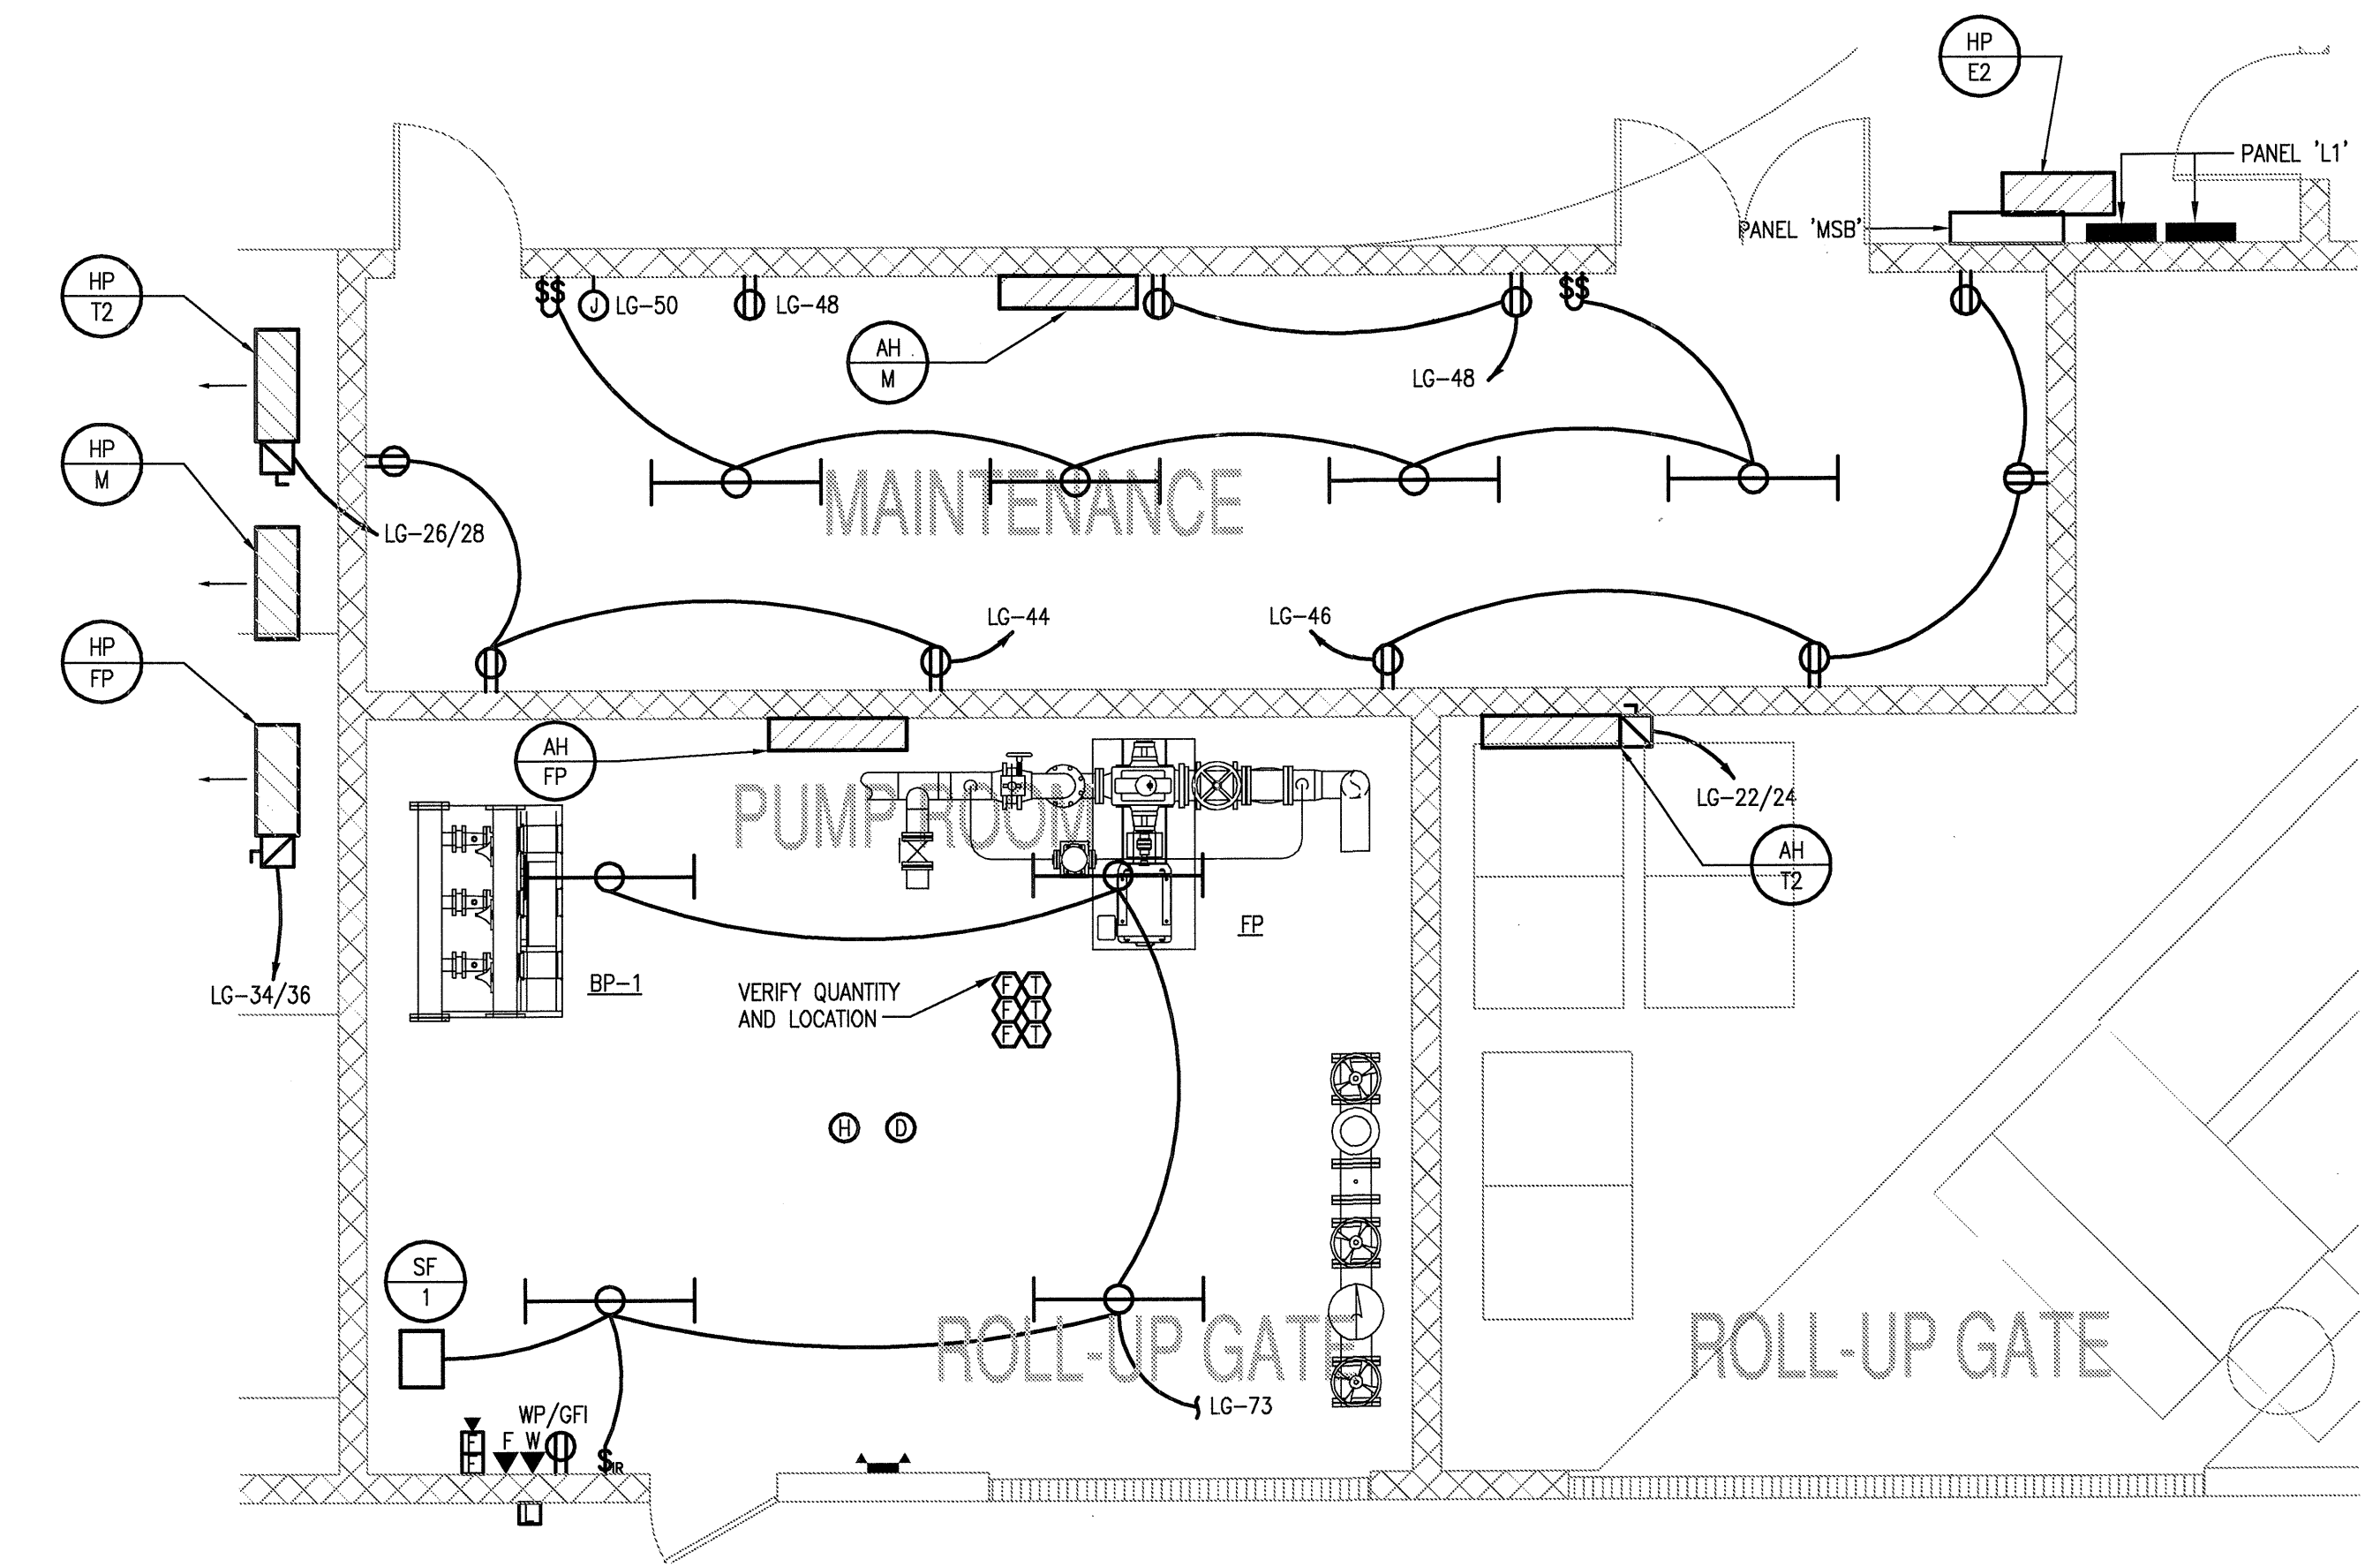

3 MAINTENANCE - ELECTRICAL
 SCALE: 1/4" = 1'-0"
 NOTE: COORDINATE EXACT LOCATION OF FIRE PUMP AND BOOSTER PUMPS WITH FIRE PROTECTION CONTRACTOR

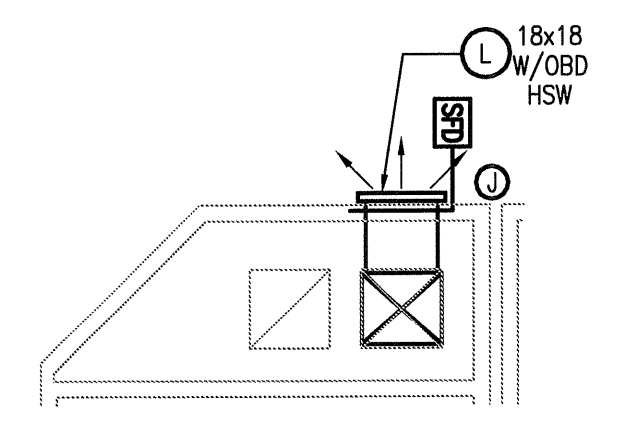

2 TYP. CORRIDOR A/C - ELECTRICAL
 SCALE: 1/4" = 1'-0"

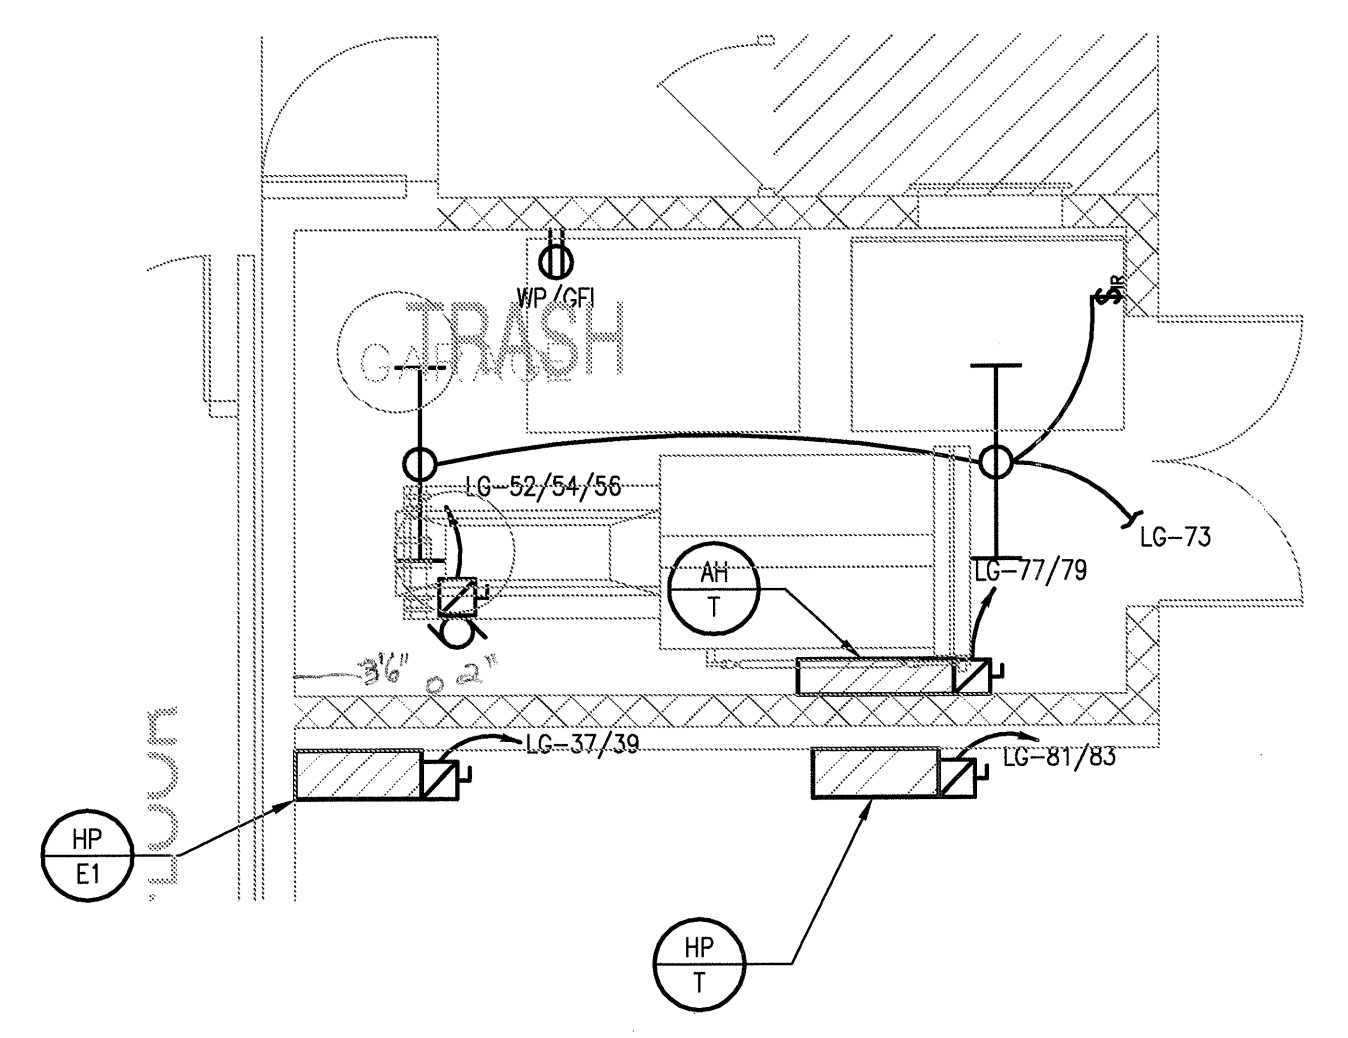

1 TRASH - ELECTRICAL
 SCALE: 1/4" = 1'-0" 1ST FLOOR

USE Jordan & Skala Engineers
 14240 Midway Road, Suite 350
 Dallas, TX 75244-2136
 V: (469) 383-1616 F: (469) 383-1615
 Project Number - 113-0555 Texas Firm Registration # F-4990
 Drawn By: MJ Checked By: RAD