

REVISIONS		
1	9-2-2011	DESIGN REVISIONS
2	9-13-2011	ANSI/FHA COMMENTS
3	9-23-2011	DESIGN REVISIONS
4	10-17-2011	CONSTRUCTION ISSUE
5	12-21-2011	DESIGN REVISIONS
6	1-17-2012	DESIGN REVISIONS

KELLER SPRINGS LOFTS
 LOFT APARTMENTS IN ADDISON, TEXAS


BGO architects
 4144 N. Central Expy.
 Suite 855
 Dallas, TX 75204
 214.520.8878
 bgoarchitects.com

DATE
 08-05-11

PROJECT
 11129

SHEET NUMBER

E-9.1

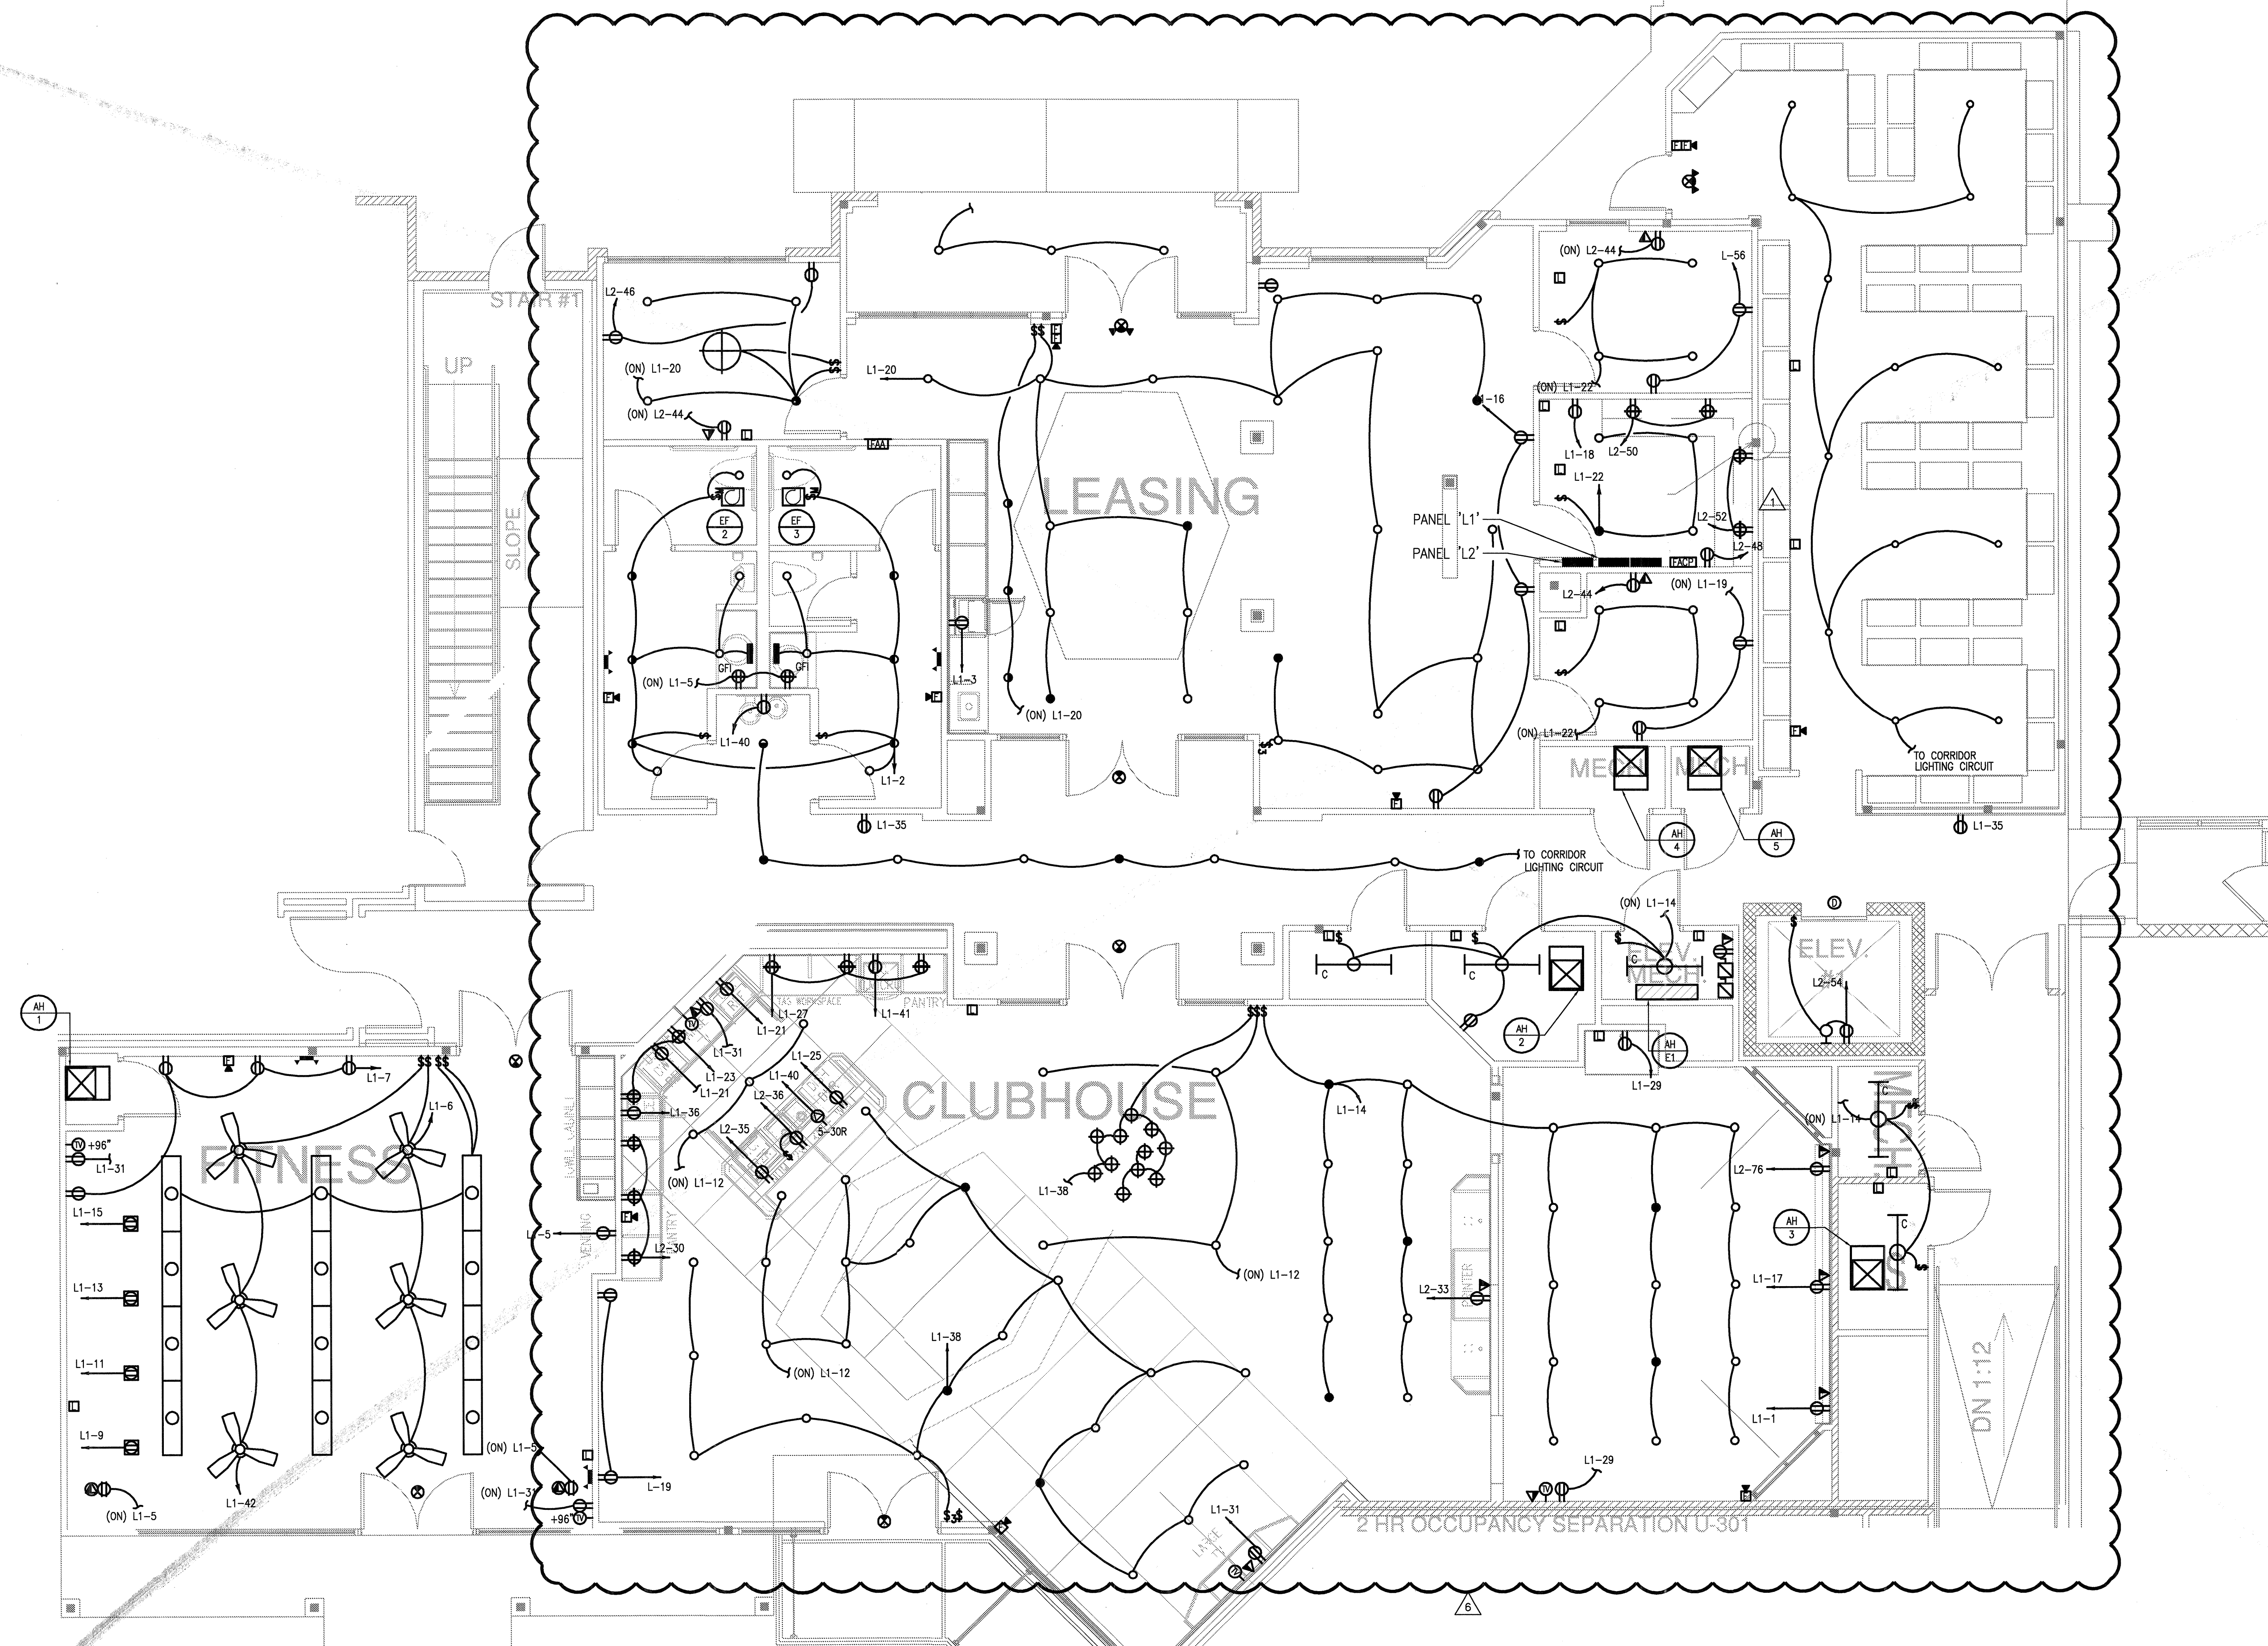

GENERAL NOTES

- REFERENCE INTERIOR DESIGN DRAWINGS FOR FIXTURE LOCATIONS, QUANTITIES, TYPES AND FIXTURE SCHEDULE.
- COORDINATE SWITCHING WITH INTERIORS. ALL SWITCHING MUST COMPLY WITH CITY OF

1 Clubhouse
 SCALE: 1/4" = 1'-0"

USE Jordan & Skala Engineers
 14240 Midway Road, Suite 350
 Dallas, TX 75244-5158
 V: (469) 385-1616, F: (469) 385-1619
 Project Number - 113-0355 Texas Firm Registration # F-4990
 Drawn By: MJ Checked By: RAD