

REVISIONS	
1	9-2-2011 DESIGN REVISIONS
2	9-13-2011 ANSI/FHA COMMENTS
3	9-23-2011 DESIGN REVISIONS
4	10-17-2011 CONSTRUCTION ISSUE

**KELLER SPRINGS LOFTS**  
LOFT APARTMENTS IN ADDISON, TEXAS

**BGO architects**  
4144 N. Central Expy.  
Suite 855  
Dallas, TX 75204  
214.520.8878  
bgoarchitects.com


DATE  
08-05-11

PROJECT  
11129

SHEET NUMBER

**E-9.1**

**JSE** Jordan & Skala Engineers  
14350 Midway Blvd, Suite 310  
Dallas, TX 75244-5138  
P: (469) 380-1876 F: (469) 380-1615  
Project Number - 113-0355 Texas Firm Registration # F-4990  
Drawn By: MJ Checkled By: RAD

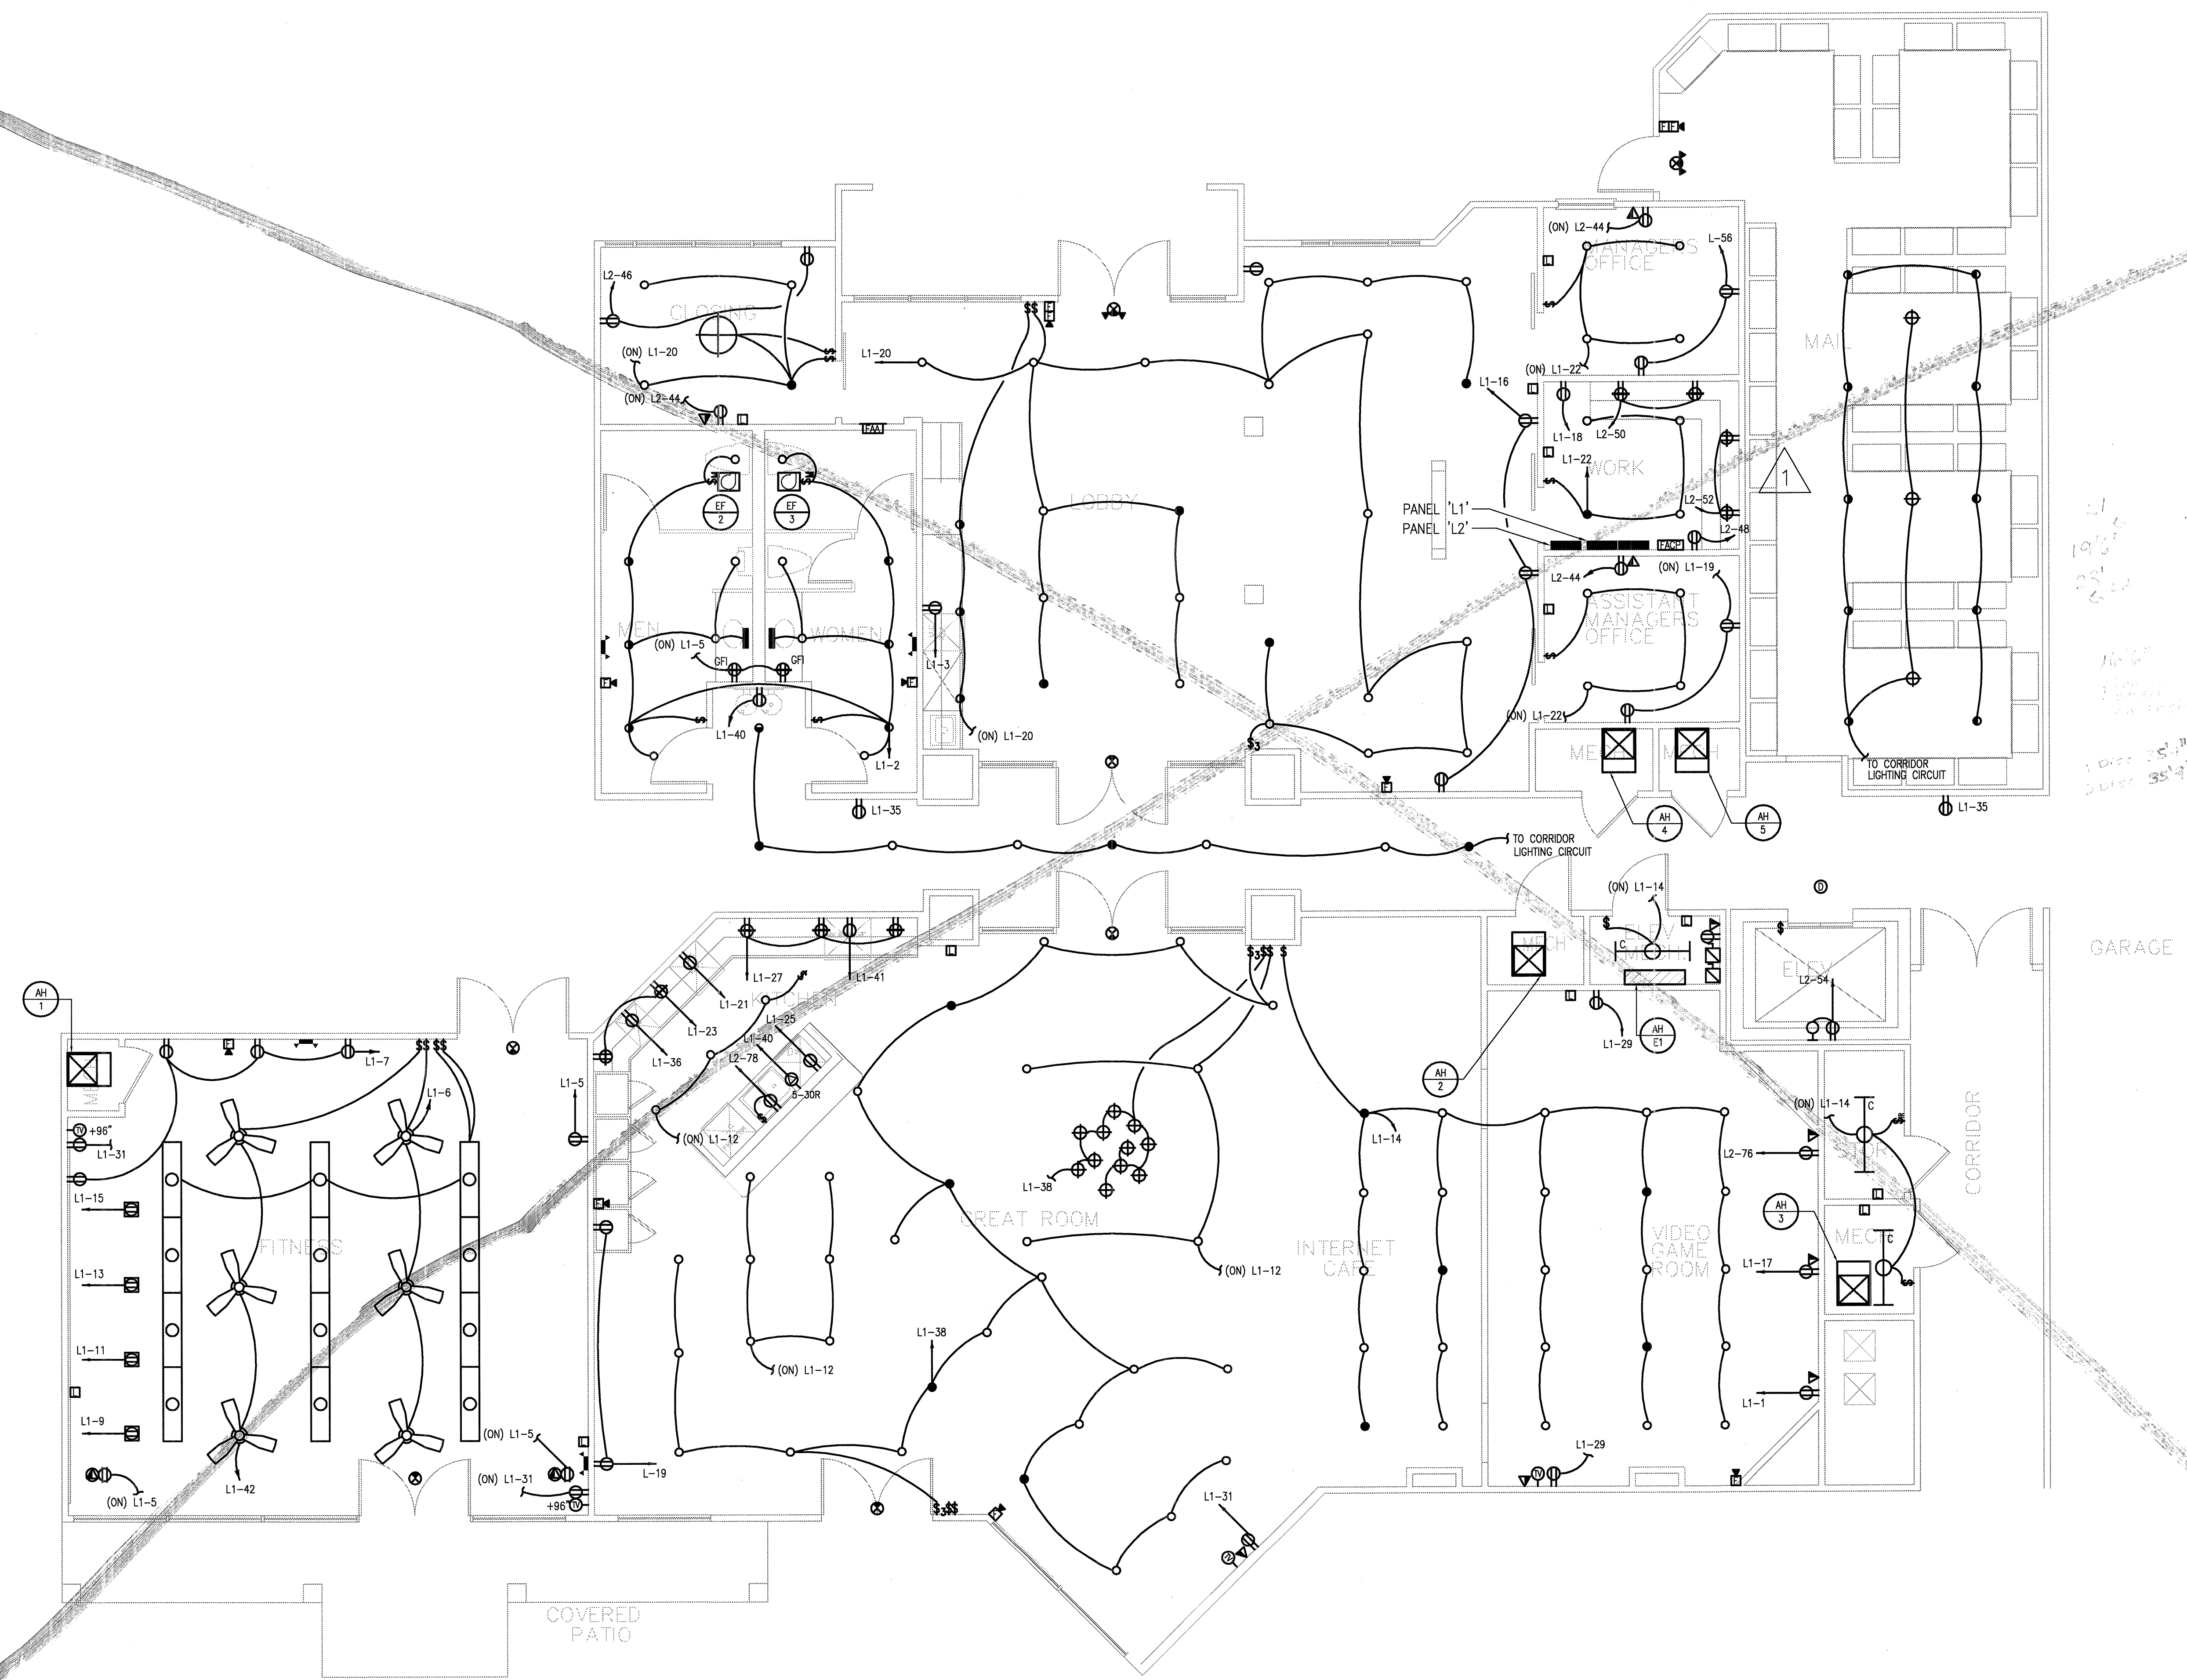

**GENERAL NOTES**  
G-1. REFERENCE INTERIOR DESIGN DRAWINGS FOR EXACT FIXTURE LOCATIONS AND FIXTURE SCHEDULE.

**1 Clubhouse**  
SCALE: 1/4" = 1'-0"