

**1 BUILDING FORMING PLAN**  
SCALE: 1:20

**BGO**  
architects  
4144 N. Central Expy.  
Suite 855  
Dallas, TX 75204  
214.520.8878  
bgoarchitects.com

CONSTRUCTION ISSUE  
10-17-2011

REVISIONS  
OWNER COORDINATION  
01-28-2008



**KELLER SPRINGS LOFTS**

LOFT APARTMENTS IN ADDISON, TEXAS



COPYRIGHT © Beeler Guest Owens Architects ALL RIGHTS RESERVED  
DATE  
08-05-2011  
PROJECT  
11129

SHEET NUMBER  
**FP**

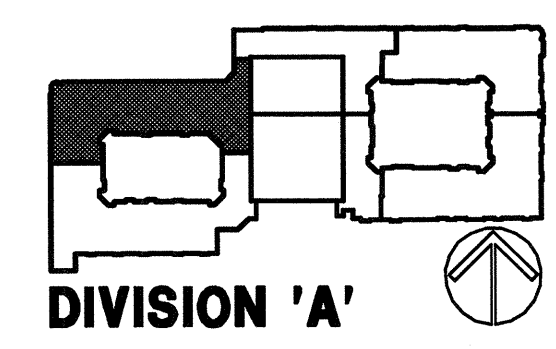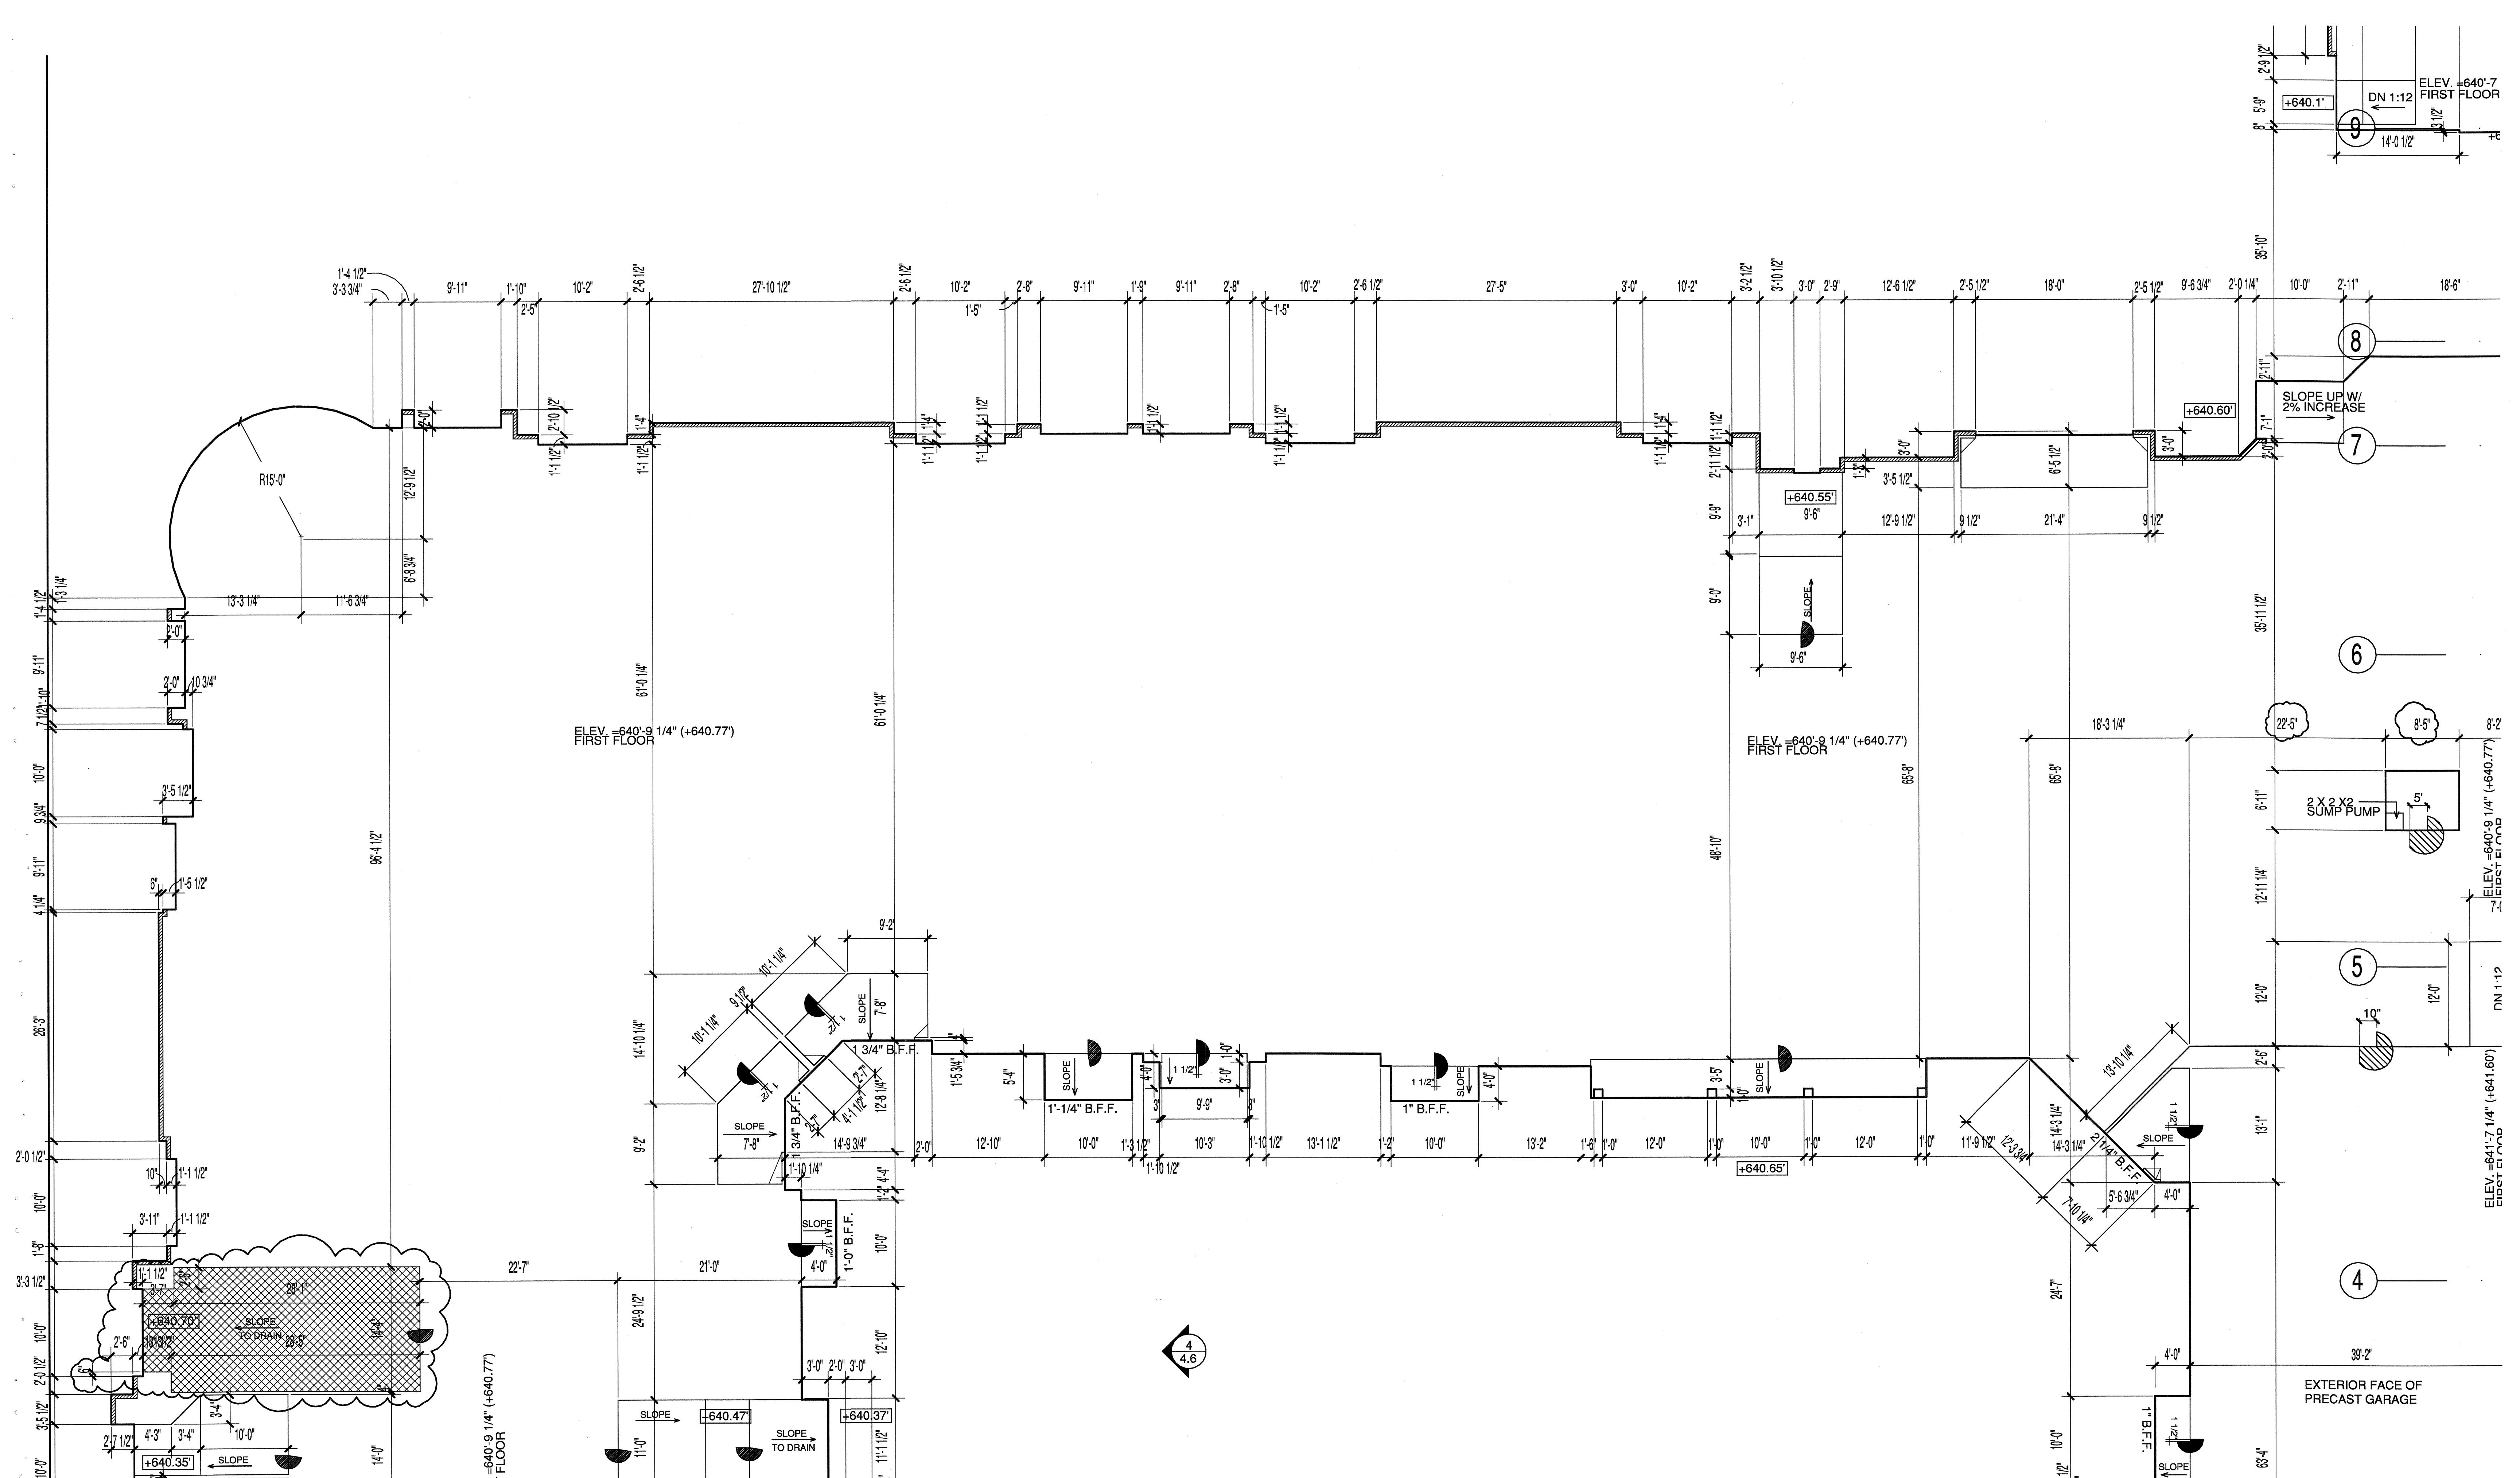

**BGO**  
architects

4144 N. Central Expy.  
Suite 855  
Dallas, TX 75204  
214.520.8878  
bgoarchitects.com

CONSTRUCTION ISSUE  
10-17-2011

REVISIONS

**KELLER SPRINGS LOFTS**

LOFT APARTMENTS IN ADDISON, TEXAS



DATE  
08-05-2011



PROJECT  
11129

SHEET NUMBER  
**FP-A**

BLDG PLAN 'A'

COPYRIGHT © Beeler Guest Owens Architects ALL RIGHTS RESERVED



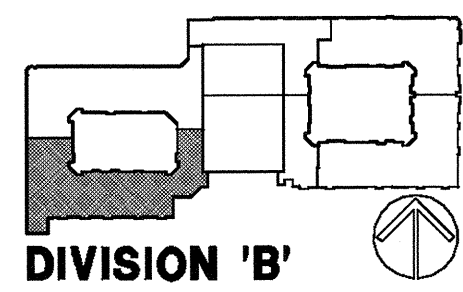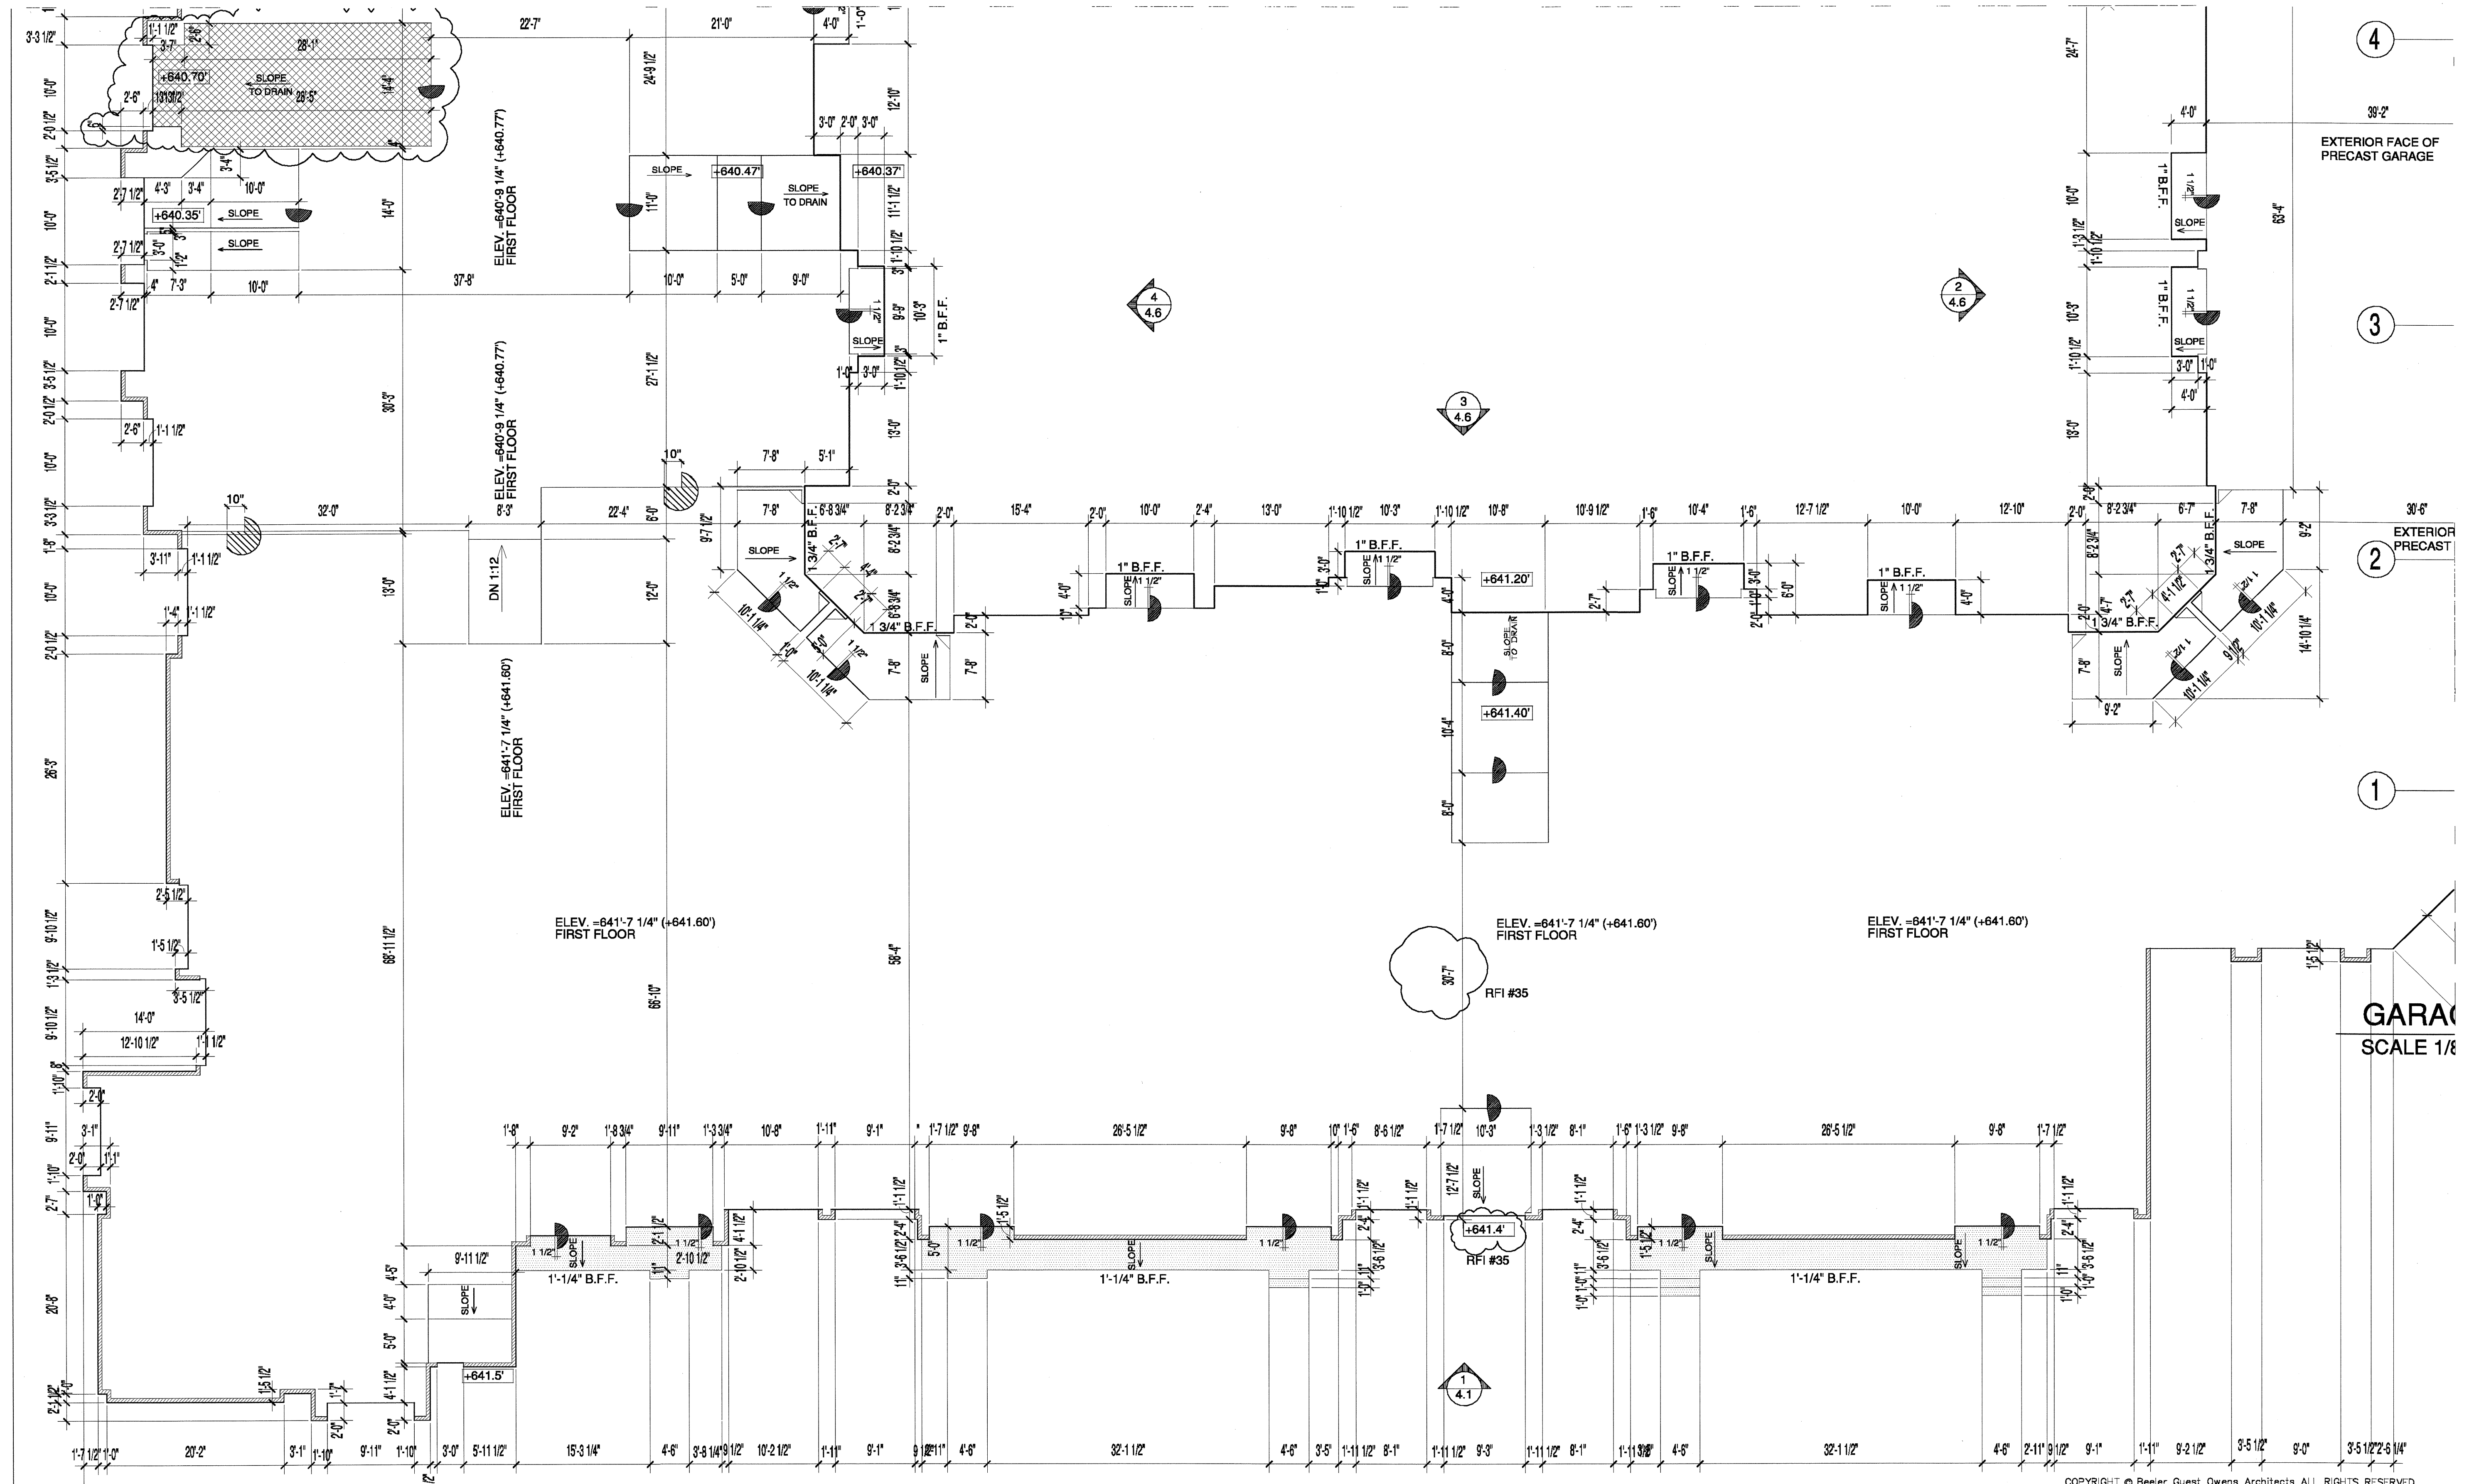

**BGO**  
architects  
4144 N. Central Expy.  
Suite 855  
Dallas, TX 75204  
214.620.8878  
bgoarchitects.com

CONSTRUCTION ISSUE  
10-17-2011

REVISIONS

NO.	DESCRIPTION



**KELLER SPRINGS LOFTS**  
LOFT APARTMENTS IN ADDISON, TEXAS

REGISTERED ARCHITECT  
DATE OF EXPIRATION  
01-03-2012

DATE  
08-05-2011  
PROJECT  
11129

SHEET NUMBER  
**FP-B**  
BLDG PLAN 'B'

COPYRIGHT © Beeler, Guest, Owens Architects. ALL RIGHTS RESERVED.

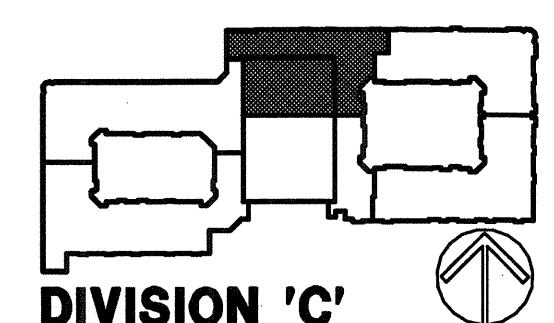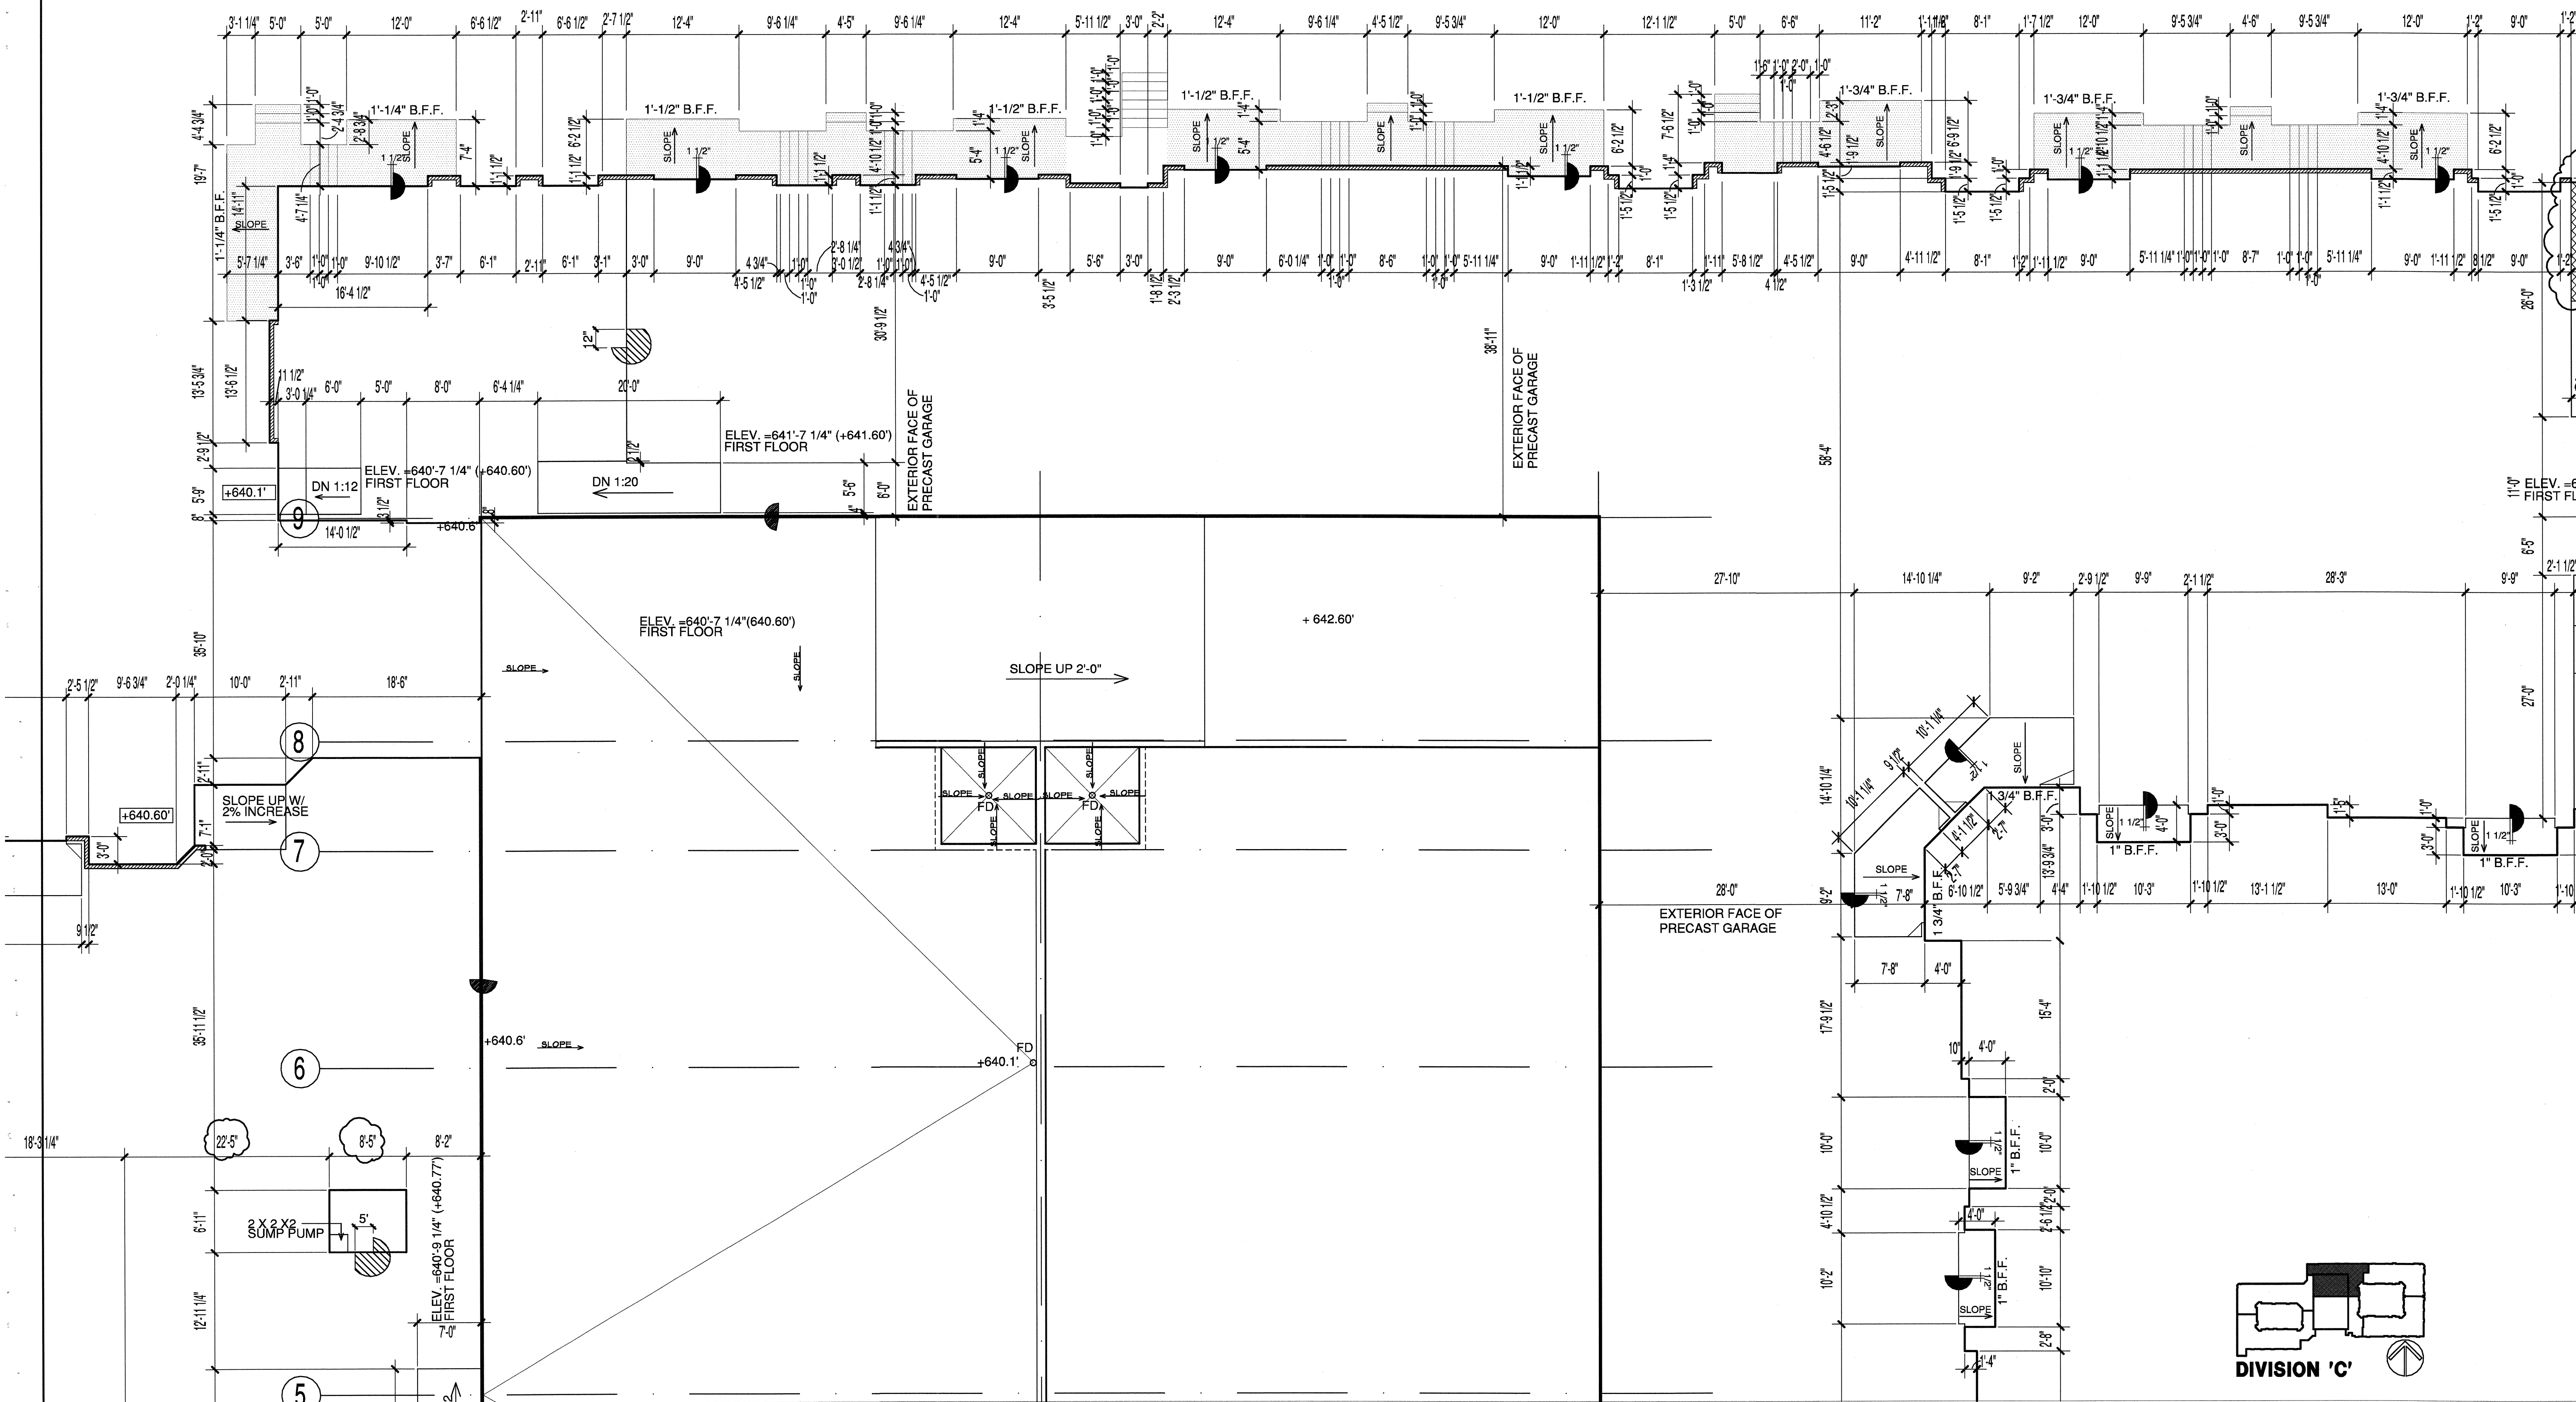


**DIVISION 'C'**


COPYRIGHT © Beeler Guest Owens Architects ALL RIGHTS RESERVED

<p>4144 N. Central Expy. Suite 855 Dallas, TX 75204 214.520.8878 bgoarchitects.com</p>	<p>CONSTRUCTION ISSUE 10-17-2011</p>	<p>REVISIONS</p> <table border="1"> <tr><td> </td><td> </td></tr> <tr><td> </td><td> </td></tr> <tr><td> </td><td> </td></tr> <tr><td> </td><td> </td></tr> <tr><td> </td><td> </td></tr> </table>											<p><b>KELLER SPRINGS LOFTS</b></p> <p>LOFT APARTMENTS IN ADDISON, TEXAS</p>		<p>DATE 08-05-2011</p>	<p>SHEET NUMBER <b>FP-C</b></p>
<p>01-03-2012</p>	<p>PROJECT 11129</p>	<p>BLDG PLAN 'C'</p>														



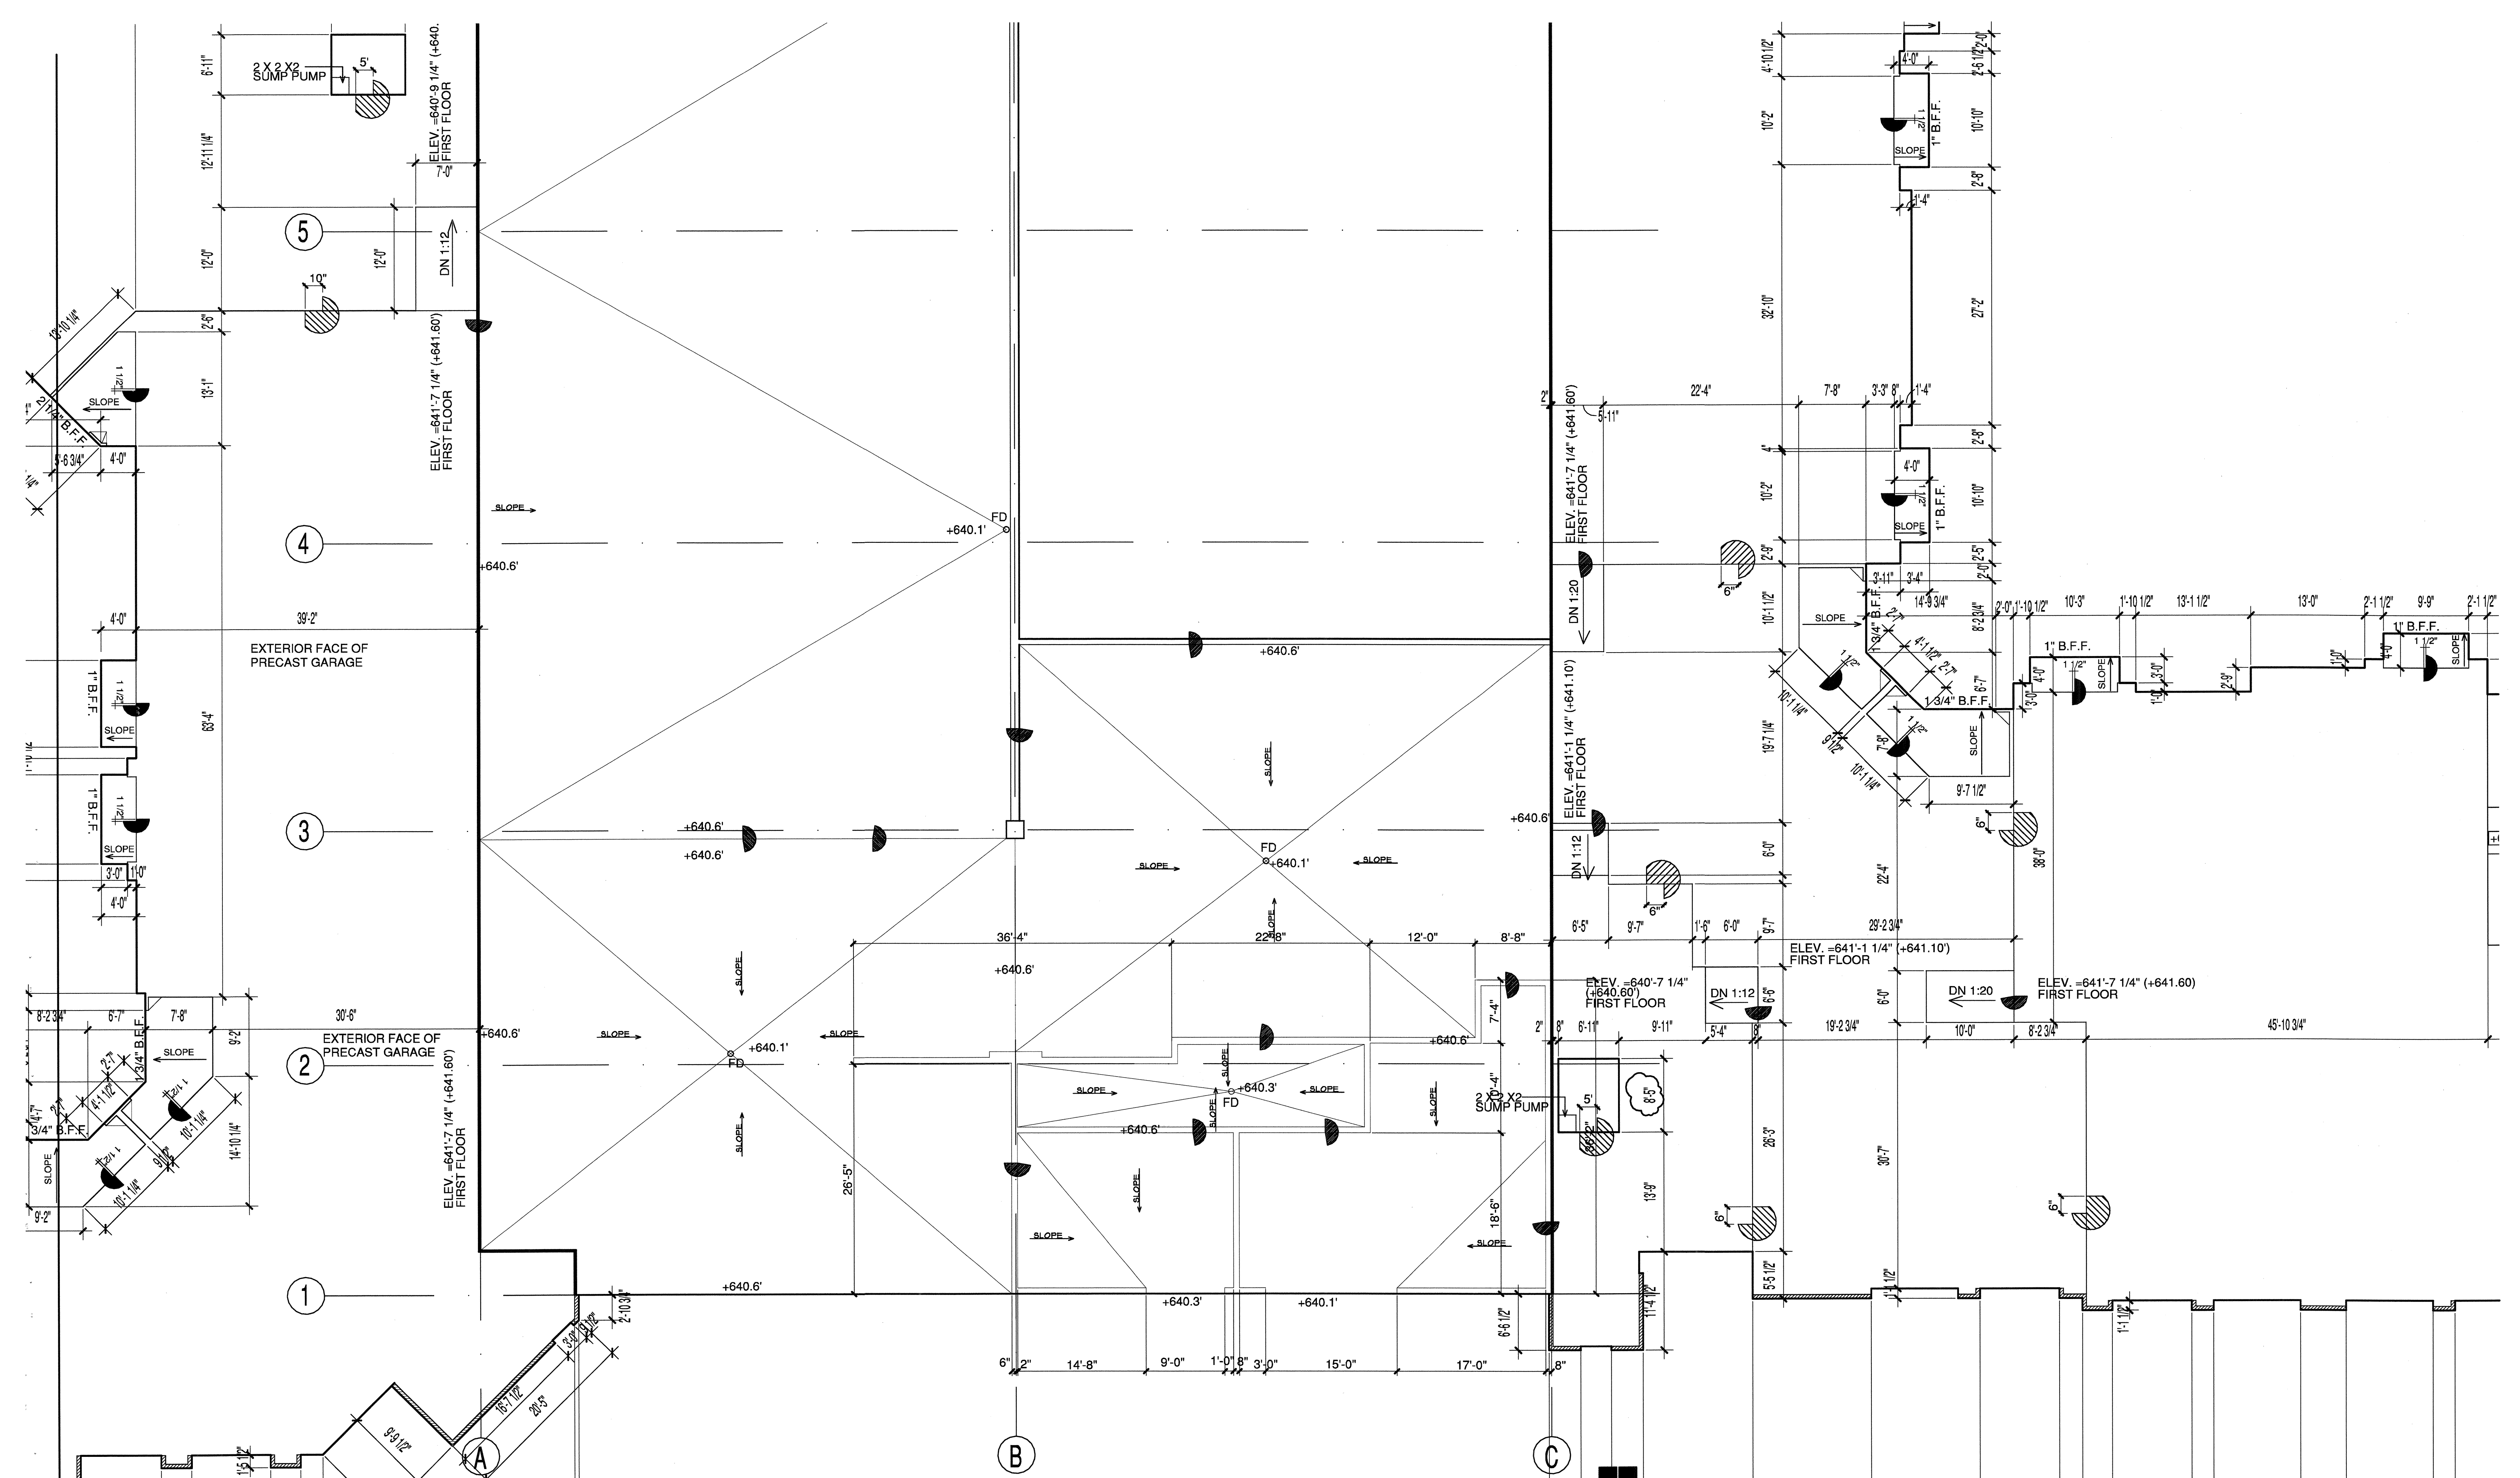

COPYRIGHT © Beeler Guest Owens Architects ALL RIGHTS RESERVED

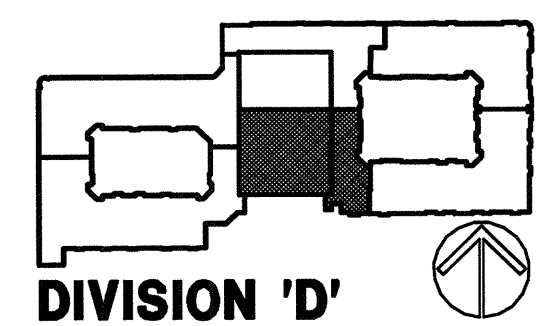


**BGO**  
architects  
4144 N. Central Expy.  
Suite 855  
Dallas, TX 75204  
214.520.8878  
bgoarchitects.com

CONSTRUCTION ISSUE  
10-17-2011


REVISIONS

**KELLER SPRINGS LOFTS**  
LOFT APARTMENTS IN ADDISON, TEXAS

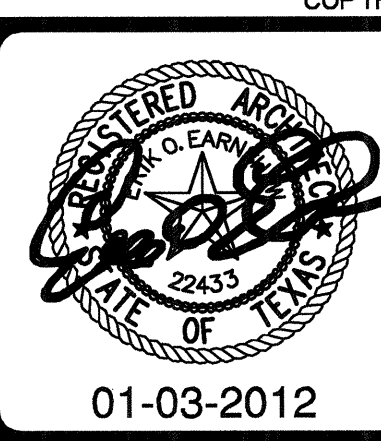

DATE  
08-05-2011  
PROJECT  
11129

SHEET NUMBER  
**FP-D**  
BLDG PLAN 'D'

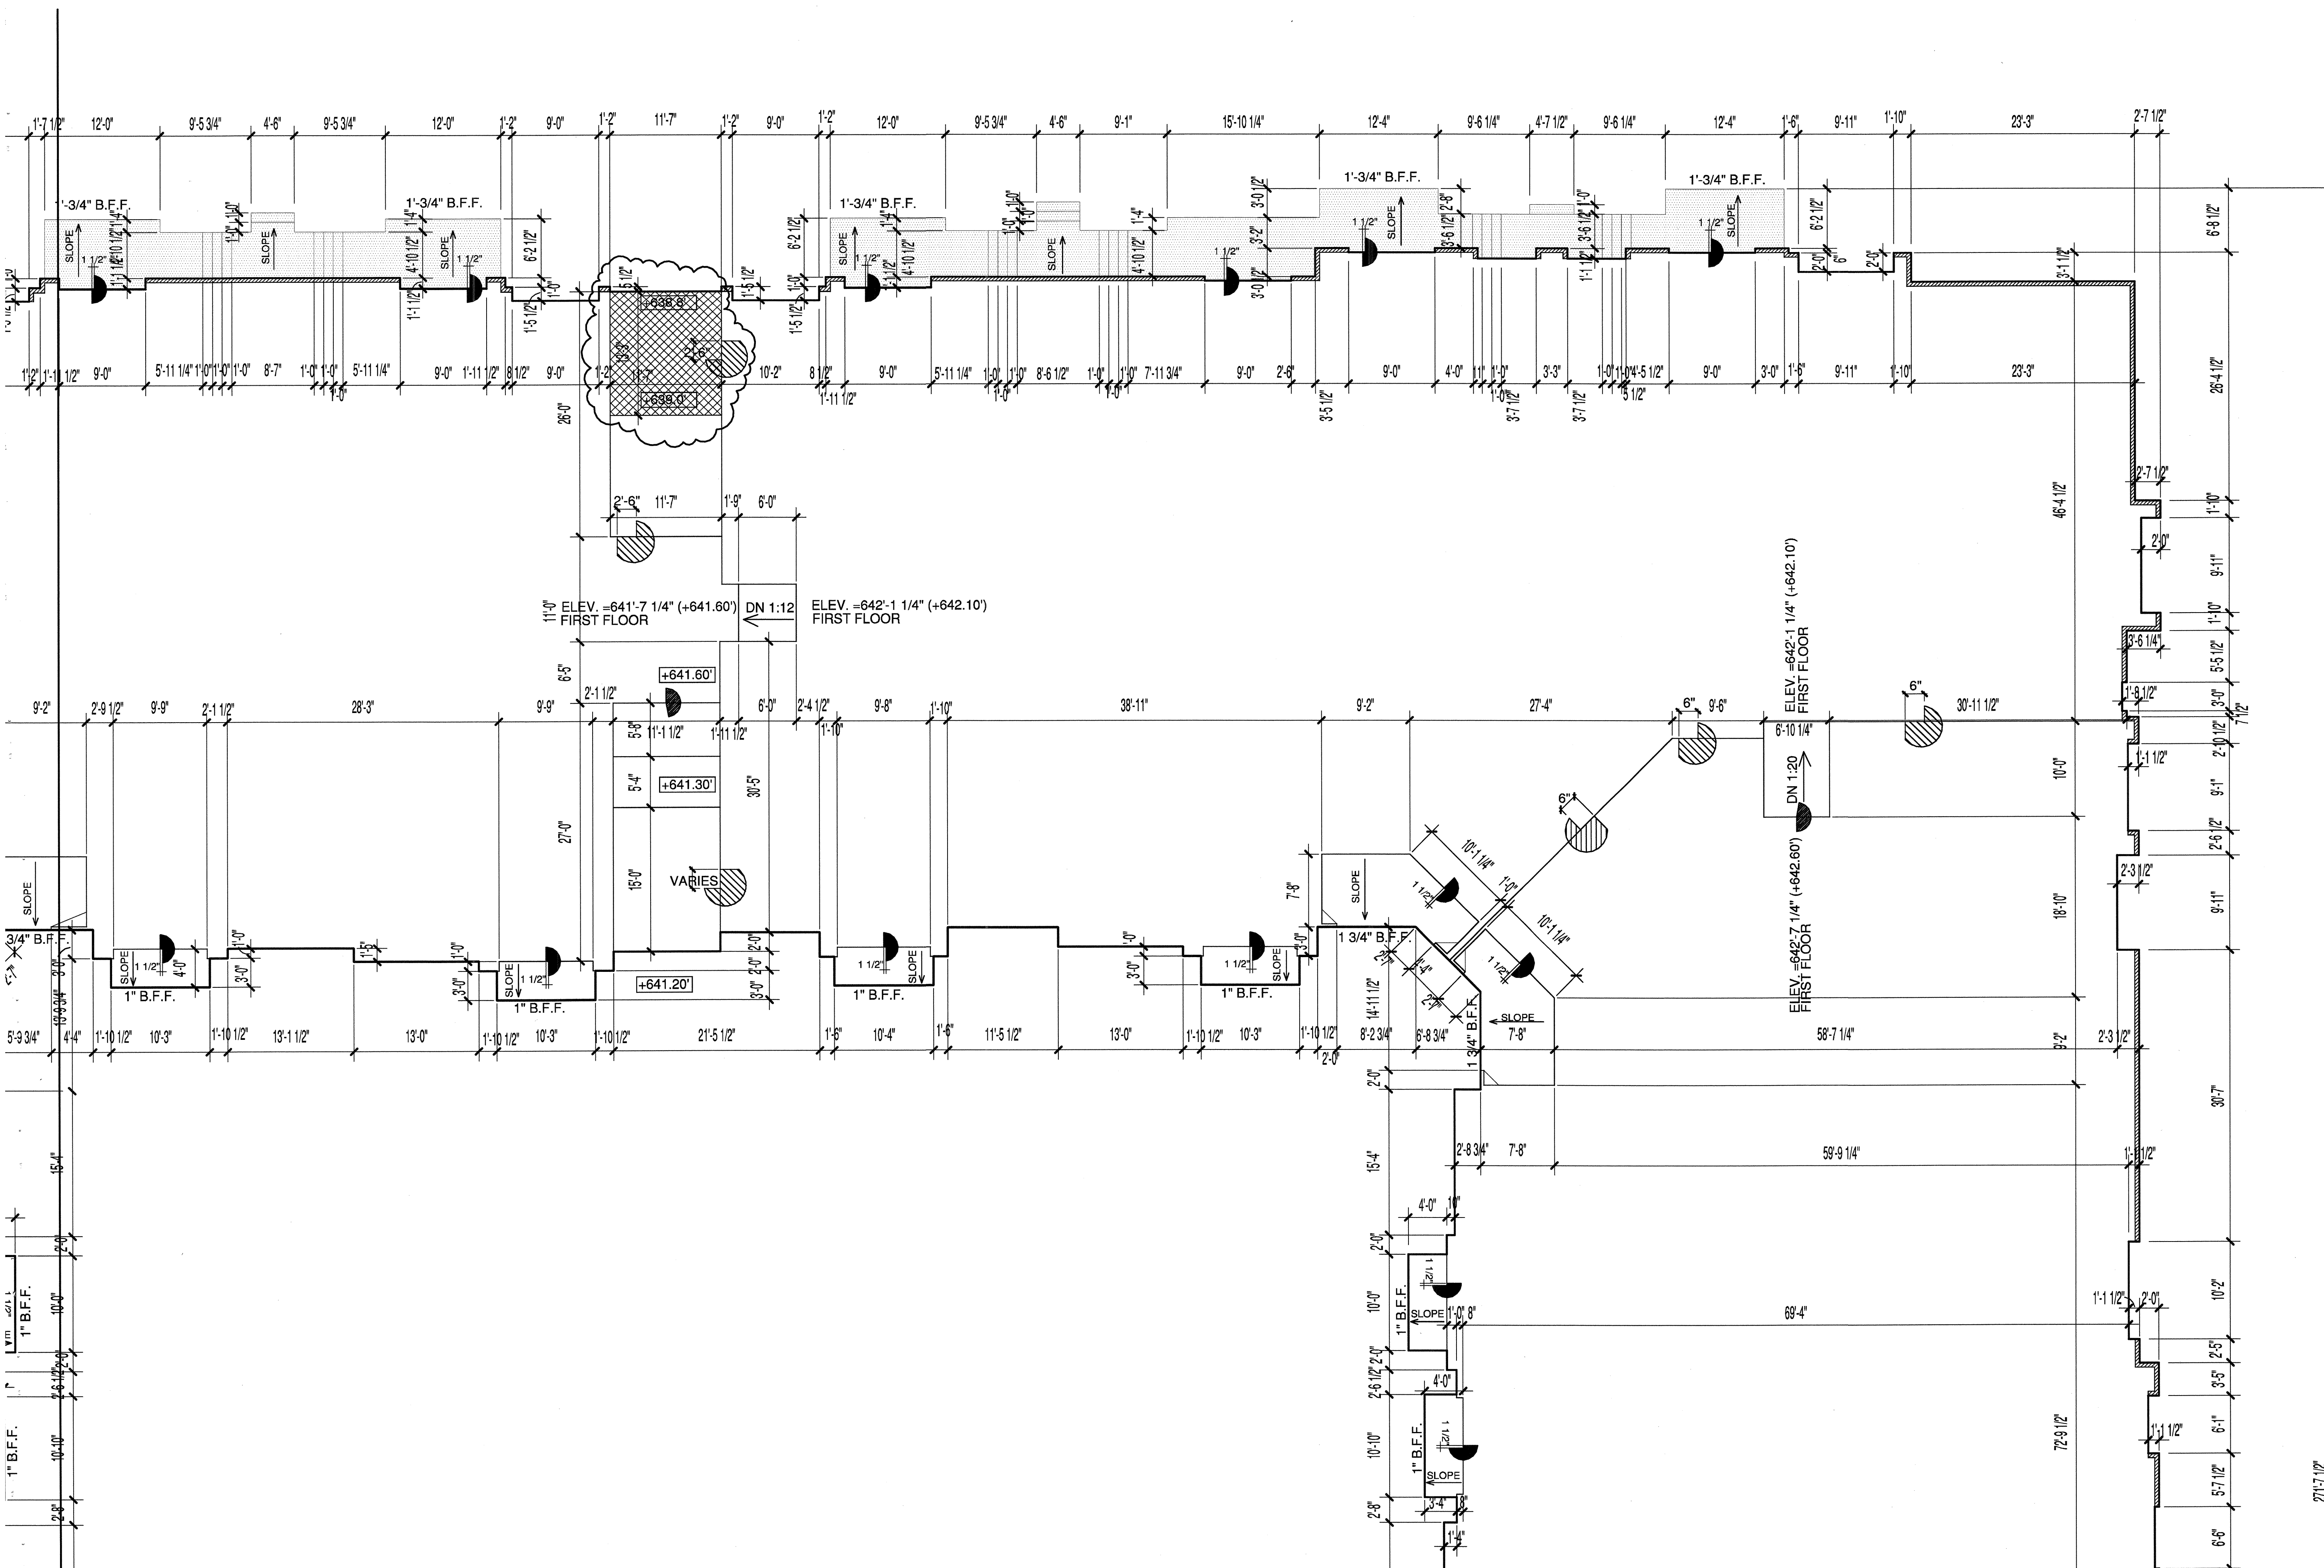

COPYRIGHT © Beeler Guest Owens Architects ALL RIGHTS RESERVED

**BGO**  
architects  
4144 N. Central Expy.  
Suite 855  
Dallas, TX 75204  
214.520.8878  
bgoarchitects.com

CONSTRUCTION ISSUE  
10-17-2011

REVISIONS

NO.	DESCRIPTION


**KELLER SPRINGS LOFTS**  
LOFT APARTMENTS IN ADDISON, TEXAS




DATE  
08-05-2011  
PROJECT  
11129

SHEET NUMBER  
**FP-E**  
BLDG PLAN 'E'

01-03-2012

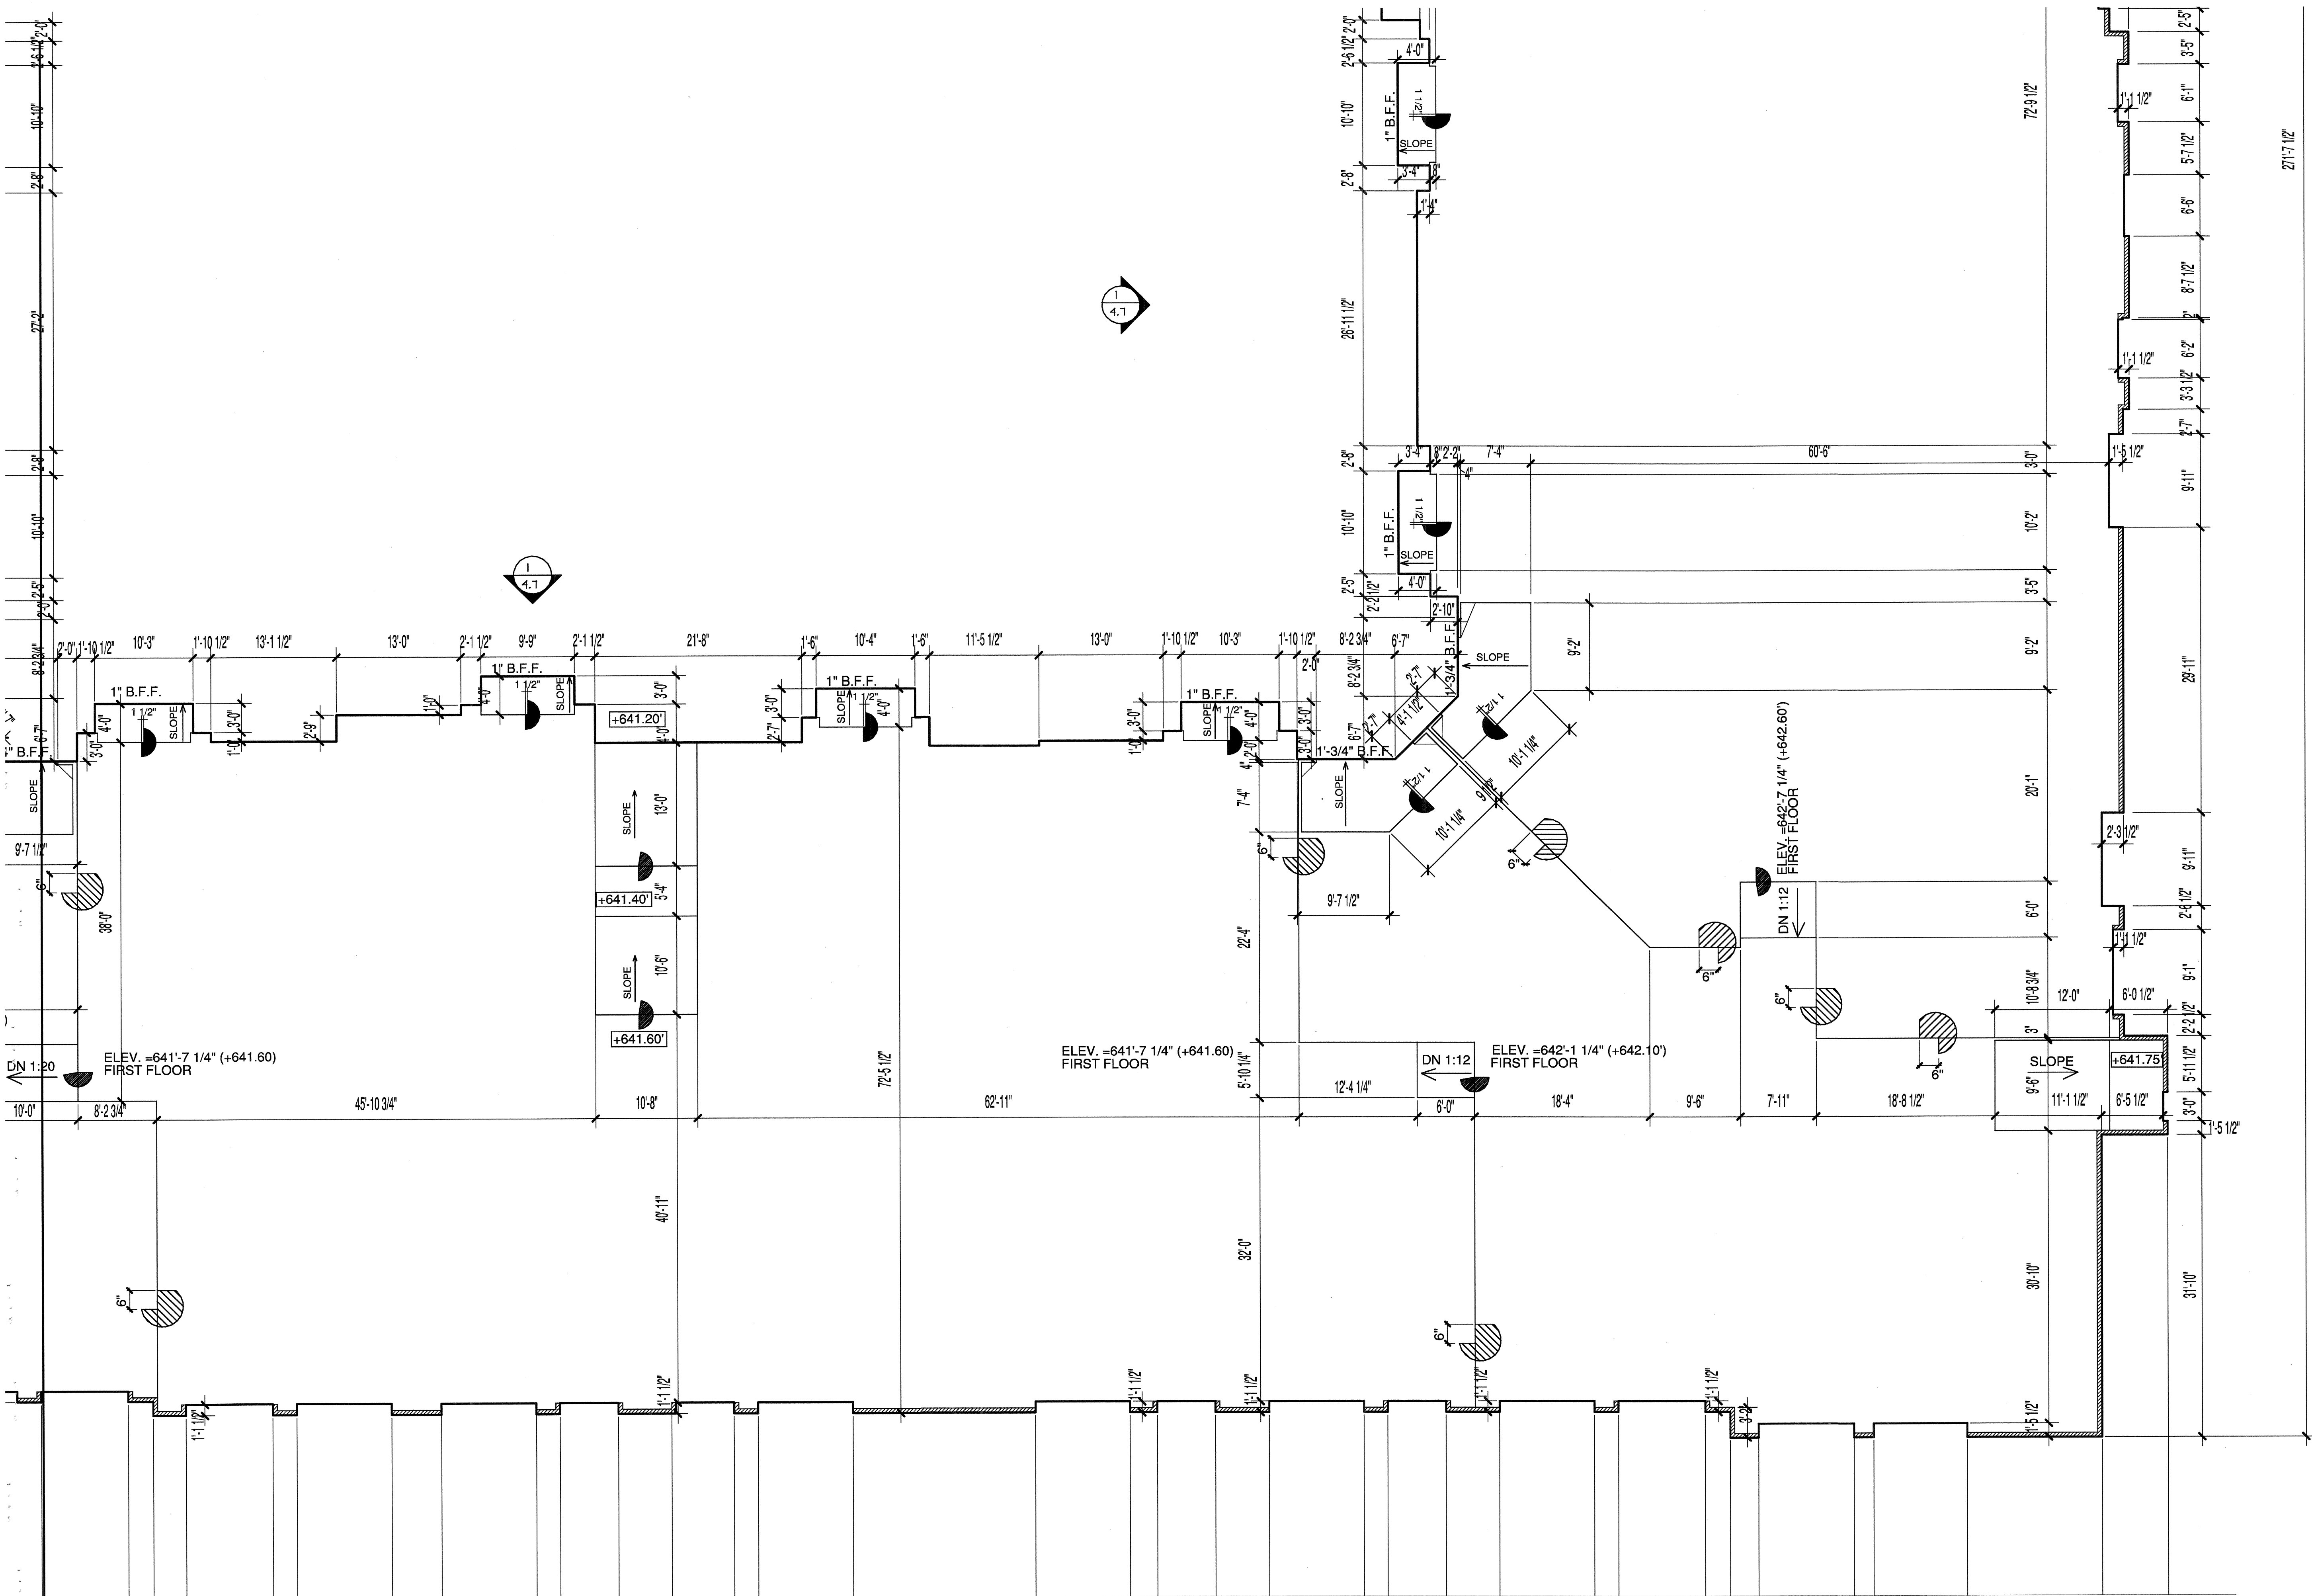

COPYRIGHT © Beeler Guest Owens Architects ALL RIGHTS RESERVED

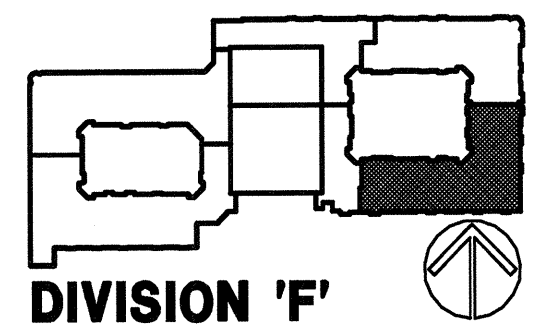

**BGO**  
architects  
4144 N. Central Expy.  
Suite 855  
Dallas, TX 75204  
214.520.8878  
bgoarchitects.com

CONSTRUCTION ISSUE  
10-17-2011

REVISIONS

**KELLER SPRINGS LOFTS**  
LOFT APARTMENTS IN ADDISON, TEXAS



DATE  
08-05-2011  
PROJECT  
11129

SHEET NUMBER  
**FP-F**  
BLDG PLAN 'F'

01-03-2012