


COPYRIGHT © Beeler Guest Owens Architects ALL RIGHTS RESERVED

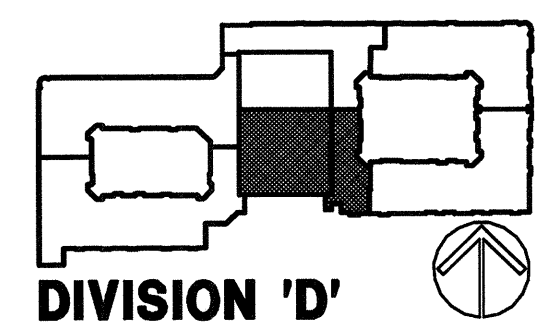

BGO
architects

4144 N. Central Expy.
Suite 855
Dallas, TX 75204
214.520.8878
bgoarchitects.com

CONSTRUCTION ISSUE
10-17-2011

REVISIONS

NO.	DESCRIPTION

KELLER SPRINGS LOFTS

LOFT APARTMENTS IN ADDISON, TEXAS



DATE
08-05-2011

PROJECT
11129

SHEET NUMBER
FP-D

BLDG PLAN 'D'