



REVISED FOR CONSTRUCTION
MAY 16, 2012

KELLER SPRINGS
CLUBHOUSE
ADDISON, TX

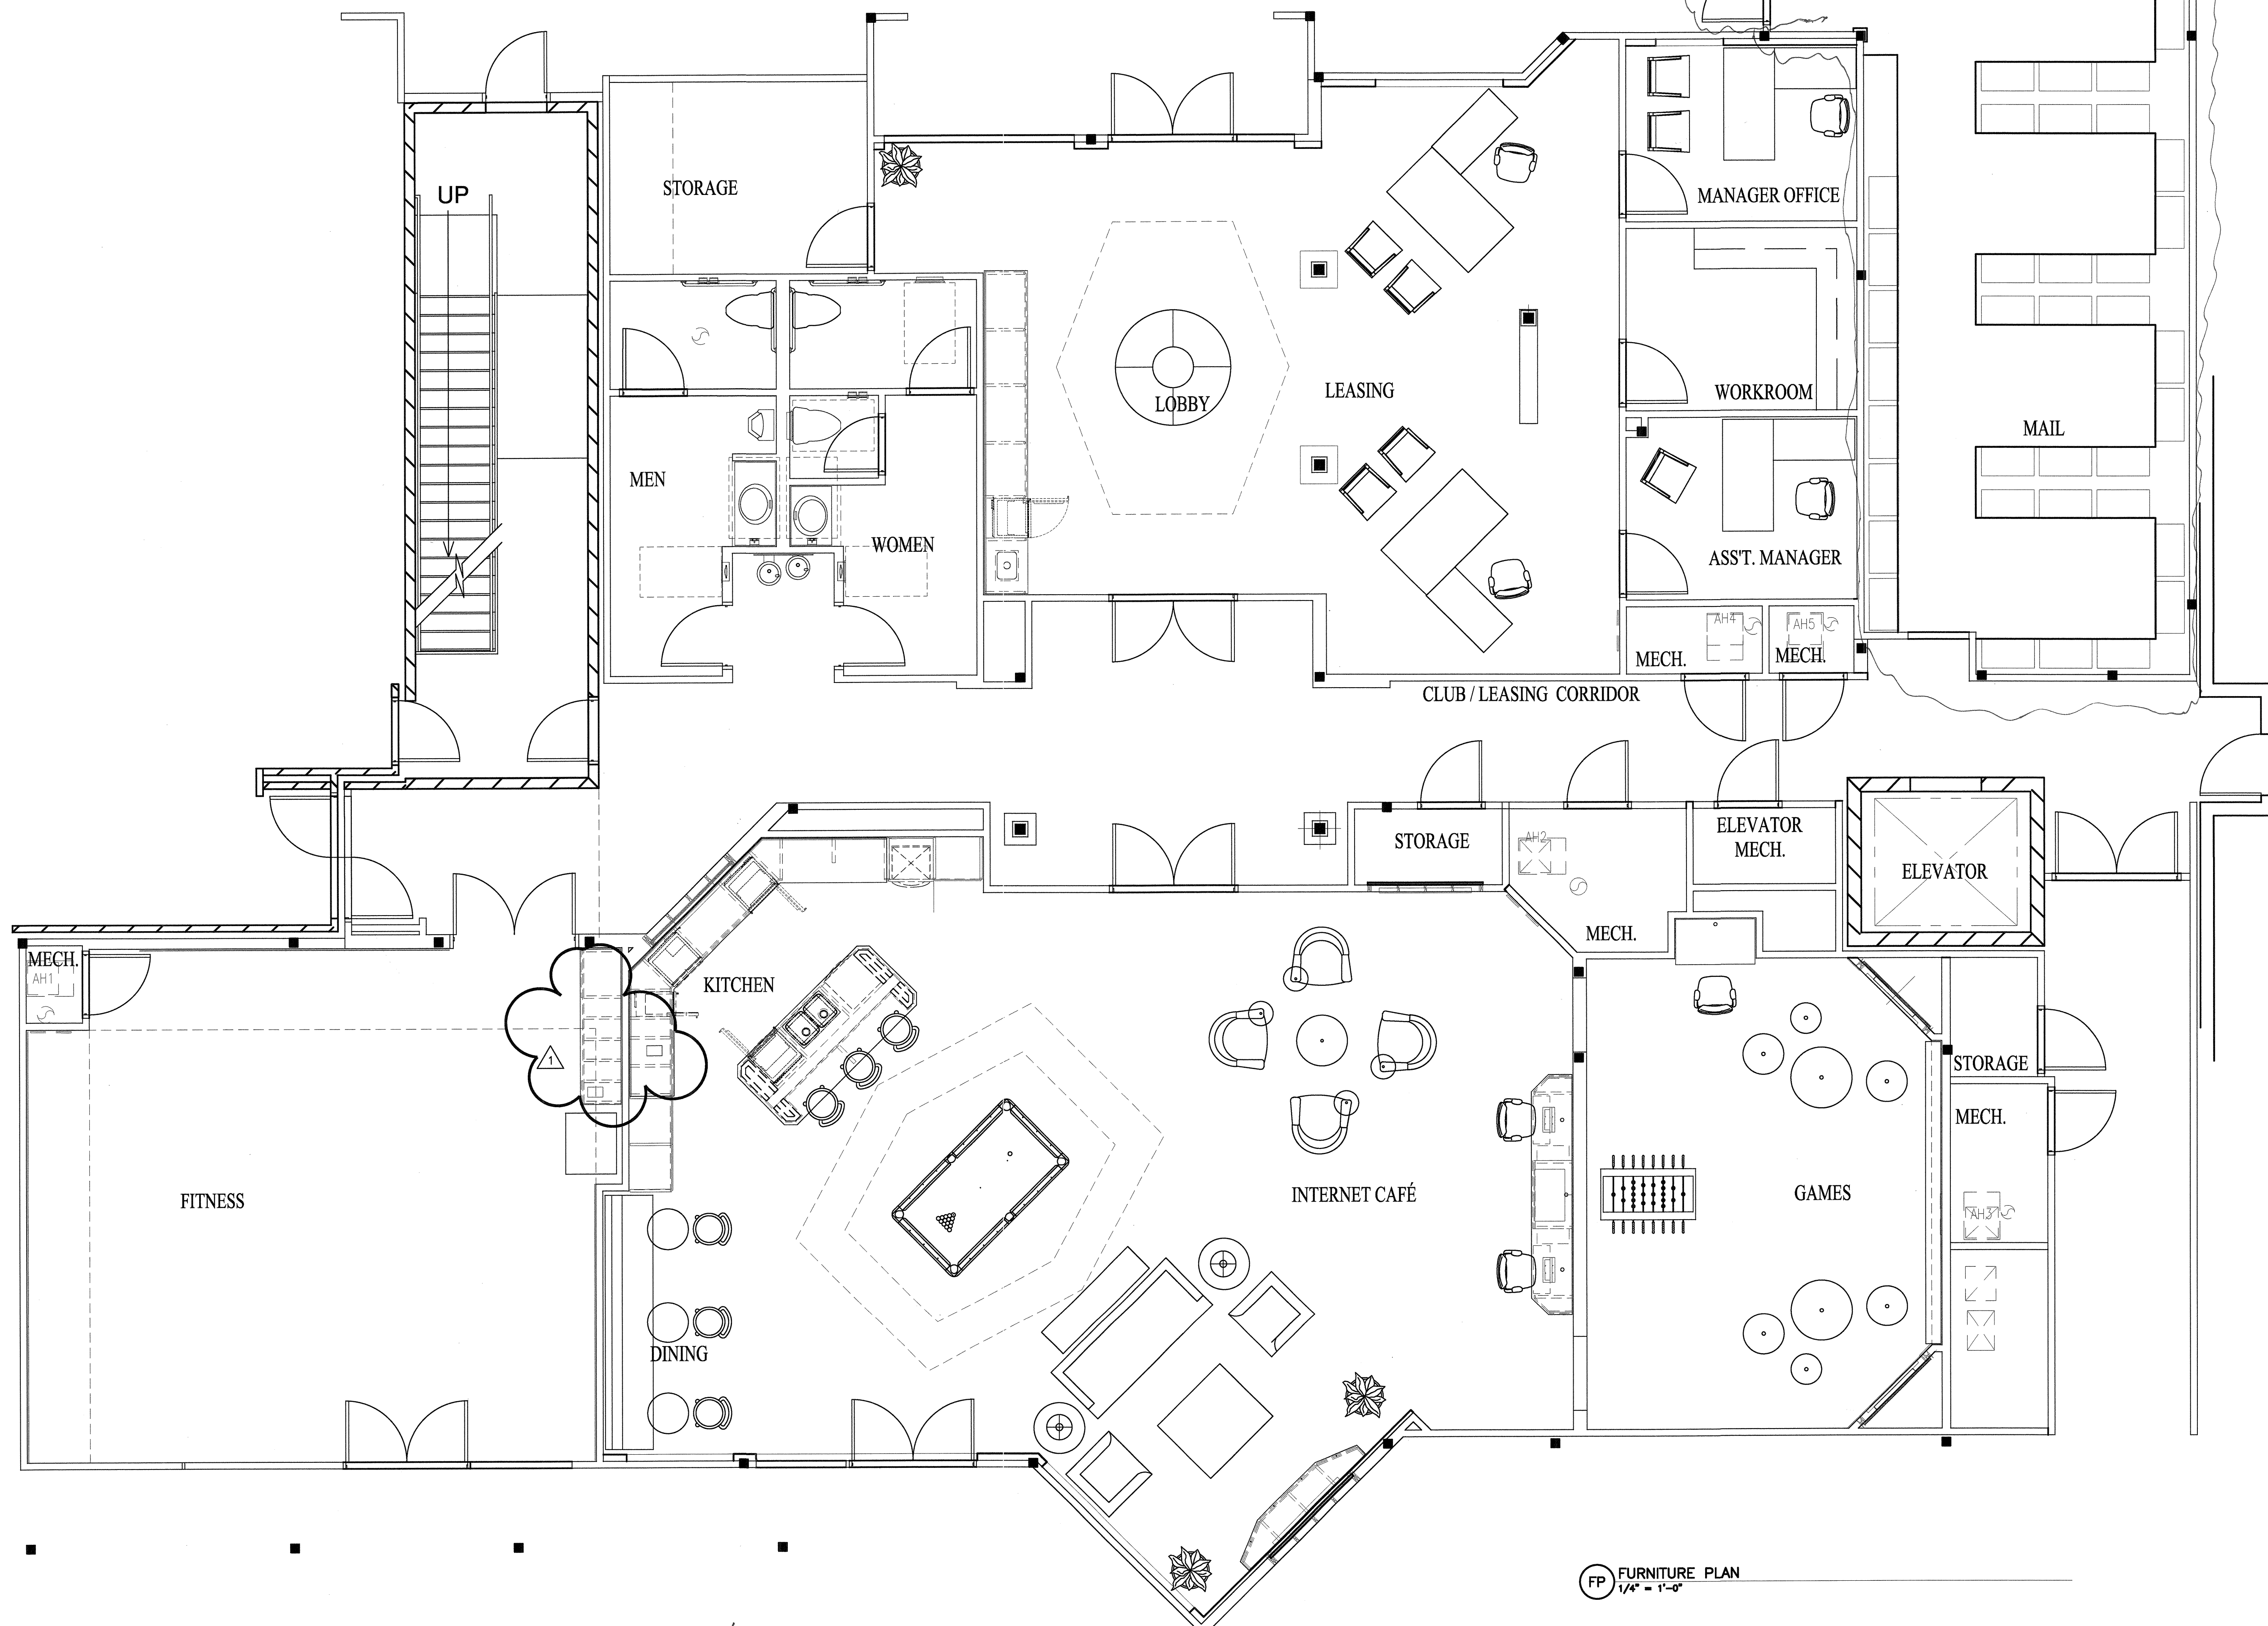

△ ADDED FABRICATION DETAILS 5-16-12

© 2012 M. FORD & ASSOCIATES INC.
THIS DOCUMENT IS PUBLISHED AS AN INSTRUMENT OF
SERVICE AND IS GIVEN IN CONFIDENCE. IT REMAINS THE
PROPERTY OF M. FORD & ASSOCIATES, INC.
THIS DOCUMENT AND THE INFORMATION CONTAINED WITHIN
MAY NOT BE DUPLICATED OR DISCLOSED WITHOUT WRITTEN
CONSENT OF M. FORD & ASSOCIATES, INC. HOUSTON, TEXAS

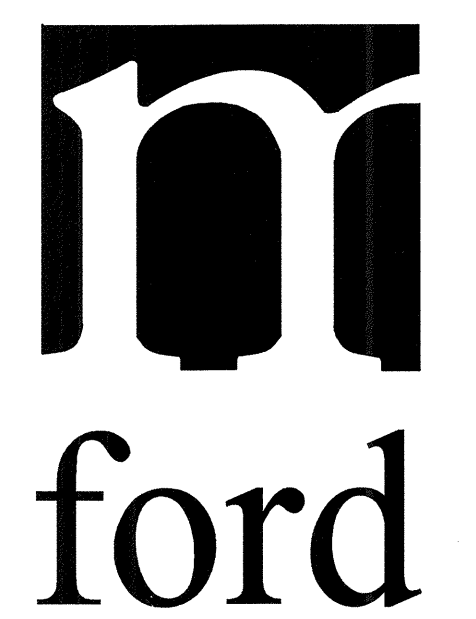

m. ford & associates
interior design
99 detersing street
suite 165
houston, tx 77007
phone 713-630-0800
fax 713-630-0814
mford@mfordassociates.com
www.mfordassociates.com



SHEET NO.

ID.FP

FURNITURE PLAN

FP FURNITURE PLAN
1/4" = 1'-0"