


REVISED FOR CONSTRUCTION
MAY 16, 2012

KELLER SPRINGS
CLUBHOUSE
ADDISON, TX

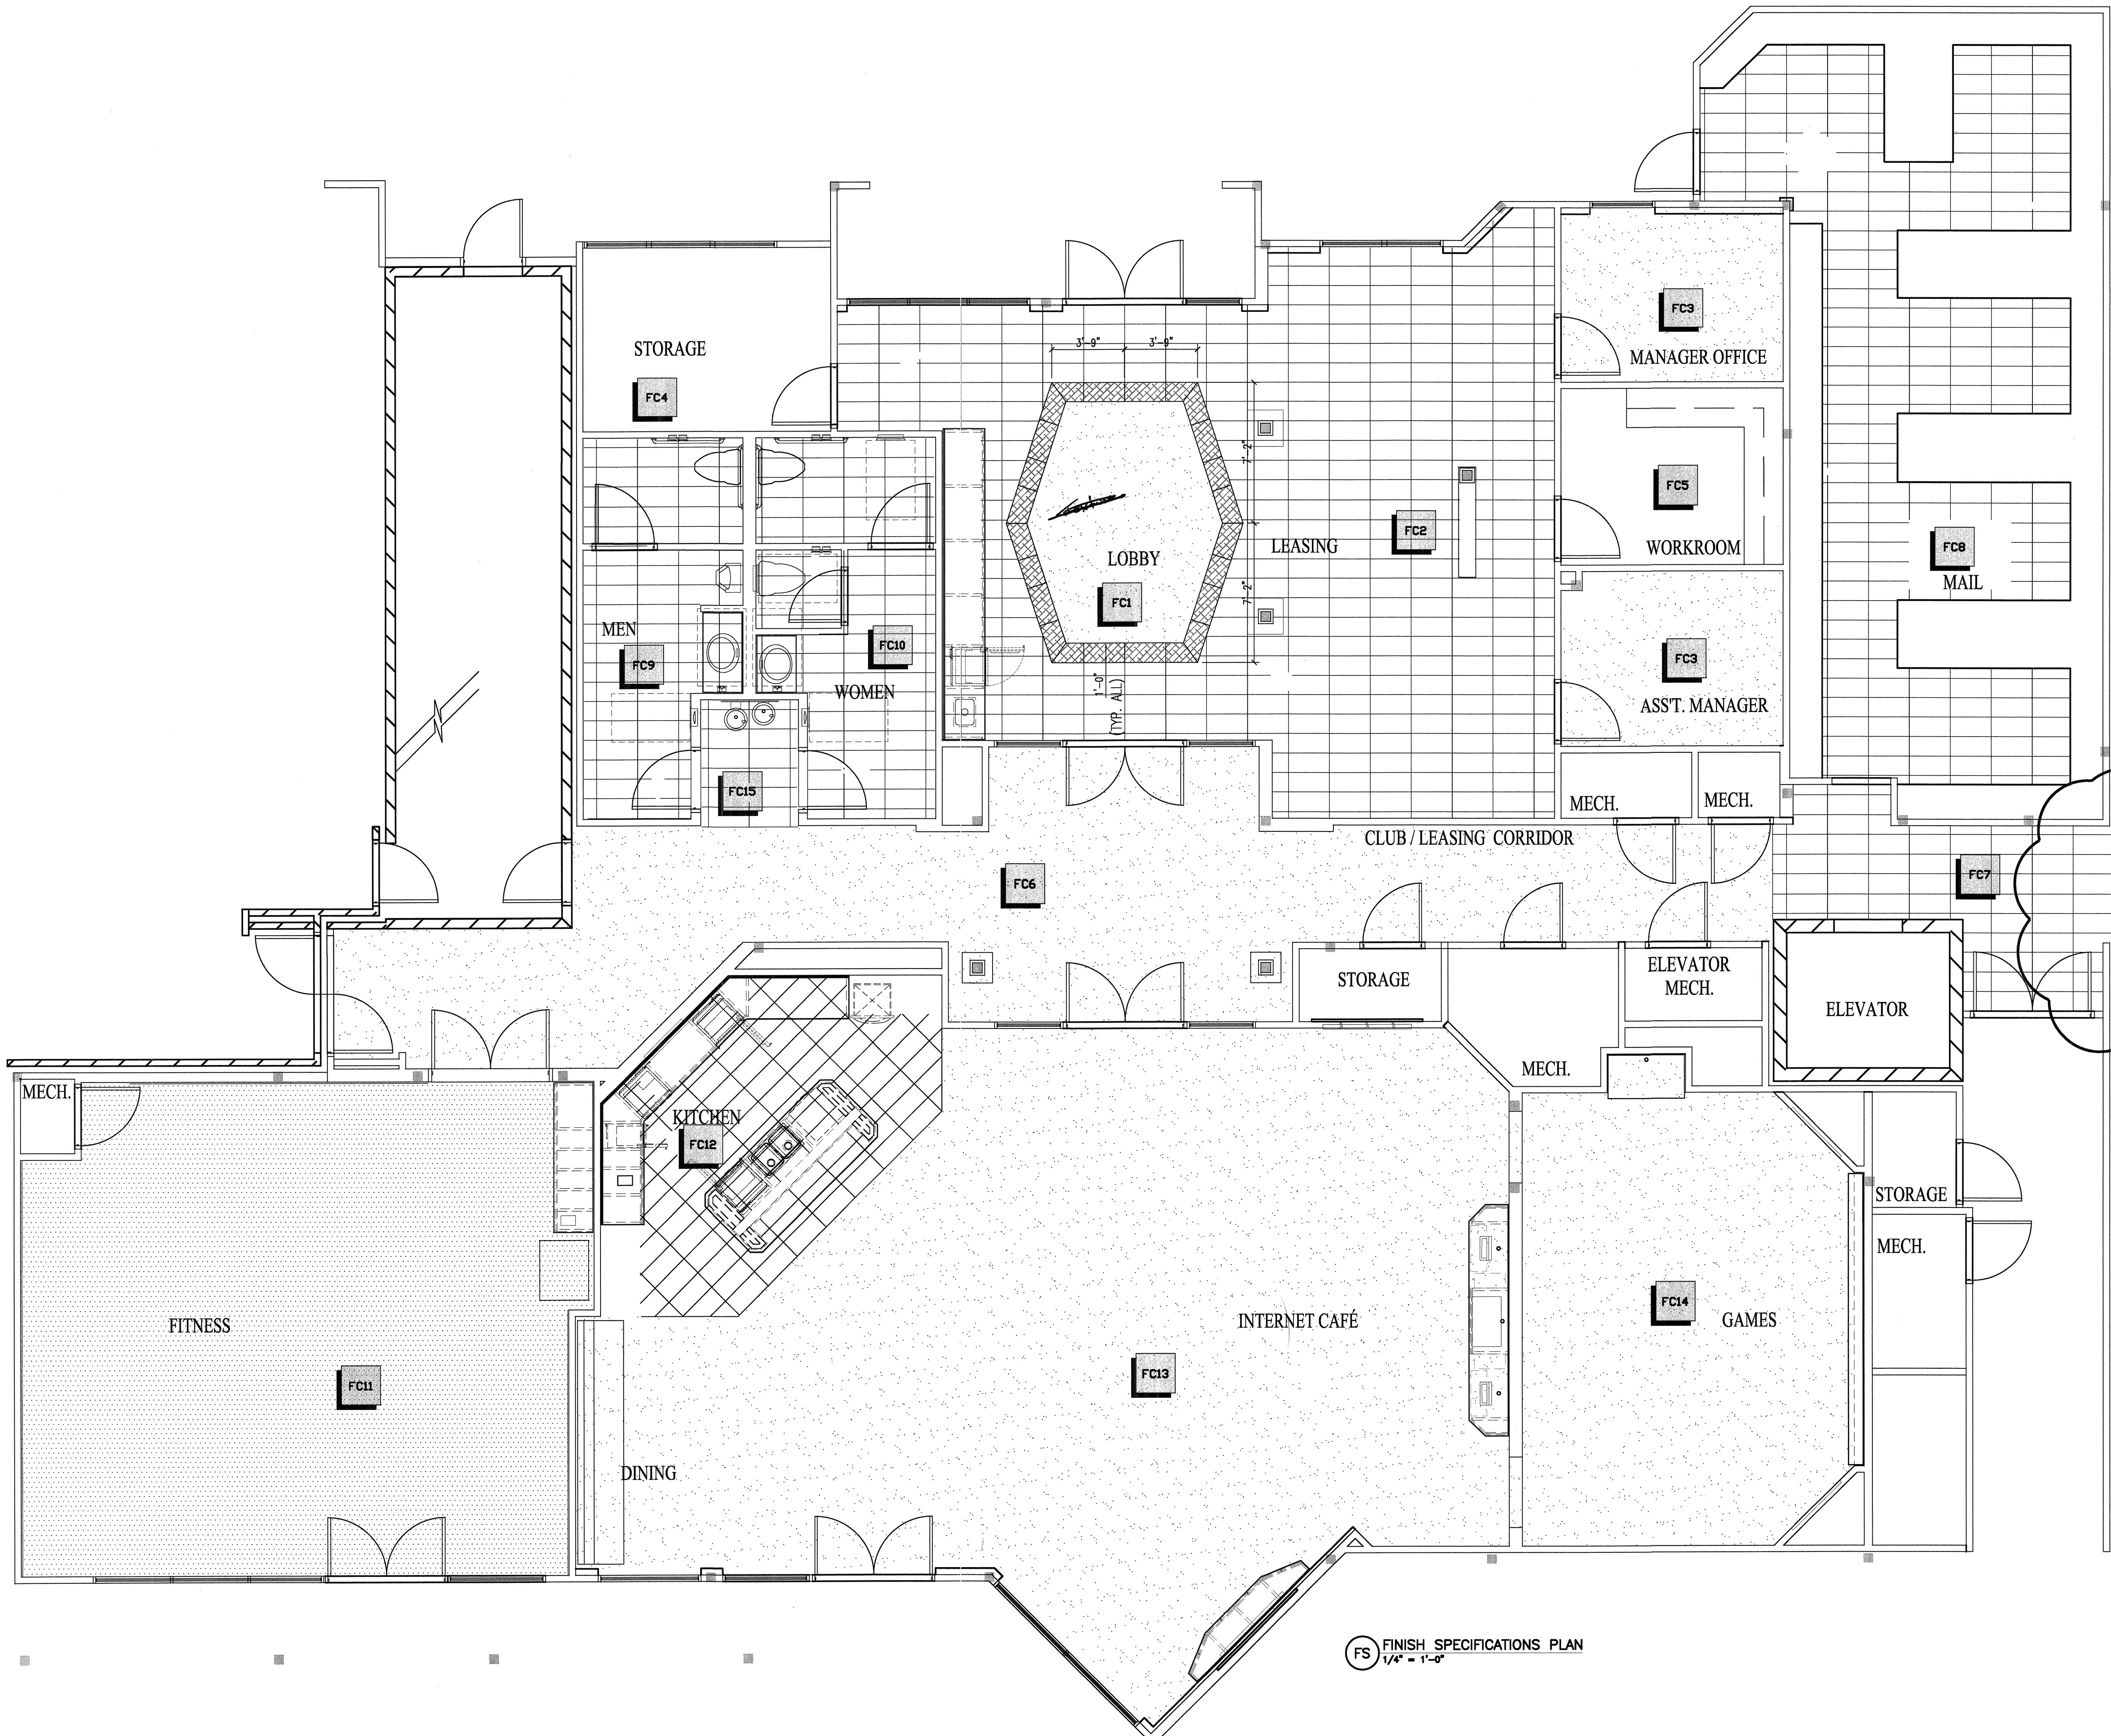


FINISH SPECIFICATIONS PLAN

▲ ADDED FABRICATION DETAILS 5-16-12
© 2012 M. FORD & ASSOCIATES INC.
THIS DOCUMENT IS PUBLISHED AS AN INSTRUMENT OF SERVICE AND IS GIVEN IN CONFIDENCE. IT REMAINS THE PROPERTY OF M. FORD & ASSOCIATES, INC. THIS DOCUMENT AND THE INFORMATION CONTAINED WITHIN MAY NOT BE DUPLICATED OR REPRODUCED WITHOUT THE WRITTEN CONSENT OF M. FORD & ASSOCIATES, INC. HOUSTON, TEXAS



m. ford & associates
interior design
99 deterring street
suite 165
houston, tx 77007
phone 713-630-0800
fax 713-630-0814
mford@mfordassociates.com
www.mfordassociates.com

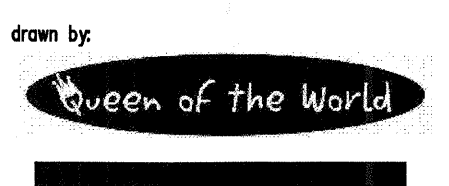

SHEET NO.

ID.FS.0

FS FINISH SPECIFICATIONS PLAN
1/4" = 1'-0"