


KELLER SPRINGS CLUBHOUSE  
ADDISON, TX


REVISED FOR CONSTRUCTION  
MAY 16, 2012

ADDED FABRICATION DETAILS 5-16-12

© 2012 M. FORD & ASSOCIATES INC.  
THIS DOCUMENT IS PUBLISHED AS AN INSTRUMENT OF SERVICE AND IS GIVEN IN CONFIDENCE. IT REMAINS THE PROPERTY OF M. FORD & ASSOCIATES, INC. THIS DOCUMENT AND THE INFORMATION CONTAINED WITHIN MAY NOT BE DUPLICATED OR DISCLOSED WITHOUT WRITTEN CONSENT OF M. FORD & ASSOCIATES, INC. HOUSTON, TEXAS

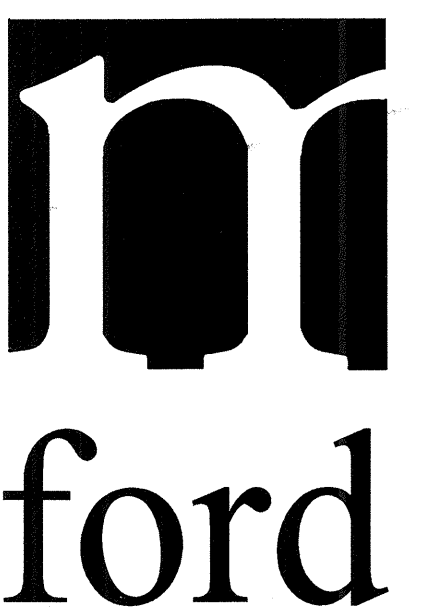



m. ford & associates  
interior design  
99 detersing street  
suite 165  
houston, tx 77007  
phone 713-630-0800  
fax 713-630-0814  
mford@mfordassociates.com  
www.mfordassociates.com

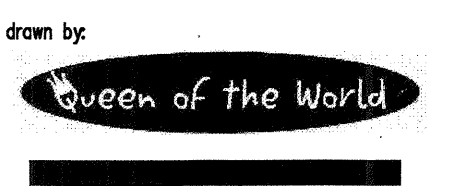

SHEET NO.

ID.2A

ENLARGED PLAN & SECTION @  
LEASING LOBBY LIGHT COVE

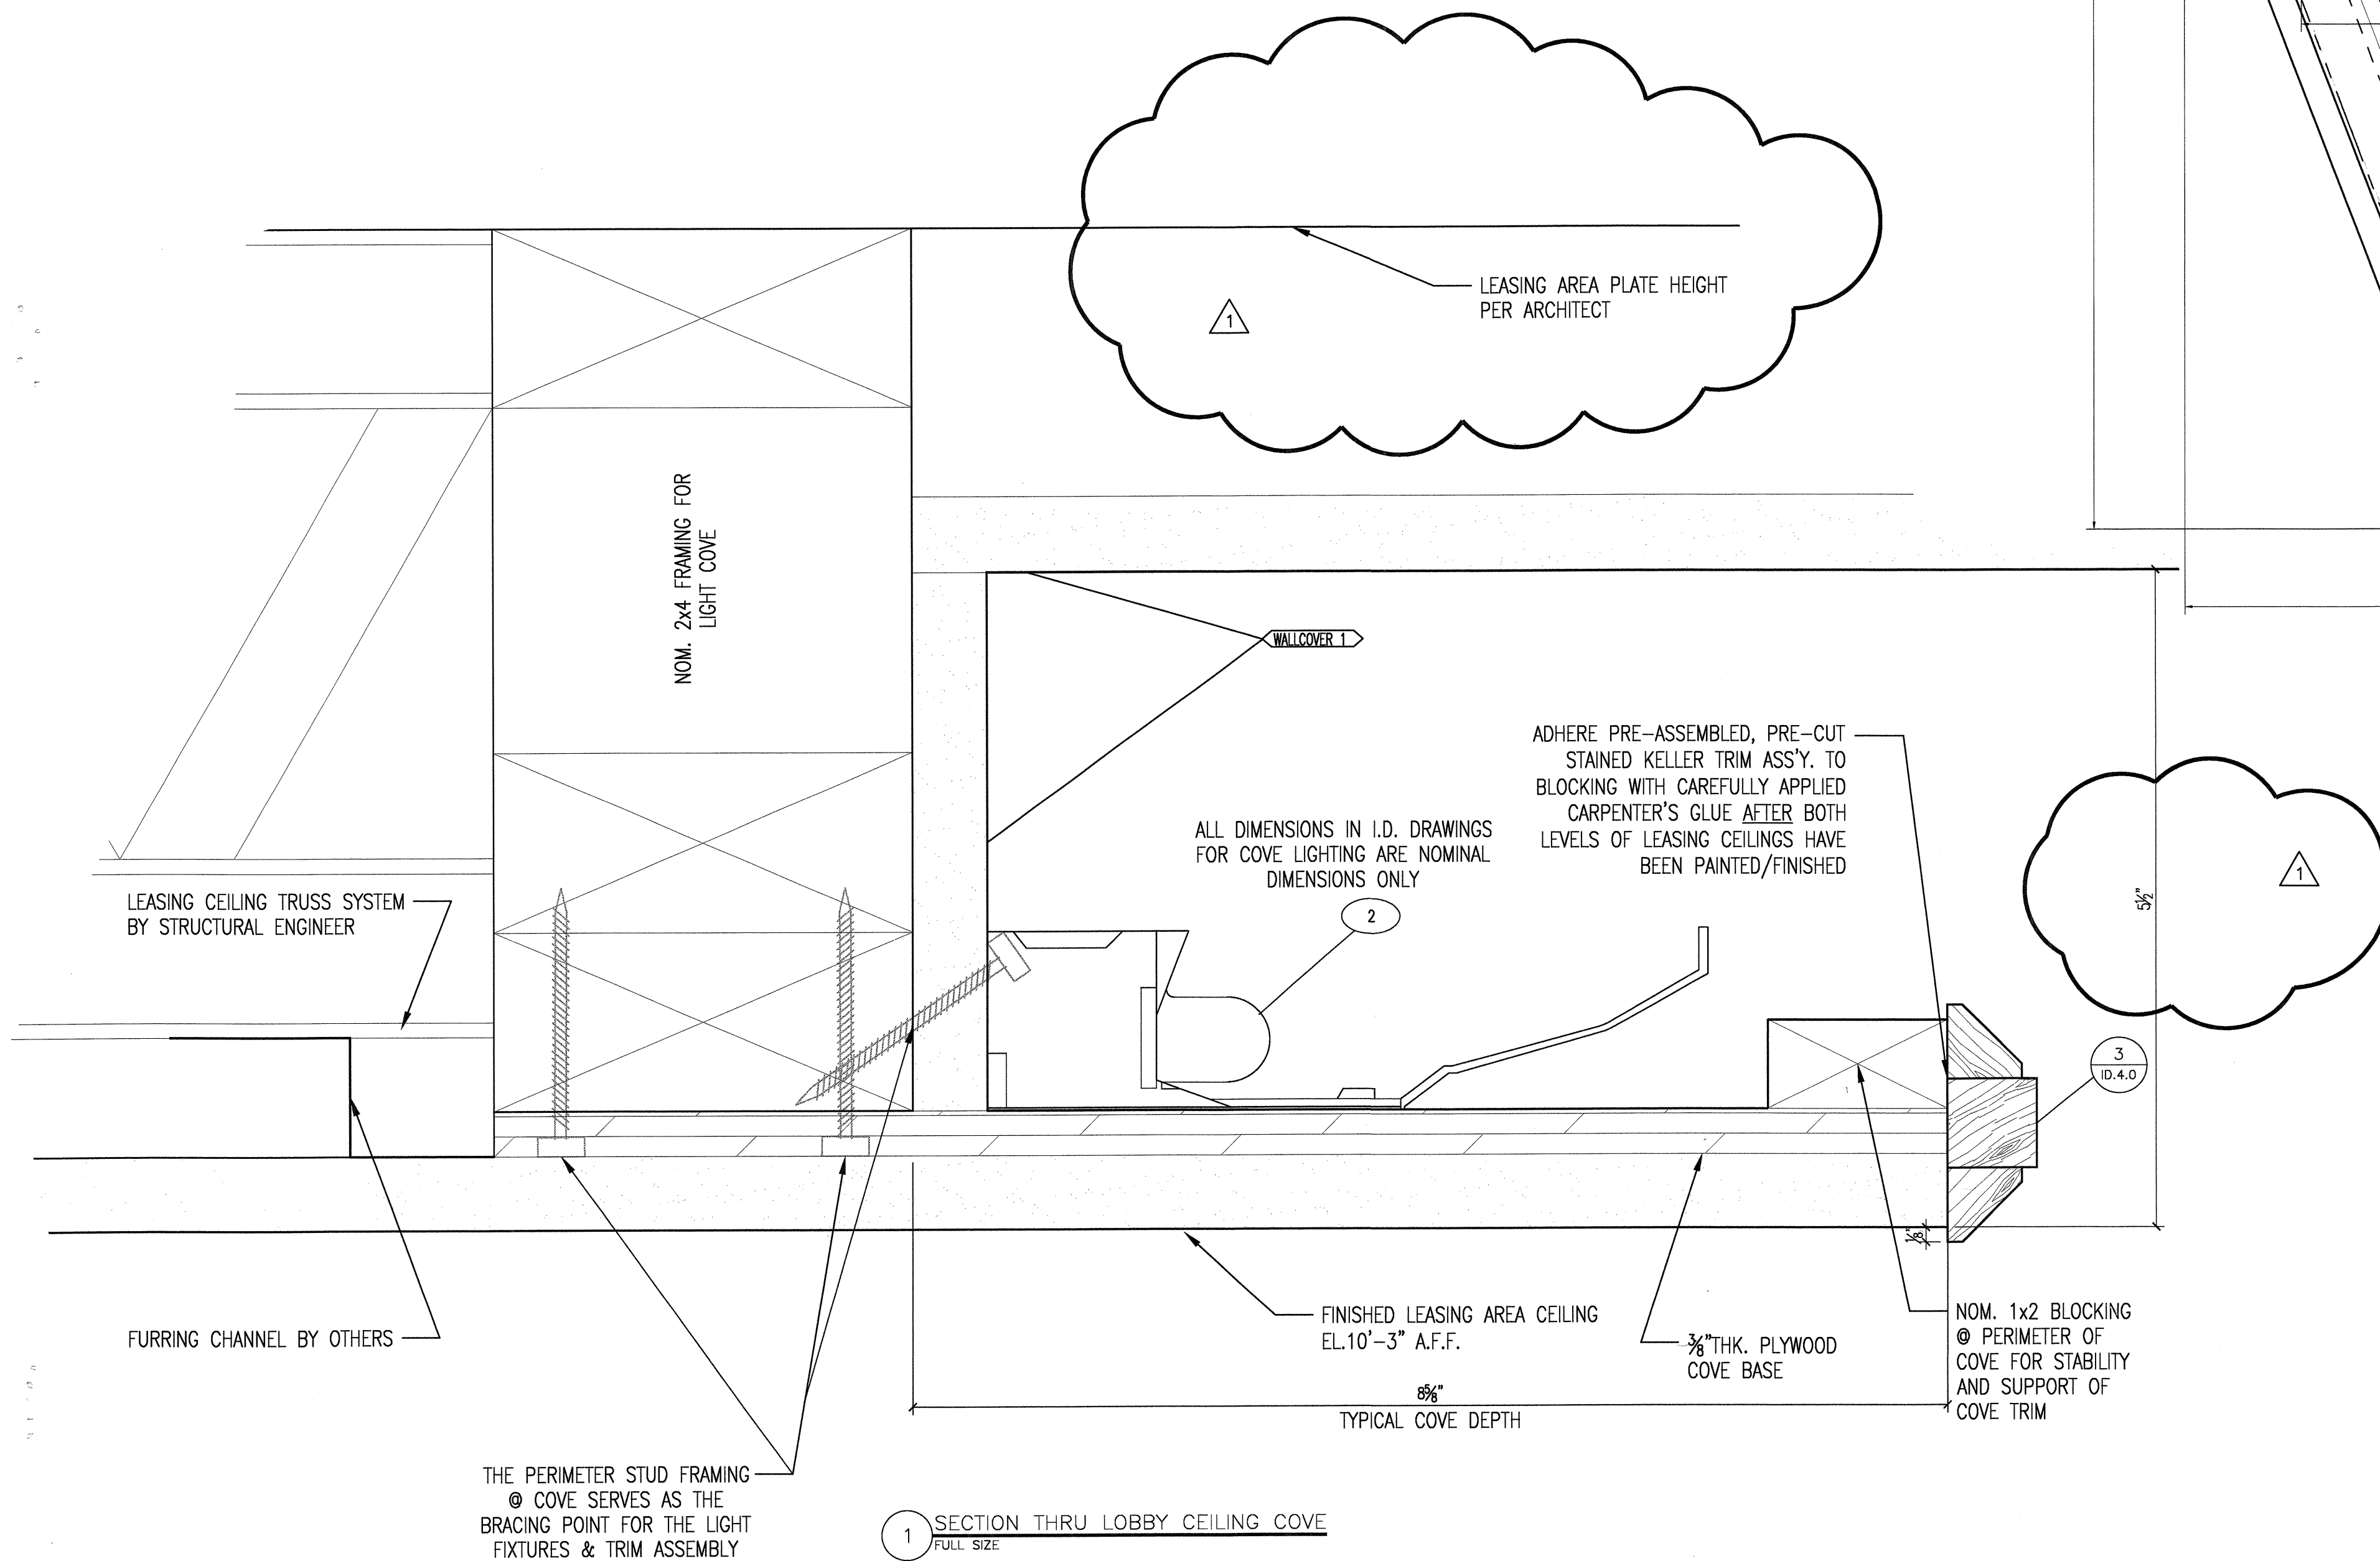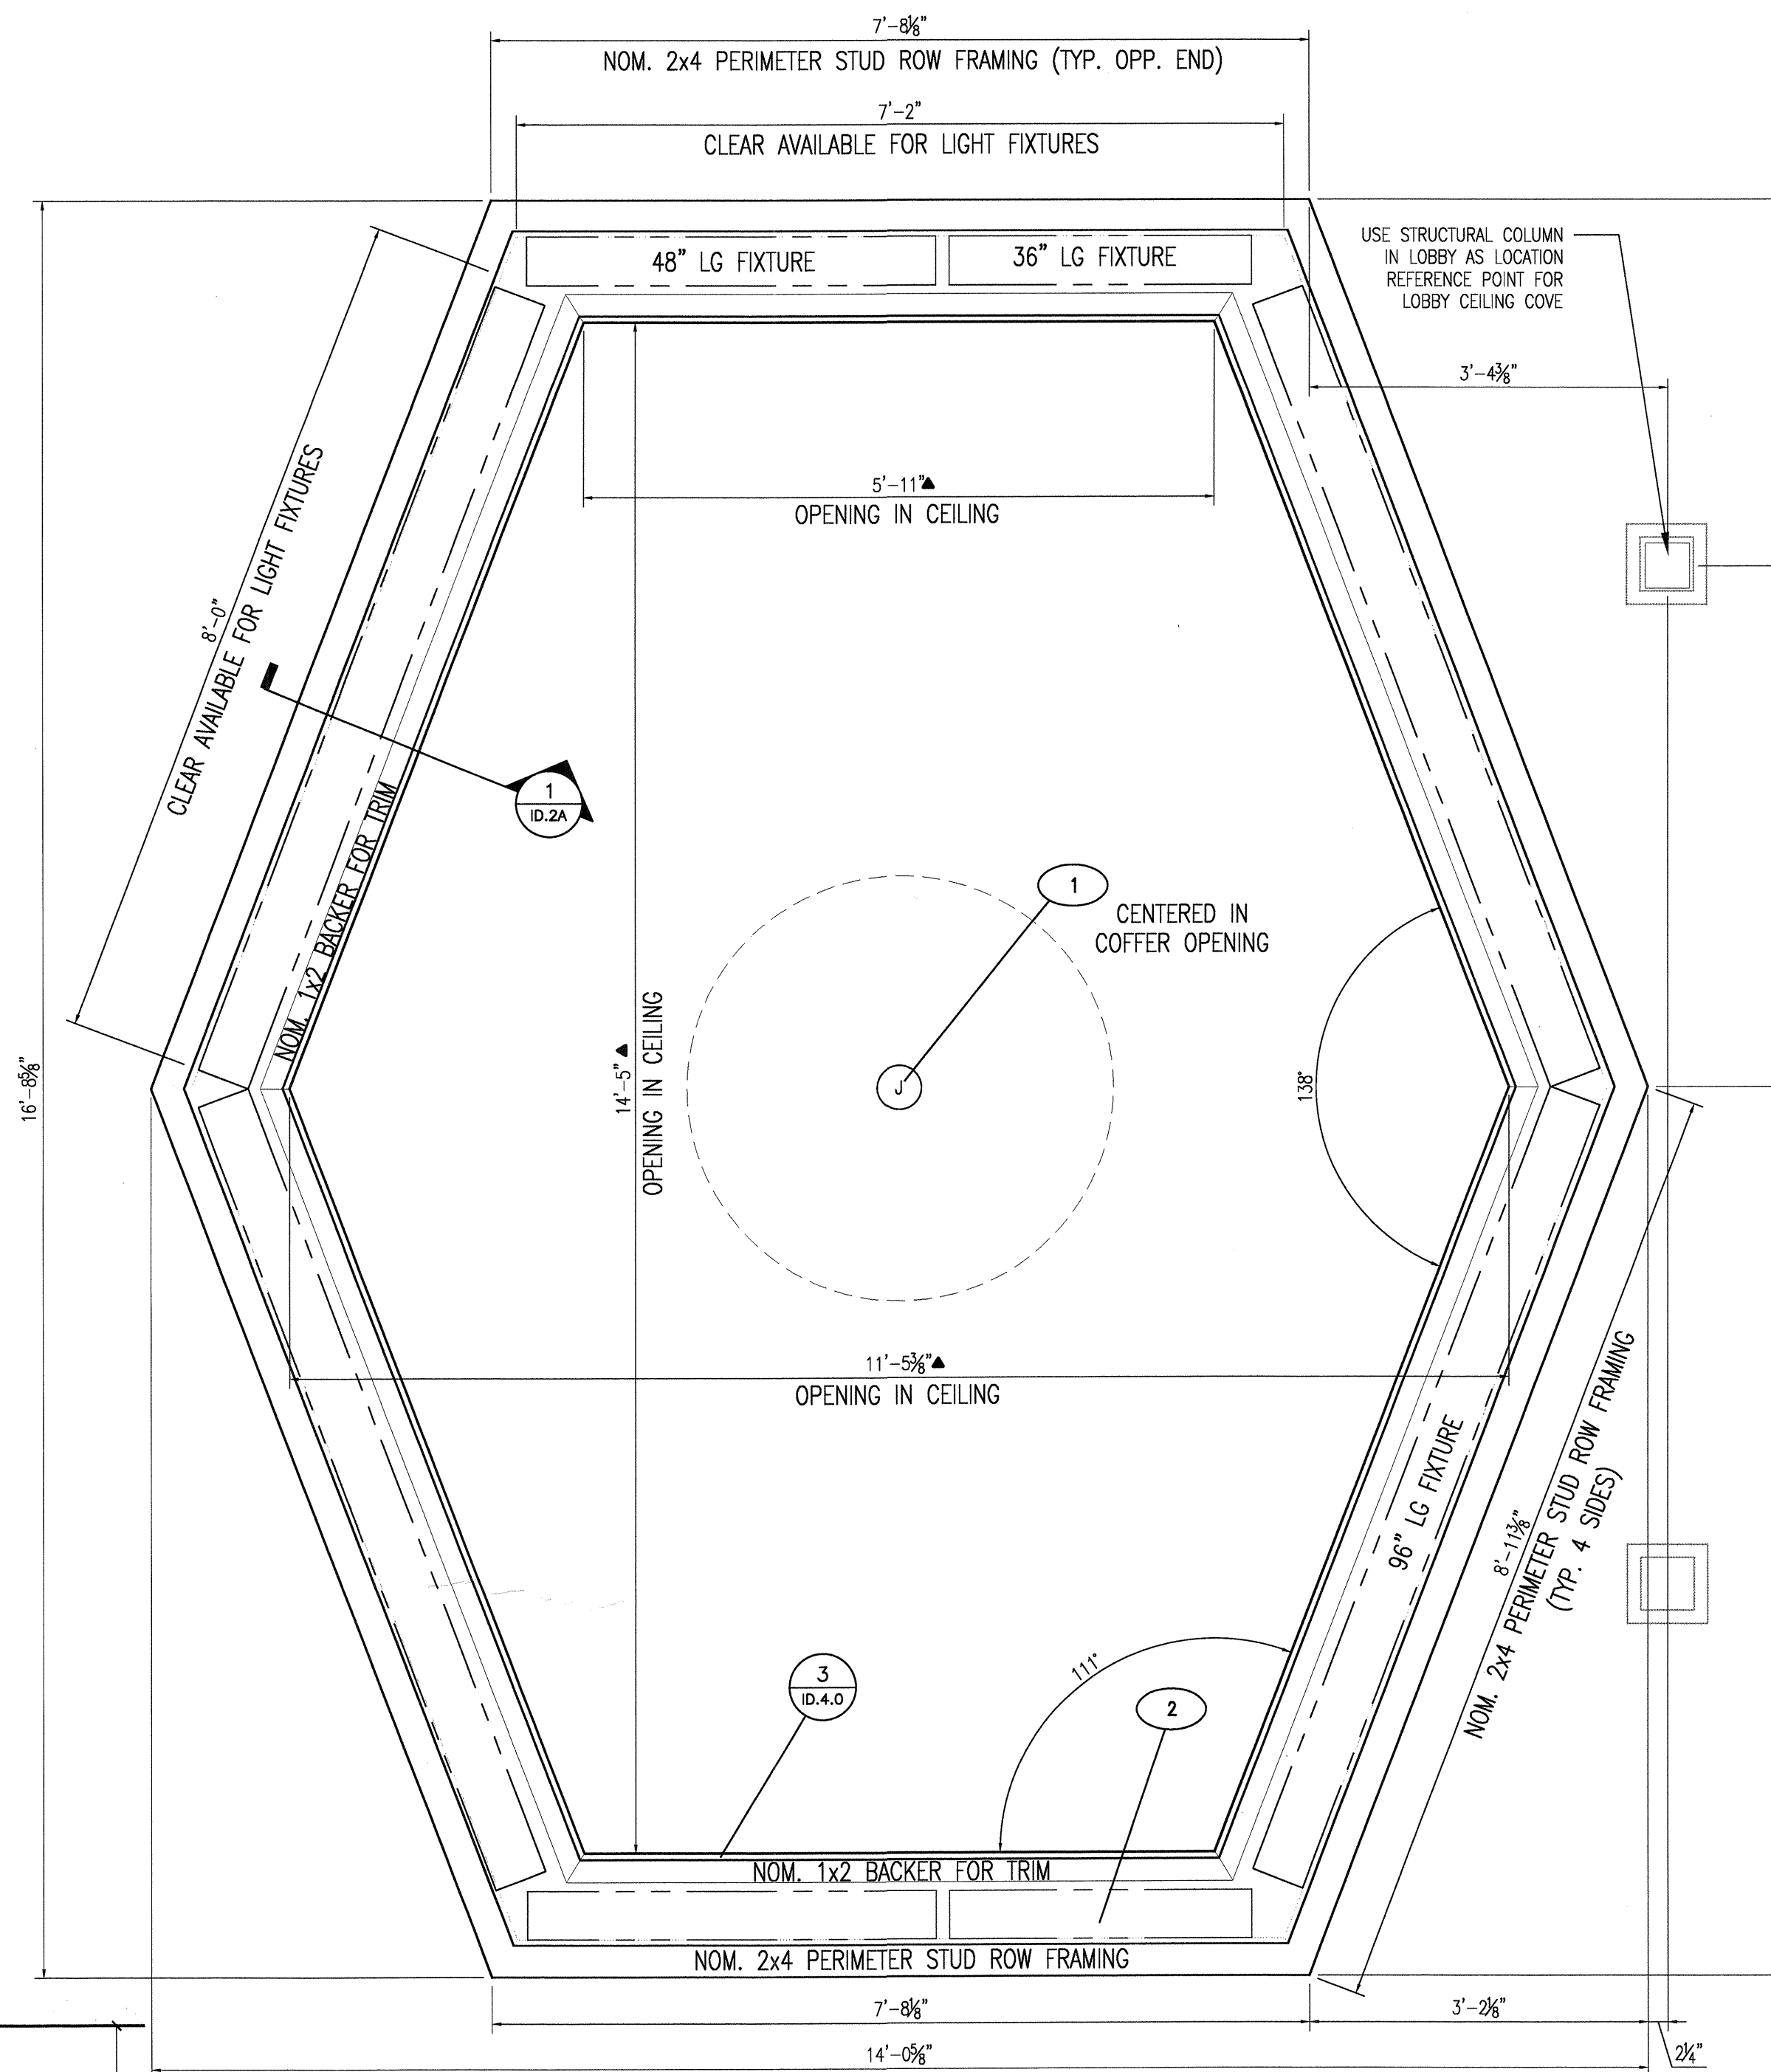

☆ ALL CEILING HEIGHTS PER ARCHITECT  
1