


ISSUED FOR CONSTRUCTION
APRIL 23, 2012


KELLER SPRINGS
CLUBHOUSE
ADDISON, TX

ENLARGED REFLECTED CEILING PLAN
@ GREAT ROOM CEILING PANELING & SOFFIT

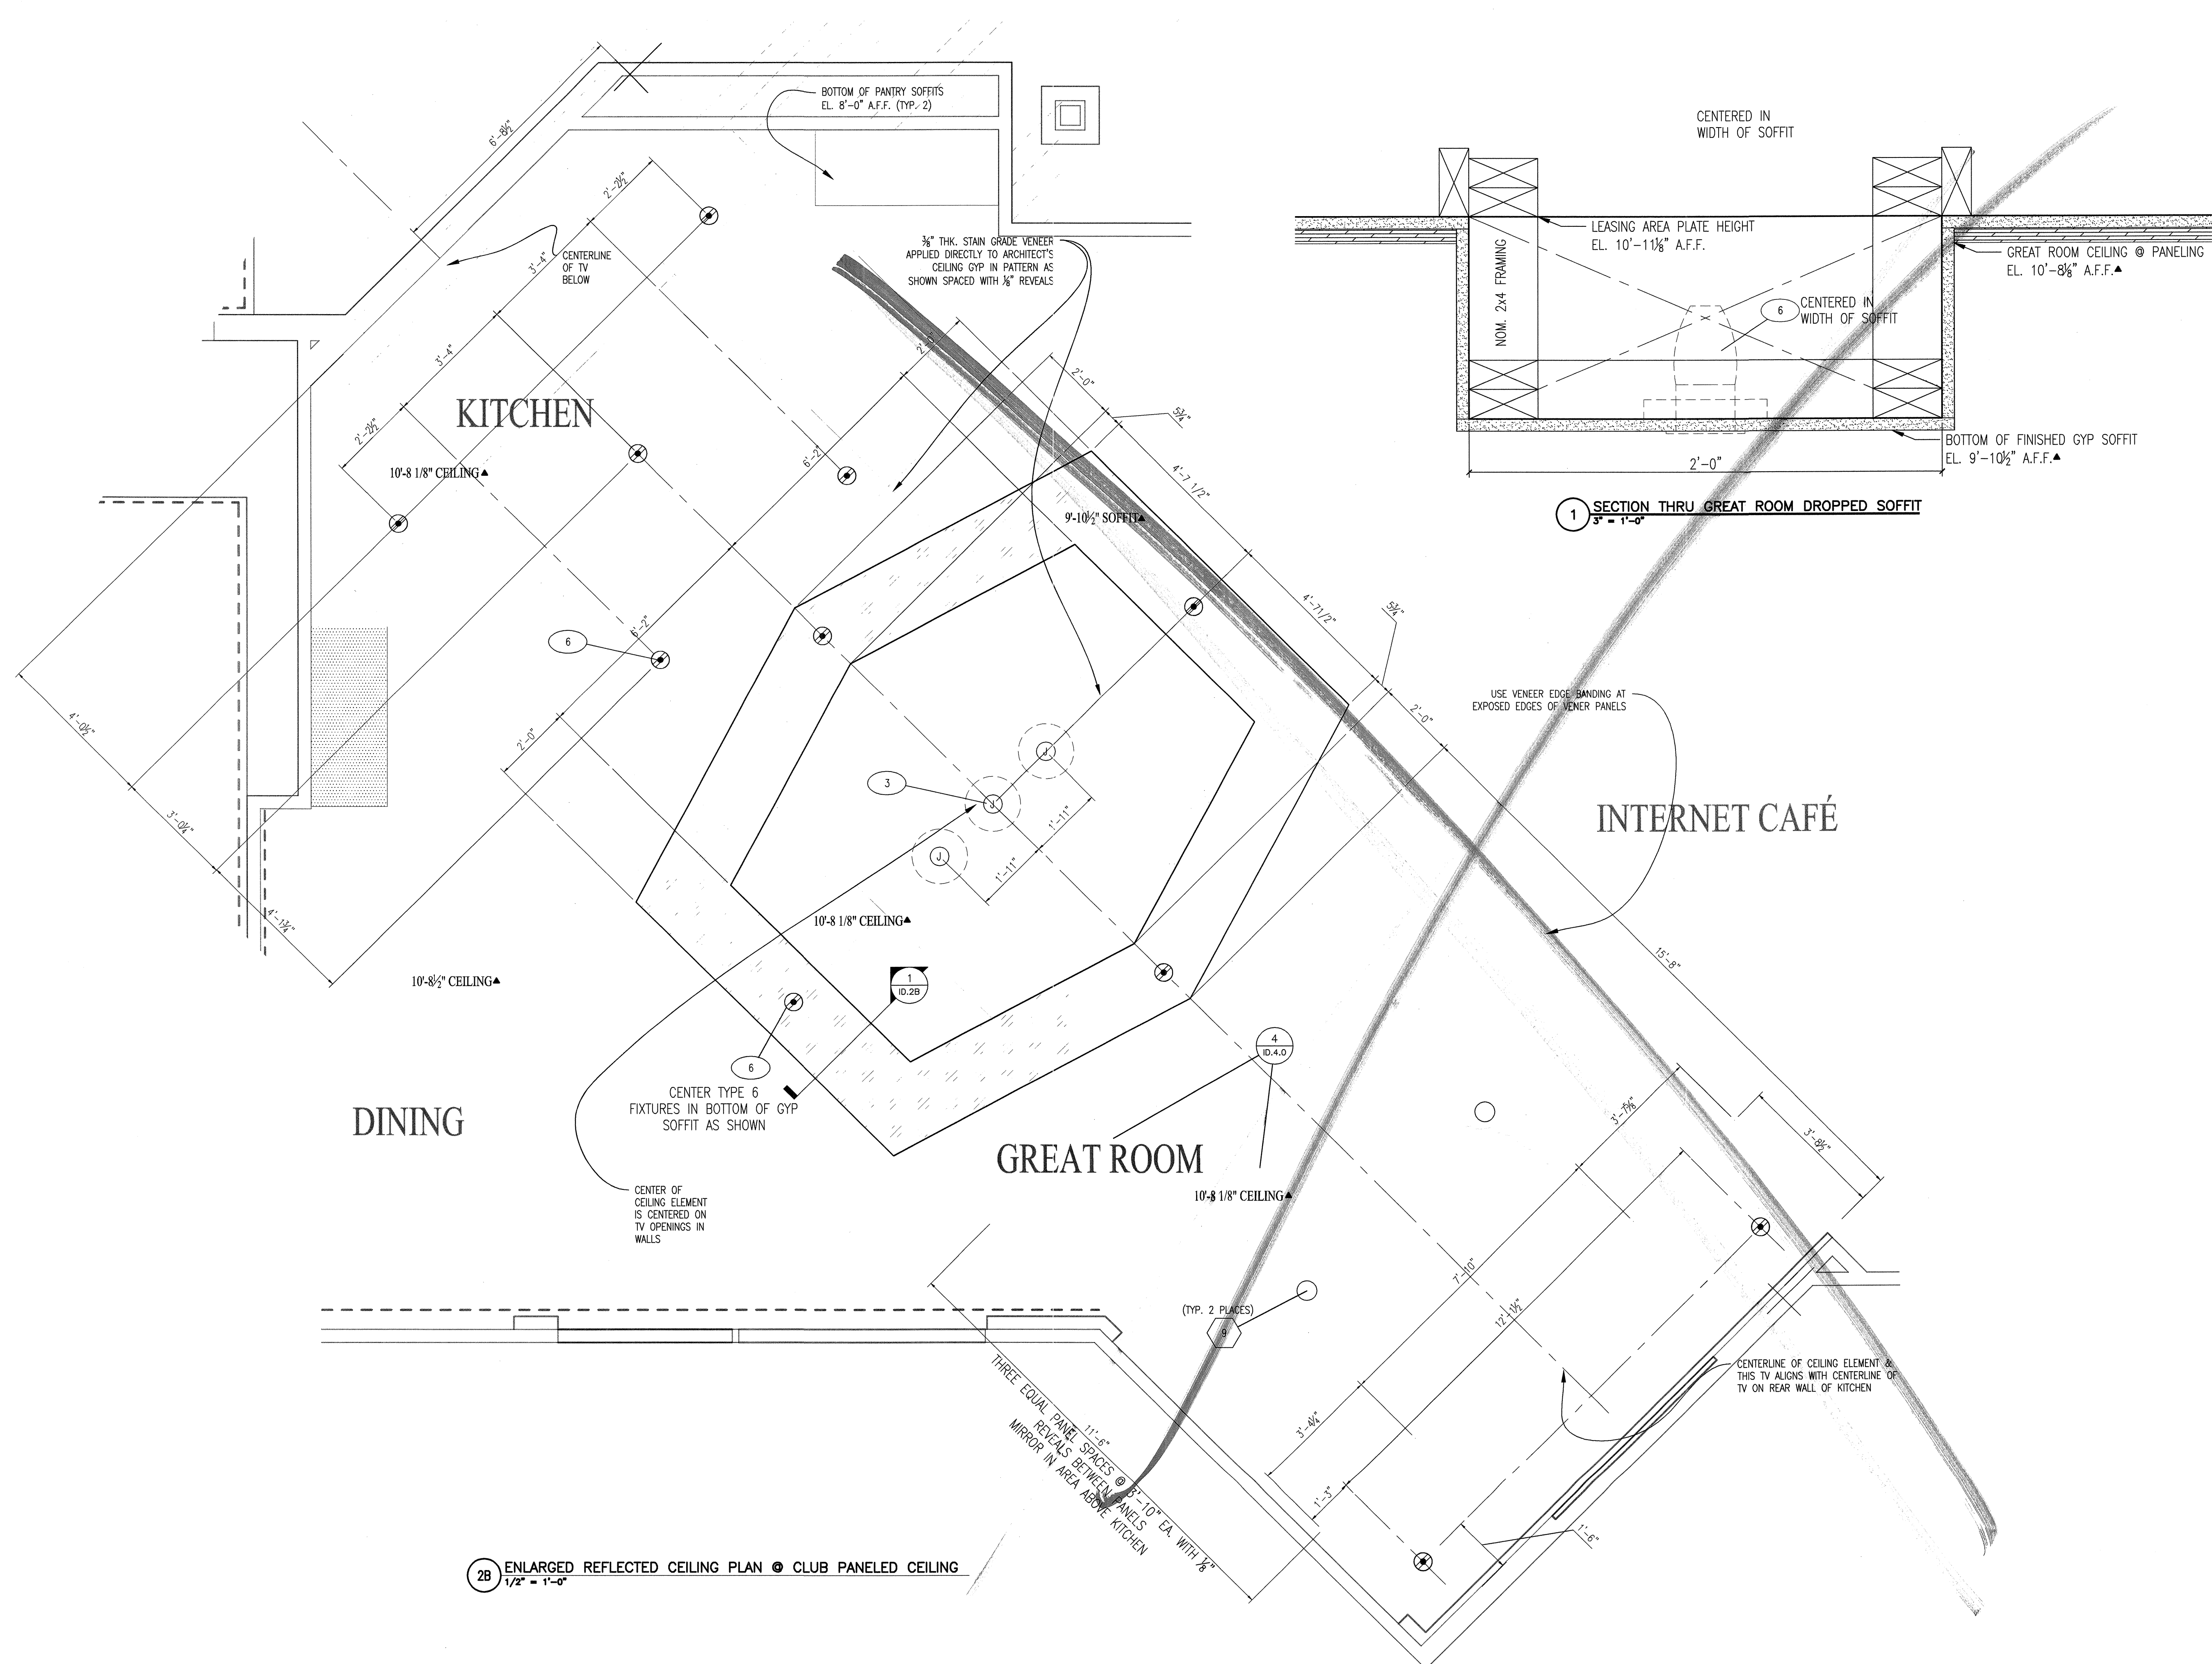


2B ENLARGED REFLECTED CEILING PLAN @ CLUB paneled ceiling
1/2" = 1'-0"

© 2012 M. FORD & ASSOCIATES INC.
THIS DOCUMENT IS PUBLISHED AS AN INSTRUMENT OF SERVICE AND IS GIVEN IN CONFIDENCE. IT REMAINS THE PROPERTY OF M. FORD & ASSOCIATES, INC. THIS DOCUMENT AND THE INFORMATION CONTAINED WITHIN MAY NOT BE DUPLICATED OR DISCLOSED WITHOUT WRITTEN CONSENT OF M. FORD & ASSOCIATES, INC. HOUSTON, TEXAS

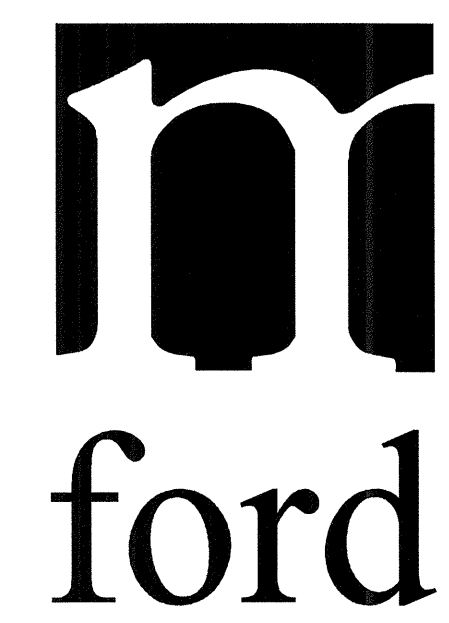

m. ford & associates
interior design
99 detering street
suite 165
houston, tx 77007
phone 713-630-0800
fax 713-630-0814
mford@mfordassociates.com
www.mfordassociates.com

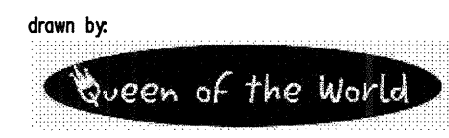

SHEET NO.

ID.2B