


KELLER SPRINGS CLUBHOUSE
ADDISON, TX

REVISED FOR CONSTRUCTION
MAY 16, 2012

ENLARGED REFLECTED CEILING PLAN
@ GREAT ROOM CEILING PANELING & SOFFIT

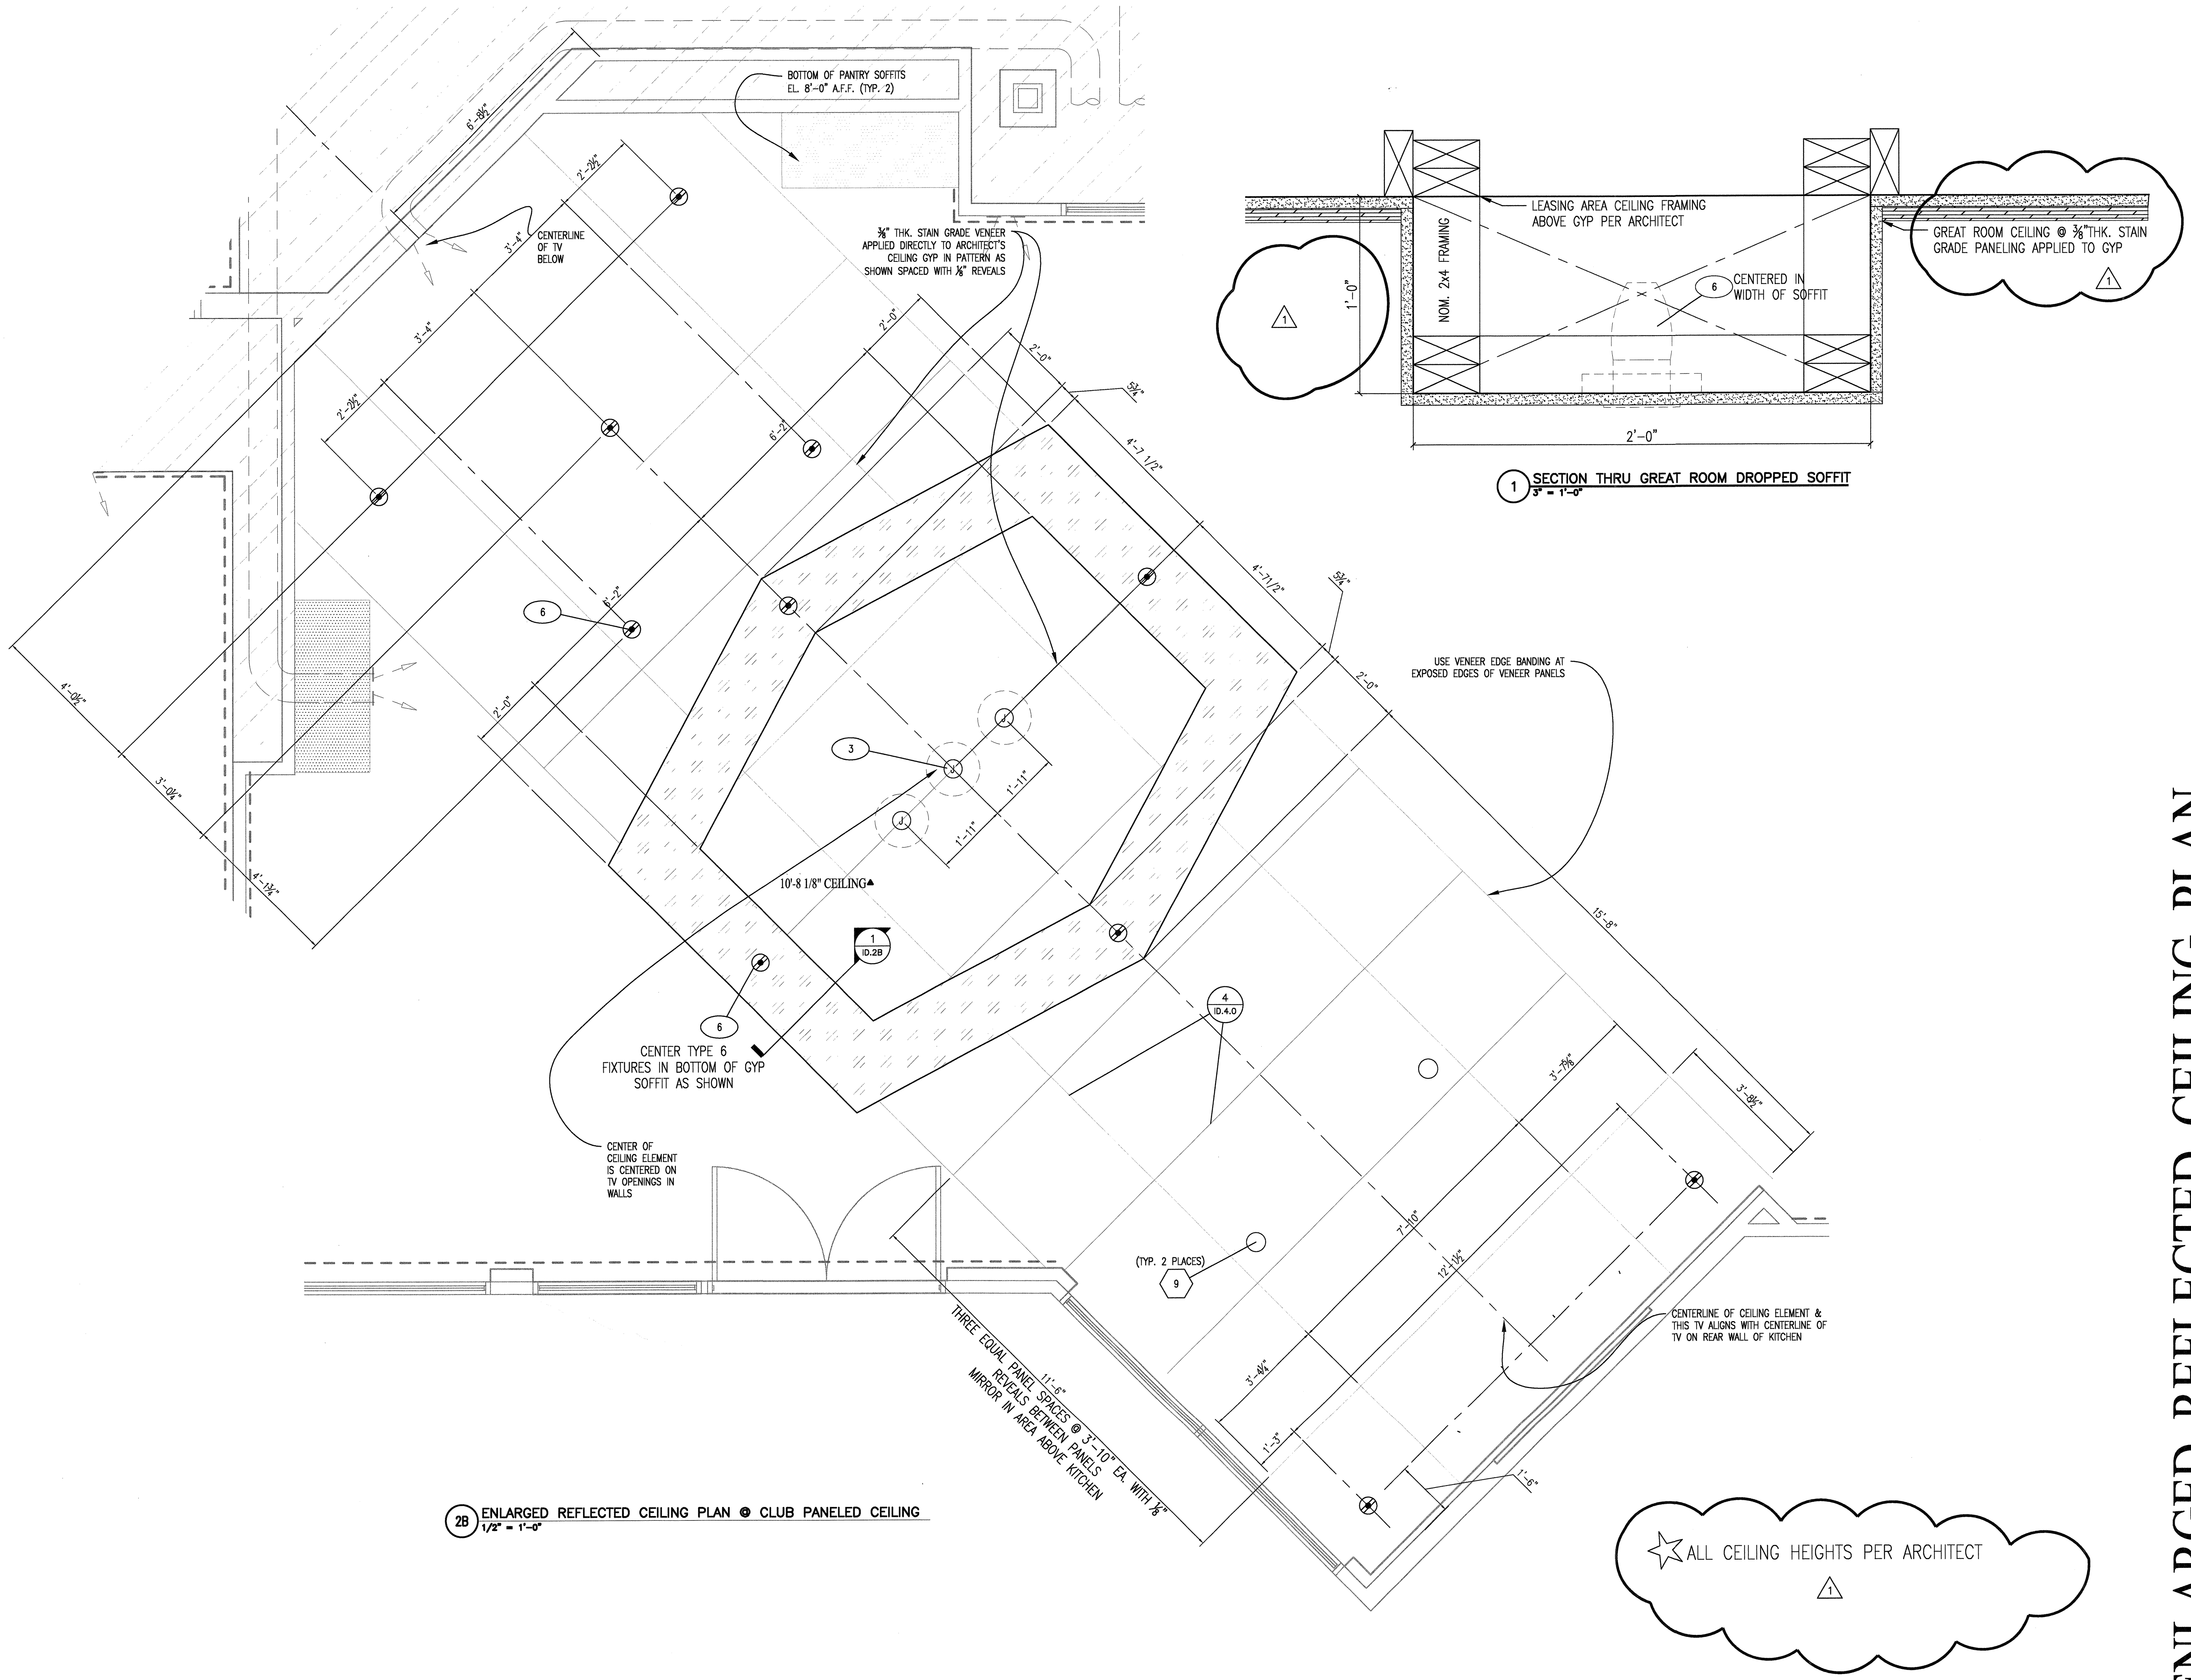

2B ENLARGED REFLECTED CEILING PLAN @ CLUB paneled ceiling
1/2" = 1'-0"

1 SECTION THRU GREAT ROOM DROPPED SOFFIT
3" = 1'-0"

☆ ALL CEILING HEIGHTS PER ARCHITECT

▲ ADDED FABRICATION DETAILS 5-16-12
© 2012 M. FORD & ASSOCIATES INC.
THIS DOCUMENT IS PUBLISHED AS AN INSTRUMENT OF SERVICE AND IS GIVEN IN CONFIDENCE. IT REMAINS THE PROPERTY OF M. FORD & ASSOCIATES, INC. THIS DOCUMENT, AND THE INFORMATION CONTAINED WITHIN, MAY NOT BE DUPLICATED OR DISCLOSED WITHOUT WRITTEN CONSENT OF M. FORD & ASSOCIATES, INC. HOUSTON, TEXAS.



m. ford & associates
interior design
99 detersing street
suite 165
houston, tx 77007
phone 713-630-0800
fax 713-630-0814
mford@mfordassociates.com
www.mfordassociates.com

drawn by: Queen of the World

SHEET NO.

ID.2B