



KELLER SPRINGS CLUBHOUSE  
ADDISON, TX


ISSUED FOR CONSTRUCTION  
APRIL 23, 2012

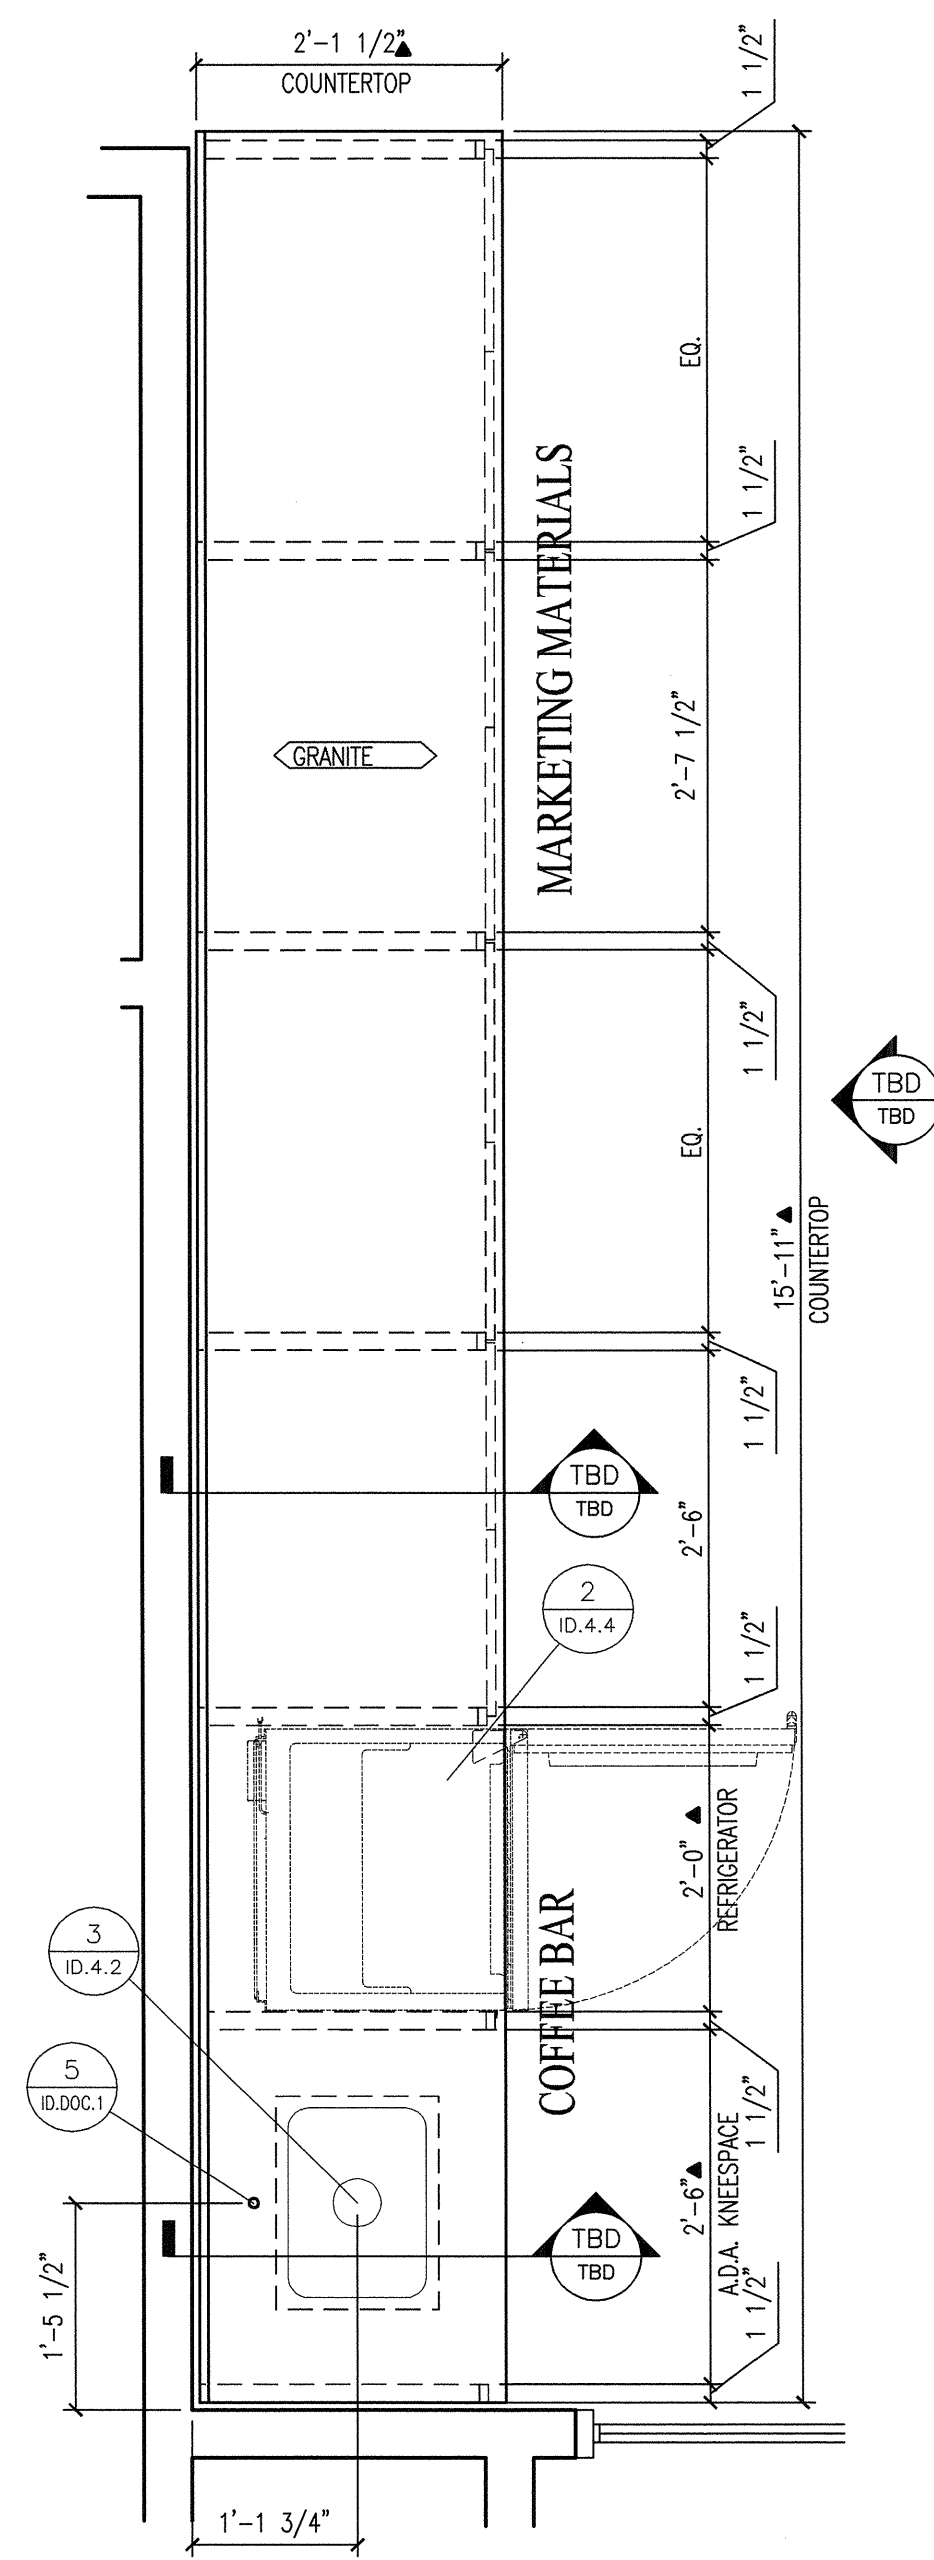


1 ENLARGED PLAN @ COFFEE BAR & MARKETING CABINET  
3/4" = 1'-0"

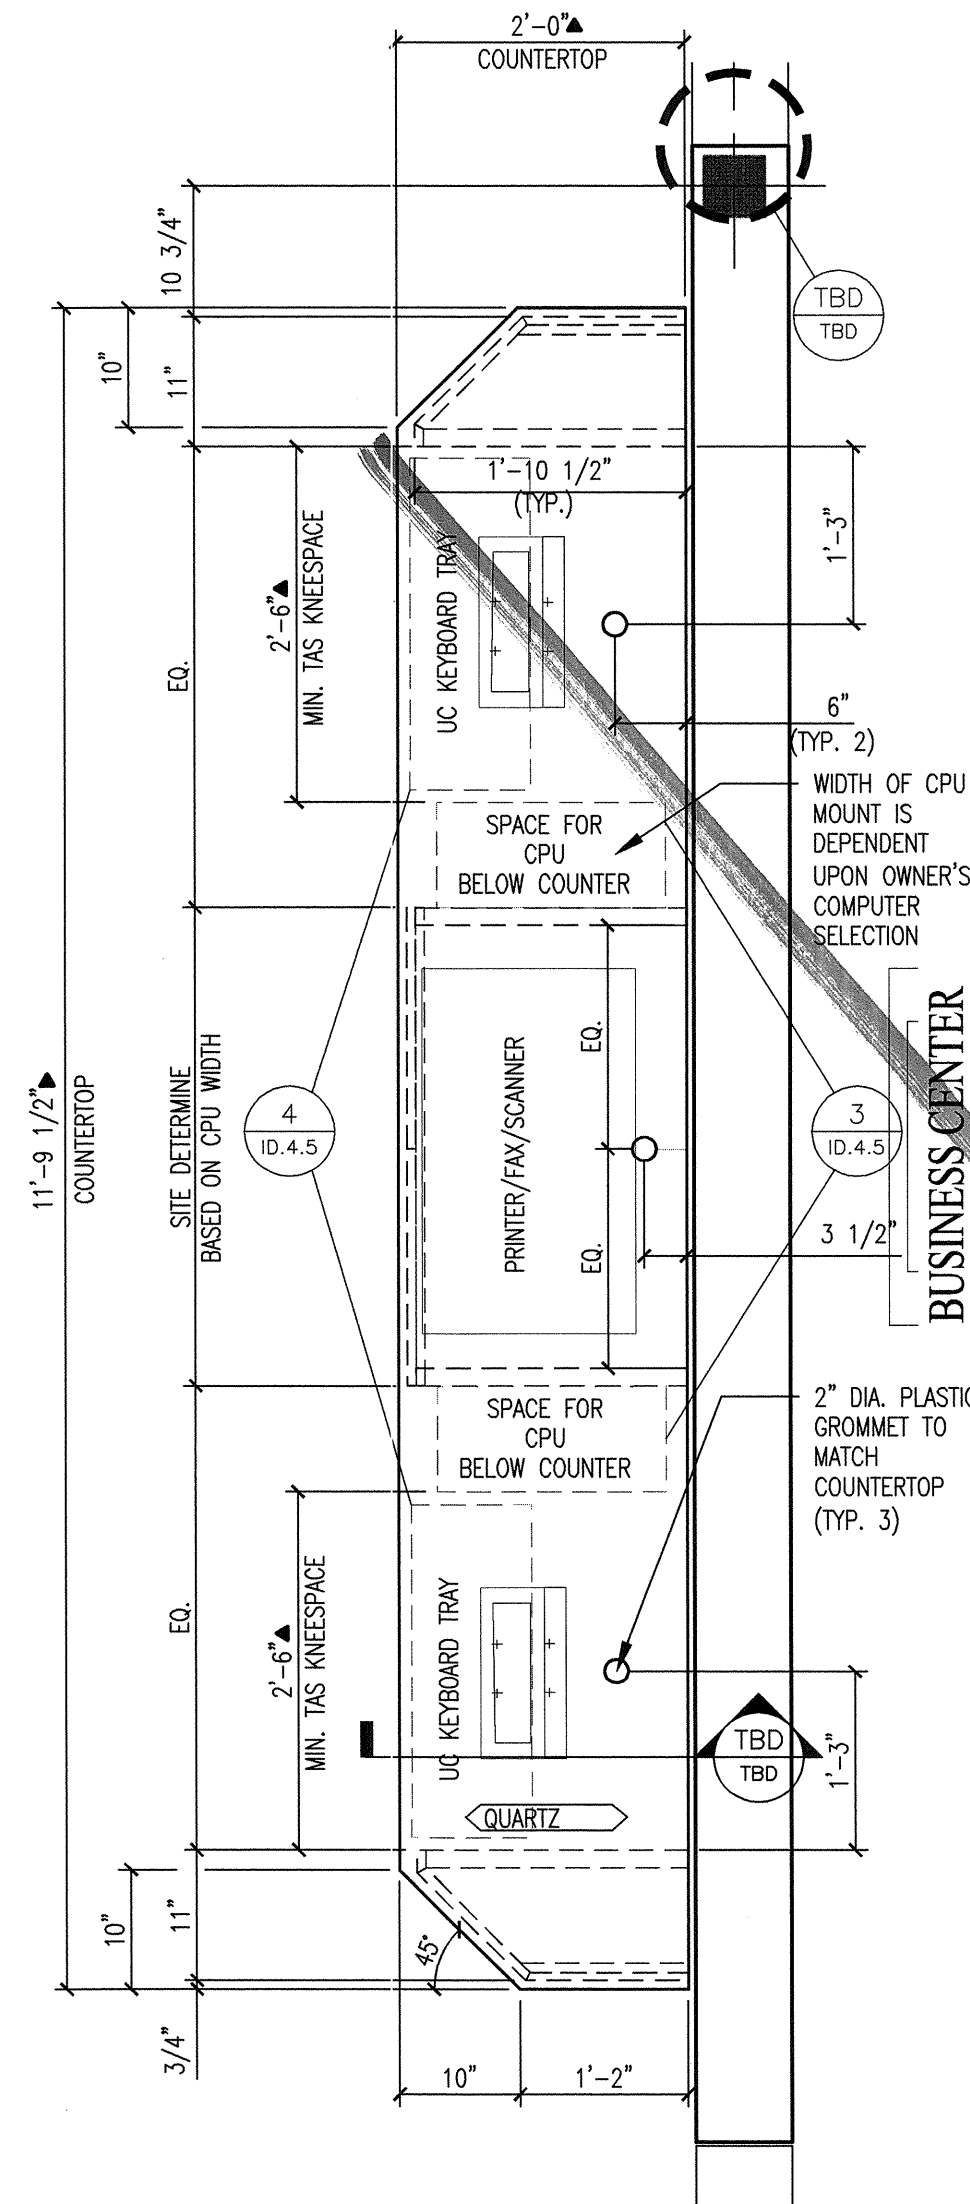


2 ENLARGED PLAN @ BUSINESS CENTER  
3/4" = 1'-0"

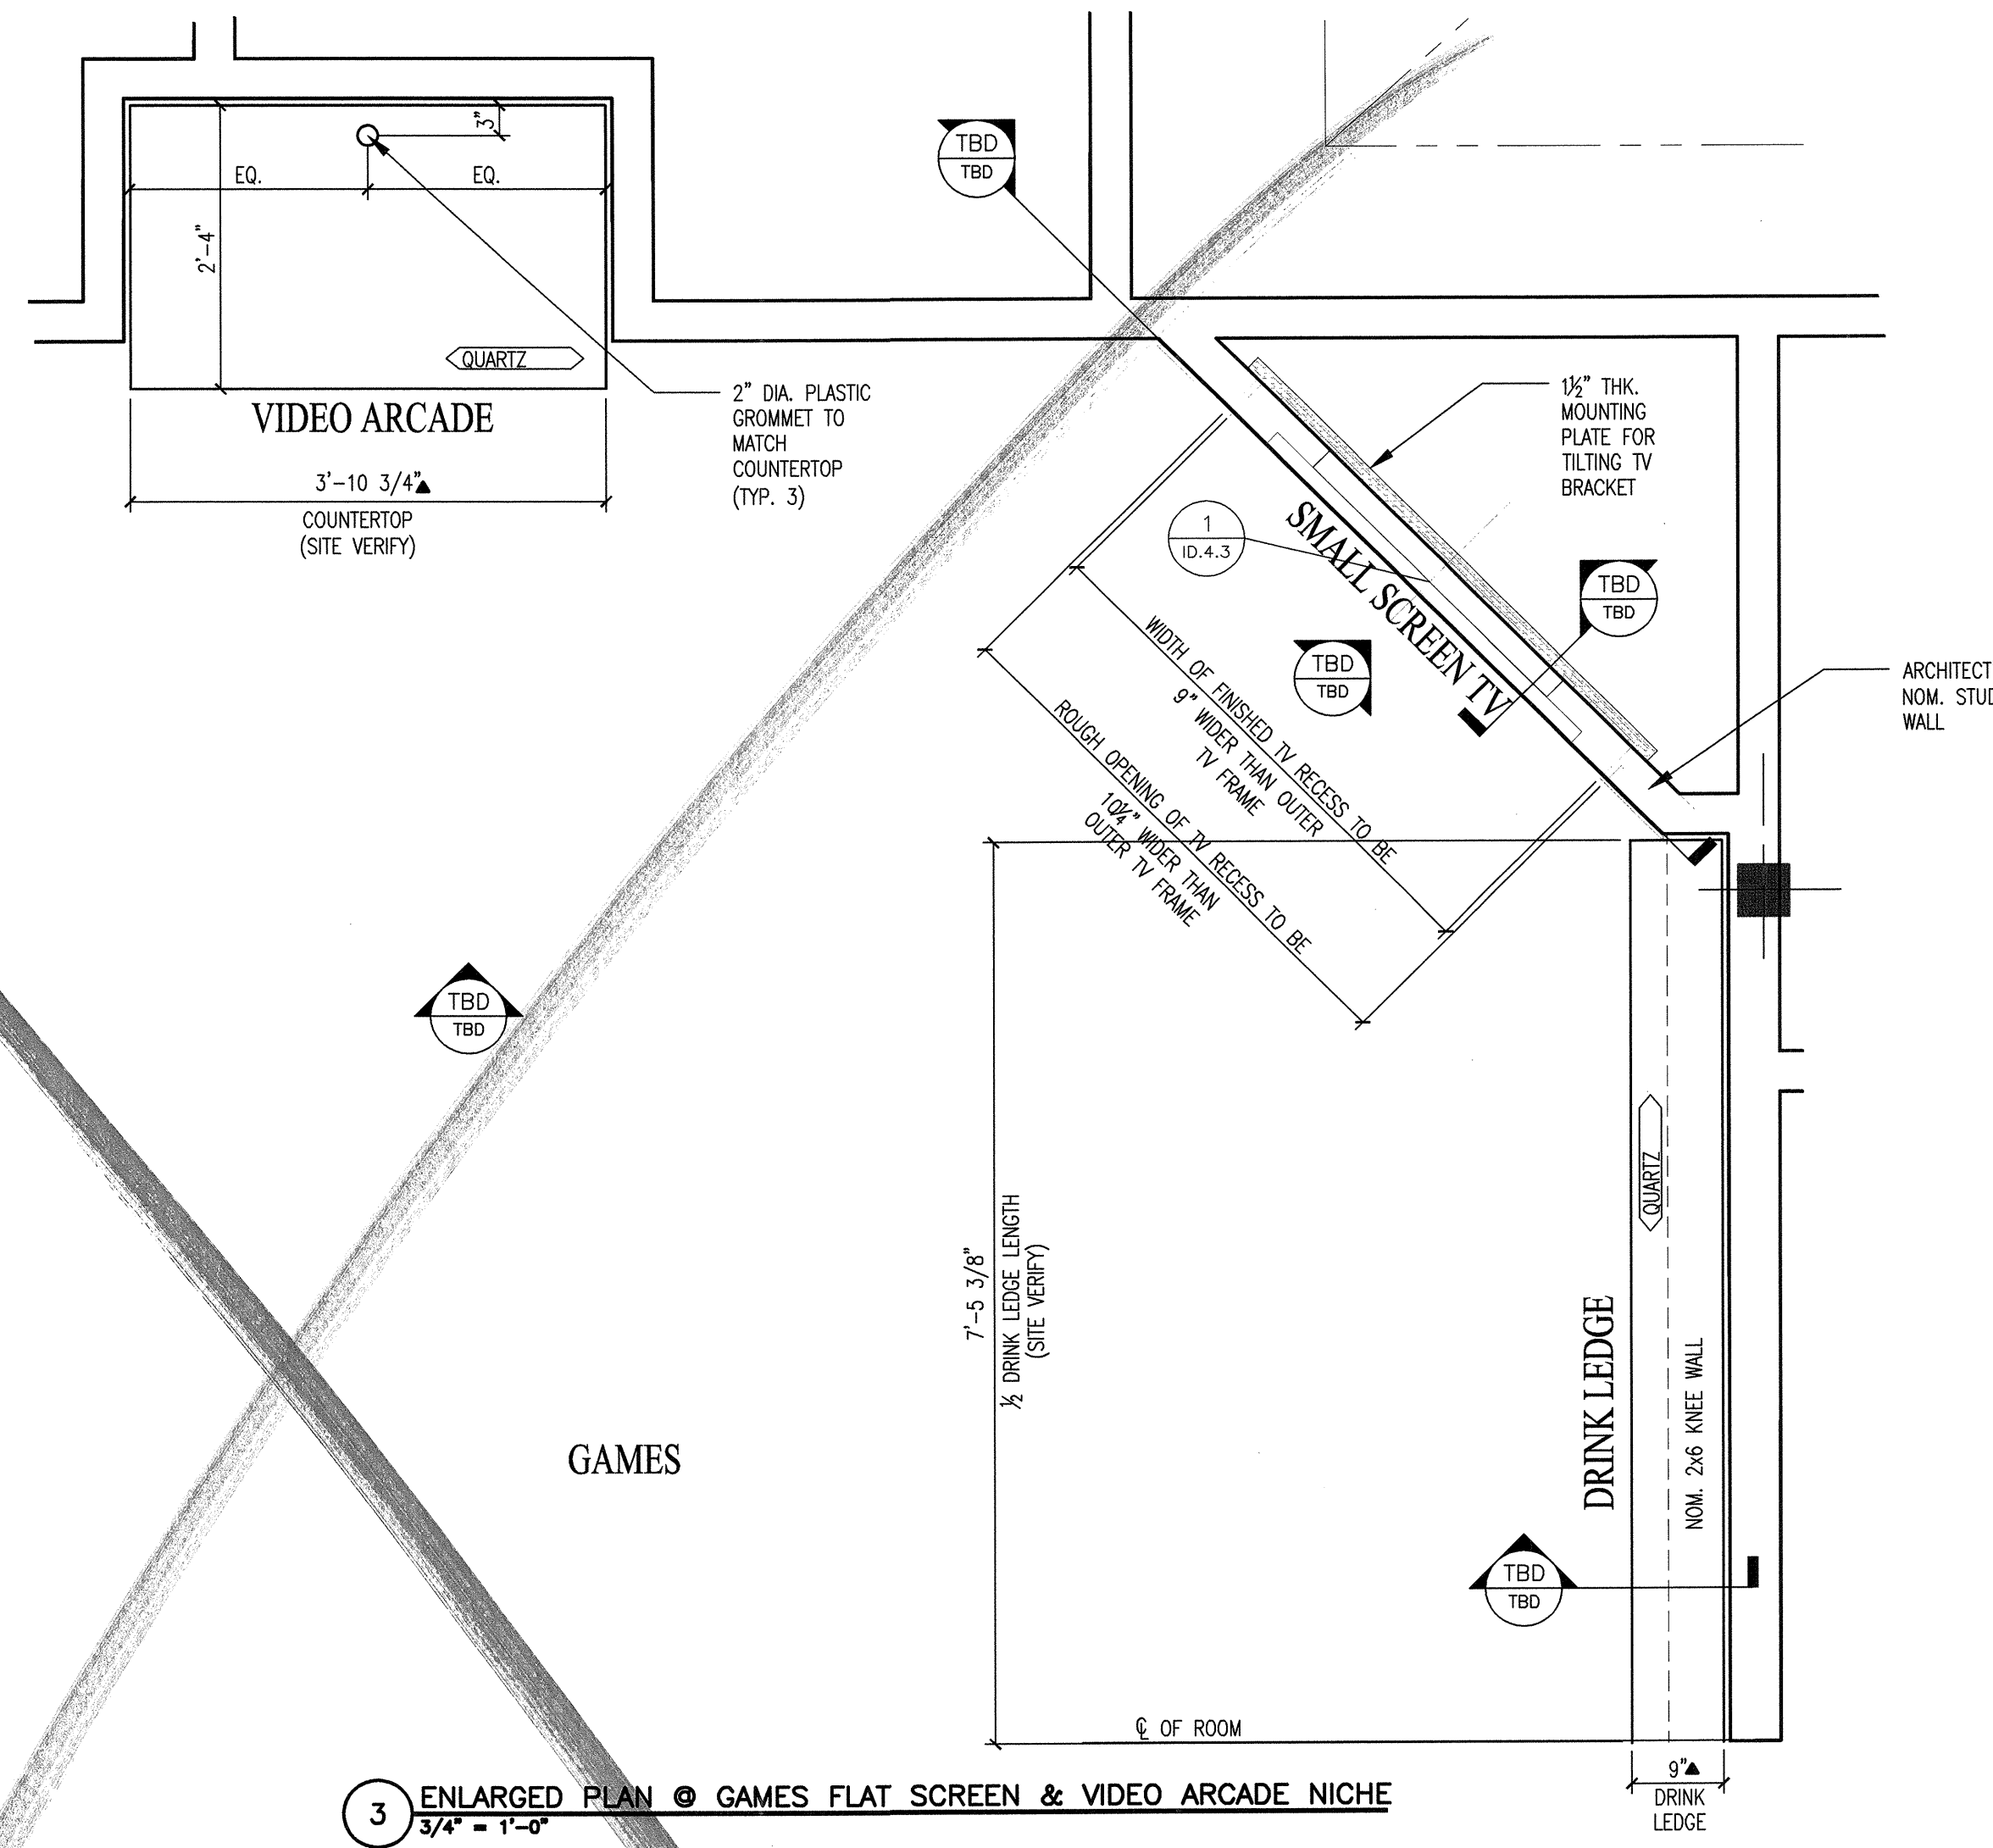

3 ENLARGED PLAN @ GAMES FLAT SCREEN & VIDEO ARCADE NICHE  
3/4" = 1'-0"

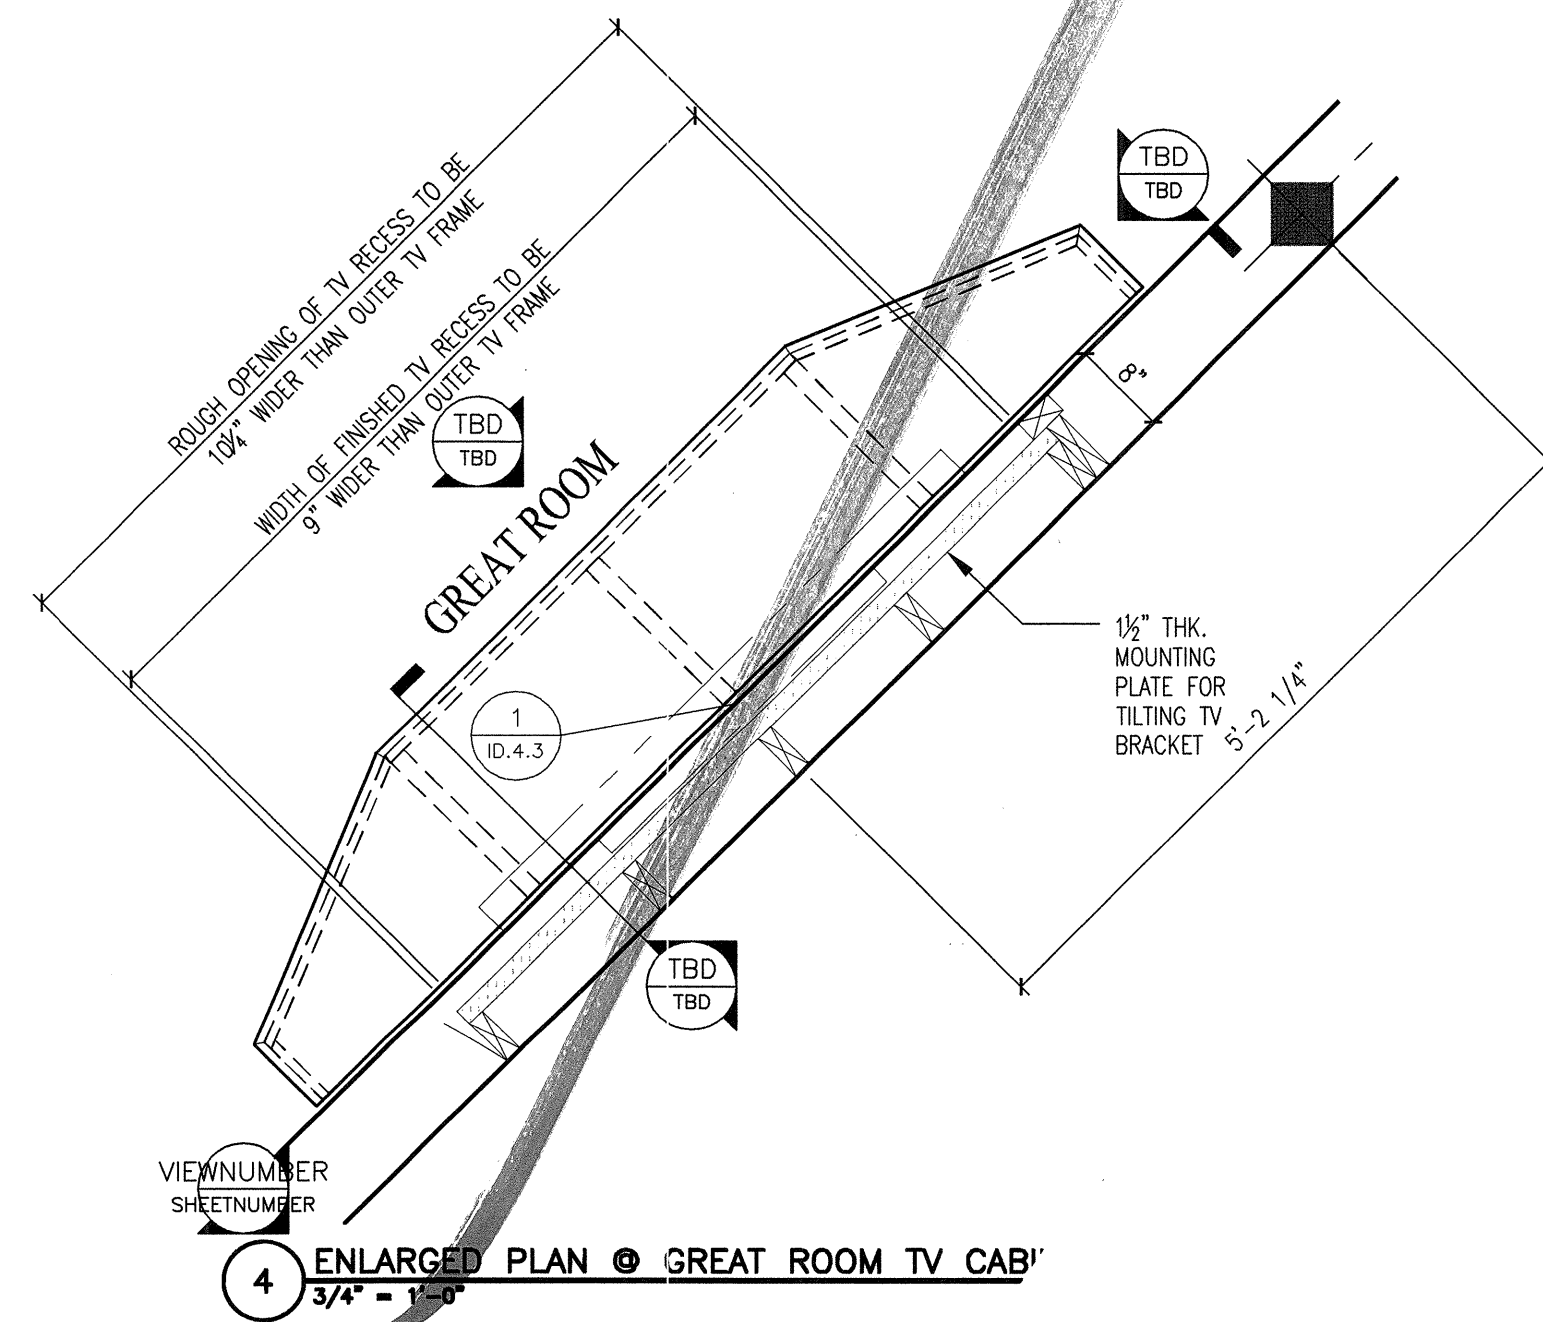


4 ENLARGED PLAN @ GREAT ROOM TV CABINET  
3/4" = 1'-0"

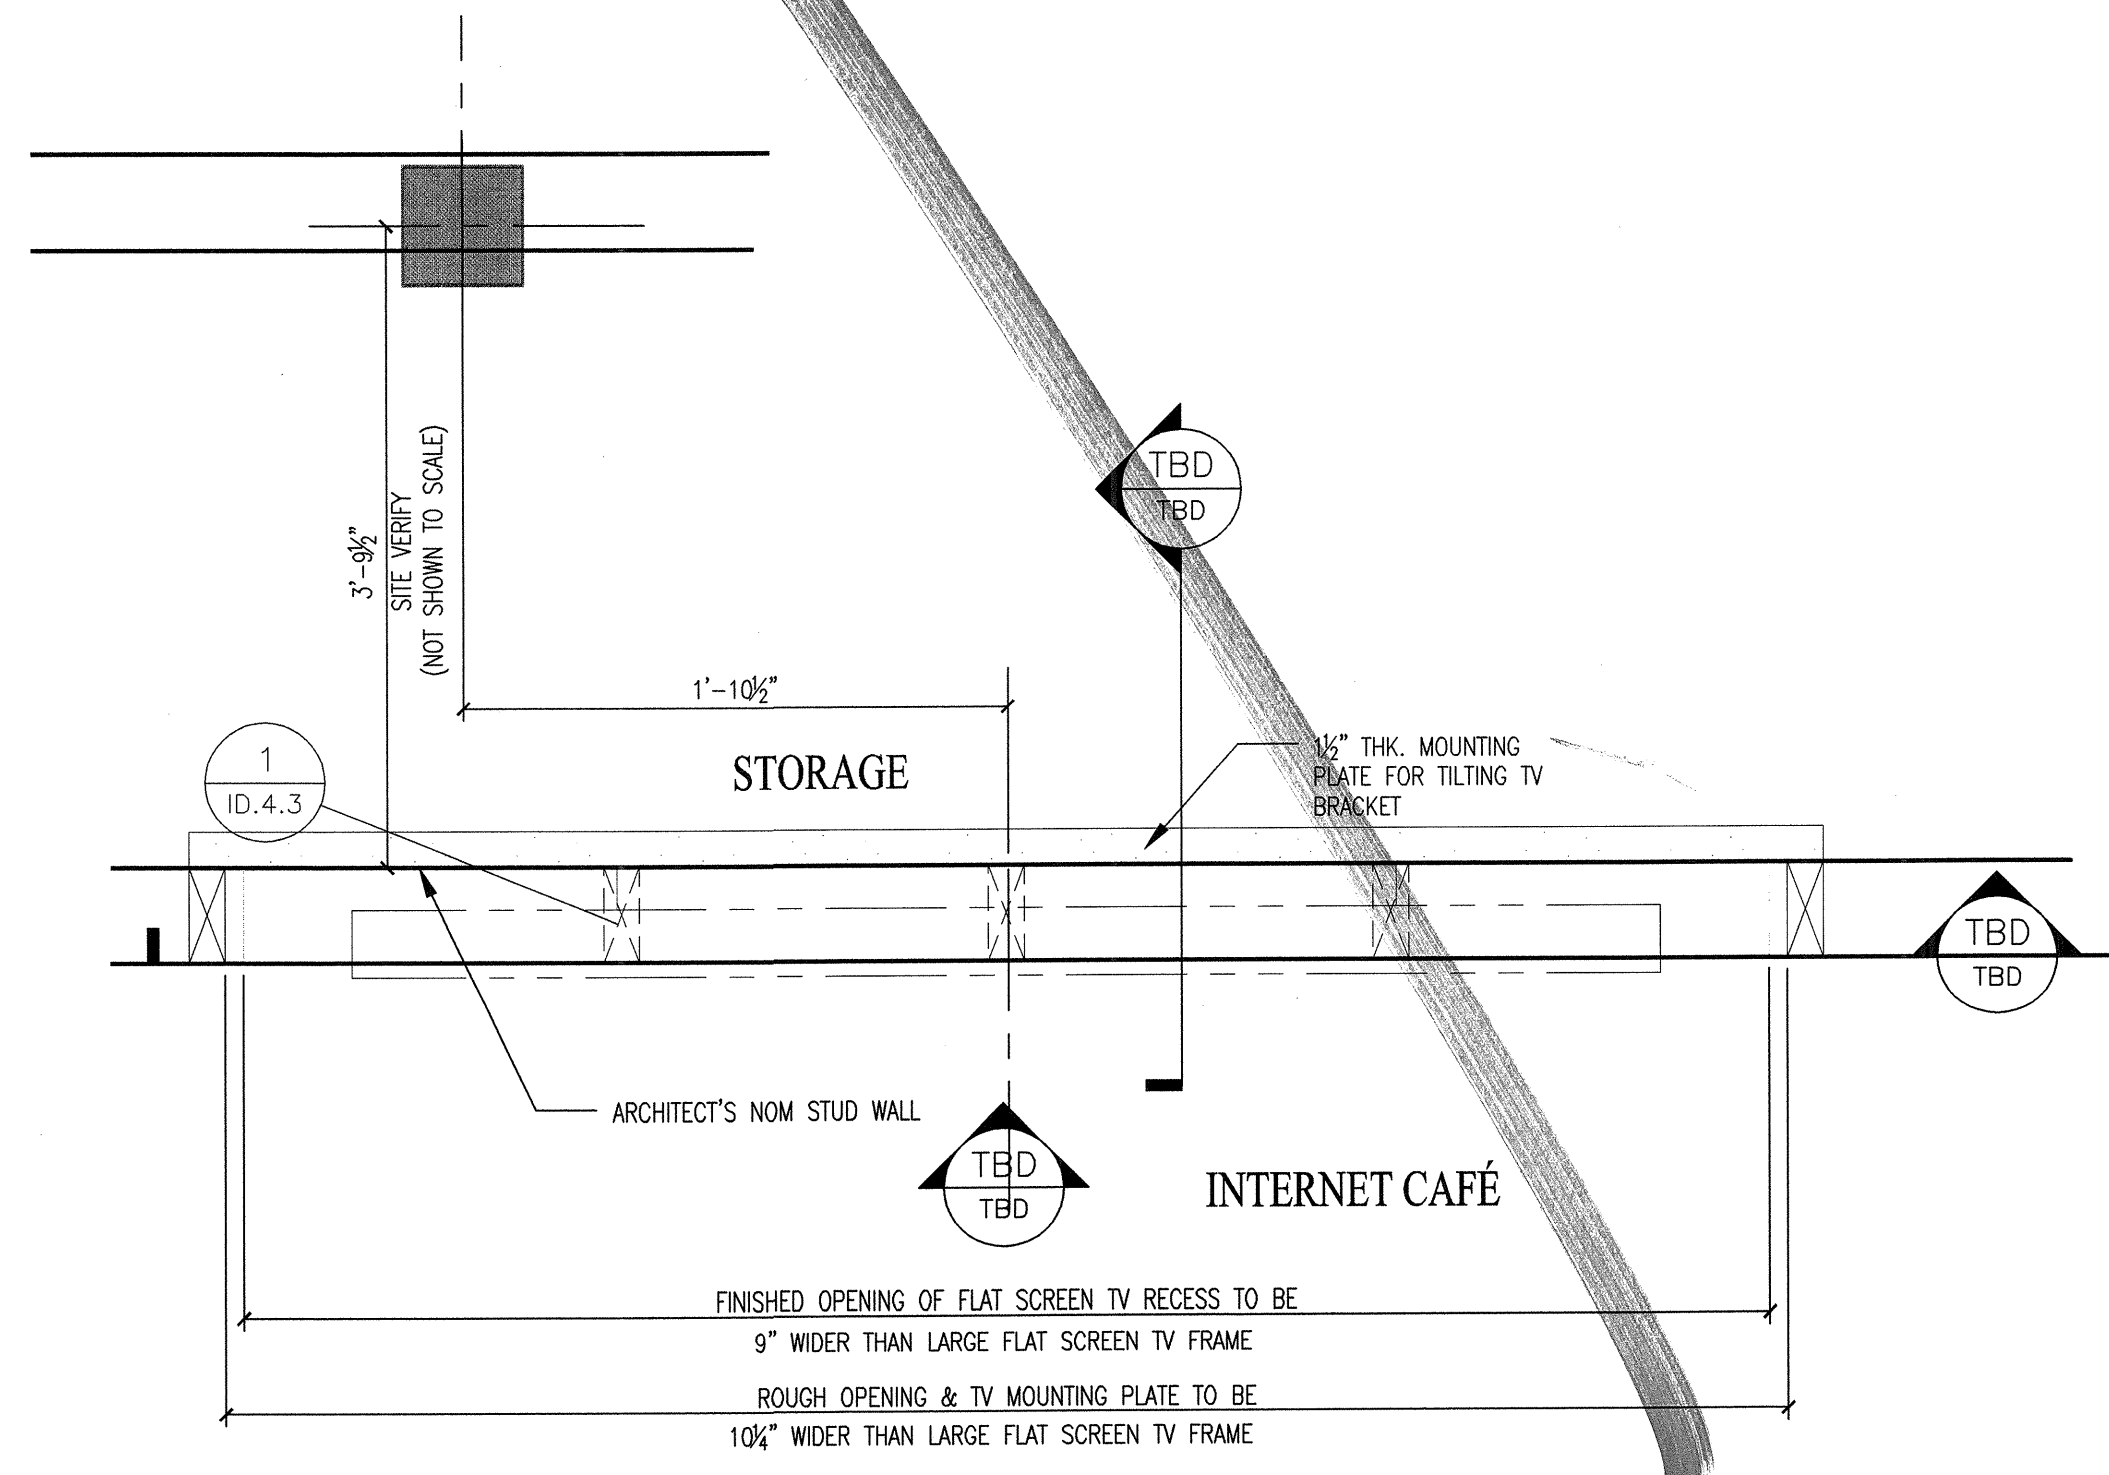

5 ENLARGED PLAN @ INTERNET CAFE LARGE FLAT SCREEN TV  
1 1/2" = 1'-0"

MISC. ENLARGED PLANS

© 2012 M. FORD & ASSOCIATES, INC.  
THIS DOCUMENT IS PUBLISHED AS AN INSTRUMENT OF SERVICE AND IS GIVEN IN CONFIDENCE. IT REMAINS THE PROPERTY OF M. FORD & ASSOCIATES, INC. THIS DOCUMENT, AND THE INFORMATION CONTAINED WITHIN, MAY NOT BE DUPLICATED OR DISCLOSED WITHOUT WRITTEN CONSENT OF M. FORD & ASSOCIATES, INC. HOUSTON, TEXAS

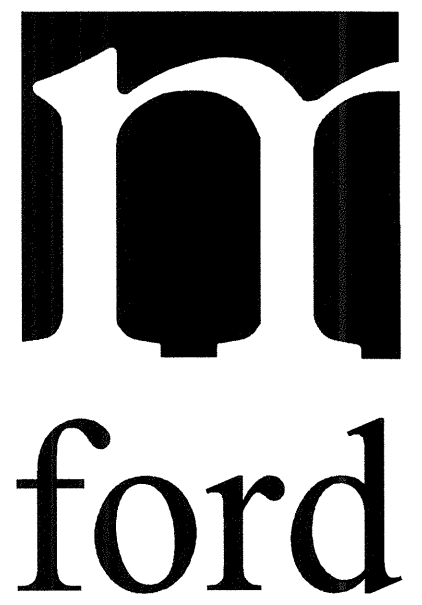

m. ford & associates  
interior design  
99 deterring street  
suite 165  
houston, tx 77007  
phone 713-630-0800  
fax 713-630-0814  
mford@mfordassociates.com  
www.mfordassociates.com



SHEET NO.

ID.7.0