



REVISIONS

09-16-2011
09-21-2011
10-31-2011
05-01-2012


**Keller Springs Lofts**  
EMBREY PARTNERS, LTD  
ADDISON, TEXAS

SCALE  
1" = 30'-0"

DATE  
08/05/11

TITLE  
LANDSCAPE SUBMITTAL

SHEET  
1L OF 2

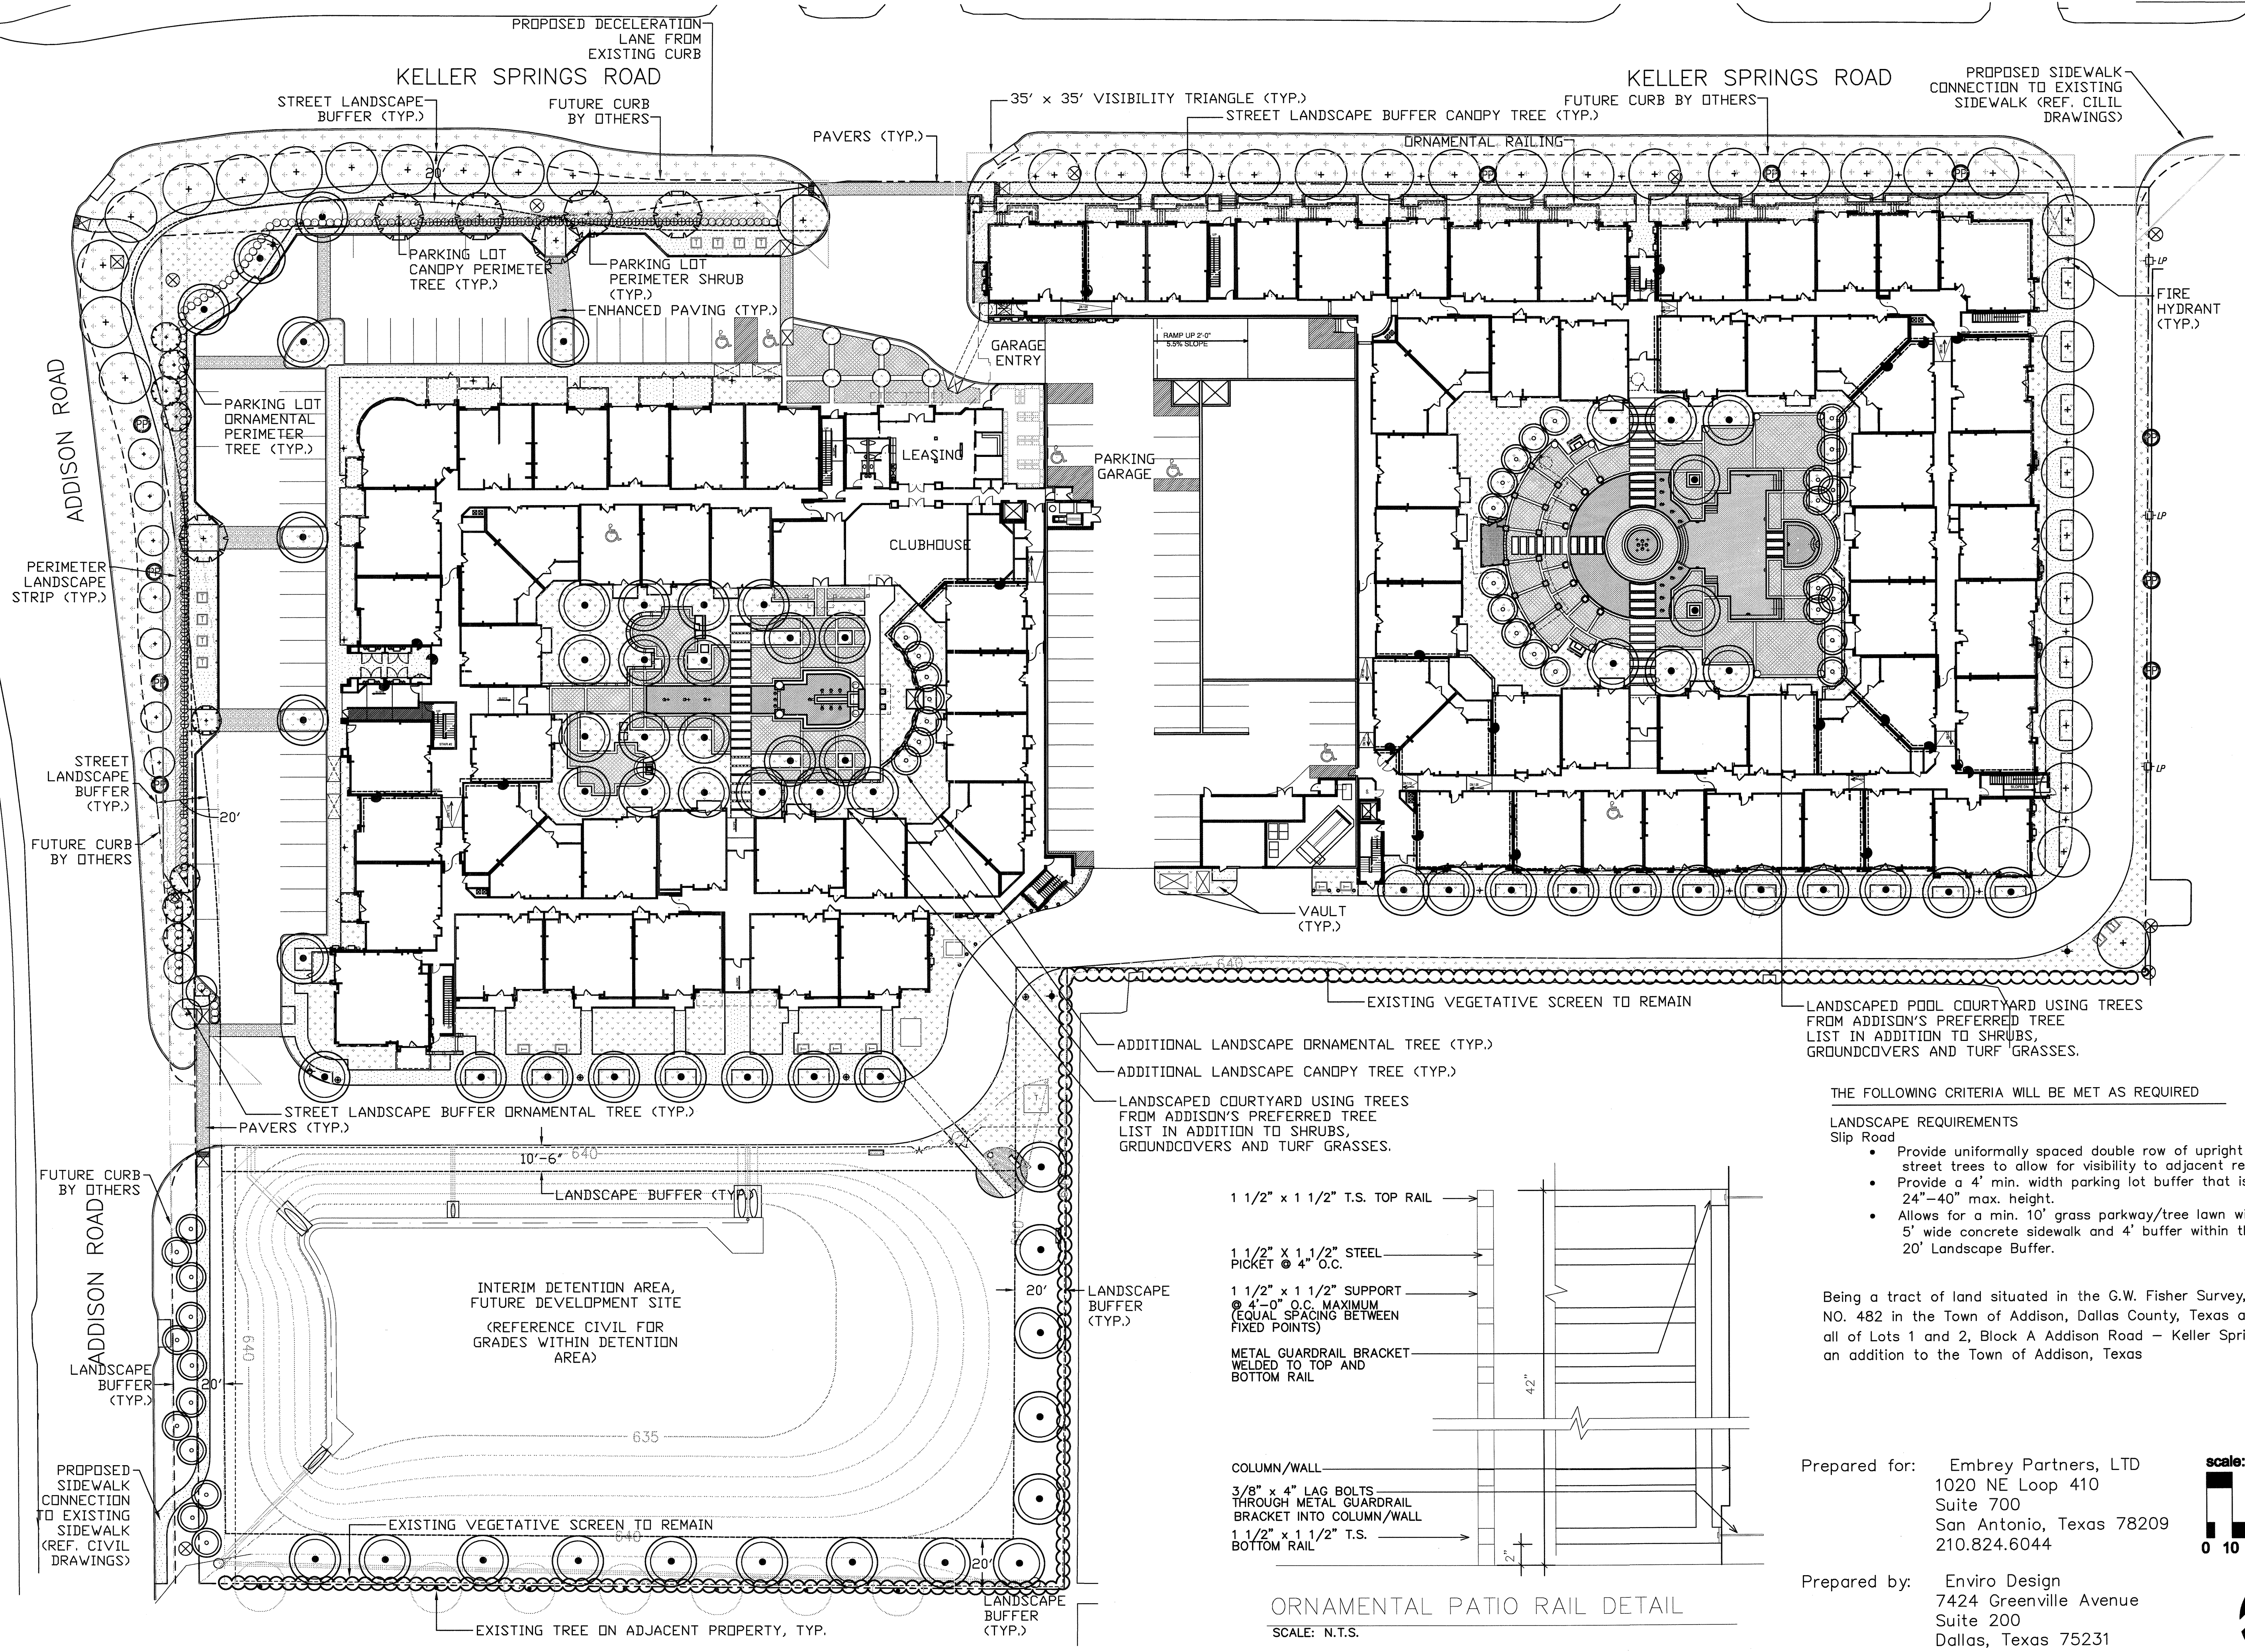

File Name: Keller\_Springs\_landscape\_submittal.dwg  
Plot Date: 05/01/2012 - 09:54am