



KELLER SPRINGS ROAD

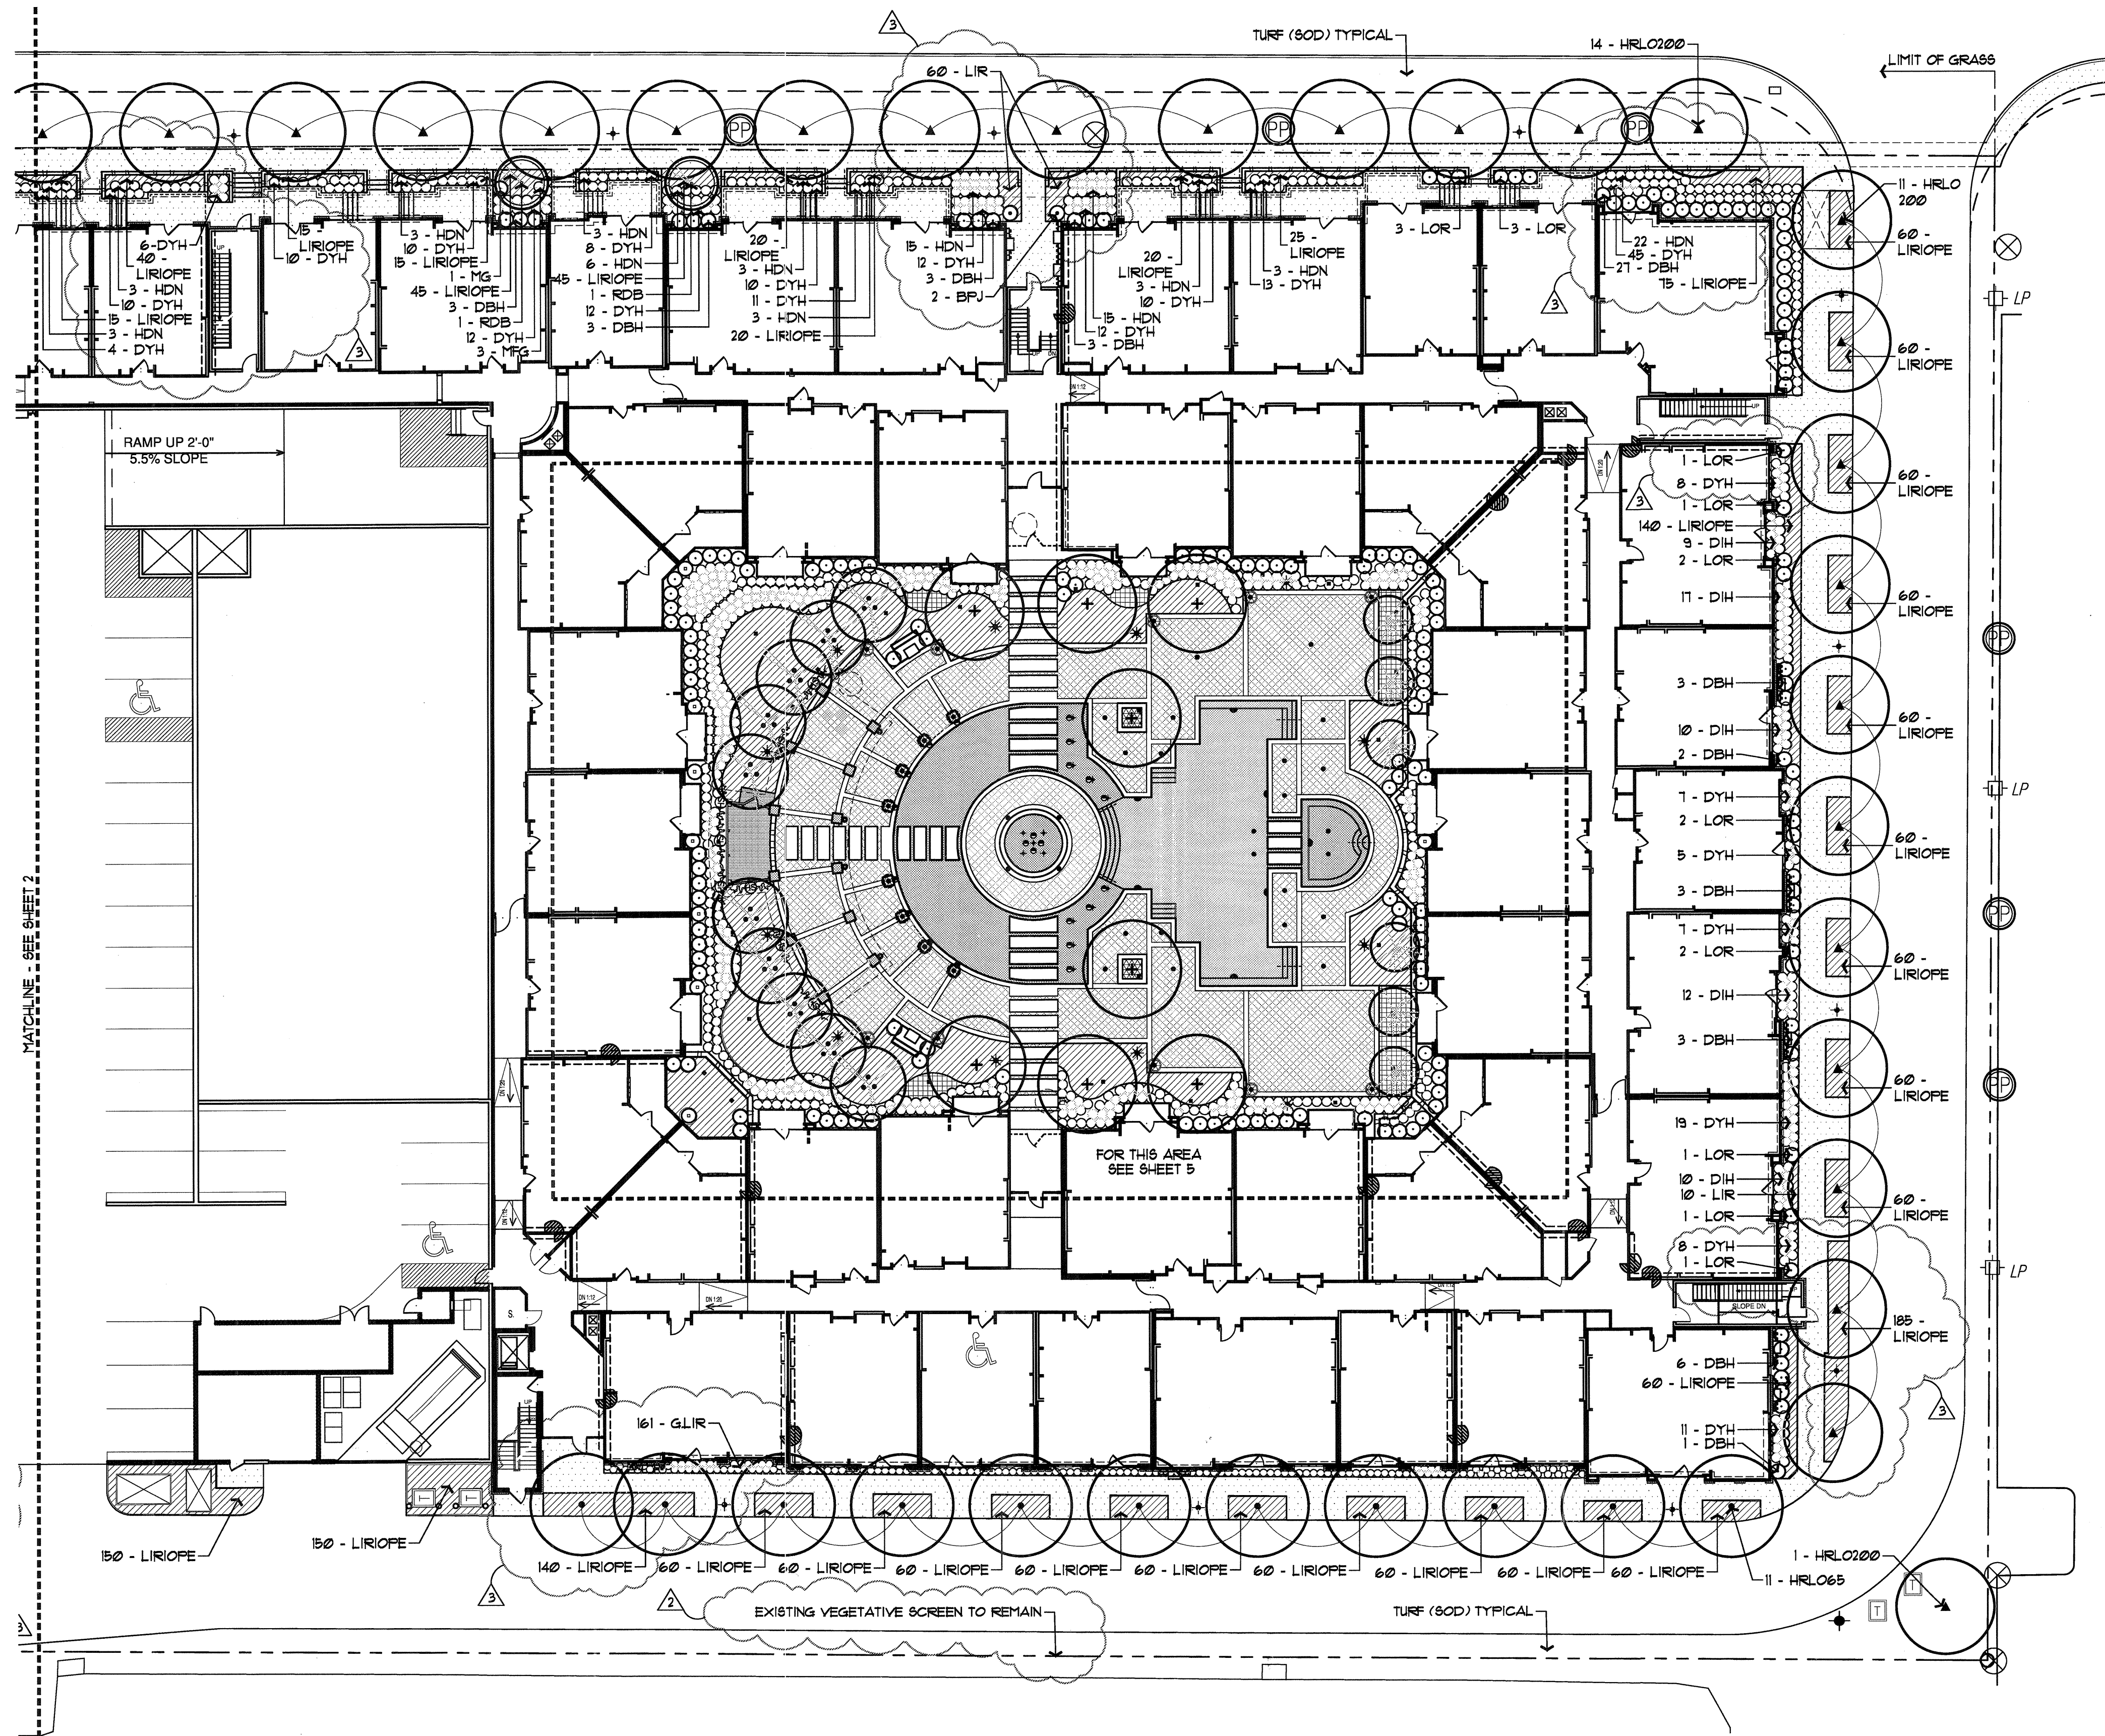

REFERENCE SHEET 3L FOR PLANT MATERIALS LIST AND SHEET 6L FOR PLANTING SPECIFICATIONS.

File Name: Keller\_Springs\_planting.dwg  
 Plot Date: 01/10/2012 - 09:54am

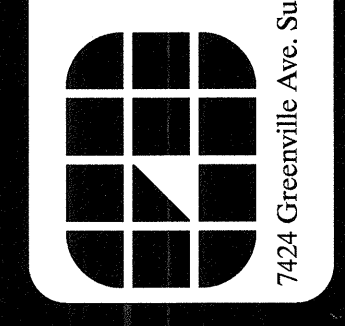

REVISIONS  
 2 03 OCT 11  
 ADDED NOTE ABOUT EXISTING VEGETATION TO REMAIN  
 3 17 OCT 11  
 REVISED PLANTING DUE TO BUILDING REVISIONS

Keller Springs Lofts  
 EMBREY PARTNERS, LTD  
 ADDISON, TEXAS

SCALE  
 1" = 20'-0"  
 DATE  
 19 AUG 2011  
 TITLE  
 LANDSCAPE  
 SHEET  
 1L OF 6

