


File Name: Keller_Springs_Irrigation.dwg
 Plot Date: 10/21/2011 - 02:37pm

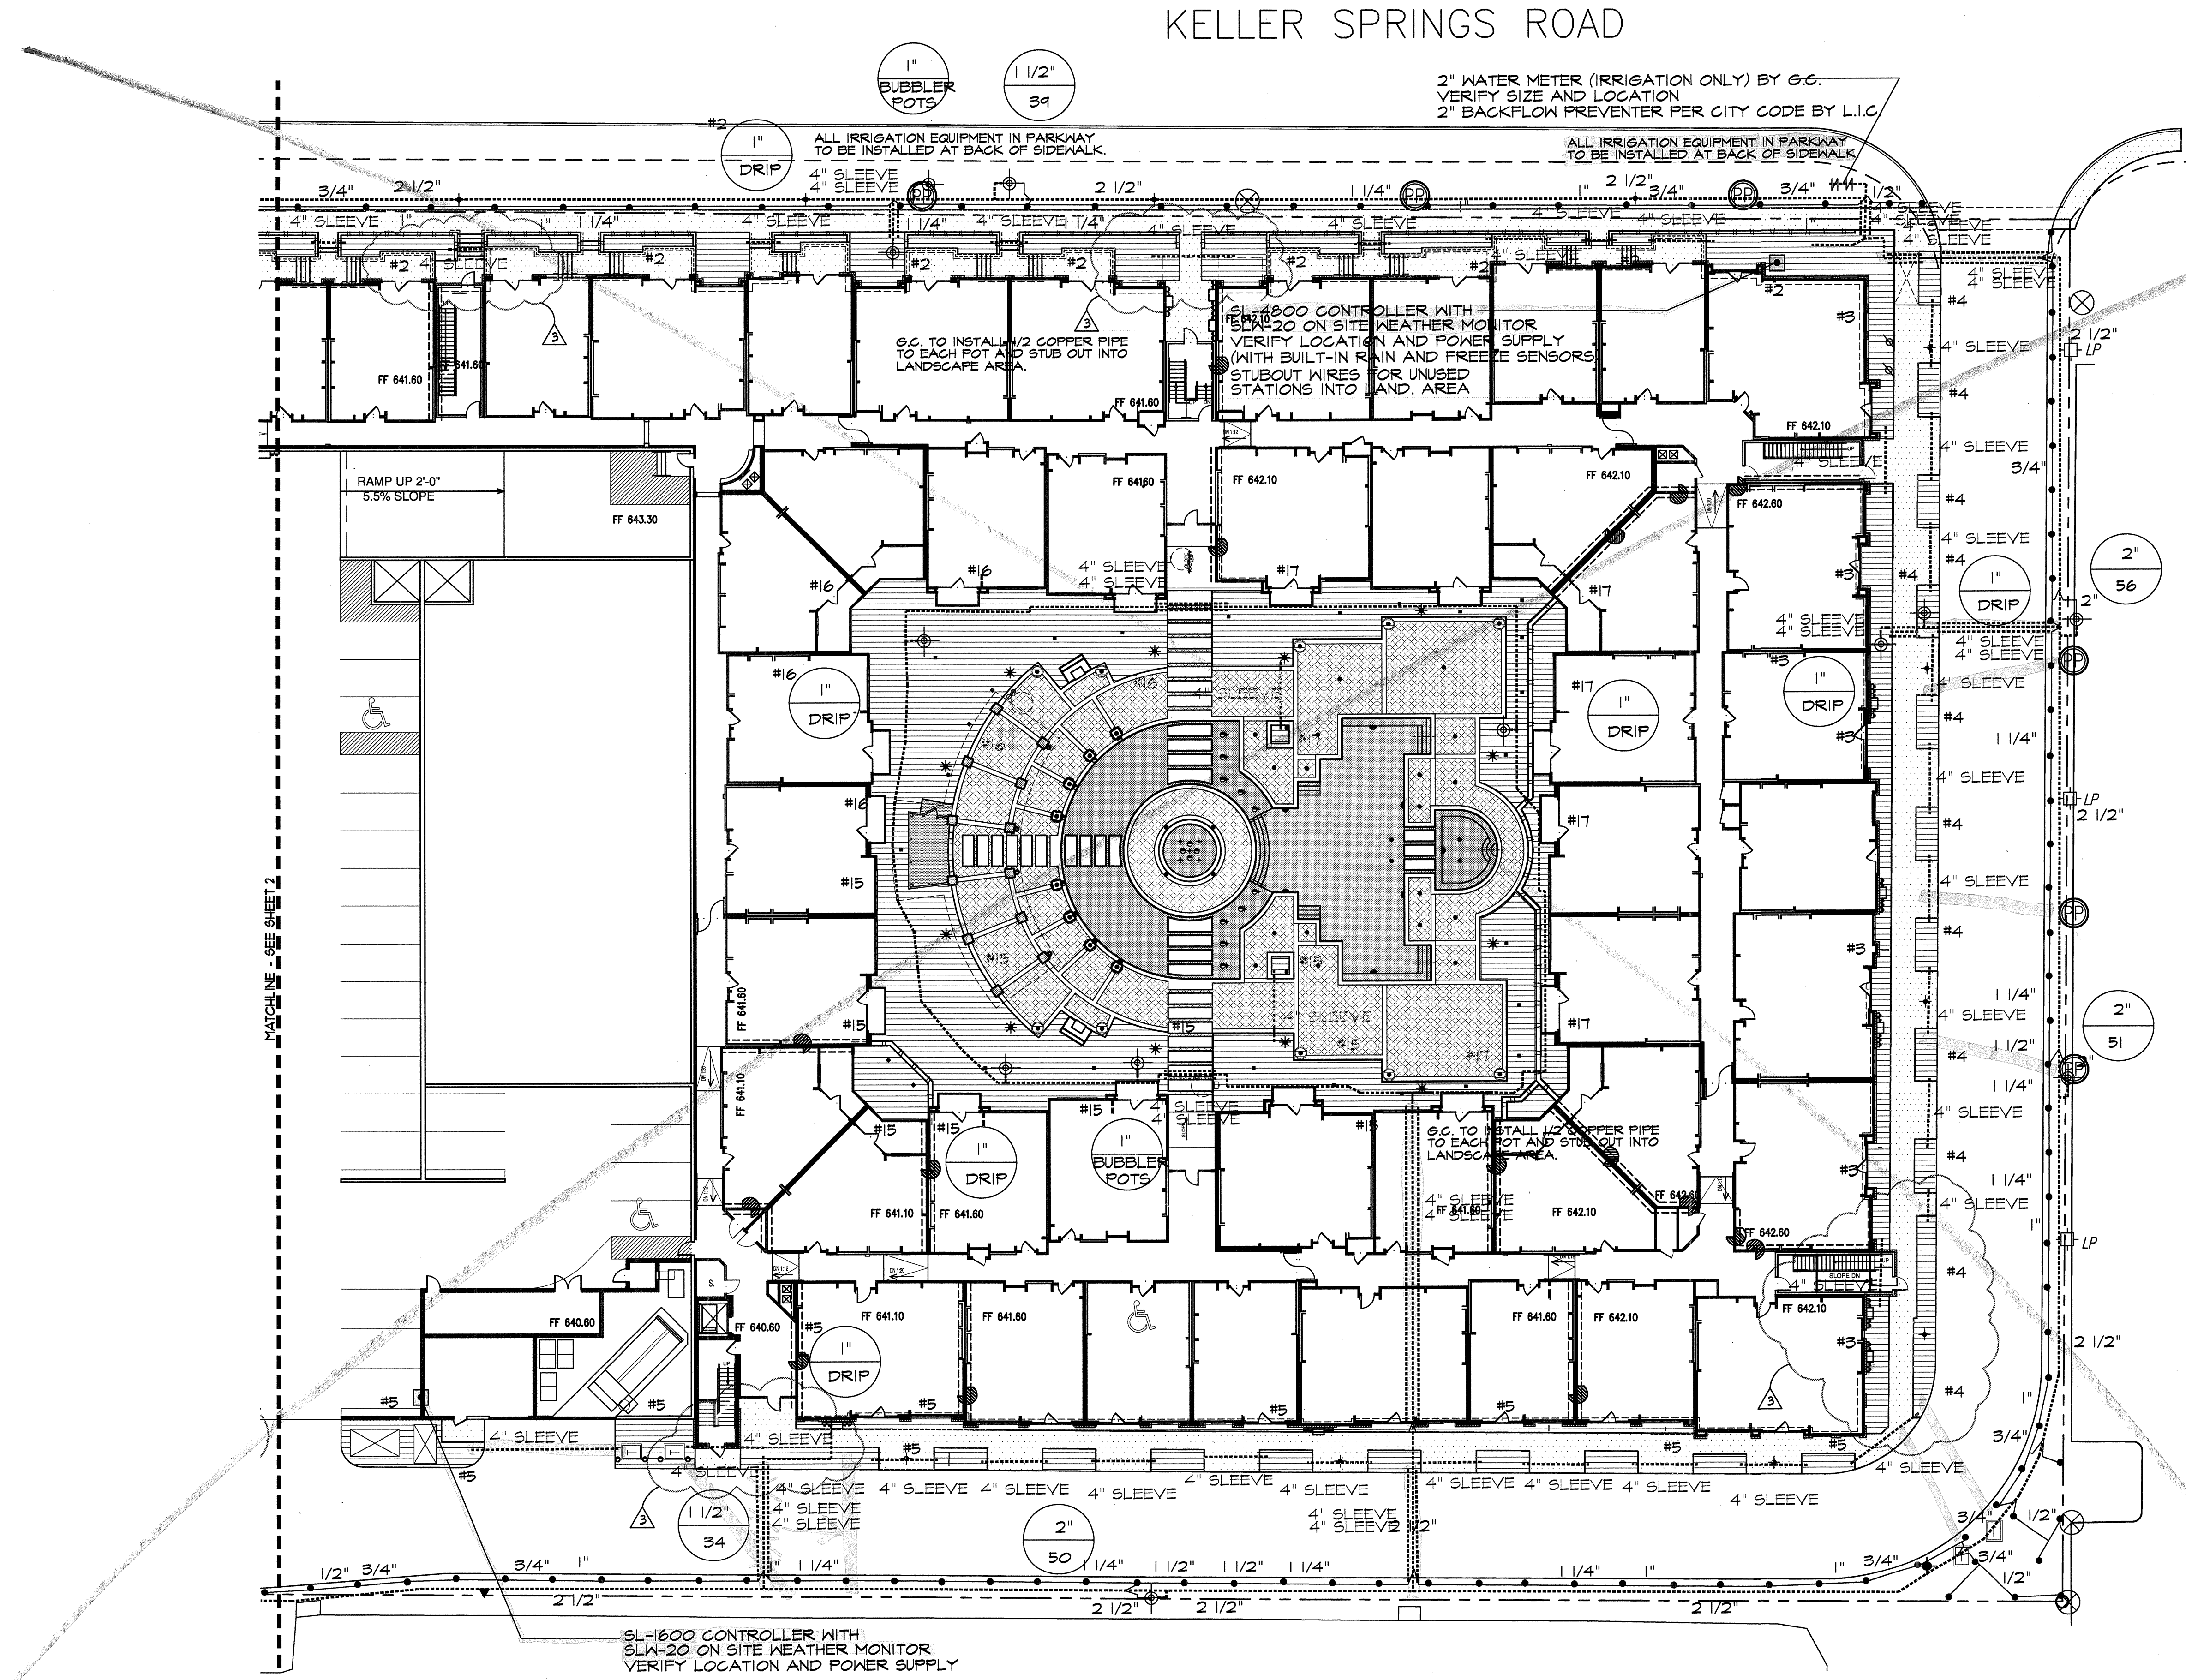

KELLER SPRINGS ROAD

2" WATER METER (IRRIGATION ONLY) BY G.C.
 VERIFY SIZE AND LOCATION
 2" BACKFLOW PREVENTER PER CITY CODE BY L.I.C.

ALL IRRIGATION EQUIPMENT IN PARKWAY
 TO BE INSTALLED AT BACK OF SIDEWALK.

ALL IRRIGATION EQUIPMENT IN PARKWAY
 TO BE INSTALLED AT BACK OF SIDEWALK.

SL-1600 CONTROLLER WITH
 SLW-20 ON SITE WEATHER MONITOR
 VERIFY LOCATION AND POWER SUPPLY

REFERENCE SHEET 35 FOR
 IRRIGATION NOTES AND LEGEND
 REFERENCE SHEET 45 FOR
 IRRIGATION SPECS AND DETAILS

