
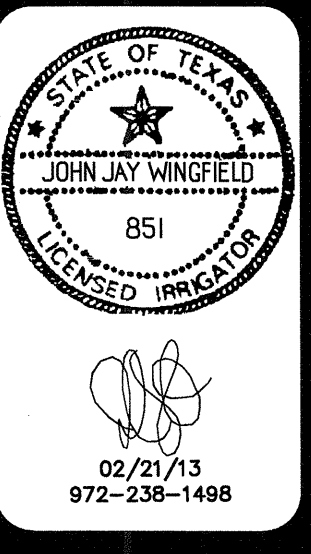


REFERENCE SHEET 35 FOR
 IRRIGATION NOTES AND LEGEND
 REFERENCE SHEET 48 FOR
 IRRIGATION SPEC'S AND DETAILS

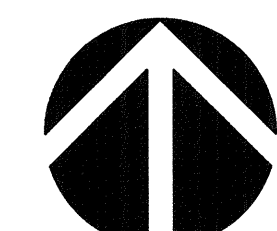

REVISIONS

IT OCT 11	REVISED IRRIGATION DUE TO BUILDING REVISIONS
21 FEB 13	IRRIGATE ROAD

Keller Springs Lofts
 EMBREY PARTNERS, LTD
 ADDISON, TEXAS

SCALE
 1" = 20'-0"

DATE
 19 AUG 2011

TITLE
 IRRIGATION

SHEET
 15 OF 4