



KELLER SPRINGS ROAD

LOCATIONS OF GROUND MOUNTED TRANSFORMERS AND POWER POLES ALONG KELLER SPRINGS ROAD SUBJECT TO CHANGE

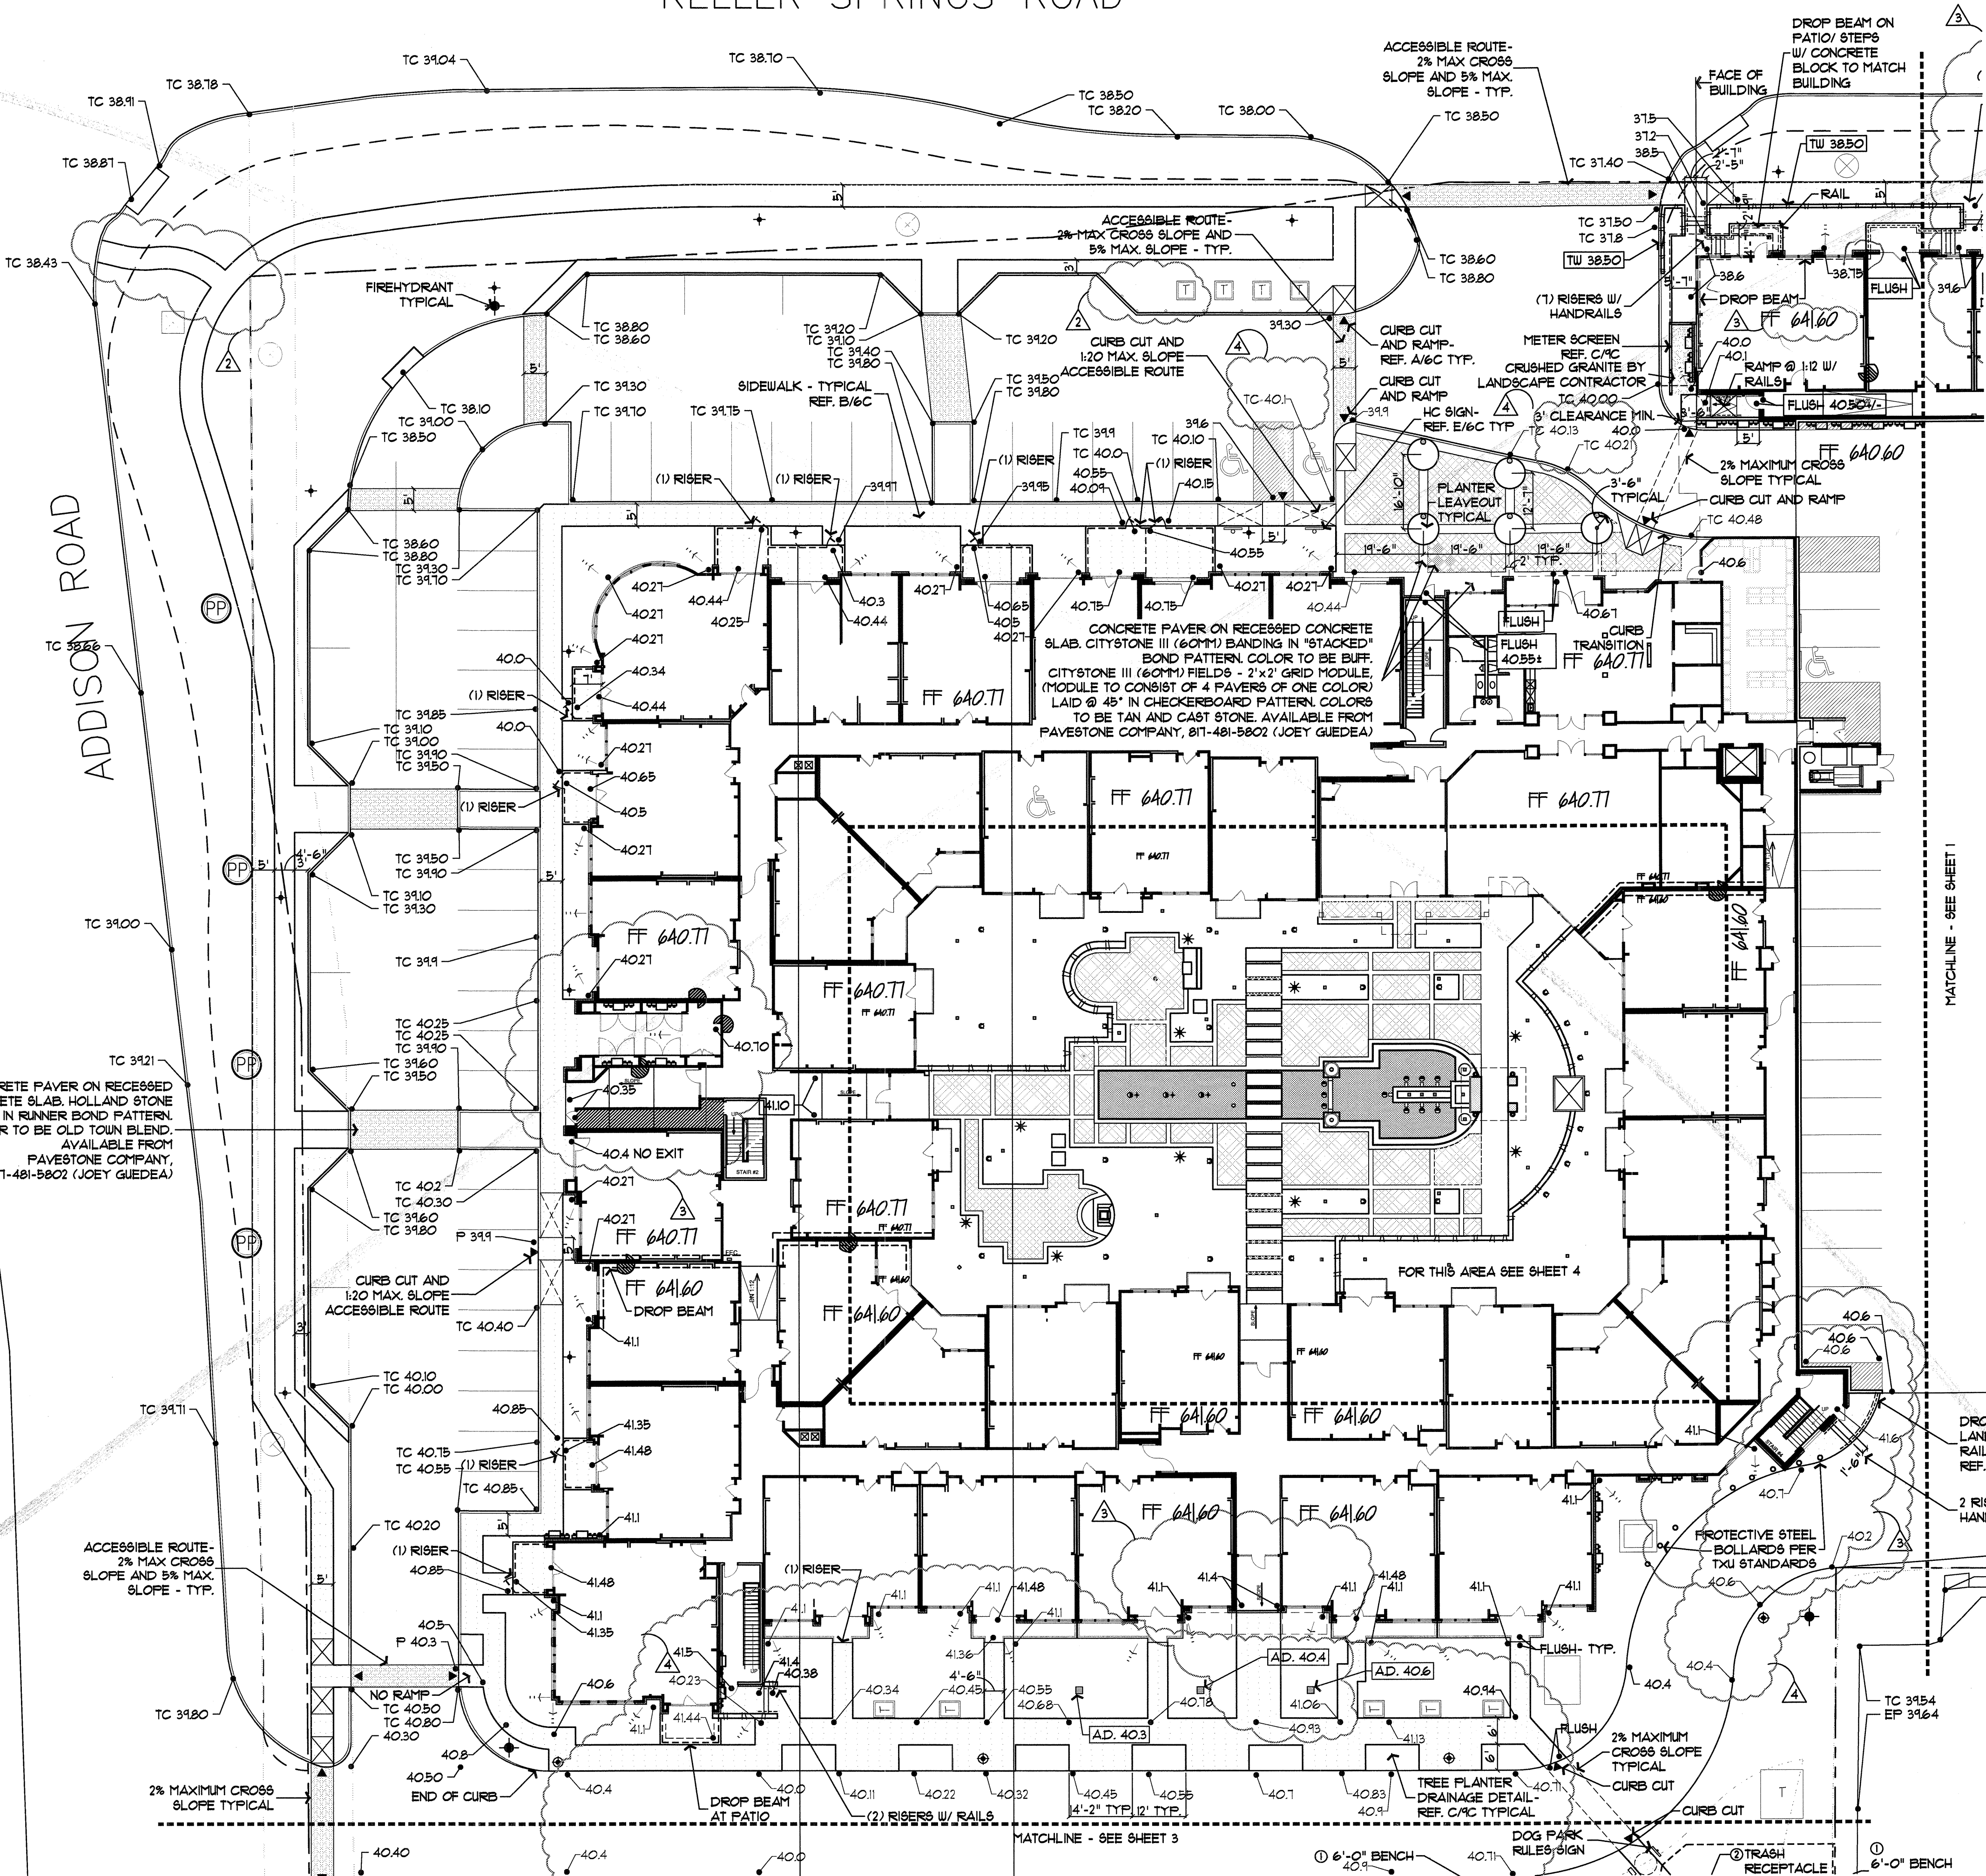

File Name: Keller Springs construction.dwg
Plot Date: 02/02/2012 - 02:53pm

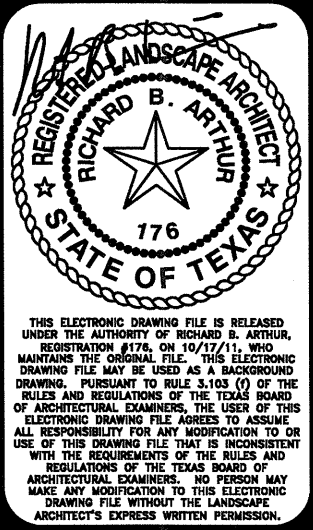

- REVISIONS
- 03 OCT 2011 TRANSFORMER REVISION AND ADDED BENCHKAT TO STREET
 - 11 OCT 2011 FLATWORK AND GRADE REVISIONS DUE TO BUILDING REVISIONS
 - 02 FEB 2012 GRADE REVISIONS DUE TO CIVIL COORDINATION

Keller Springs Lofts
EMBREY PARTNERS, LTD
ADDISON, TEXAS

