


LOCATIONS OF GROUND MOUNTED TRANSFORMERS AND POWER POLES ALONG KELLER SPRINGS ROAD SUBJECT TO CHANGE

KELLER SPRINGS ROAD

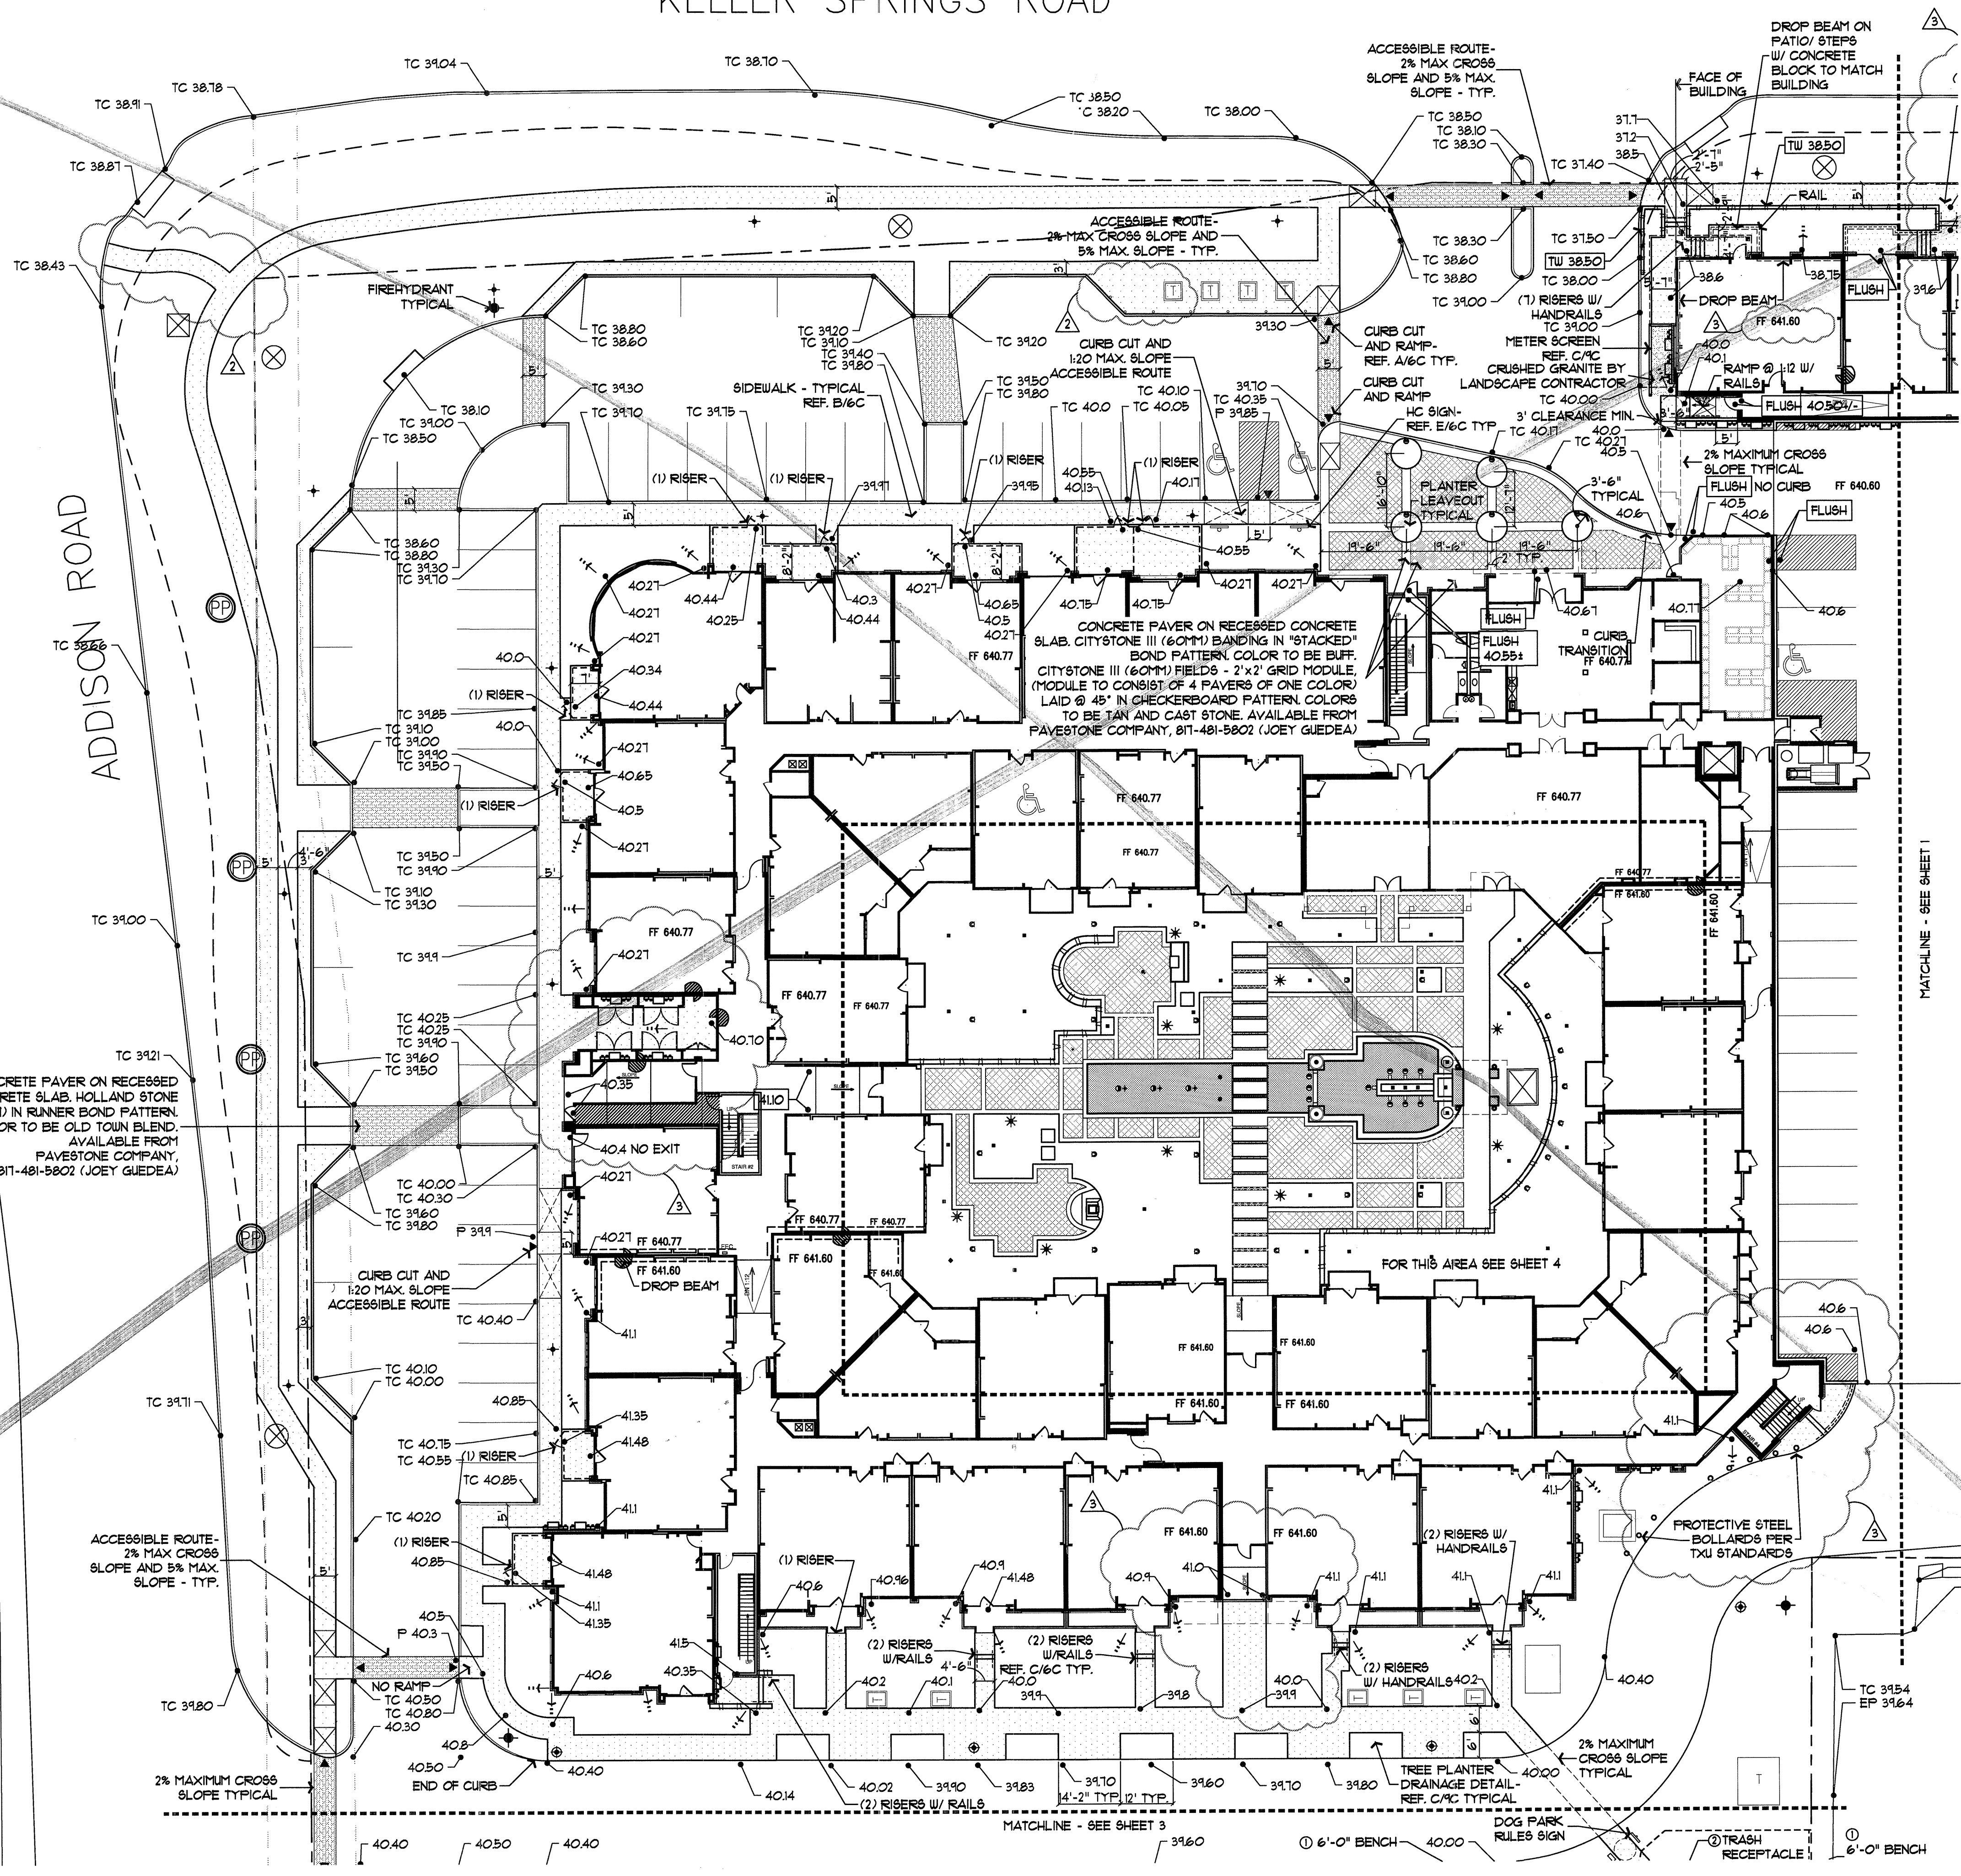


File Name: Keller Springs construction.dwg
 Plot Date: 10/21/2011 - 02:28pm

ENVIRO DESIGN
 LANDSCAPE ARCHITECTURE
 SITE PLANNING



7424 Greenville Ave., Suite 200 Dallas, TX 75231 (214) 987-3010

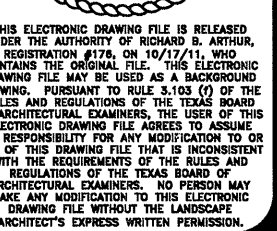

REVISIONS
 05 OCT 2011
 TRANSFORMER REVISION AND ACCORD SIDEWALK TO STREET
 17 OCT 2011
 PLANTING AND GRADE REVISIONS DUE TO BUILDING REVISIONS

Keller Springs Lofts
 EMBREY PARTNERS, LTD
 ADDISON, TEXAS

SCALE
 1" = 20'-0"

DATE
 19 AUG 2011

TITLE
 CONSTRUCTION

SHEET
 2C OF 9

