



KELLER SPRINGS ROAD

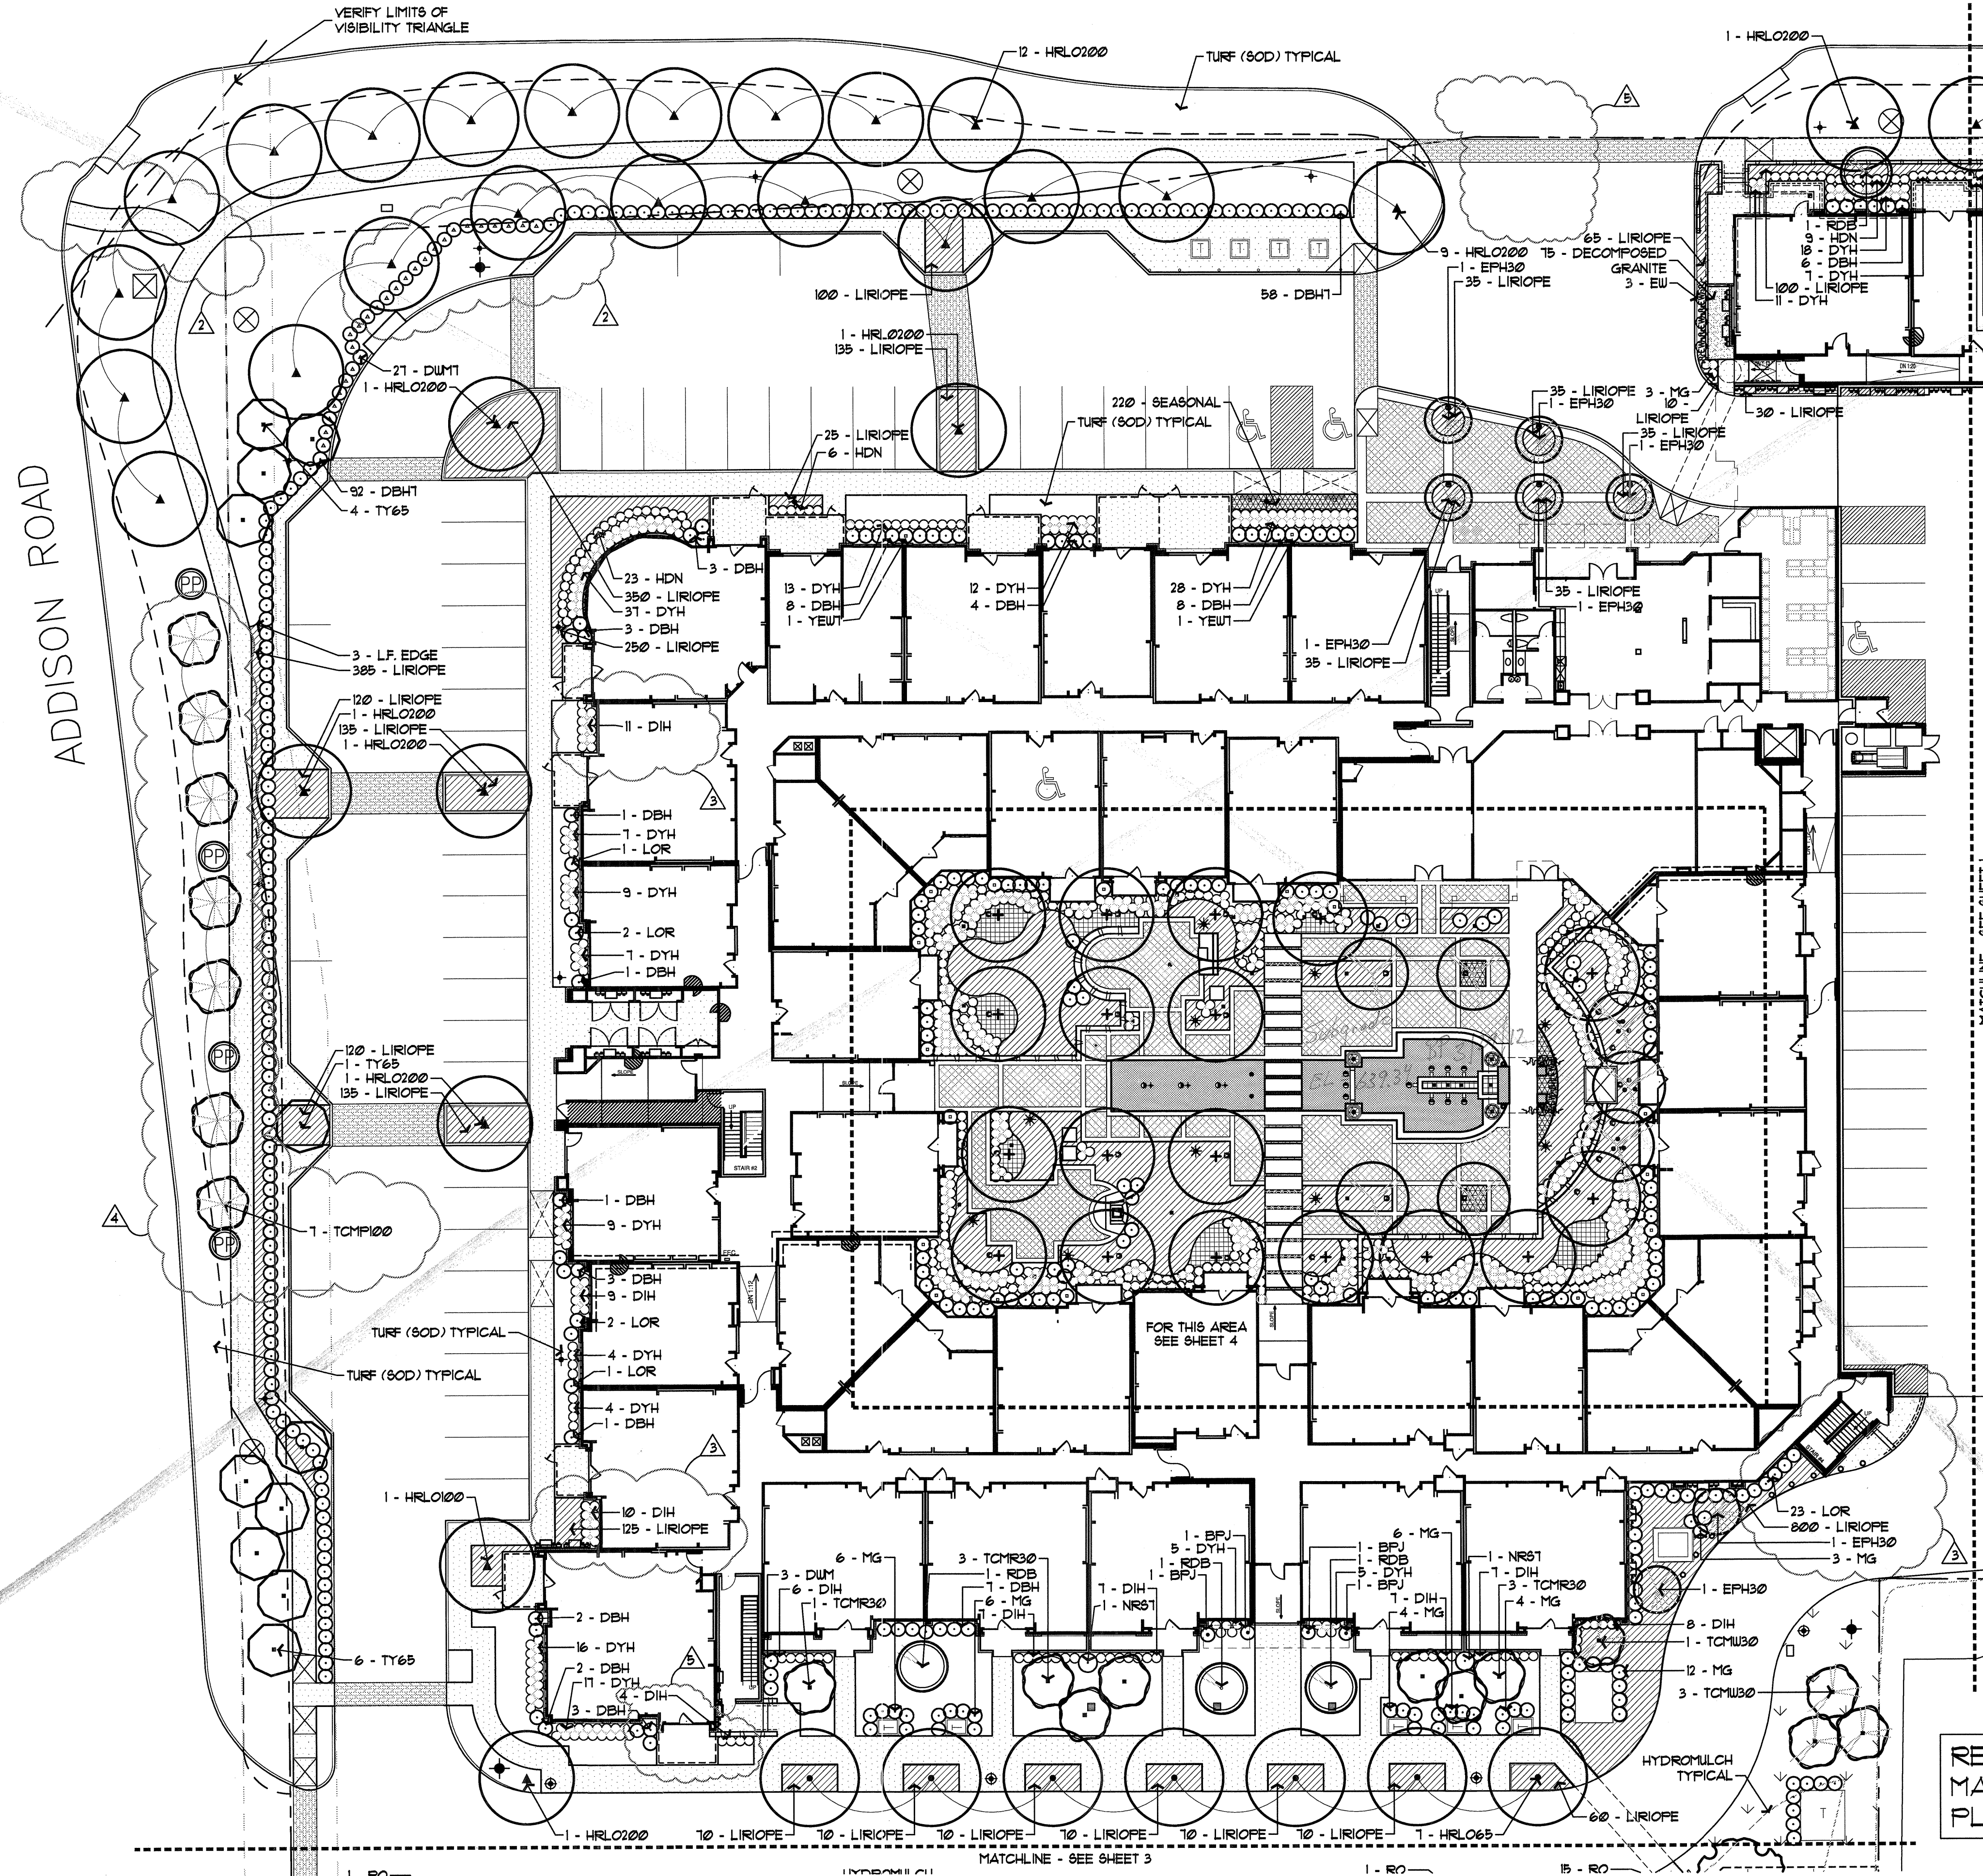

REFERENCE SHEET 3L FOR PLANT MATERIALS LIST AND SHEET 6L FOR PLANTING SPECIFICATIONS.

File Name: Keller Springs planting.dwg
 Plot Date: 02/02/2012 - 03:09pm

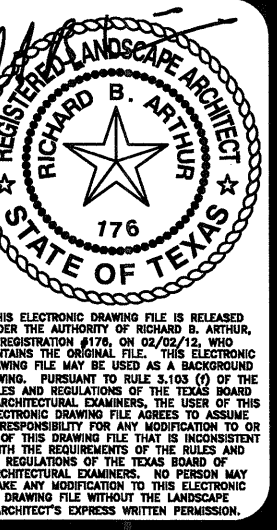

- REVISIONS
- 03 OCT 11 ADDED SIDEWALK TO STREET AND ADJUSTED BARRIERS TO GO ON BACK SIDE OF FIRE HYDRANT.
 - 17 OCT 11 REVISED PLANTING DUE TO BUILDING REVISIONS.
 - 31 OCT 11 REVISED TREE SPECIES ALONG ADDISON ROAD PER CITY CONCERN WITH OVERHEAD POWER LINES.
 - 02 FEB 12 REVISED PLANTING.

Keller Springs Lofts
 EMBREY PARTNERS, LTD
 ADDISON, TEXAS

SCALE
 1" = 20'-0"

DATE
 19 AUG 2011

TITLE
 LANDSCAPE

SHEET
 2L OF 6