



KELLER SPRINGS ROAD

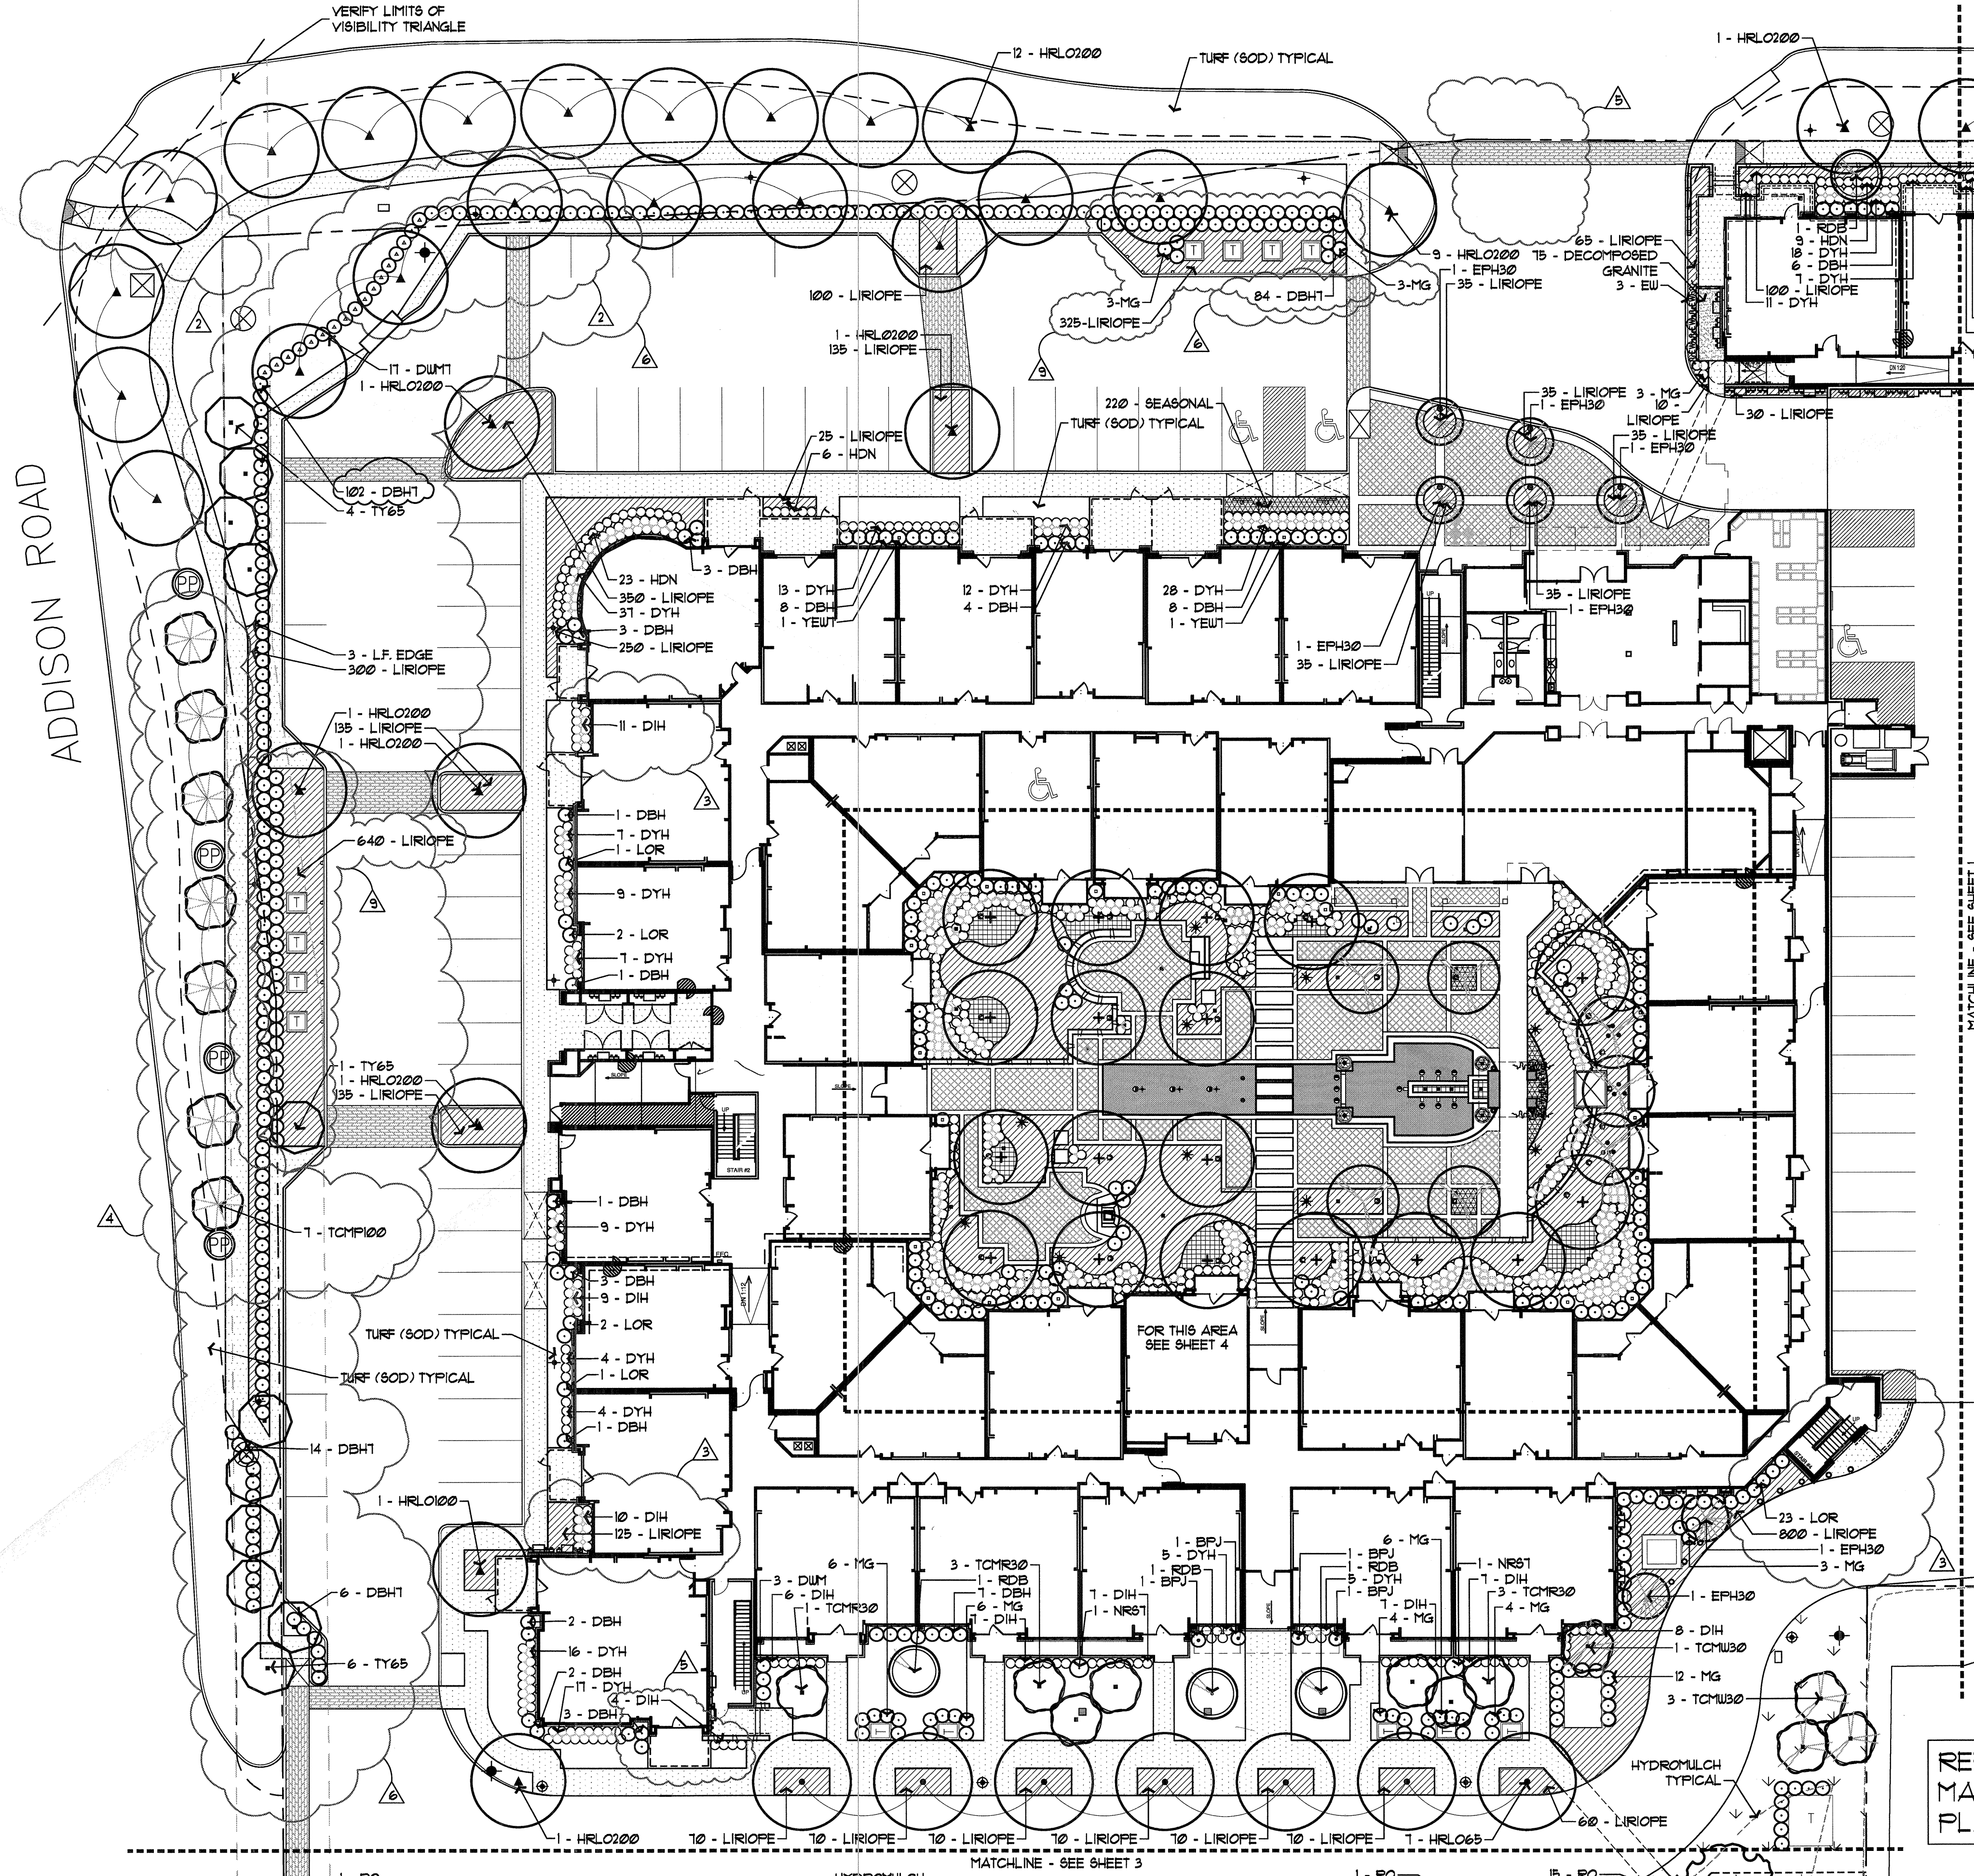

REFERENCE SHEET 3L FOR PLANT MATERIALS LIST AND SHEET 6L FOR PLANTING SPECIFICATIONS.

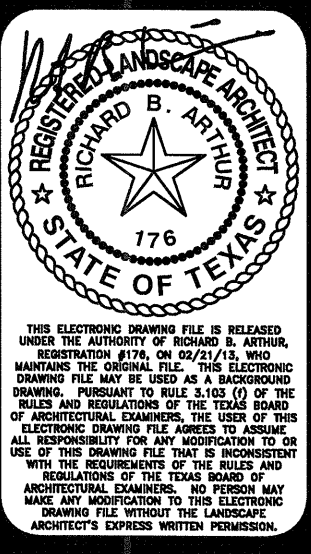

- REVISIONS
- 03 OCT 11 ADDED SIDEWALK TO STREET AND ADJUSTED BARRIERS TO GO ON BACK SIDE OF THE HYDRANT.
  - 17 OCT 11 REVISED PLANTING DUE TO BUILDING REVISIONS
  - 31 OCT 11 REVISED TREE SPECIES ALONG ADDISON ROAD PER CITY CONCERN WITH OVERHEAD POWER LINES
  - 02 FEB 12 REVISED PLANTING

- 26 APR 12 REVISED PLANTING DUE TO PARKING/SIDEWALK REVISIONS
- 21 FEB 13 CHANGED PAVED TRANSFER AREAS TO BE LANDSCAPED

Keller Springs Lofts  
 EMBREY PARTNERS, LTD  
 ADDISON, TEXAS

SCALE  
 1" = 20'-0"

DATE  
 19 AUG 2011

TITLE  
 LANDSCAPE

SHEET  
 2L OF 6

