



KELLER SPRINGS ROAD

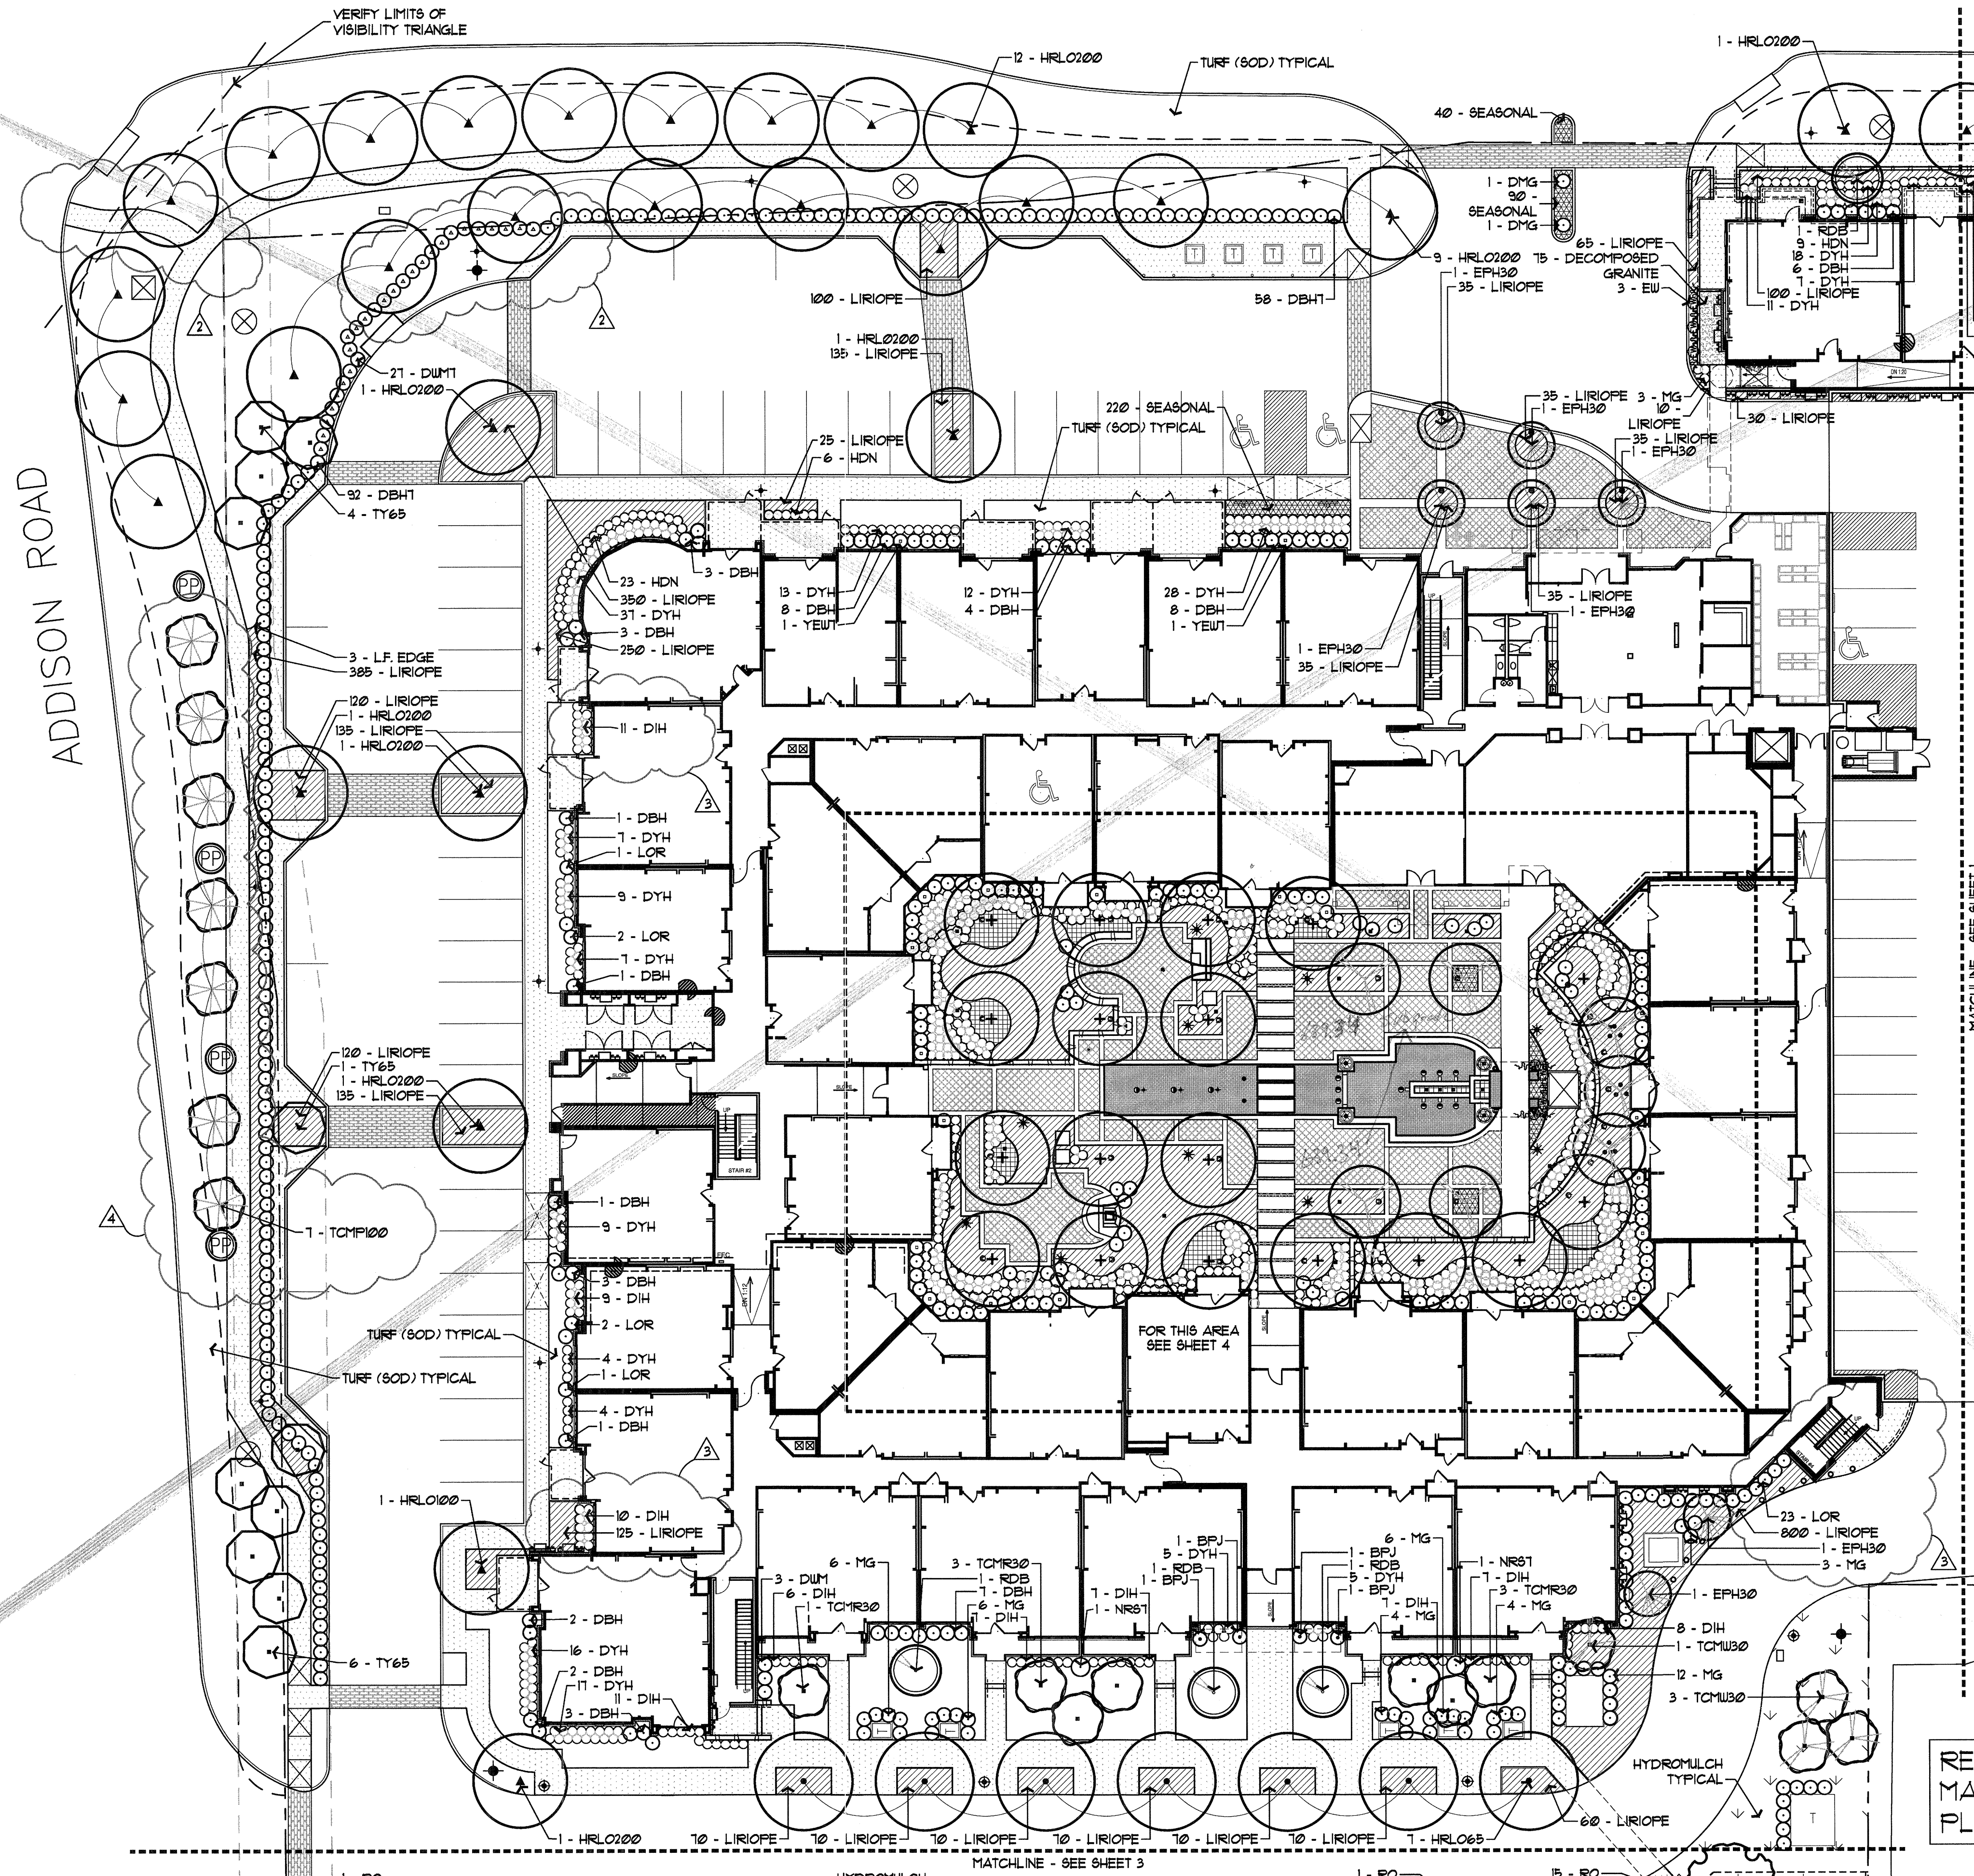

REFERENCE SHEET 3L FOR PLANT MATERIALS LIST AND SHEET 6L FOR PLANTING SPECIFICATIONS.

File Name: Keller Springs planting.dwg  
 Plot Date: 11/01/2011 - 08:24am

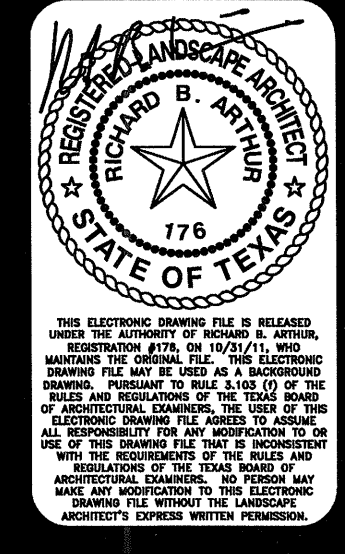

REVISIONS

03 OCT 11	ADDED SIDEWALK TO STREET AND ADJUSTED BARRIERS TO GO ON BACK SIDE OF FIRE HYDRANT.
17 OCT 11	REVISED PLANTINGS DUE TO BUILDING REVISIONS
31 OCT 11	REVISED TREE SPECIES ALONG ADDISON ROAD PER CITY CONCERN WITH OVERHEAD POWER LINES

Keller Springs Lofts  
 EMBREY PARTNERS, LTD  
 ADDISON, TEXAS

SCALE  
 1" = 20'-0"

DATE  
 19 AUG 2011

TITLE  
 LANDSCAPE

SHEET  
 2L OF 6