



KELLER SPRINGS ROAD

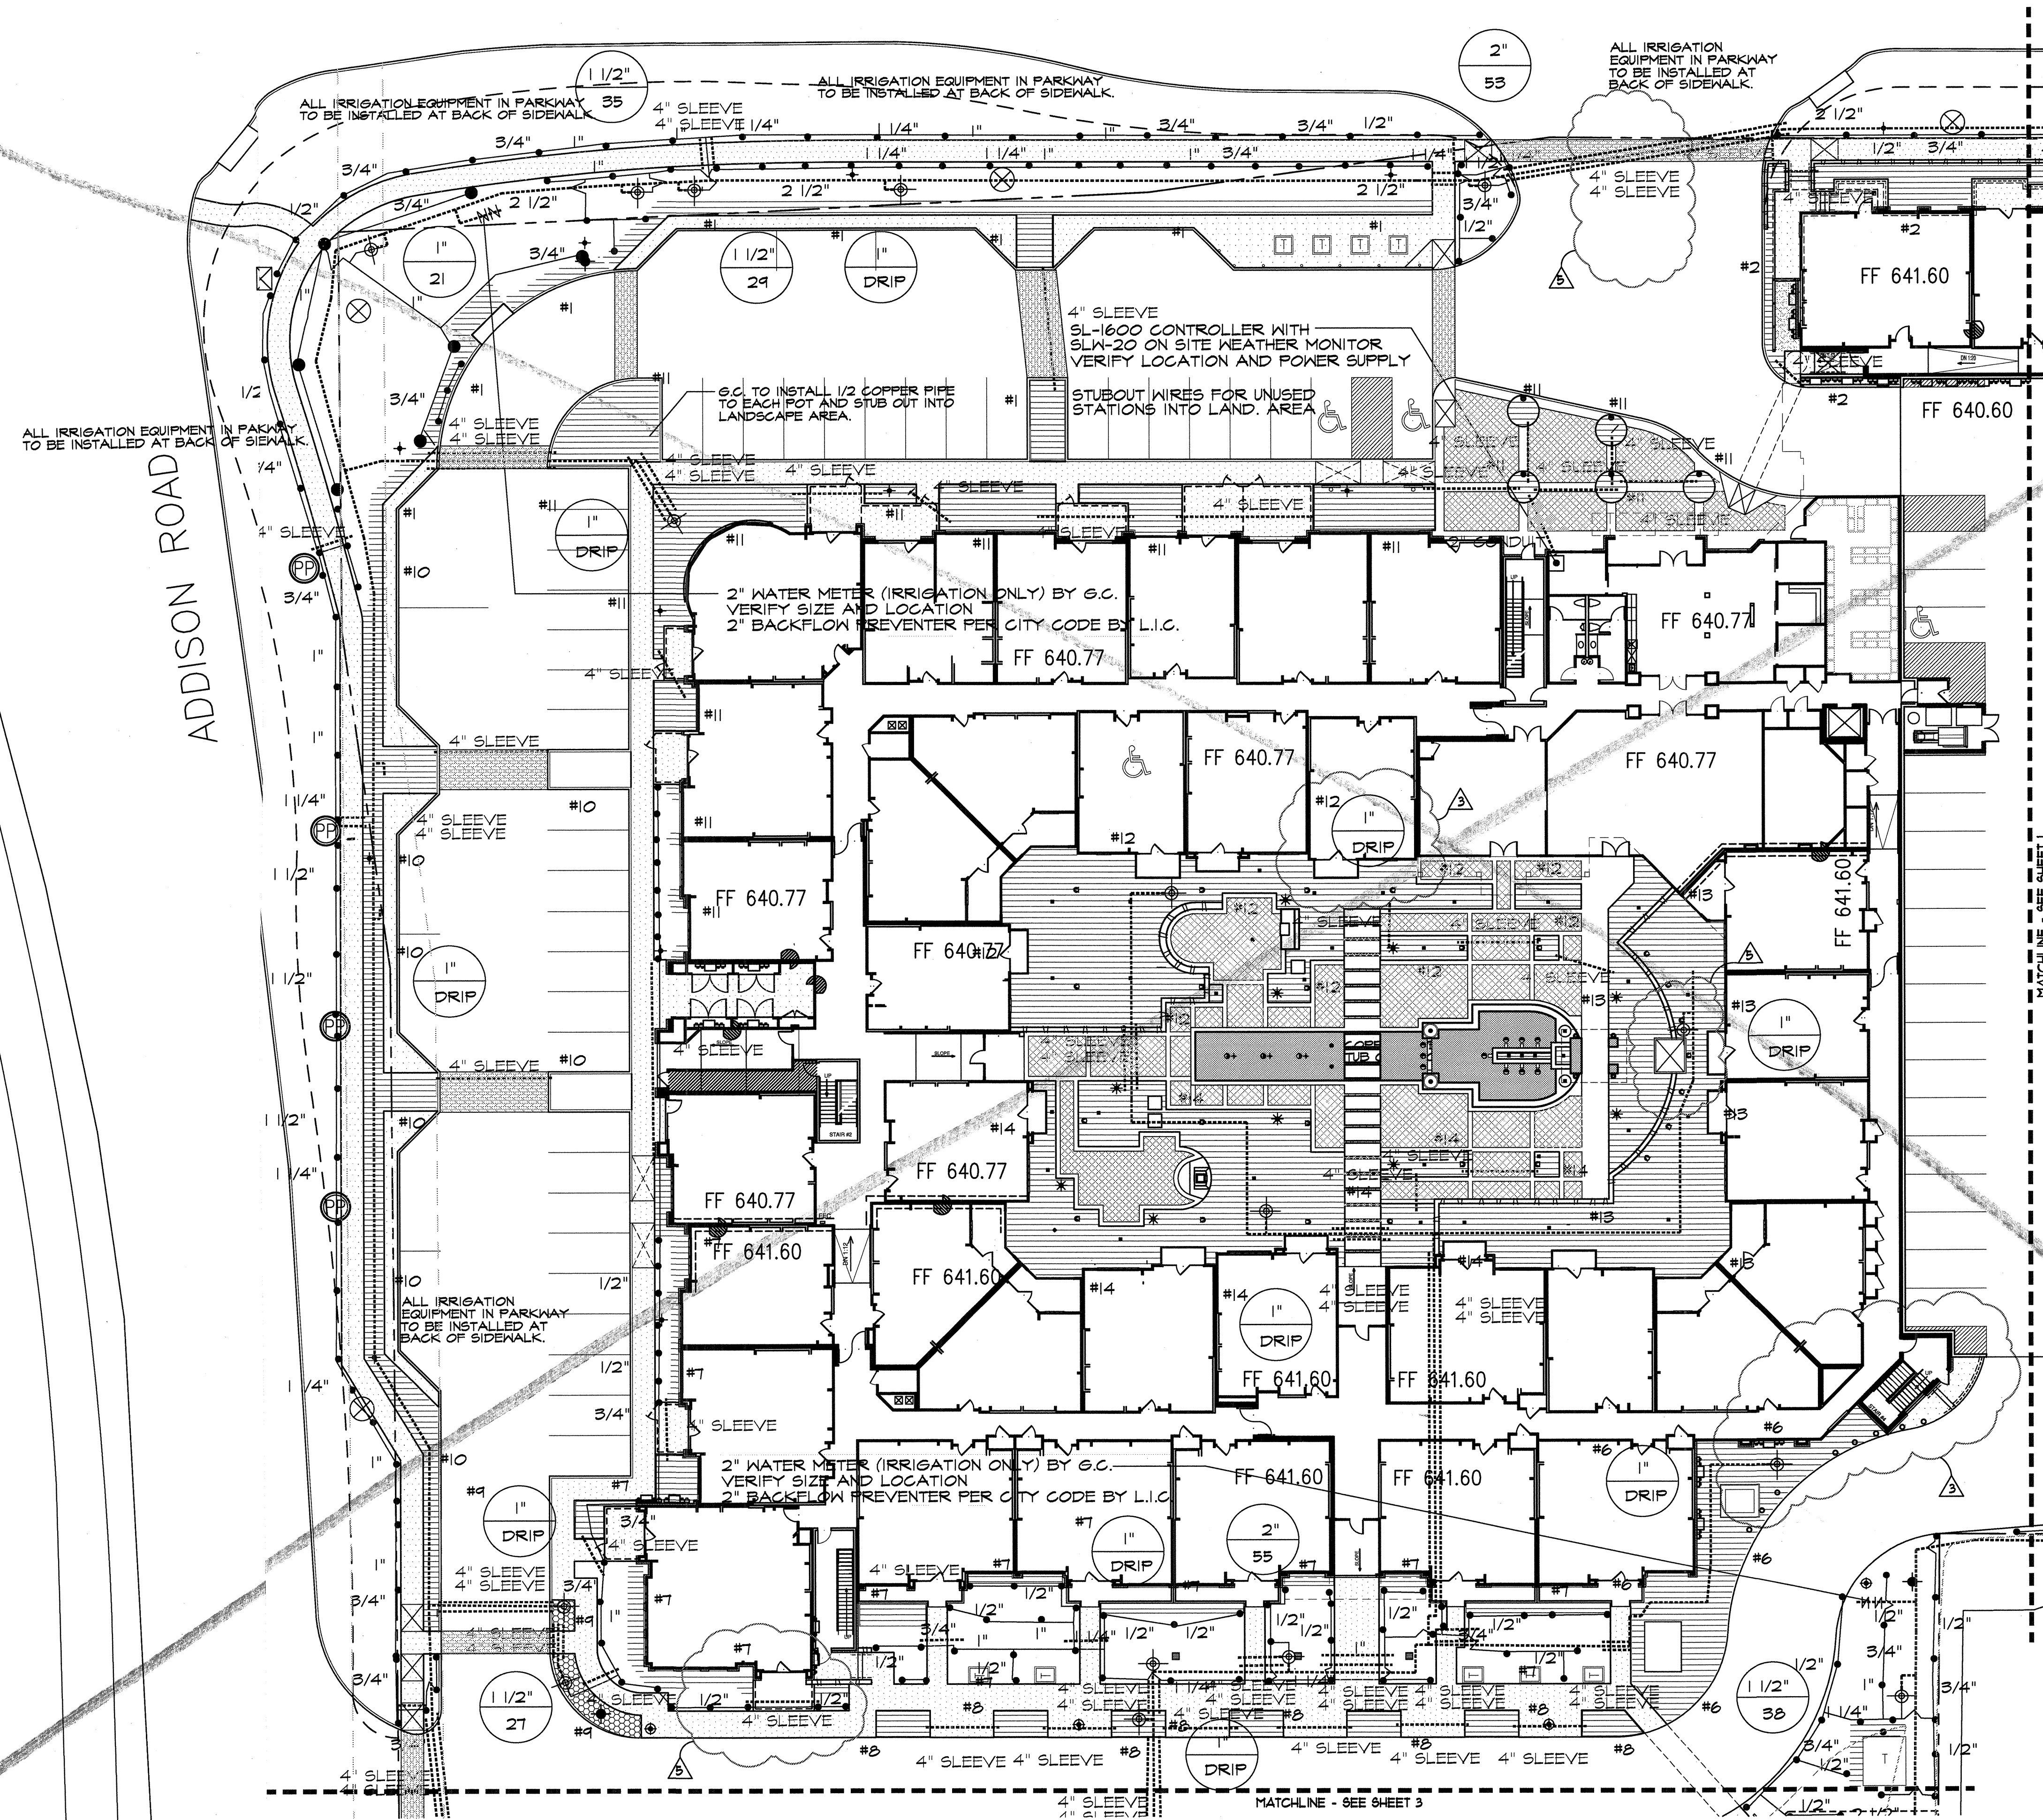

ADDISON ROAD

REFERENCE SHEET 36 FOR IRRIGATION NOTES AND LEGEND
 REFERENCE SHEET 46 FOR IRRIGATION SPECS AND DETAILS

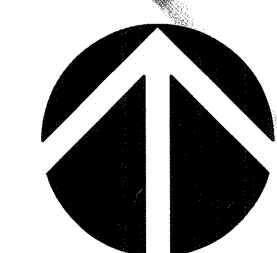

File Name: Keller Springs Irrigation.dwg
 Plot Date: 02/02/2012 - 03:09pm

REVISIONS

11 OCT 11	REVISED IRRIGATION DUE TO BUILDING REVISIONS
02 FEB 12	REVISED IRRIGATION DUE TO PATIO LOCATION RELOCATION OF VAULT IN FOUNTAIN COURTYARD AND REMOVAL OF MEDIAN AT ENTRY DRIVE OFF OF KELLER SPRINGS ROAD

Keller Springs Lofts
 EMBREY PARTNERS, LTD
 ADDISON, TEXAS

SCALE
 1" = 20'-0"

DATE
 19 AUG 2011

TITLE
 IRRIGATION

SHEET
 25 OF 4