



KELLER SPRINGS ROAD

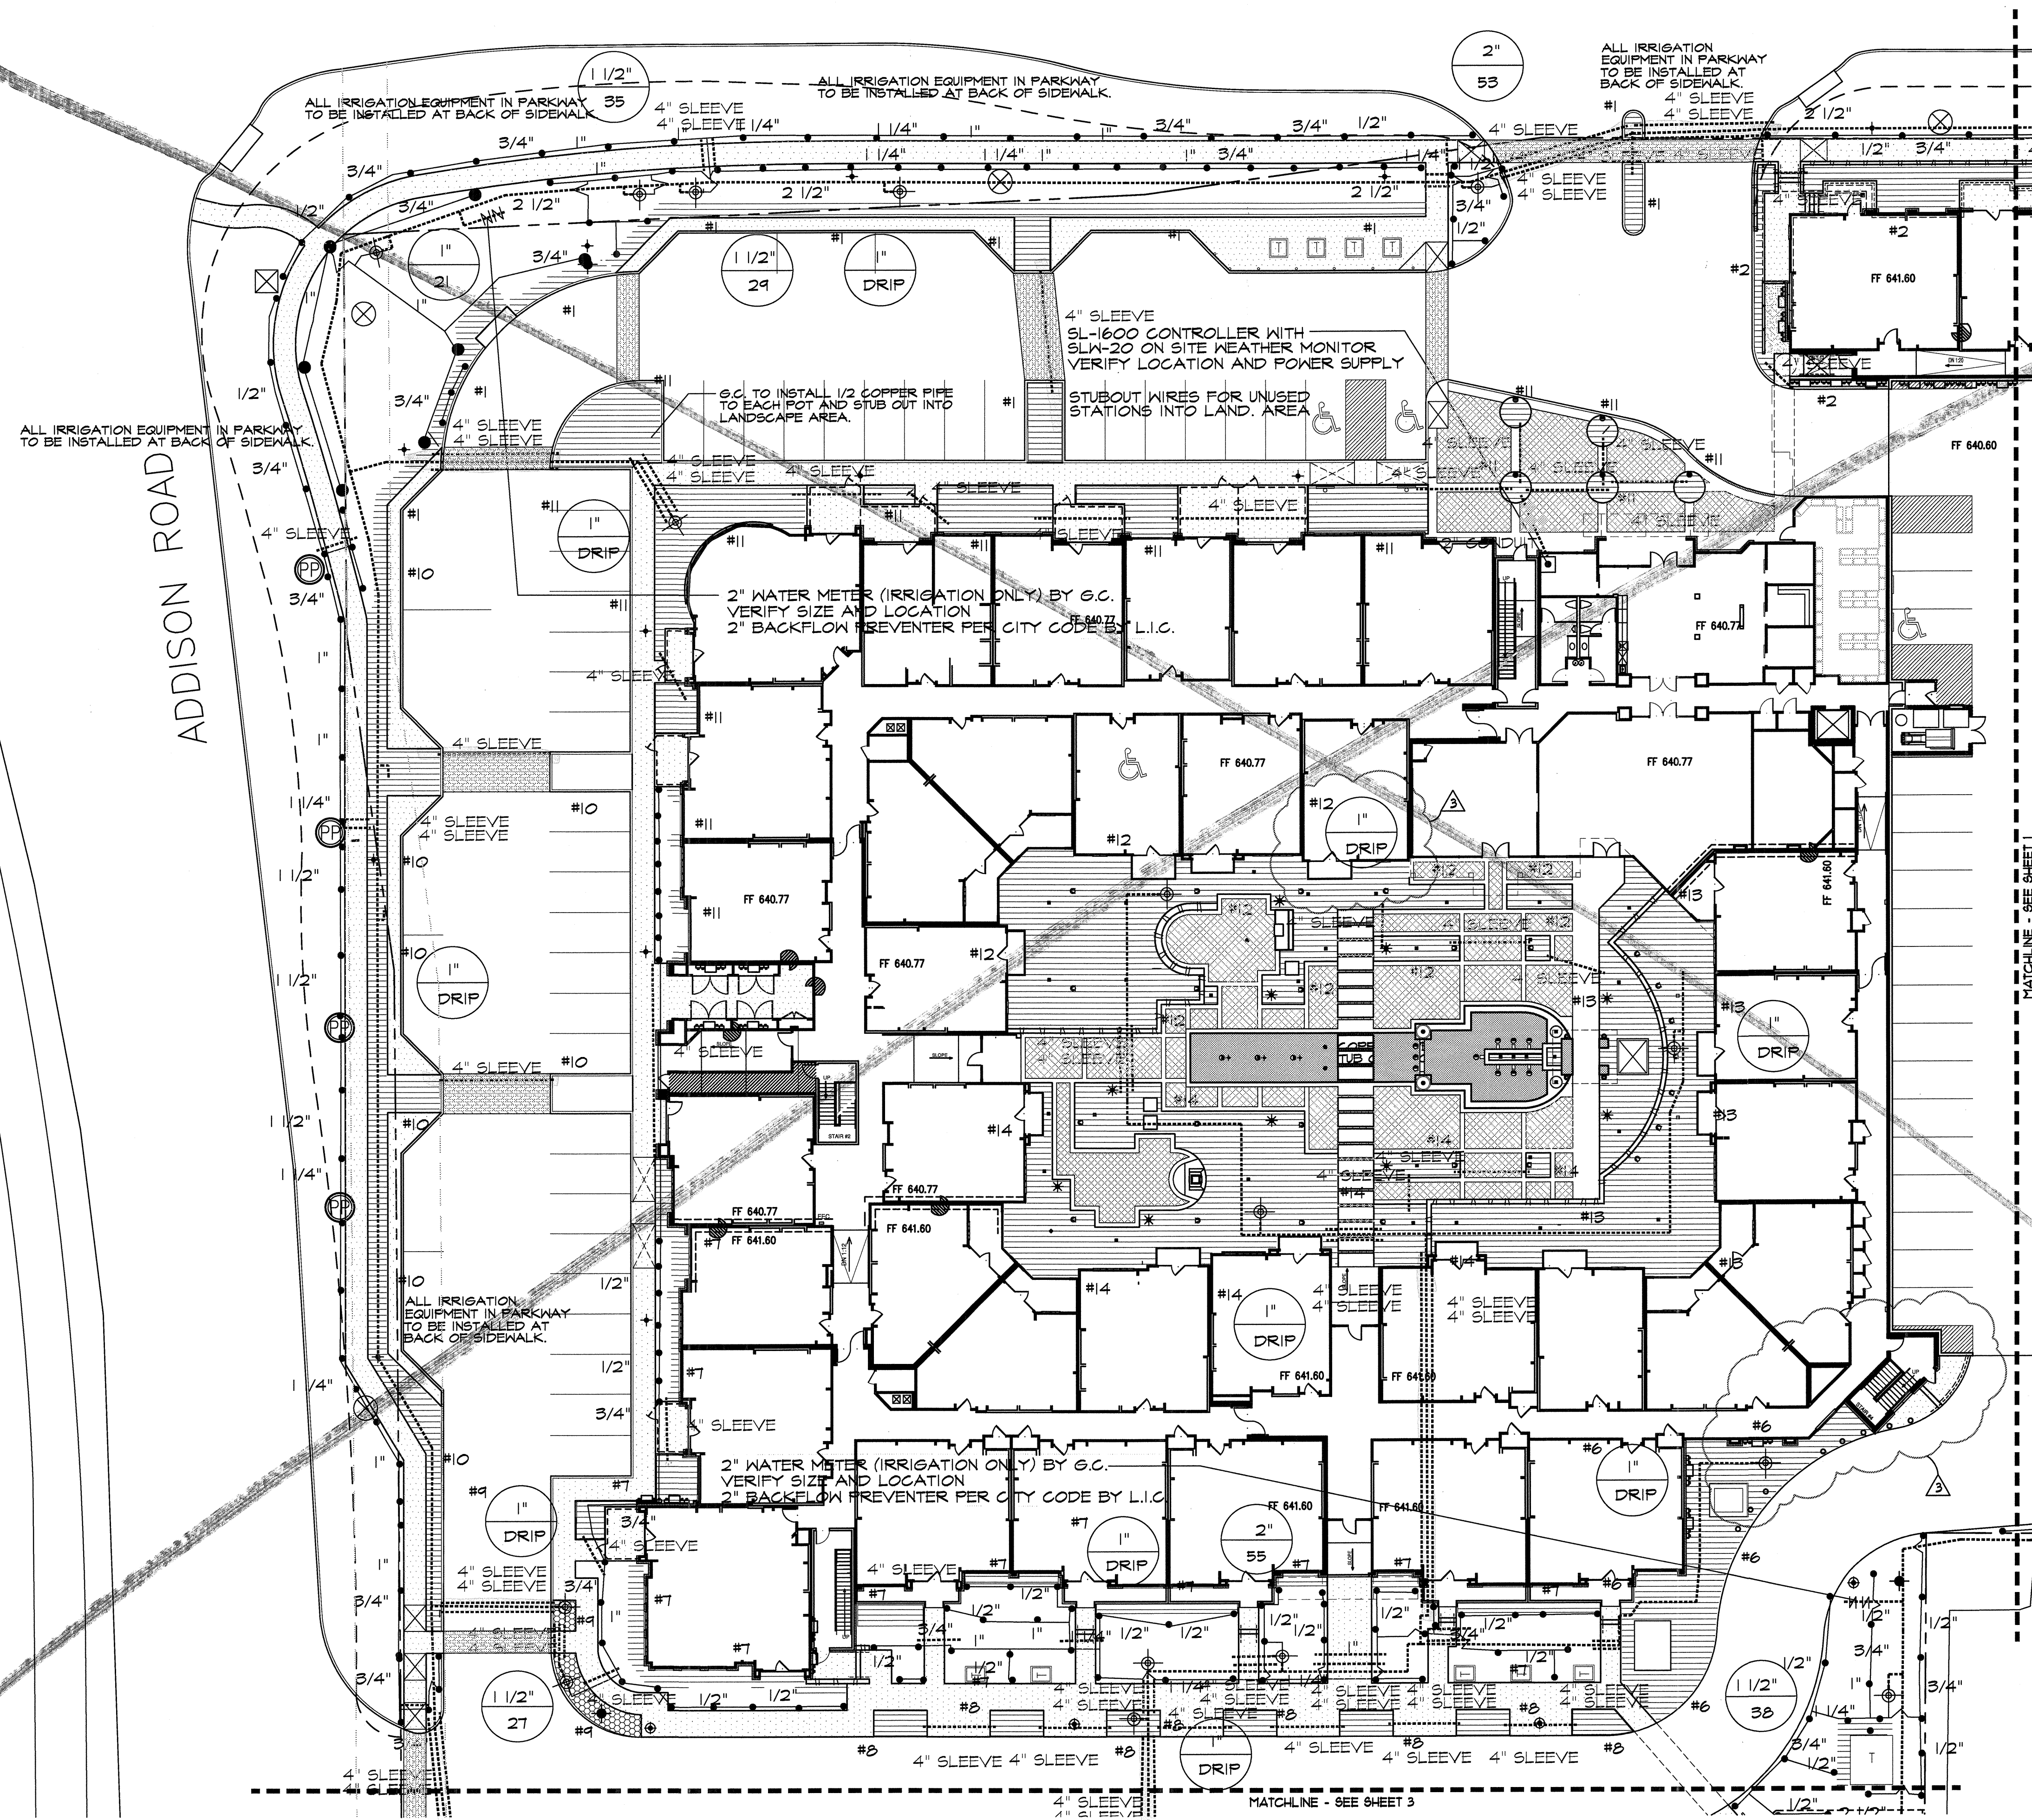


File Name: Keller Springs Irrigation.dwg
 Plot Date: 10/21/2011 - 02:37pm


REFERENCE SHEET 35 FOR
 IRRIGATION NOTES AND LEGEND
 REFERENCE SHEET 45 FOR
 IRRIGATION SPECS AND DETAILS

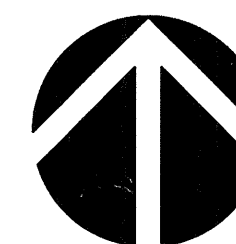

ENVIRO DESIGN
 LANDSCAPE ARCHITECTURE
 SITE PLANNING

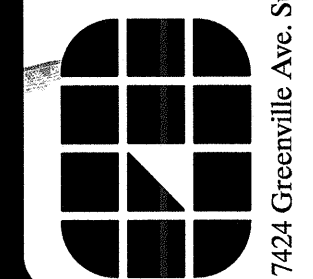

7424 Greenville Ave., Suite 200 Dallas, TX 75231 (214) 967-3010

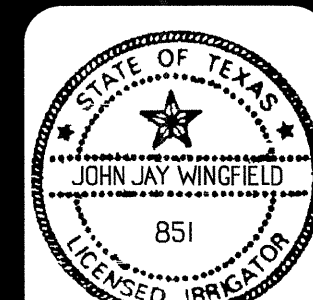

10/17/11
 972-238-1498

REVISIONS
 11 OCT 11
 REVISED IRRIGATION DUE TO
 BUILDING REVISIONS

Keller Springs Lofts
 EMBREY PARTNERS, LTD
 ADDISON, TEXAS

SCALE
 1" = 20'-0"

DATE
 19 AUG 2011

TITLE
 IRRIGATION

SHEET
 26 OF 4