


File Name: Keller_Springs_Irrigation.dwg
 Plot Date: 02/21/2013 - 09:56am



REFERENCE SHEET 38 FOR
 IRRIGATION NOTES AND LEGEND
 REFERENCE SHEET 48 FOR
 IRRIGATION SPECS AND DETAILS

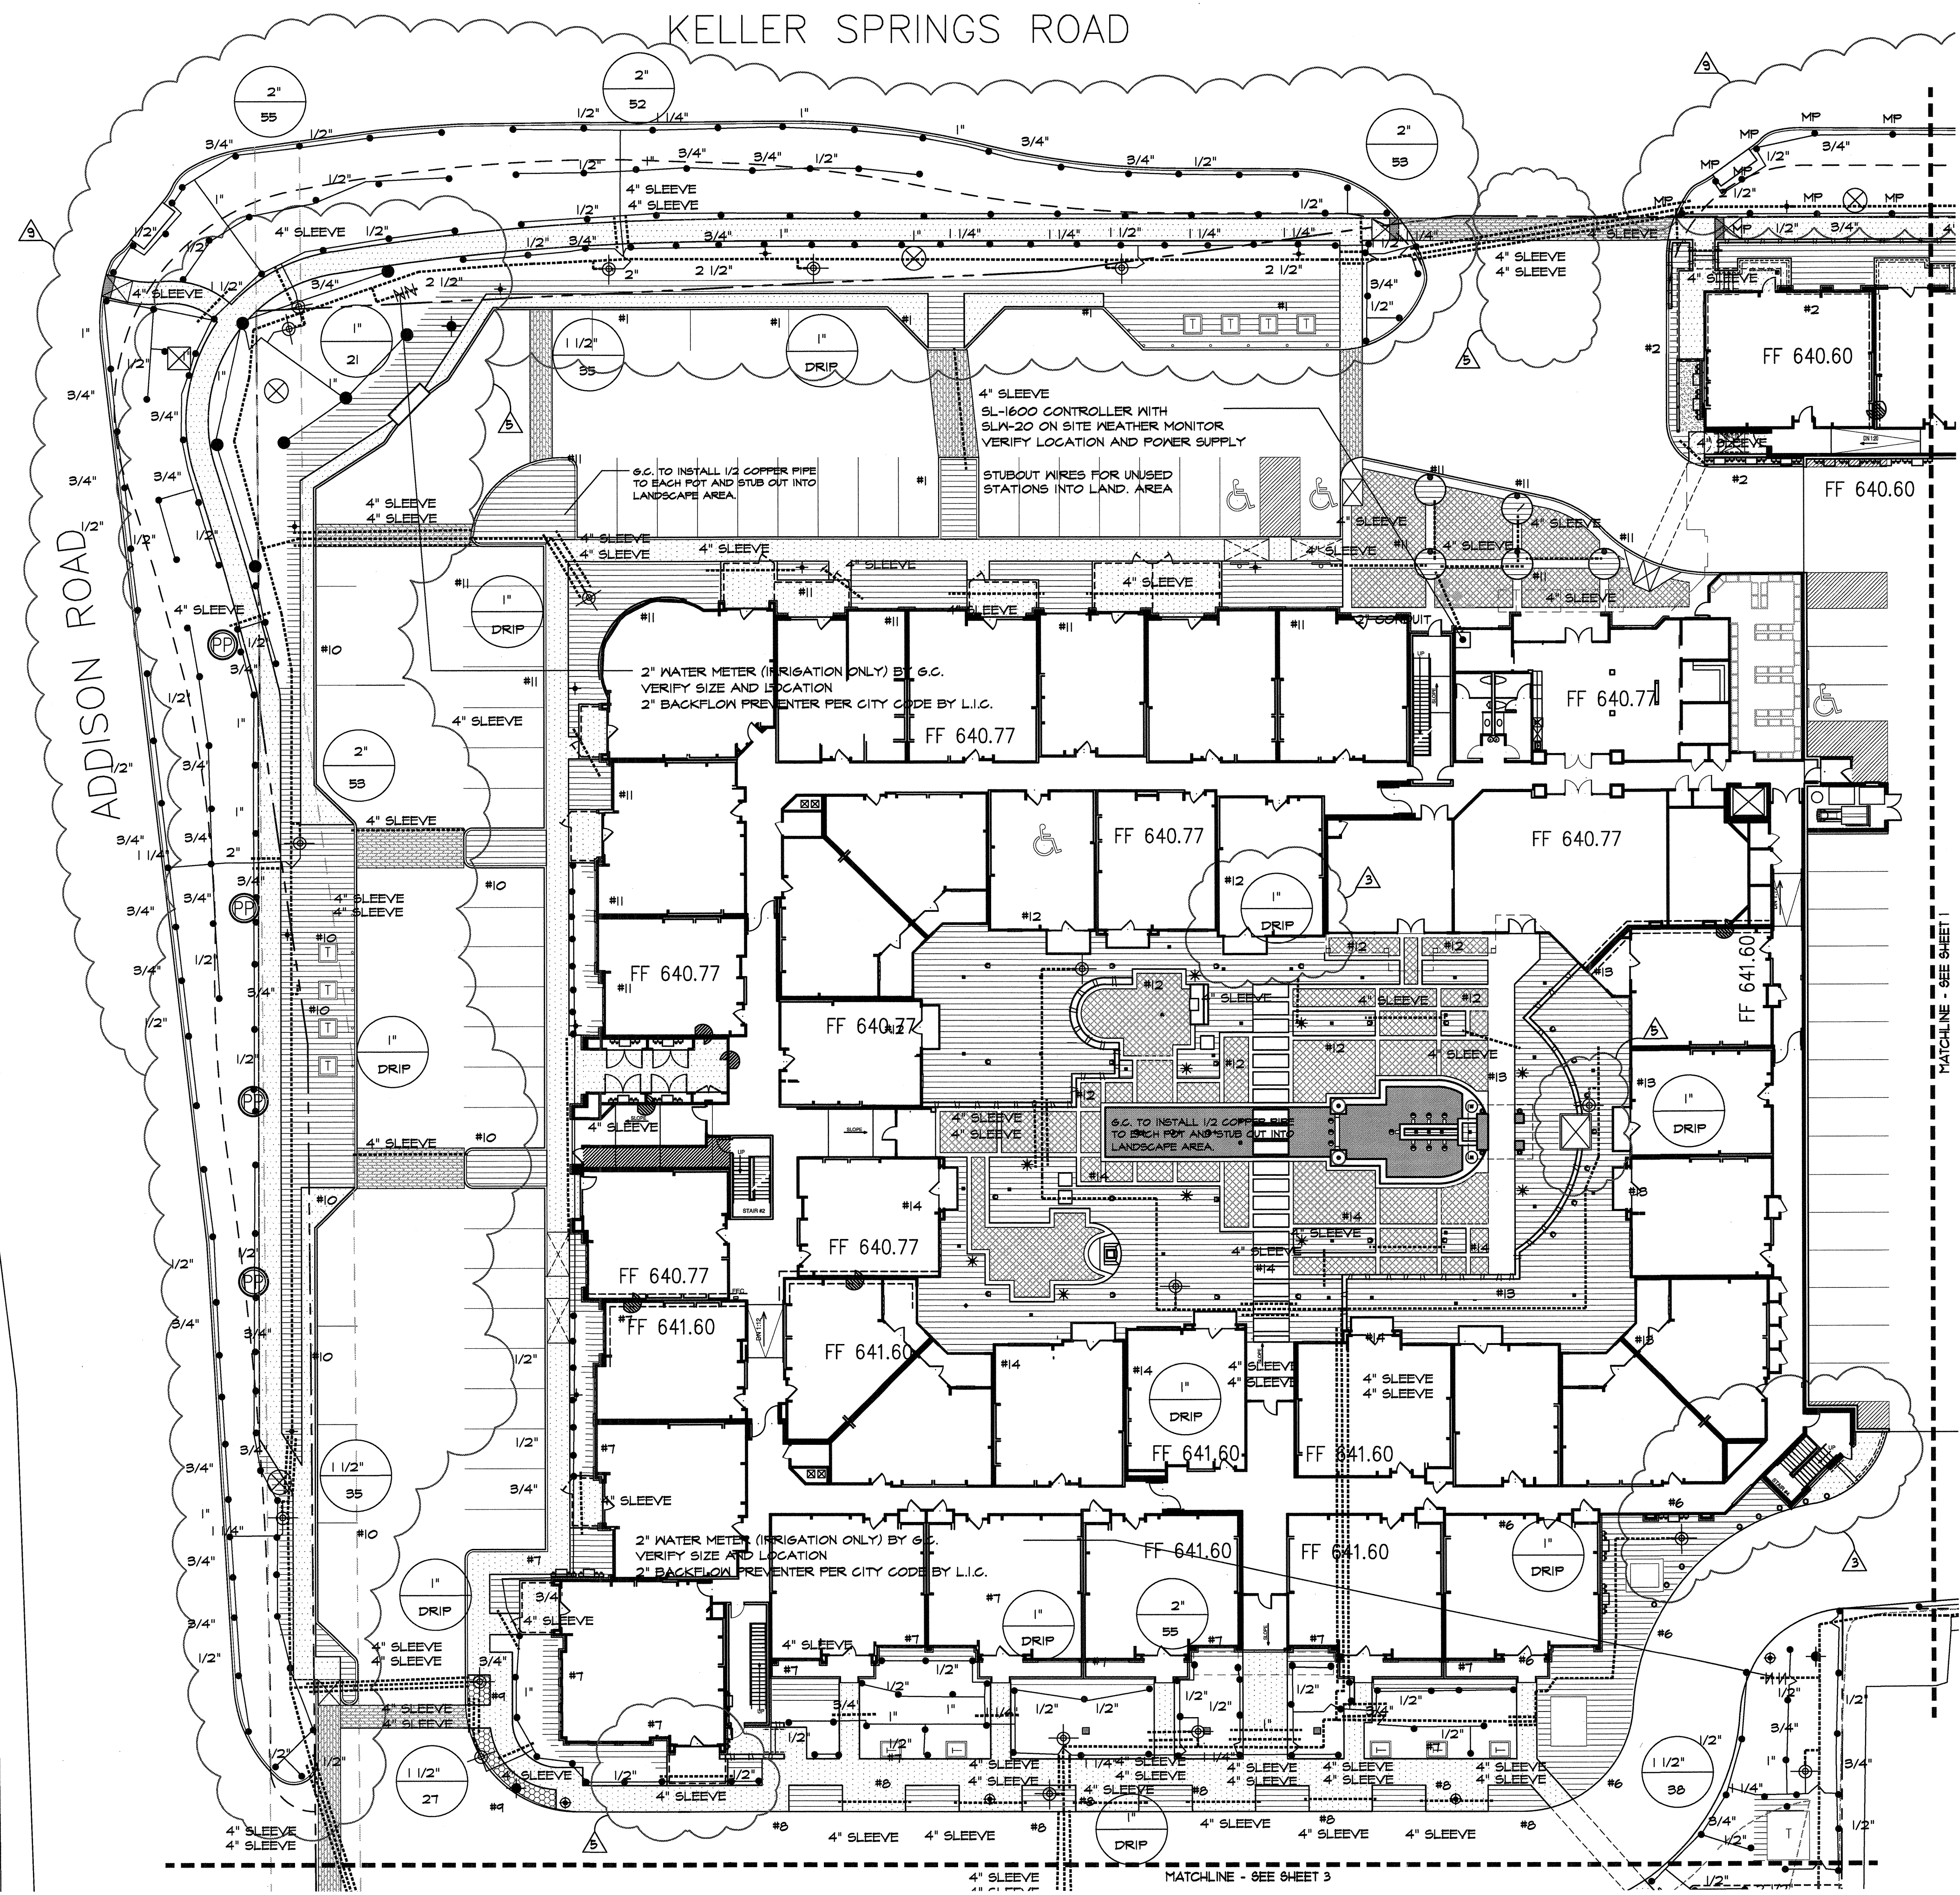