

REVISIONS

Keller Springs Lofts
EMBREY PARTNERS, LTD
ADDISON, TEXAS

SCALE

1" = 20'-0"

DATE


19 AUG 2011

TITLE

CONSTRUCTION

SHEET

3C OF 9

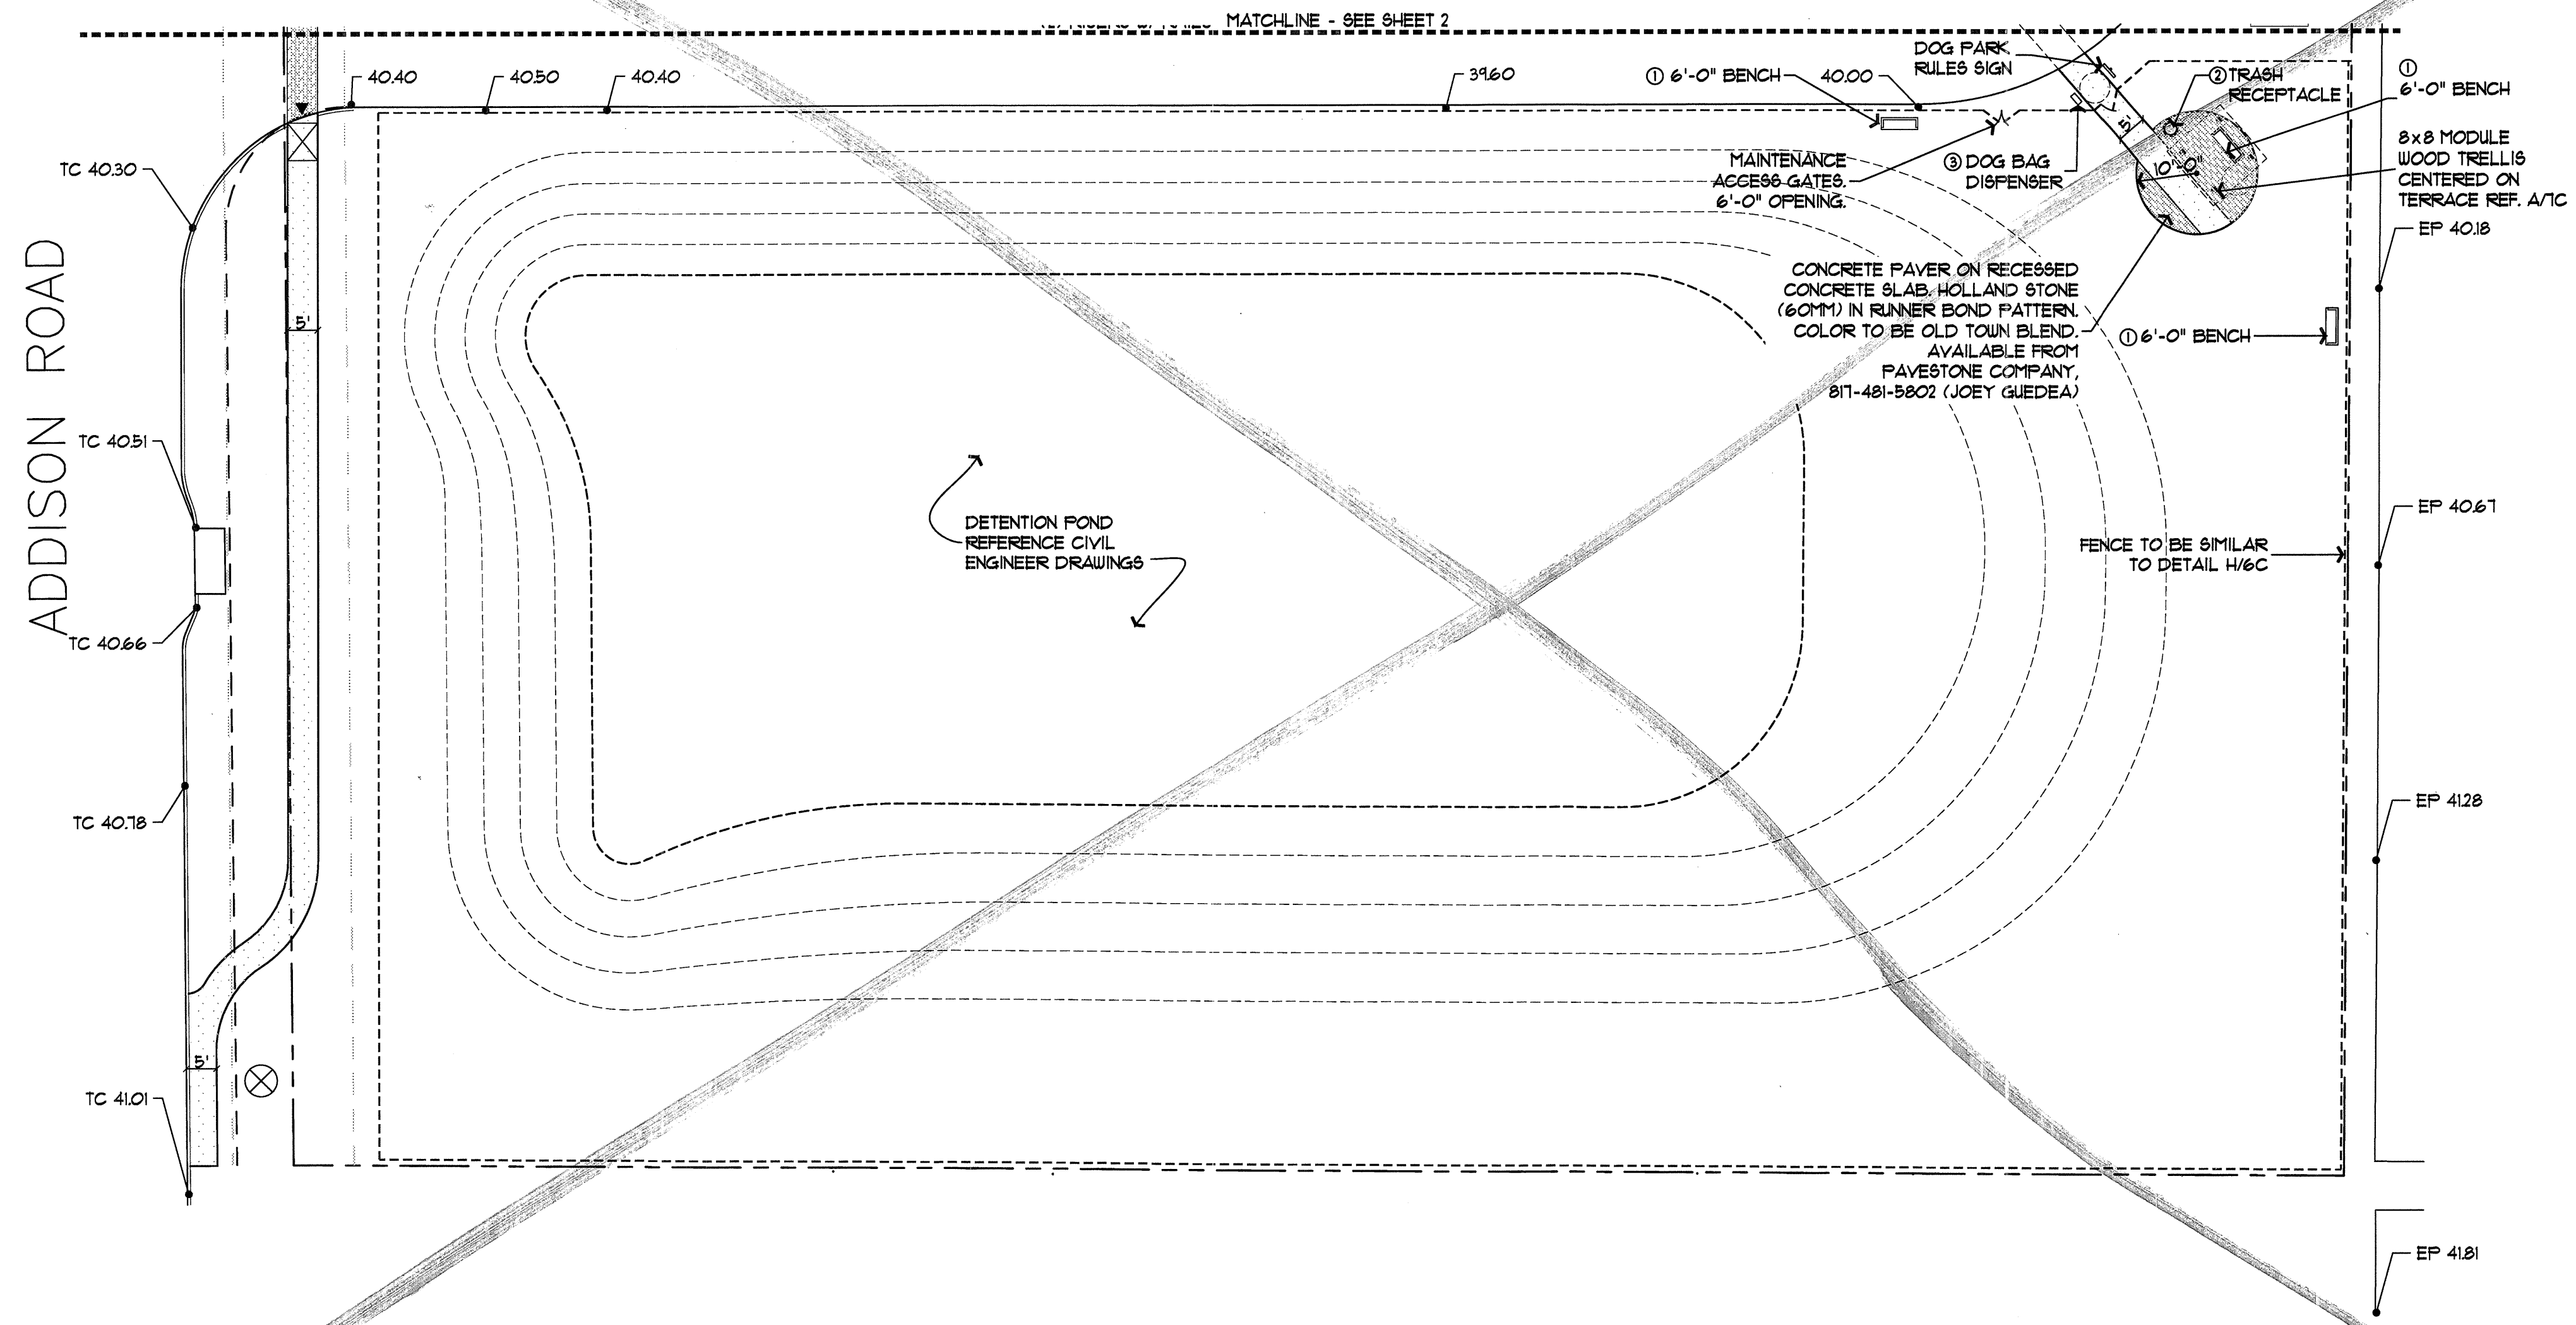

ACCESSORIES						
KEY	TYPE	STYLE	MODEL	MANUF	COLOR	QUAN
①	BENCH	PERFORATED	B&B PERFER 38	WEBCOAT	BY OWNER	3
②	TRASH RECEPTACLE	PERFORATED	TR32AVEFERF W/PLATOP 32	WEBCOAT	BY OWNER	1
③	DOG BAG DISPENSER	N/A	SELECTED BY OWNER	N/A	N/A	1
④	GALLERY PLANTER		GP-30A	PLANTCONTAINERS.COM	WEATHERED GRAY	8
⑤	GALLERY PLANTER		GP-40A	PLANTCONTAINERS.COM	WEATHERED GRAY	14
⑥	GAS GRILL	BGB SERIES	BGB3-BQ	DCS	STAINLESS	3

MFG. - WEBCOAT
WWW.WEBCOAT.COM
(800) 505-5101

MFG. - PLANTCONTAINERS.COM
WWW.PLANTCONTAINERS.COM
(866) 342-3330

MFG. - DCS
WWW.DCSAPPLIANCES.COM
(800) 433-8466

