


CONSTRUCTION LEGEND

TOP OF CURB GRADE	TC XXXX
PROPOSED GRADE	XXXX
TOP OF WALL GRADE	TW XXXX
AREA DRAIN ELEVATION	AD. XXXX
AREA DRAIN	[Symbol]
DECK DRAIN ELEVATION	D.D. XXXX
DECK DRAIN	[Symbol]
PROPOSED CONTOUR	[Symbol]
DIRECTION OF DRAINAGE	[Symbol]
STONE WALL	[Symbol]
BRICK WALL	[Symbol]
SLOPED WALL	[Symbol]
SPECIAL PAVING (REFERENCE PLAN)	[Symbol]
WOOD FENCE	[Symbol]
ORNAMENTAL FENCE	[Symbol]
POOL FENCE	[Symbol]
HANDRAIL / RAILING	[Symbol]
SIDEWALK POST LIGHT	[Symbol]
COURTYARD BOLLARD LIGHT	[Symbol]
TREE UPLIGHT	[Symbol]
SCENCE LIGHT	[Symbol]
POOL LIGHT	[Symbol]
FOUNTAIN LIGHT	[Symbol]
LED LIGHT	[Symbol]
DRAIN LINE	[Symbol]
JUNCTION BOX	[Symbol]
PROPOSED TREE BALL	[Symbol]
POOL DEPTH (FEET AND INCHES)	[Symbol]
POOL DIMENSIONS	[Symbol]
AIR CONDITIONER	[Symbol]
TRANSFORMER	[Symbol]
ELECTRICAL METERS	[Symbol]
BARRIER-FREE RAMP AND CURB OPENING	[Symbol]
BARRIER-FREE RAMP	[Symbol]
ACCESSIBLE ROUTE 1:20 MAX. SLOPE	[Symbol]
CURB OPENING	[Symbol]
IRRIGATION SLEEVE	[Symbol]

- #### LIGHTING SCHEDULE
- * COURTYARD BOLLARDS AS SELECTED BY OWNER
 - TREE UPLIGHTS AS SELECTED BY OWNER
 - SCENCE LIGHT AS SELECTED BY OWNER

NOTE:

- REFER TO SHEET 1C FOR CONSTRUCTION AND ACCESSIBILITY NOTES.
- REFER TO SHEET 3C FOR ACCESSORIES LIST
- REFER TO SHEET 5C FOR PAVING MATERIALS
- CONNECT DECK / AREA DRAINS TO STORM SEWER. REFERENCE CIVIL ENGINEER'S PLANS FOR LOCATION OF STORM SEWER DRAINS AND DRAINLINE TO BE SIZED BY CIVIL ENGINEER.
- ALL ROOF DOWNSPOUTS DISCHARGING INTO COURTYARD AREAS SHALL BE TIED INTO THE UNDERGROUND STORM DRAIN SYSTEM (REF. CIVIL).

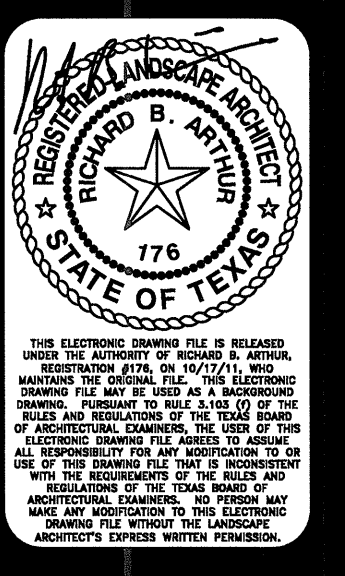

REVISIONS

23 AUG 2011	REVISED LIGHTING SCHEDULE
17 OCT 2011	PLATFORM AND GRADE REVISIONS DUE TO BUILDING REVISIONS

SCALE
 1/8" = 1'-0"

DATE
 19 AUG 2011

TITLE
 CONSTRUCTION

SHEET
 4C OF 9

