

EMBREY BUILDERS, LLC.
 1020 N. E. Loop 410, Suite 700
 San Antonio, TX 78209
 Ph: (210) 824-6044 Fax: (210) 824-7656

RFI

To: Enviro Design Landscape
 7424 Greenville Ave, Suite 200
 Dallas, TX 75231
 Ph: 214/987-3010 Fax: 214/987-3015

RFI #: 14
 Date: 12/14/2011
 Job: EB-02 Keller Springs Lofts
 Phone: 877-777-5115

CC: David Gallagher (Embrey Build (Embrey Construction LLC))

Subject: Drinking fountain

Drawing: L5C
 Cost Impact: None
 Spec Section:
 Schedule Impact: None

Request: Please verify that there is a drinking fountain in the swimming pool courtyard. If there is please provide location
 Date Required: 12/21/2011

Requested by: Bryan Pickler
 Embrey Partners, Ltd.

Response:
 THERE IS A DRINKING FOUNTAIN SPECIFIED FOR THE POOL COURTYARD. REFERENCE SHEET EC. THE DRINKING FOUNTAIN IS SHOWN JUST NORTH OF THE CURVED TROUSERS ON THE EDGE OF THE POOL DECK. THE MODEL NUMBER, DECK AND MANUFACTURER ARE NOTED ON THE MATERIAL TAKE OFF ON THE RIGHT HAND SIDE OF SHEET EC.

Answered by: SHIRO DESIG
 Date: 12-16-2011

Page 1 of 1

EMBREY BUILDERS, LLC.
 1020 N. E. Loop 410, Suite 700
 San Antonio, TX 78209
 Ph: (210) 824-6044 Fax: (210) 824-7656

RFI

To: Jordan & Skala Engineers, Inc.
 14240 Midway Road, Suite 350
 Dallas, TX 75244
 Ph: 469/385-1610 Fax: 469/385-1615

RFI #: 51
 Date: 2/7/2012
 Job: EB-02 Keller Springs Lofts
 Phone: 877-777-5115

CC: David Gallagher (Embrey Build (Embrey Construction LLC))

Subject: Pool and fountain equipment drain requirements

Drawing: landscape EC
 Cost Impact: None
 Spec Section:
 Schedule Impact: None

Request: Jordan and Skala,
 Date Required: 2/14/2012



In discussing the courtyard fountain and pool equipment requirements with our pool contractor, it has come to our attention that since the pool equipment will have a chlorinated filter system, by code, we are required to run that into the sanitary sewer. The fact that the fountain equipment is run with a non-chlorinated system, the pool contractor believes that the fountain equipment can be run into the existing storm sewer system in the fountain courtyard. Therefore we need Jordan and Skala to revise the plans accordingly. Please reference landscape sheet EC of 9 for pool equipment location.

Requested by: Bryan Pickler
 Embrey Partners, Ltd.

Response:
 A 6" sanitary waste line has been routed to pool equipment area for pool drainage. See attached sketch.

Answered by: Russell Cox
 Date: 2-16-2012

Page 1 of 1

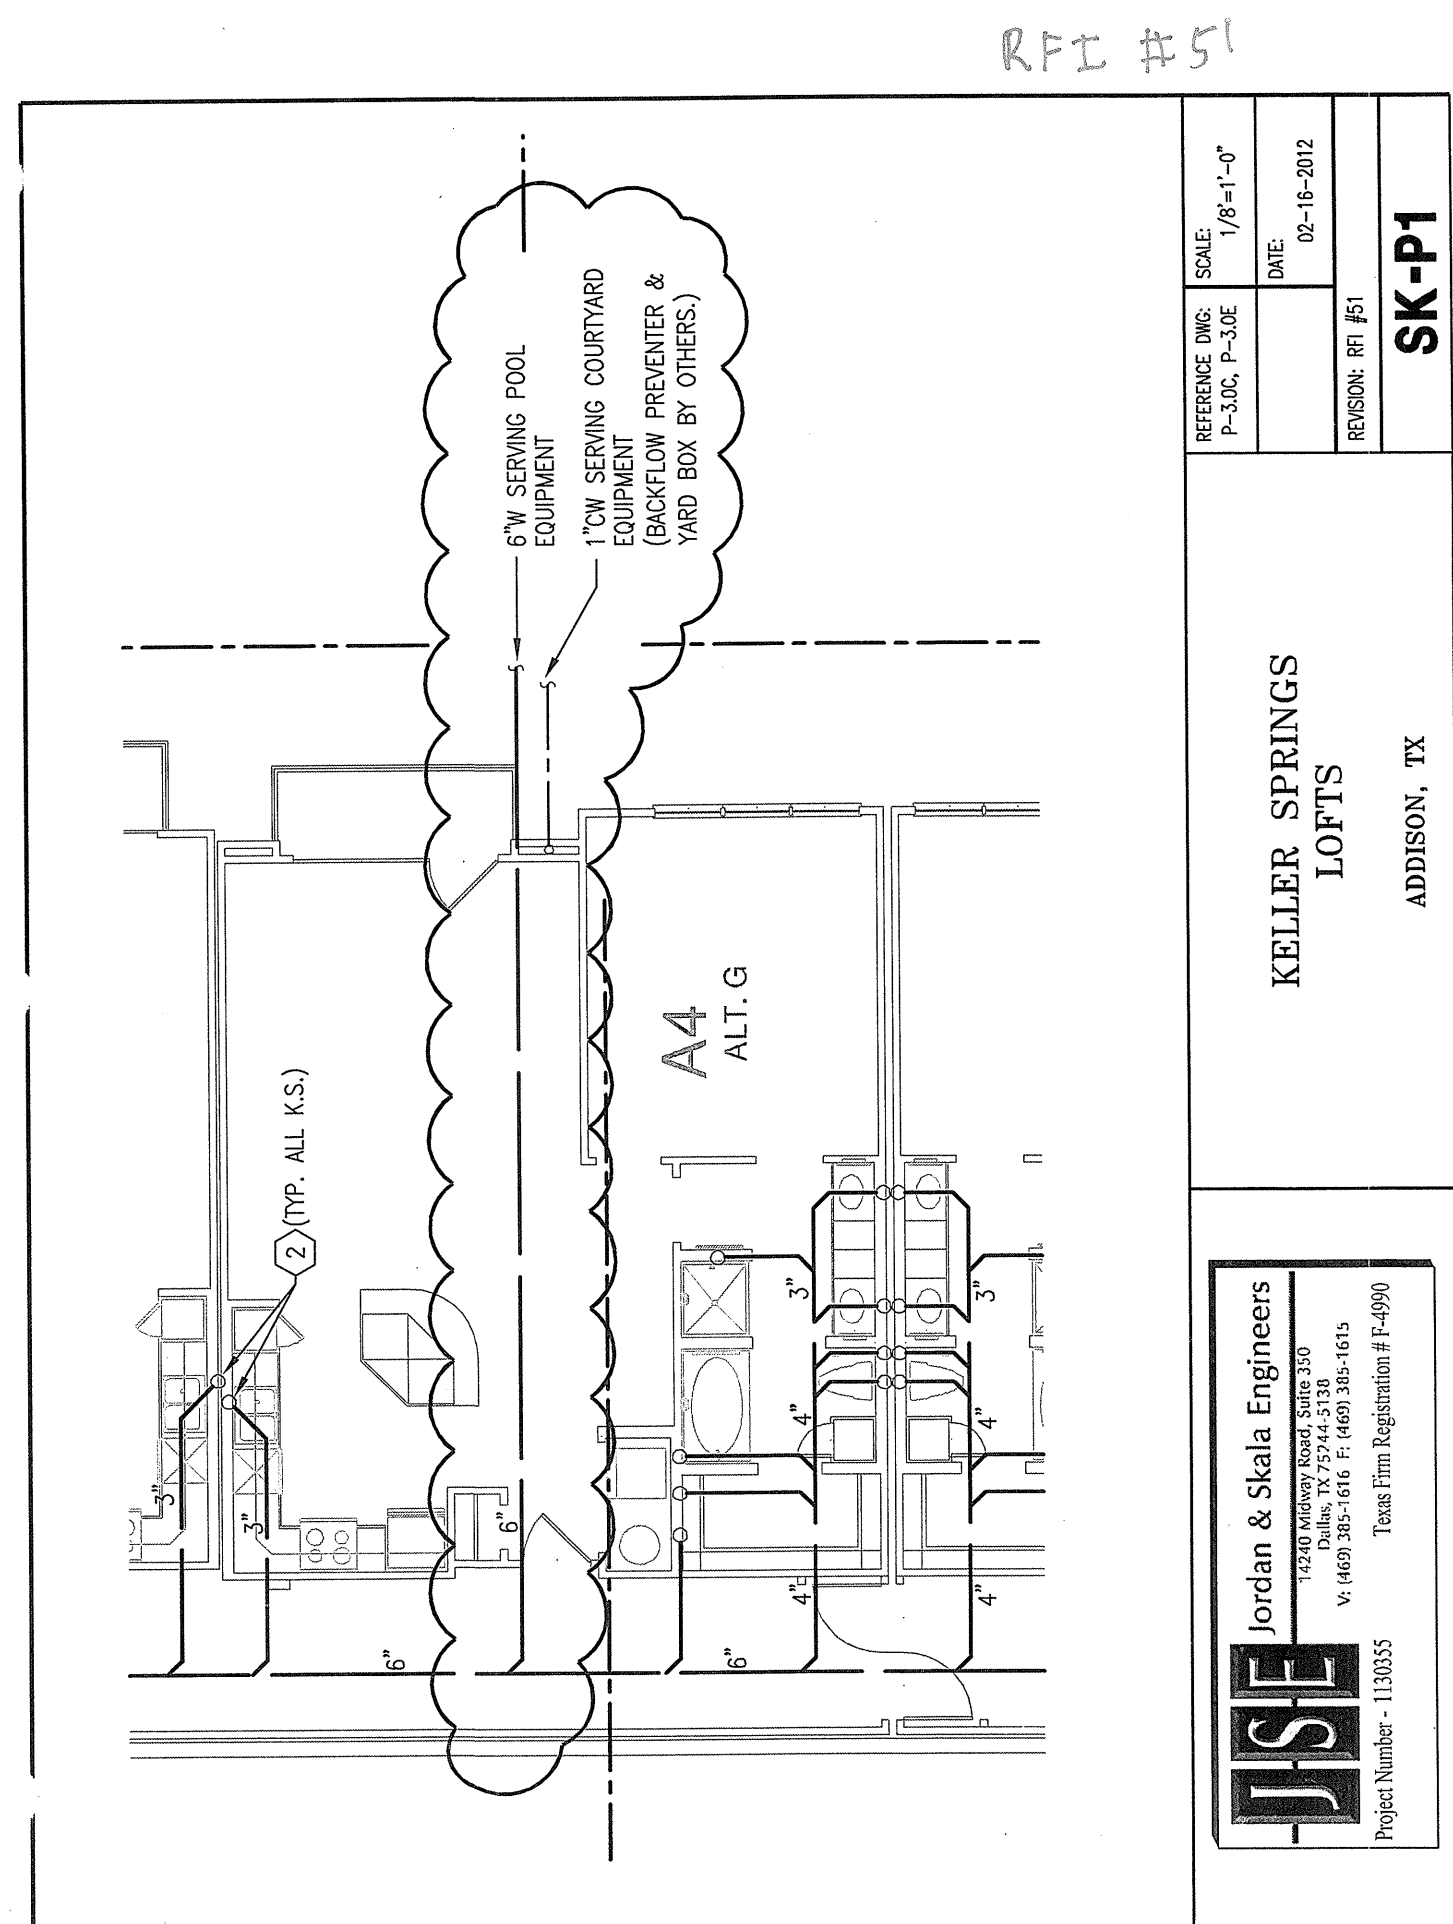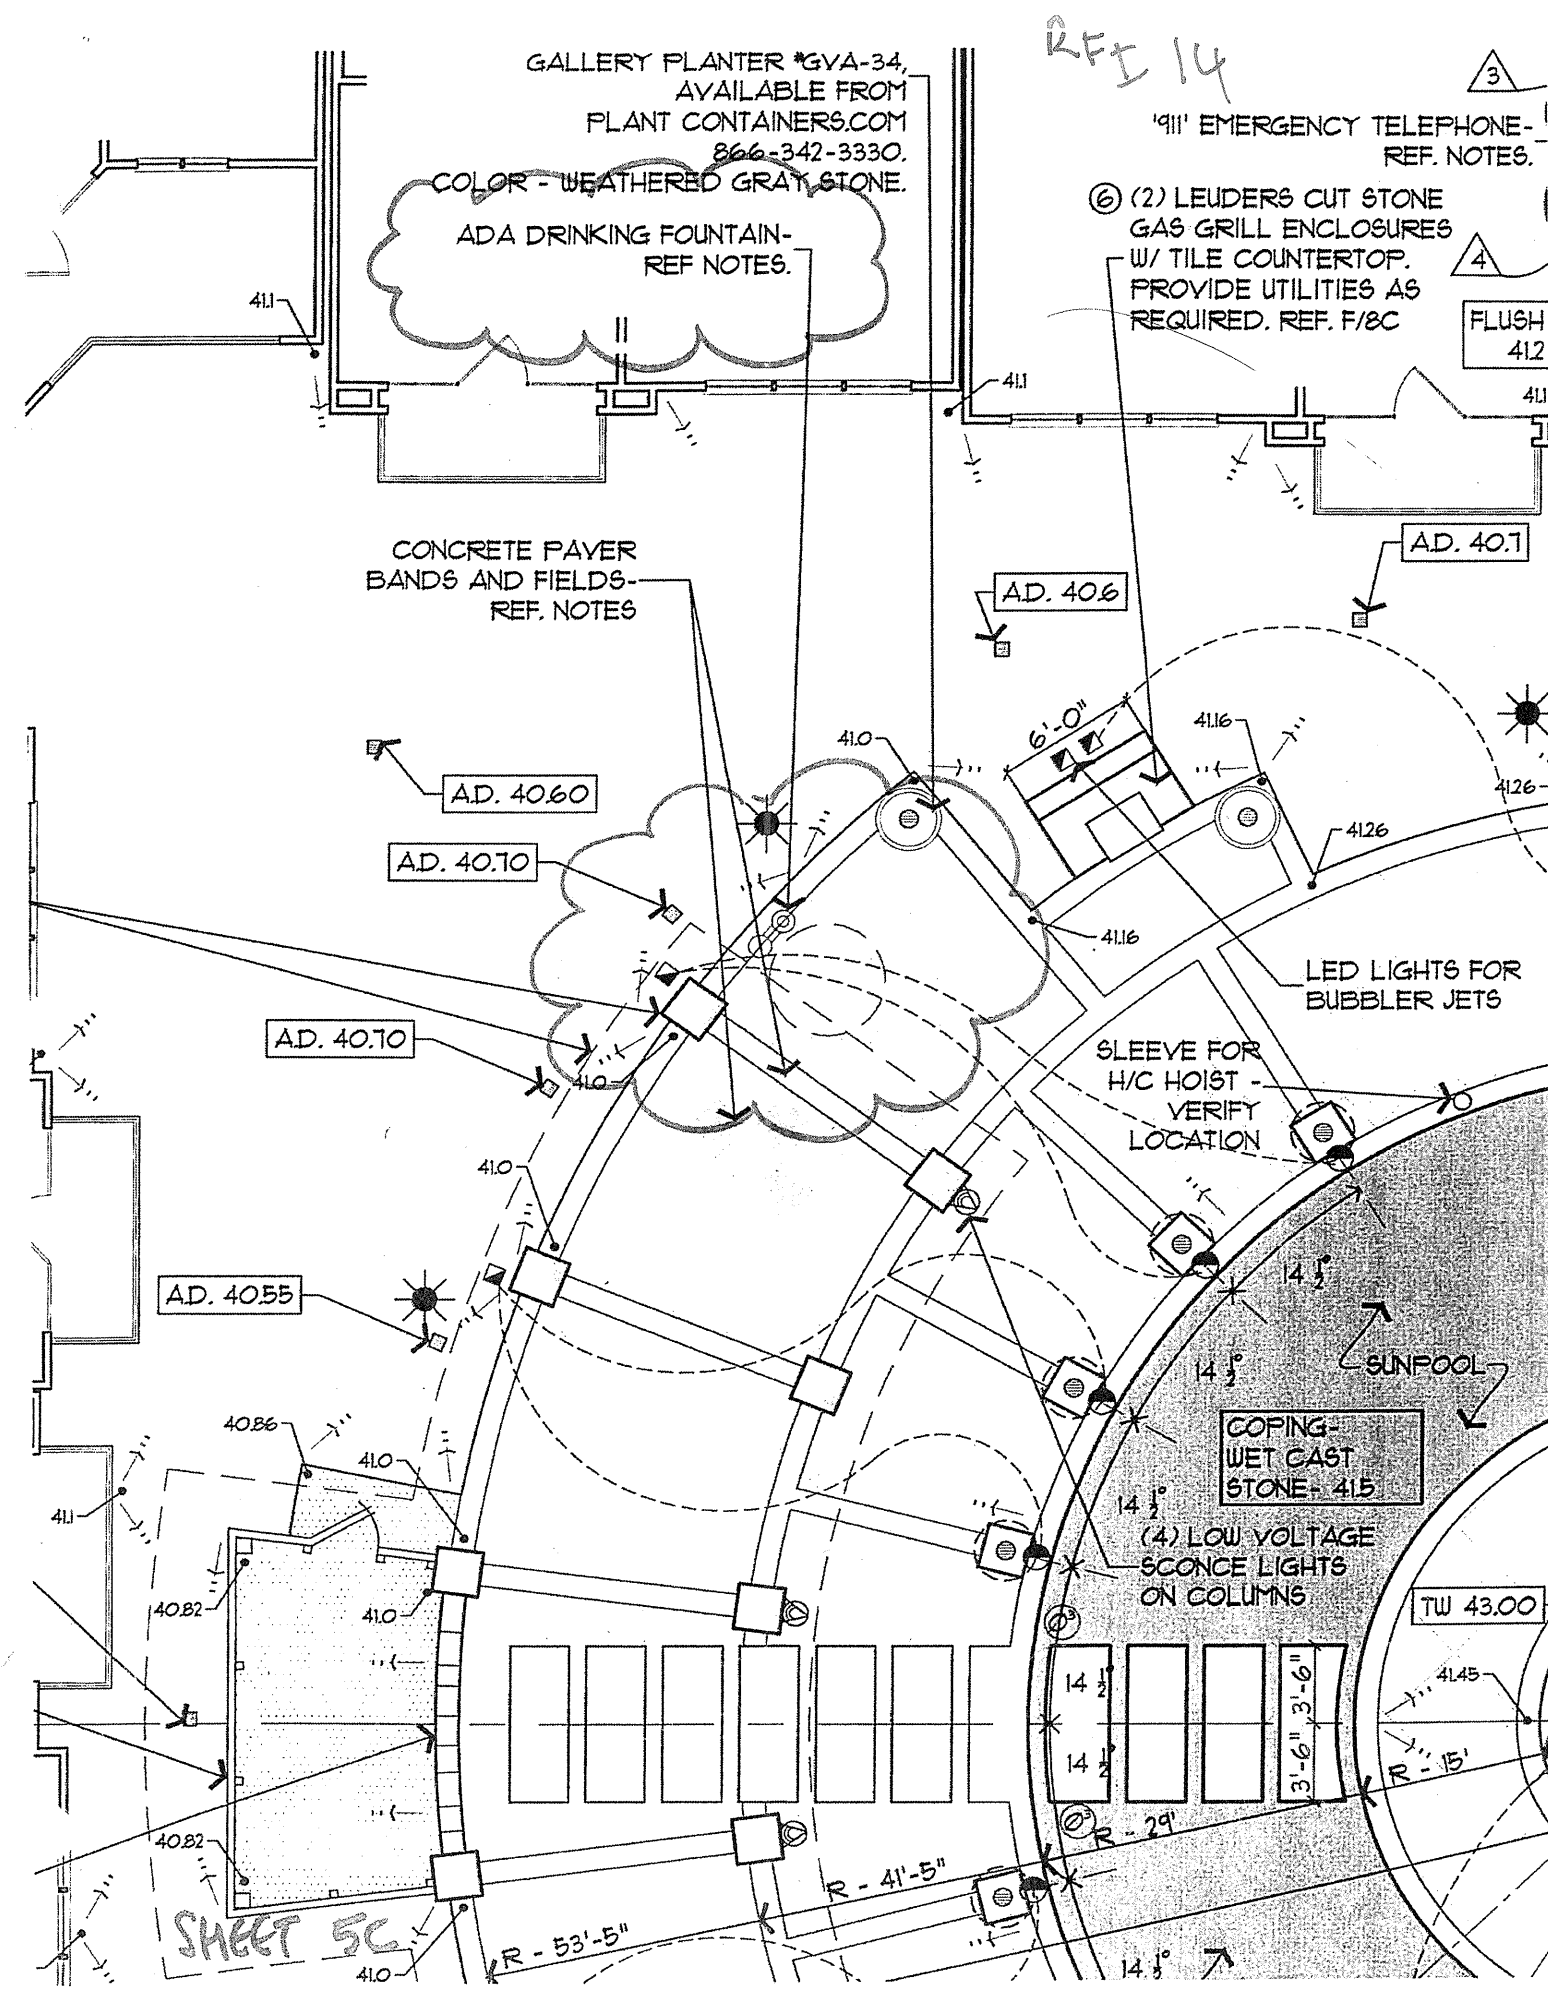

JSE
 Jordan & Skala Engineers
 14240 Midway Road, Suite 350
 Dallas, TX 75244
 Ph: 469-385-1610 Fax: 469-385-1615
 Texas Firm Registration # F-4990
 Project Number - 113035

REFERENCE DWG: SCALE: 1/8"=1'-0"
 P-3006, P-3008
 DATE: 02-16-2012
 REVISION: RFI #51
SK-P1

KELLER SPRINGS LOFTS
 ADDISON, TX