PART 1 - GENERAL 1.01 SCOPE

A. PROVIDE COMPLETE INSTALLATION AS DETAILED.

1.02 QUALITY ASSURANCE

A. POOL CONTRACTOR SHALL VERIFY THAT THIS DESIGN COMPLIES WITH ALL APPLICABLE BUILDING, PLUMBING AND ELECTRICAL CODES BEFORE CONSTRUCTION. ANY DISCREPANCY BETWEEN THE POOL DESIGN AND/OR SPECIFICATIONS AND THE GOVERNING CODES SHALL BE REPORTED IMMEDIATELY UPON DISCOVERY, IN WRITING, TO THE OWNER AND THE LANDSCAPE ARCHITECT. THE CONTRACTOR ASSUMES ALL RESPONSIBILITY FOR ANY DEFICIENCIES NOT REPORTED TO THE LANDSCAPE ARCHITECT

1.03 PERMITS

POOL CONTRACTOR IS RESPONSIBLE FOR OBTAINING AND MEETING ALL APPLICABLE PERMITS FOR CONSTRUCTION OF, BUT NOT LIMITED TO, THE FOLLOWING: ALL POOL EQUIPMENT, PIPING, POOL SHELL TILE, DEPTH MARKERS, POOL HANDRAILS, POOL STEPS, COPING, ELECTRICAL WORK AND ANY OTHER POOL RELATED ITEMS.

POOL EQUIPMENT, PIPING AND STEEL REINFORCING SCHEDULE IS TO BE SUBMITTED WITH THE POOL BID. THE STEEL REINFORCING SCHEDULE IS TO BE APPROVED AND SEALED BY AN ENGINEER AND STATE THAT IT WILL MEET THE PARTICULAR SITE CONDITIONS. STRUCTURAL, MECHANICAL AND ELECTRICAL ASPECTS OF THE POOL DESIGN SHALL BE DESIGNED BY PROFESSIONAL ENGINEERS CERTIFIED TO PERFORM SUCH WORK.

B. UPON COMPLETION, PROVIDE COMPLETE OPERATIONS MANUAL AND EQUIPMENT BROCHURES, NEATLY

POOL CONTRACTOR TO SUBMIT A LIST OF MATERIALS WITH PROPOSAL. FINAL SELECTION OF MATERIALS SHALL BE SUBMITTED TO AND APPROVED BY THE OWNER BEFORE CONSTRUCTION. MATERIALS TO BE SUBMITTED FOR APPROVAL INCLUDE DECK FINISHES, DECK DRAINS, EXPANSION JOINT MATERIAL, POOL WALL FINISH AND COLOR, POOL COPING, POOL TILE, DEPTH MARKERS, HANDRAILS, INLETS, AND LIGHTS CHANGE ORDERS SHALL BE ISSUED FOR ANY SELECTIONS BY THE OWNER THAT DIFFER FROM ITEMS BID, OR REPRESENT AN INCREASE IN COST.

1.05 SITE CONDITIONS

THE POOL CONTRACTOR SHALL VERIFY SITE CONDITIONS PRIOR TO CONSTRUCTION AND BRING ANY DISCREPANCIES BETWEEN SITE AND PLAN TO THE ATTENTION OF THE OWNER AND LANDSCAPE ARCHITECT IMMEDIATELY UPON DISCOVERY.

THE GENERAL CONTRACTOR IS RESPONSIBLE FOR ROUGH GRADING THE POOL AREA TO WITHIN SIX INCHES OF THE FINISHED GRADE BEFORE POOL EXCAVATION.

UTILITIES TO THE PUMP ROOM LOCATION WILL BE PROVIDED BY THE GENERAL CONTRACTOR. 1.06 WARRANT

PROVIDE A MINIMUM FIVE-YEAR WRITTEN GUARANTEE FOR THE POOL SHELL AGAINST FAILURE TO PERFORM. GUARANTEE POOL EQUIPMENT FOR A MINIMUM OF ONE YEAR AFTER FINAL ACCEPTANCE

PARTA2 - PRODUCTS

2.01 SAND FILTER A. MEETS NATIONAL SANITATION FOUNDATION STANDARDS.

CONTRACTOR TO VERIFY CONCRETE SPECIFICATIONS WITH A STRUCTURAL ENGINEER FOR SPECIFIC SITE CONDITIONS.

2.03 HAIR AND LINT CATCHER

A. INSTALL ON THE SUCTION SIDE OF THE PUMP. AREA OF CATCHER TO BE A MINIMUM OF FOUR TIMES THE CROSS SECTIONAL AREA OF INLET PIPE.

2.04 MAIN DRAIN OUTLET

BY SWIMQUIP OR APPROVED EQUAL WITH HYDROSTATIC RELIEF VALVE AND PERFORATED

ALL MAIN DRAIN SUCTION PIPES MUST COME PROM AT LEAST TWO (2) SOURCES. REFERENCE LOCAL, STATE AND NATIONAL CODES.

A. SCHEDULE 40, WITH SCHEDULE 40 FITTINGS.

2.06 PLASTER

2.07 PUMP

SUBMIT COLOR SAMPLES OR EXISTING POOL EXAMPLES FOR APPROVAL.

MUST BE OF ADEQUATE SIZE TO TURN OVER POOL WASTE CAPACITY WITHIN FIVE HOURS OR PER LOCAL OR STATE CODES. B. VERIFY MINIMUM POOL CODE REQUIREMENTS.

BY SWIMQUIP, U-3 OR APPROVED EQUAL AUTOMATIC SURFACE SKIMMER. ONE PER 500 SQUARE FEET MINIMUM. VERIFY MINIMUM POOL CODE REQUIREMENTS.

2.09 UNDERWATER LIGHTING

A. AS SHOWN ON MATERIALS LIST, OR PLAN AND DETAILS. 2.10 DECK MATERIAL

A. DECK SURFACE SHALL BE TEXTURED FOR POSITIVE FOOT TRACTION

2.11 DEPTH MARKERS

DEPTH MARKERS AND "NO DIVING" NOTATIONS SHALL BE MADE IN ACCORDANCE WITH GOVERNING CODES. AT A MINIMUM, DEPTH MARKERS SHALL BE INSTALLED FLUSH WITH THE POOL DECK AND ON POOL TILES IN LOCATIONS AROUND THE POOL MARKING THE DEPTH AT EVERY SIX (6) INCHES OF CHANGE

2.12 AUTOMATIC WATER LEVELER

A. SPAS AND FOUNTAINS INDEPENDENT OF THE MAIN POOL SHALL HAVE AN AUTOMATIC WATER LEVELER INSTALLED IN ACCORDANCE WITH MANUFACTURER'S DIRECTIONS AND PER APPLICABLE POOL CODES. LEVELER TO BE NOYES 'POOL MISER' OR EQUIVALENT.

PART 3 - EXECUTION

3.01 STAKING

A. STAKE OUT POOL AND FINISHED GRADES. NOTIFY LANDSCAPE ARCHITECT AND RECEIVE APPROVAL PRIOR TO EXCAVATION. VERIFY EXISTING CONDITIONS, NOTIFY THE LANDSCAPE ARCHITECT OF ANY

3.02 TREE PROTECTION

PROTECT EXISTING TREES. DO NOT CUT OR FILL BENEATH TREES UNLESS SPECIFICALLY SHOWN ON THE PLANS. DO NOT TRENCH WITHIN DRIP LINE OF TREES.

3.03 EXCAYATION

A. SOIL IS UNCLASSIFIED. 3.04 STEEL

CONTRACTOR TO SUBMIT SCHEDULE, APPROVED AND SEALED BY STRUCTURAL ENGINEER, WITH

3.05 GUNITE

A. TO BE DONE IN CONTINUOUS OPERATION OR AS APPROVED BY STRUCTURAL ENGINEER.

B. POOL TO BE GROUNDED PER CODE. C. POOL WALLS, FLOOR AND BEAMS TO BE GUNITE

3.06 PIPING

A. ALL PIPING SHALL BE ROUTED AROUND TREES THAT ARE TO BE PLANTED ADJACENT TO THE POOL 3.07 JUNCTION BOXES

INSTALL AS SHOWN ON PLANS. 3.08 LINES

A. PROVIDE POOL FILL LINES AND POOL OVERFLOW LINES.

3.09 PLASTER

TROWEL TO SMOOTH, DENSE IMPERVIOUS SURFACE PREE FROM BLEMISHES. MINIMUM THICKNESS OF 3.10 ADJUSTING

SUPPLY ALL REQUIRED START UP CHEMICALS AND BALANCE POOL. MEET WITH OWNER'S

REPRESENTATIVE TO DISCUSS POOL OPERATION. CLEANING

A. KEEP PREMISES NEAT AND ORDERLY. REMOVE DEBRIS FROM SITE AND LEAVE AREAS IN A BROOM CLEAN CONDITION

CONTRACTOR TO CONFIRM THAT THE ABOVE SPECIFICATIONS AND ALL POOL CONSTRUCTION WORK, MEETS OR EXCEEDS ALL GOVERNMENT CODES AND REGULATIONS.

## POOL NOTES

POOL CONTRACTOR IS RESPONSIBLE FOR THE QUALITY OF WORKMANSHIP, SUPERINTENDENCE AND SCHEDULING OF WORK UNDER HIS AND THE SUBCONTRACTOR'S AGREEMENT. CONTRACTOR WILL BE SOLELY RESPONSIBLE FOR THIS WORK AND SHALL PROMPTLY CORRECT (AT CONTRACTOR'S EXPENSE) ANY DEFECTIVE WORK DURING THE CONSTRUCTION OF THE PROJECT OR THE WARRANTY PERIOD THEREAFTER.

THE POOL CONTRACTOR SHALL PROVIDE CONSTRUCTION METHODS AND COMPATIBLE COMPONENTS REQUIRED FOR COMPLETE AND OPERABLE SYSTEMS FOR SWIMMING POOL, FOUNTAIN AND/OR SPA INCLUDING, BUT NOT LIMITED

TO, EXCAVATION, DEWATERING OF CONSTRUCTION AREA, AND REMOVAL OF EXCESS EARTH FROM SITE. THE OWNER OR OWNER'S MANAGEMENT SHALL BE RESPONSIBLE FOR INSTALLATION AND MAINTENANCE OF POOL WARNING SIGNS AND SAFETY EQUIPMENT IN THE POOL AREA TO COMPLY WITH STATE AND LOCAL CODES, AND

STATE AND LOCAL CODE GUIDELINES. THE GENERAL CONTRACTOR IS RESPONSIBLE FOR ROUGH GRADING IN THE POOL AREA. THE GRADE PROVIDED SHALL BE WITHIN SIX INCHES OF FINISHED GRADE BEFORE POOL EXCAVATION BEGINS.

THE POOL CONTRACTOR WILL STAKE OUT THE POOL AND SET THE FINISHED GRADE. THE LANDSCAPE ARCHITECT OR OWNER WILL BE NOTIFIED AND APPROVE THIS WORK PRIOR TO EXCAYATION.

POOL LIGHTS AND JUNCTION BOXES TO BE INSTALLED PER STATE AND LOCAL CODE BY POOL CONTRACTOR. POOL DECK LIGHTING SHALL FULLY ILLUMINATE THE POOL DECK AND BE IN ACCORDANCE WITH THE GOVERNING STANDARDS. UNDERWATER LIGHTING SHALL BE IN ACCORDANCE WITH GOVERNING CODES. ALL POST LIGHTS AND LANDSCAPE LIGHTING SHALL BE A MINIMUM OF 10'-O" FROM POOL WATER'S EDGE OR AS REQUIRED BY LOCAL CODES AND

REQUIRED UTILITIES AT THE POOL FILTER/EQUIPMENT LOCATION TO BE SUPPLIED BY THE GENERAL CONTRACTOR. AREA DRAIN SIZE AND PVC DRAIN LINE SIZE AND GRADE TO BE DETERMINED BY CIVIL ENGINEER AND SHALL

MEET MINIMUM REQUIREMENTS: • DECK DRAINS - ALL DRAINS TO BE CAPPED WITH A MINIMUM 6" ROUND GRATE

 PLANTER DRAINS - ALL DRAINS TO BE CAPPED WITH A MINIMUM 6" ATRIUM GRATE. ALL POOL ENCLOSURE GATES AND FENCES TO COMPLY WITH STATE AND LOCAL CODES, INCLUDING TEXAS STATE

10. ALL PIPING SHALL BE 24" DEEP MINIMUM IN ALL PLANTING AREAS, AND ROUTED AROUND PROPOSED OR

POOL CONTRACTOR IS RESPONSIBLE FOR TEMPORARY FENCING DURING CONSTRUCTION.

FINISH GRADES NEXT TO WALKS AND POOL DECKS SHALL BE THE RESPONSIBILITY OF THE POOL CONTRACTOR. SWIMMING POOL HANDICAP LIFTER AND RELATED ITEMS TO BE PROVIDED BY POOL CONTRACTOR. RECREONICS, INC. STAINLESS MODEL NUMBER 46-620 OR EQUAL (800) 428-3254. INSTALL ANCHOR PER MANUFACTURER'S

SPECIFICATIONS. PORTABLE LIFT TO BE KEPT BY MANAGEMENT UNTIL REQUESTED FOR USE BY TENANT. HANDICAP ACCESSIBLE GATE WITH KEY, CARD OR COMBINATION LOCK ACCESS ONLY SHALL BE INSTALLED AT


LOCATION SHOWN BY "\*" ON PLAN. REFERENCE DETAILS. 15. LIGHT LOCATIONS AS INDICATED ON PLANS ARE RECOMMENDED LOCATIONS ONLY. FINAL FIXTURE QUANTITY AND LOCATIONS MAY VARY DUE TO OWNER'S SELECTION OF LAMP TYPE, LAMP WATTAGE, FOOT CANDLE INTENSITY AND HEIGHT OF FIXTURE. OWNER OR OWNER'S LIGHTING CONSULTANT TO DETERMINE REQUIRED ILLUMINATION.


16. '911 EMERGENCY TELEPHONE' TO BE READILY ACCESSIBLE TO SWIMMING POOL FOR EMERGENCY USE.

ALL STRUCTURAL DETAILS BY OTHERS.

SHOWER REQUIREMENTS FOR POOL FACILITIES TO BE CONFIRMED BY THE LOCAL HEALTH DEPARTMENT OR OTHER AUTHORIZED AGENCY.

19. POOL TO BE SALT WATER.

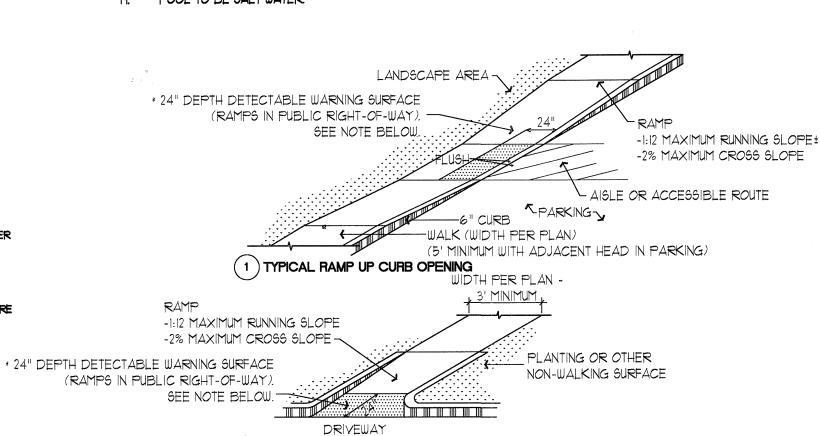

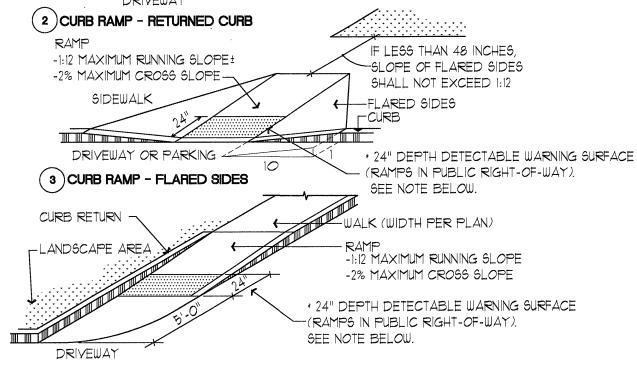

(4) TYPICAL RAMP UP CURB OPENING

TAS (TEXAS ACCESSIBILITY STANDARDS) 4.7.4(2) THE FULL WIDTH AND DEPTH OF CURB RAMPS SHALL HAVE A LIGHT REFLECTIVE YALUE AND SURFACE TEXTURE THAT SIGNIFICANTLY CONTRASTS WITH THAT OF ADJOINING PEDESTRIAN ROUTES. THE INTENT OF THIS STANDARD IS MET BY


TRUNCATED DOMES MEETING THE TECHNICAL SPECIFICATIONS OF TAS 4292 OTHER TEXTURES SUCH AS GROOVES 1/4" DEEP, 3/4" WIDE, AND 2" APART AND ARRANGED SO THAT WATER WILL NOT ACCUMULATE, MAY BE ACCEPTABLE, PROVIDED THE SURFACES ARE DETECTABLE UNDERFOOT. OTHER DESIGNS FOR SURFACES THAT ARE DETECTABLE UNDERFOOT MAY BE SUBMITTED TO THE STATE FOR APPROVAL. WE RECOMMEND USING TRUNCATED DOMES ON ALL CURB RAMPS.

\* CURB RAMPS LOCATED IN THE PUBLIC RIGHT-OF-WAY MAY HAVE A 24" MINIMUM DEPTH DETECTABLE WARNING SURFACE (MUST EXTEND THE FULL WIDTH OF THE CURB RAMP OR LANDING). CURB RAMPS NOT LOCATED WITHIN THE PUBLIC RIGHT-OF-WAY SHALL HAVE A DETECTABLE WARNING SURFACE THAT EXTENDS THE FULL WIDTH AND DEPTH OF THE CURB RAMP OR LANDING. TRUNCATED DOME DETECTABLE WARNING SURFACE SHALL BE USED IN PUBLIC RIGHT-OF-WAY AND WHEN CROSSING PUBLIC STREETS.

REFERENCE ARCHITECTURAL DRAWING PACKAGE FOR FURTHER ACCESSIBILITY GUIDELINES AND TAS REQUIREMENTS.

BARRIER FREE CURB RAMPS

SCALE - NONE

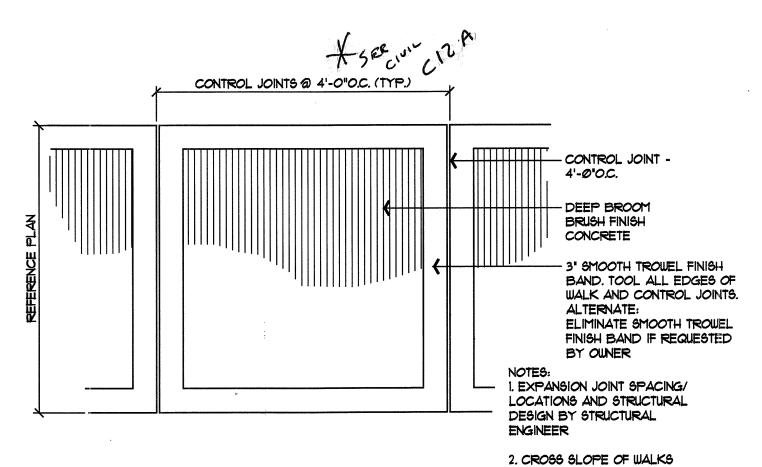

SIDEWALK

POINTS)

(MAX. 6")

PITCH TREAD &" FOR DRAINAGE -

QUARTZSCAPES FINISH ---

POOL SEAT

RESERVED

PARKING

VAN ACCESSIBLE

BORDER AND LETTERS

SHALL BE BLUE COLOR

ON WHITE BACKGROUND

SYMBOL SHALL BE WHITE

COLOR ON BLUE BACK-

YERIFY SIGN YERBIAGE AND

COLOR WITH LOCAL COUNTY

OR GOVERNING BODY

ADDITIONAL SIGNAGE

"YAN ACCESSIBLE" AT

YAN ACCESSIBLE SPACE

ONLY. (8' MINIMUM AIGLE)

TOP OF PAYEMENT/FINISH GRADE

NOTE: PROVIDE

1 J" DIAMETER

HANDICAP PARKING SIGN

GALVANIZED STEEL

STAIR AND HANDRAIL

EDGES

DEEP BROOM

BRUSH FINISH -

TYPICAL

1 2" SQUARE STEEL RAILS

AND POSTS, MAXIMUM POST

SPACING 6'-O" O.C. (EQUAL -

SPACING BETWEEN FIXED

1'-0"

2"x2" TILE BAND ---

WATER LEVEL -

6" RADIUS ---

SLOPE TO DRAIN

BRUSH FINISH CONCRETE - TYPICAL PLAN VIEW

3/4" = 1'-0"

SHALL NOT EXCEED 2%

4"x4" STEEL ANCHOR

PLATE-SECURE TO

CONCRETE WALK

CONCRETE WALK

4 4 44

REINFORCED

I. PAINT HANDRA!L WITH ONE COAT

ZINC CHROMATE AND TWO COATS

HIGH GLOSS INDUSTRIAL ENAMEL

PAINT. COLOR TO BE SELECTED

2. HANDRAIL CONSTRUCTION AND

DESIGN TO MEET ALL STATE AND

3. STRUCTURAL REINFORCING AND

3/4" = 1'-0"

EXPANSION JOINT MATERIAL AS

LOCAL APPLICABLE CODES.

SPECIFIED BY ENGINEER

· COPING - REF. PLAN

REF. PLAN FOR MATERIALS

2" x 2" FROSTPROOF BLACK

· ALL POOL STRUCTURAL BY

DIMENSION FROM POOL SEAT

TO POOL BOTTOM WILL YARY

3/4" = 1'-0"

WITH LOCATION OF SEAT

GROUND POOL AS PER

TILE, CHARCOAL GROUT

--- 1 1/2" DIAMETER

REINFORCED

GUNITE SHELL

POOL ENGINEER

LOCAL CODE


GRAVEL


REF. POOL DECK DETAIL

FOR MATERIALS


- POOL DECK -

COPING - REF. PLAN FOR MATERIALS 2" X 2" FROSTPROOF BLACK TILE, CHARCOAL GROUT - POOL DECK -REF. PLAN FOR MATERIALS REF. POOL DECK DETAIL WATER LEVEL-QUARTZSCAPES FINISH -2" x 2" TILE BAND -1'-44' < MATCH WATERLINE TILE . TYP. JOP STEP ONLY 1 1/2" DIAMETER REINFORCED GUNITE SHELL SLOPE TO DRAIN -· ALL POOL STRUCTURAL BY POOL ENGINEER GROUND POOL AS PER LOCAL CODE REFERENCE PLAN FOR NUMBER OF STEPS. POOL STEPS 3/4" = 1'-0"

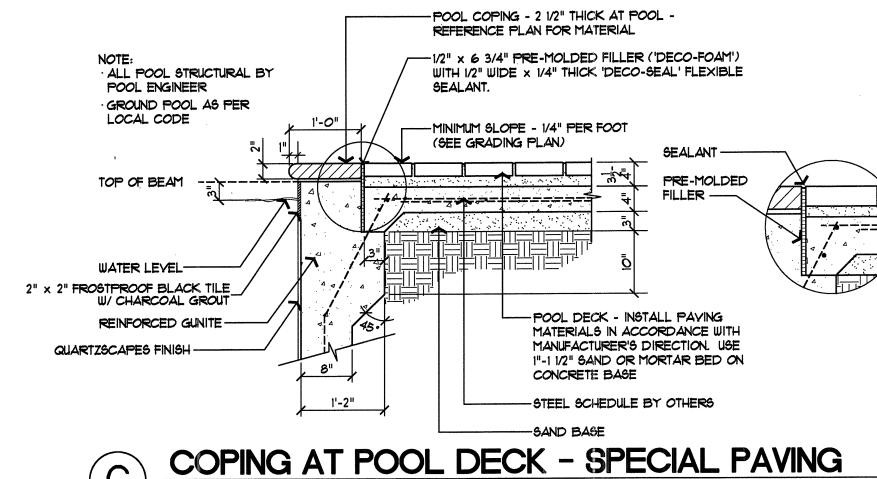

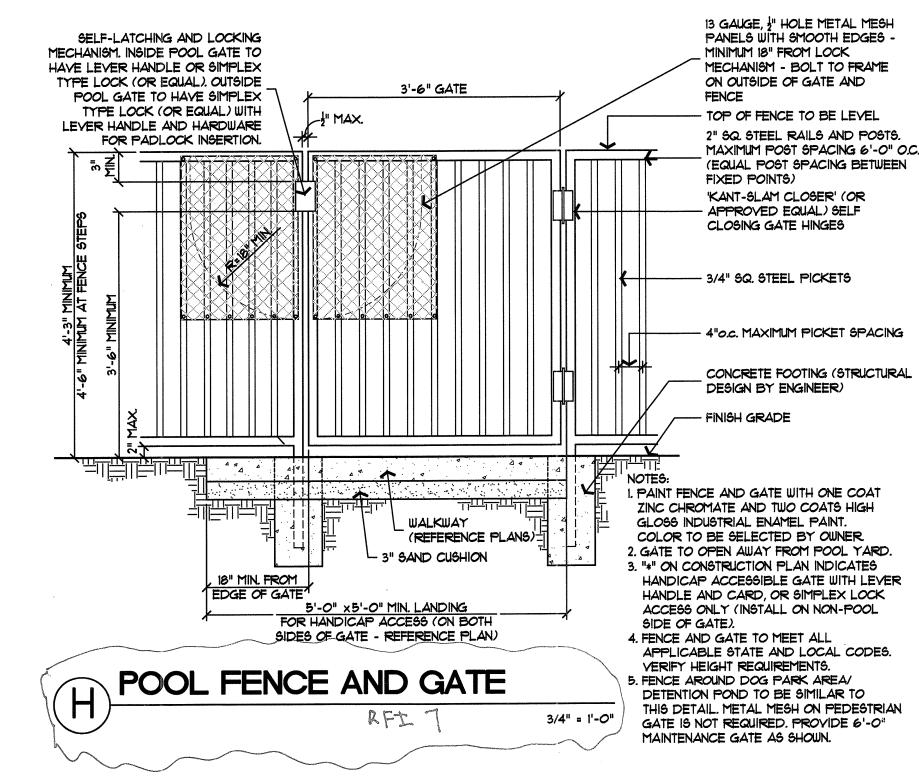



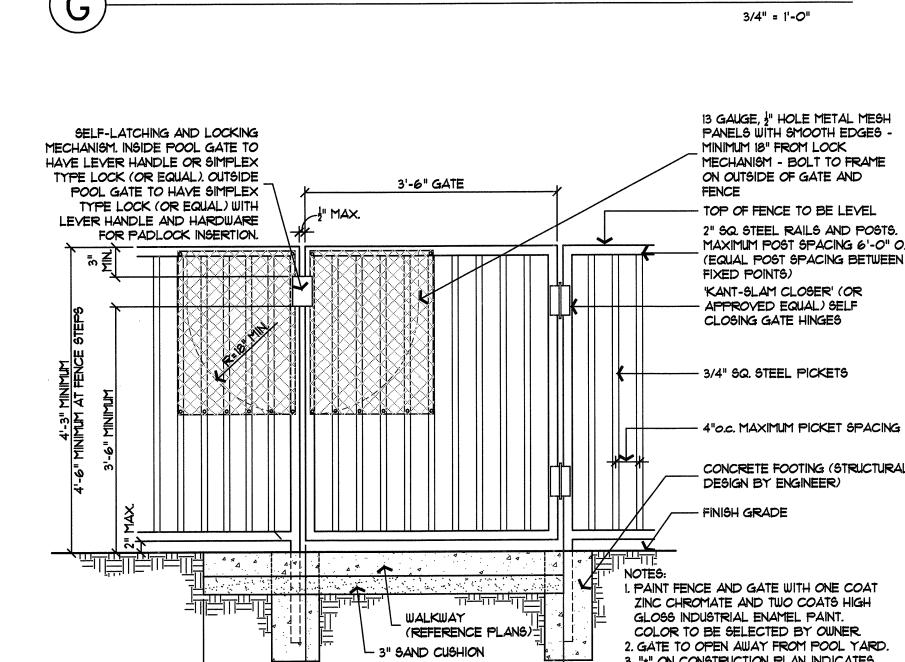

**SCALE** AS NOTED

DATE

REVISIONS

0

4

\_\_\_

D. /P

ZF.

19 AUG 2011

CONSTRUCTION DETAILS

TITLE

SHEET

6C OF 9