

RFI

To: Enviro Design Landscape
 7424 Greenville Ave, Suite 200
 Dallas, TX 75231
 Ph: 214/987-3010 Fax: 214/987-3015

RFI #: 15
 Date: 12/14/2011
 Job: EB-02 Keller Springs Lots
 Phone: 877-777-5115

CC: David Gallagher (Embrey Build (Embrey Construction LLC))


Subject: BBQ handle height and countertop

Drawing: Spec Section:
 Cost Impact: None Schedule Impact: None

Request: Date Required: 12/21/2011
 Please confirm height of the handle of the BBQ grill is it compliant with ADA?
 Also the countertop is called out at 36" should it be 34 1/2" to be compliant with ADA?
 Requested by: Bryan Pickler
 Embrey Partners, Ltd.

Response:
 WE DO NOT KNOW HOW ANY GRILL LID WOULD BE COMPLIANT WITH ADA. BBQ
 REGULATIONS WAS GOING TO ASK THE QUESTION TO THE H.J.D REVIEWER. WE HAVE NOT
 RECEIVED A RESPONSE FROM THE REVIEWER AT THIS TIME.
 THE GRILL ENCLOSURE COUNTERTOP SHOULD BE MAXIMUM 34" HEIGHT TO BE
 COMPLIANT WITH ADA. OUR FURNISH INCLUDED ALL OUT-OF-DATE DETAILS THAT
 HAS SINCE BEEN REVISED. THE UPDATED DETAIL IS ATTACHED.
 Answered by: DAVE ARTHUR
 Company: ENVIRO DESIGN Date: 12-16-2011

RFI 15

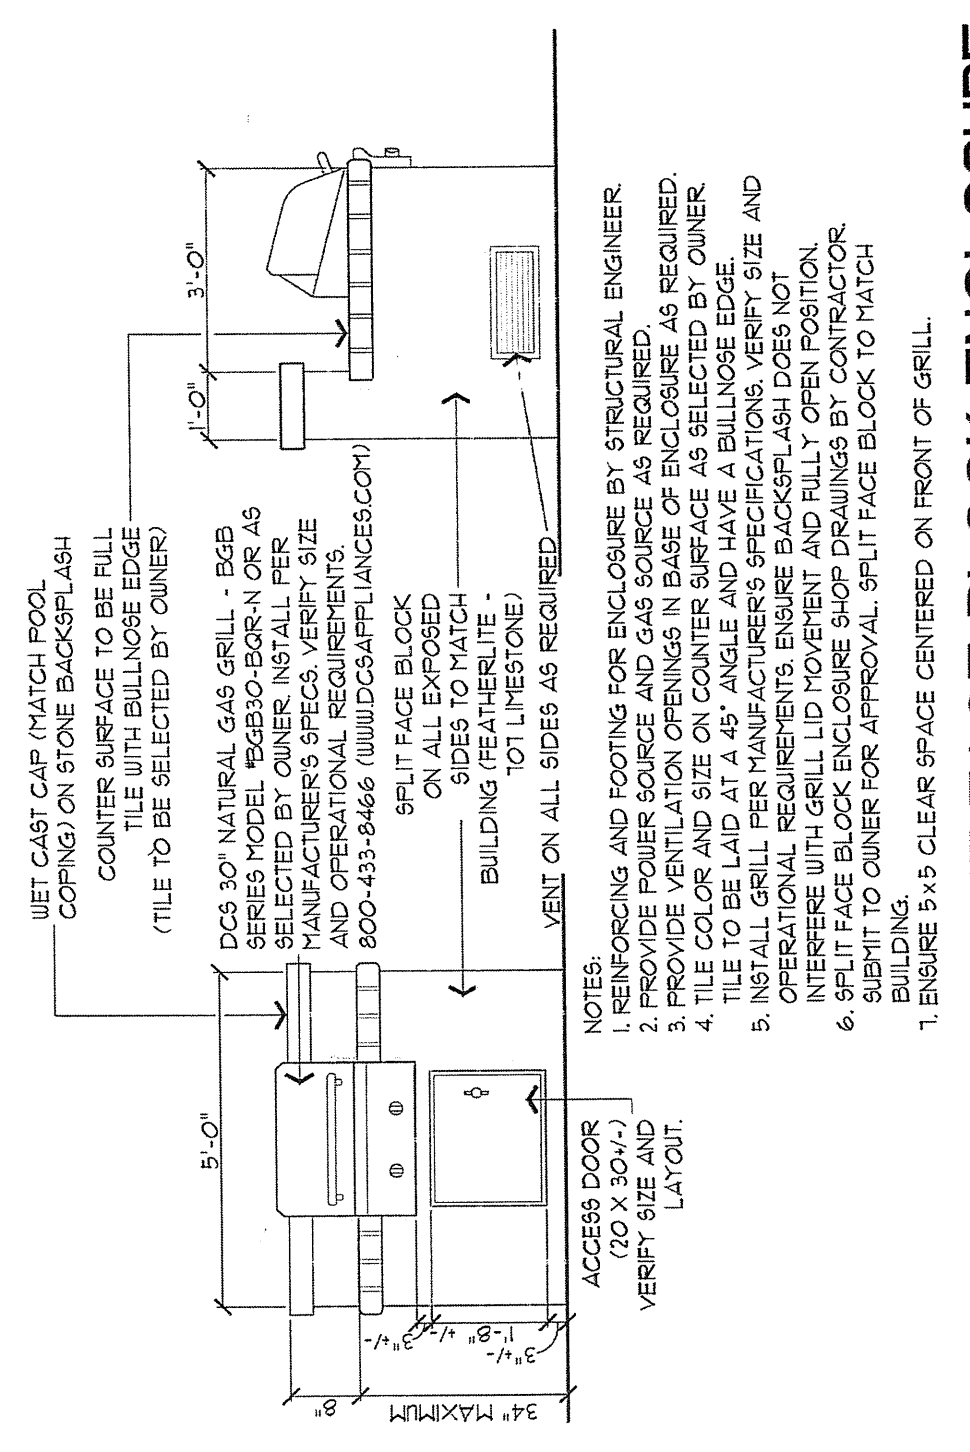

F GAS GRILL IN SPLIT FACE BLOCK ENCLOSURE
 3/8" = 1'-0"

- NOTES:
1. REINFORCING AND FOOTINGS FOR ENCLOSURE BY STRUCTURAL ENGINEER.
 2. REINFORCING AND FOOTINGS AND GAS SOURCE AS REQUIRED.
 3. PROVIDE VENTILATION OPENINGS IN BASE OF ENCLOSURE AS REQUIRED.
 4. TILE COLOR AND SIZE ON COUNTERTOP SURFACE AS SELECTED BY OWNER.
 5. TILE TO BE LAID AT 45° ANGLE AND HAVE A TYPICAL 1/4" BEVEL ON ALL OPERATIONAL REQUIREMENTS. ENSURE BACKSPLASH DOES NOT INTERFERE WITH GRILL LID MOVEMENT AND FULLY OPEN POSITION.
 6. SPLIT FACE BLOCK ENCLOSURE SHOP DRAWINGS BY CONTRACTOR. SUBMIT TO OWNER FOR APPROVAL. SPLIT FACE BLOCK TO MATCH BUILDING FEAATHERLITE. SIDES TO MATCH SPLIT FACE BLOCK (101 LIMESTONE).
- VENT ON ALL SIDES AS REQUIRED.

ACCESS DOOR (20 X 20 X 10) VERIFY LAYOUT.