

REVISIONS







Keller Springs Lofts
EMBREY PARTNERS, LTD
ADDISON, TEXAS

SCALE
AS NOTED

DATE
19 AUG 2011

TITLE
CONSTRUCTION
DETAILS

SHEET
7C OF 9

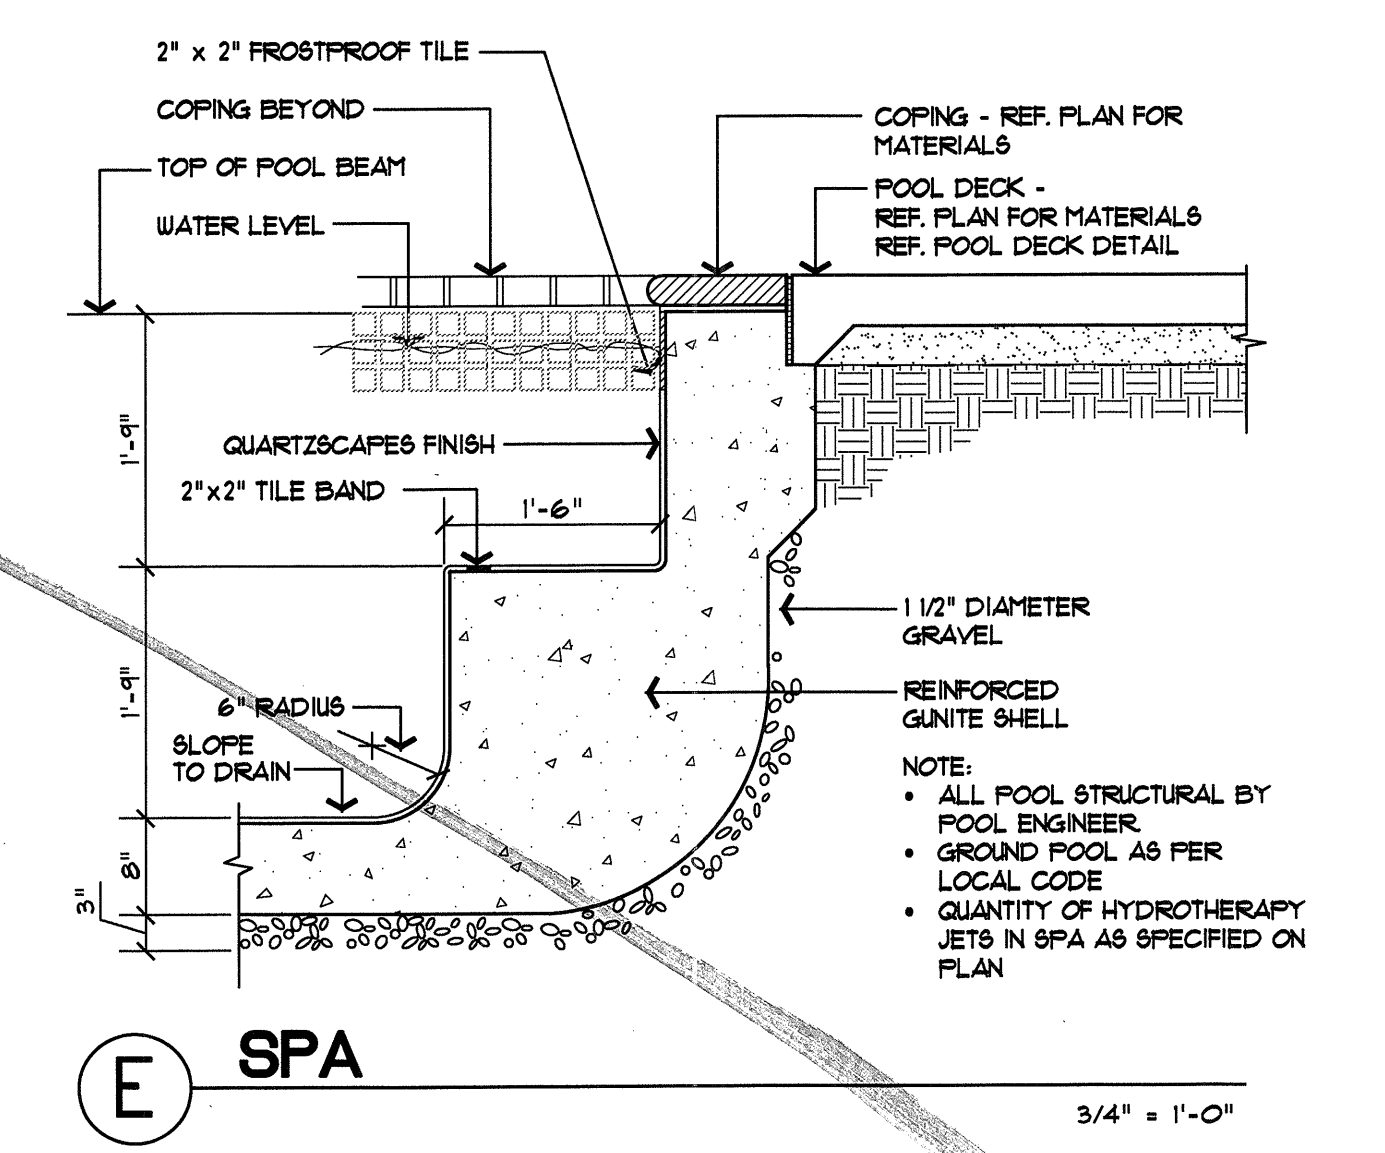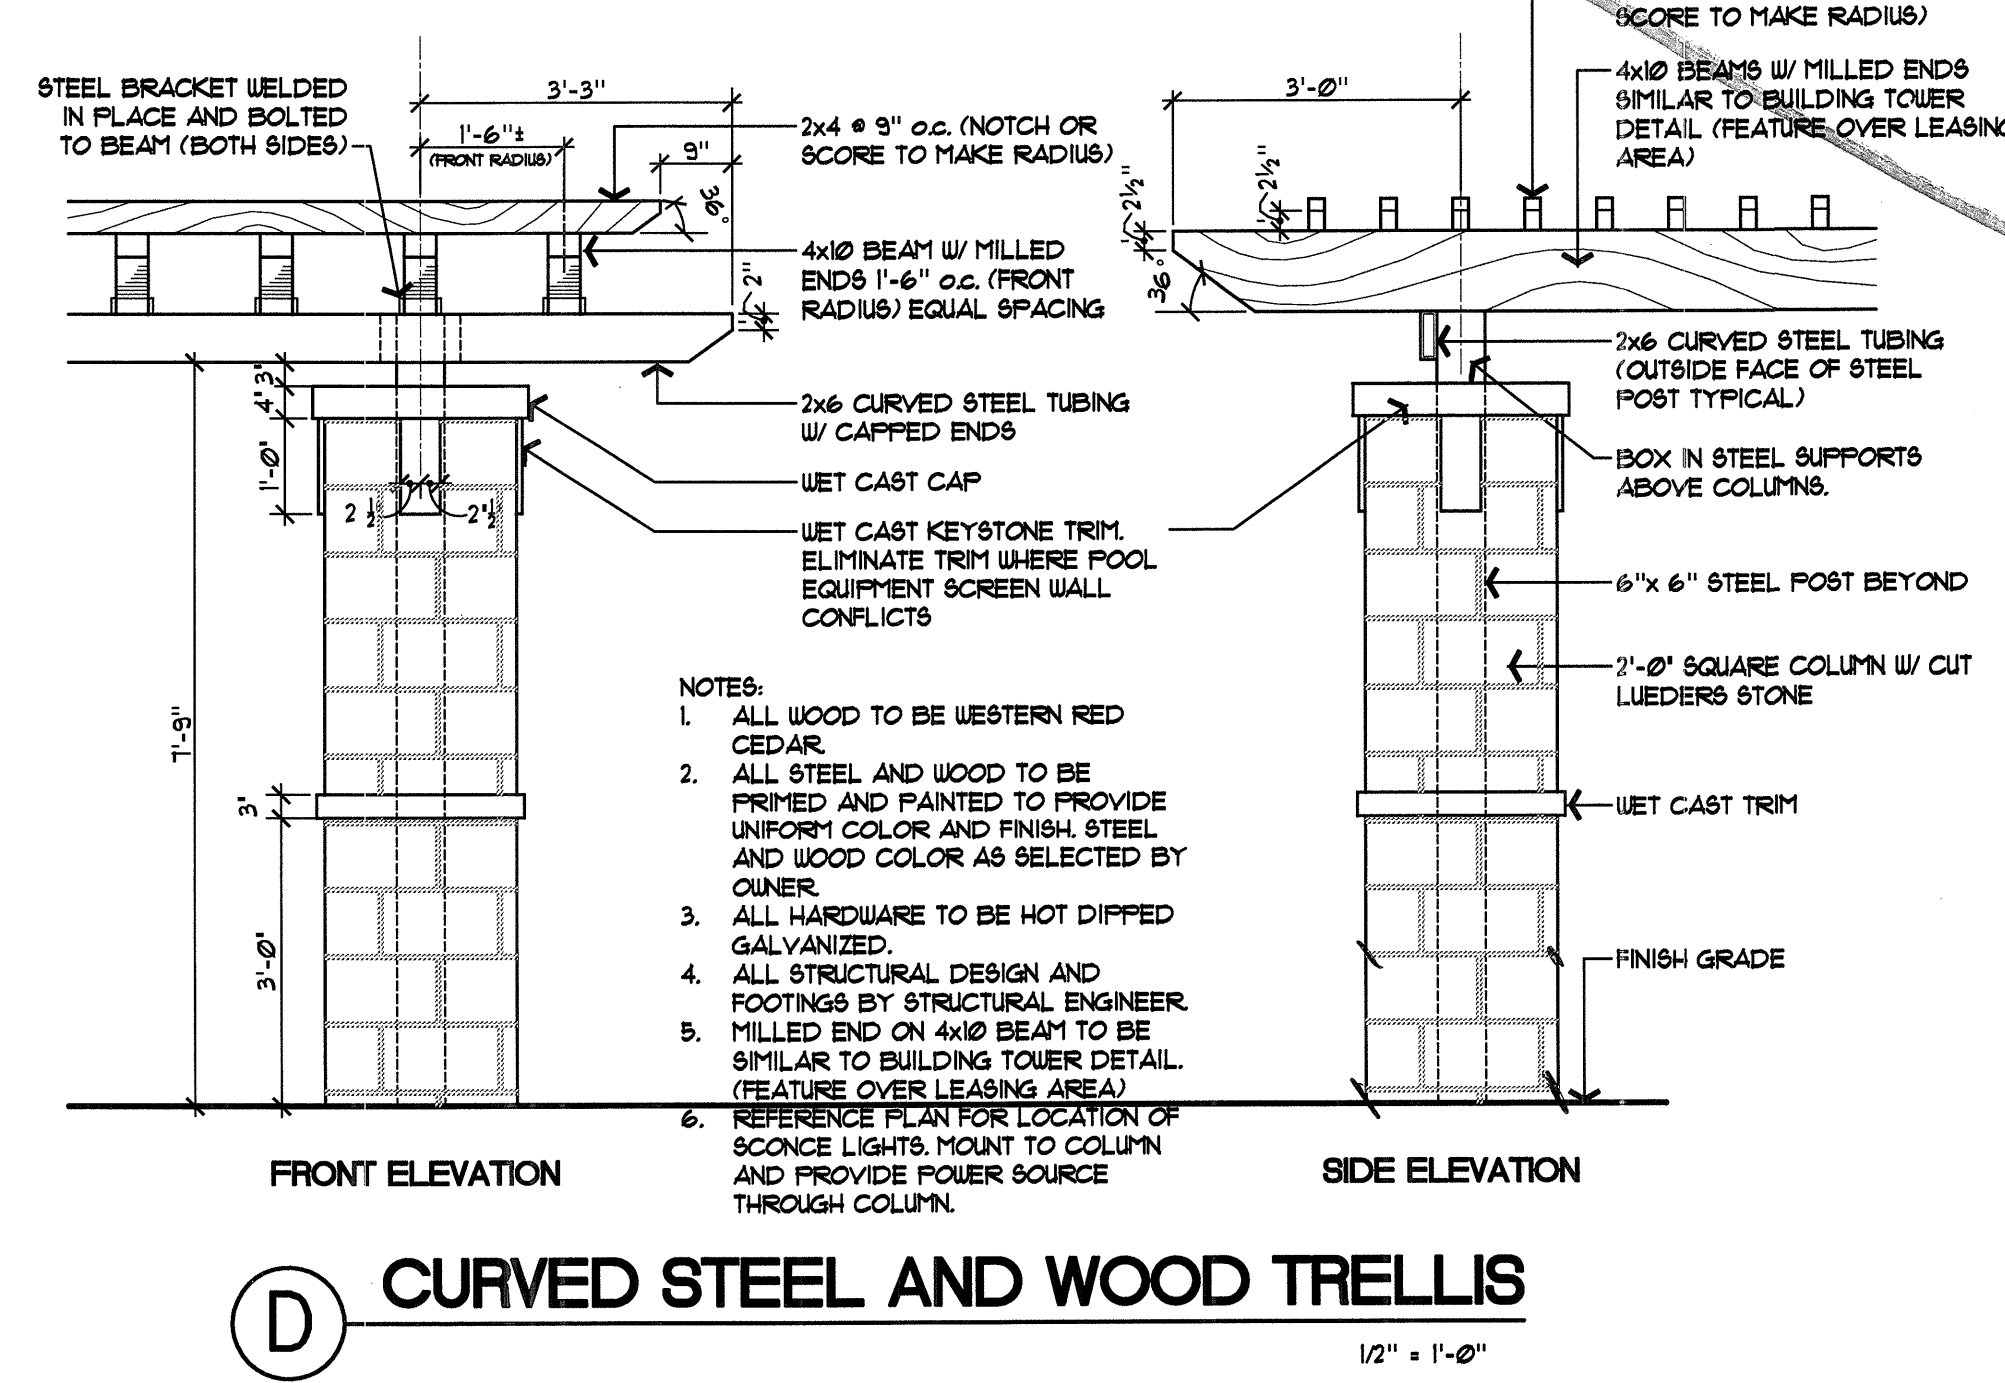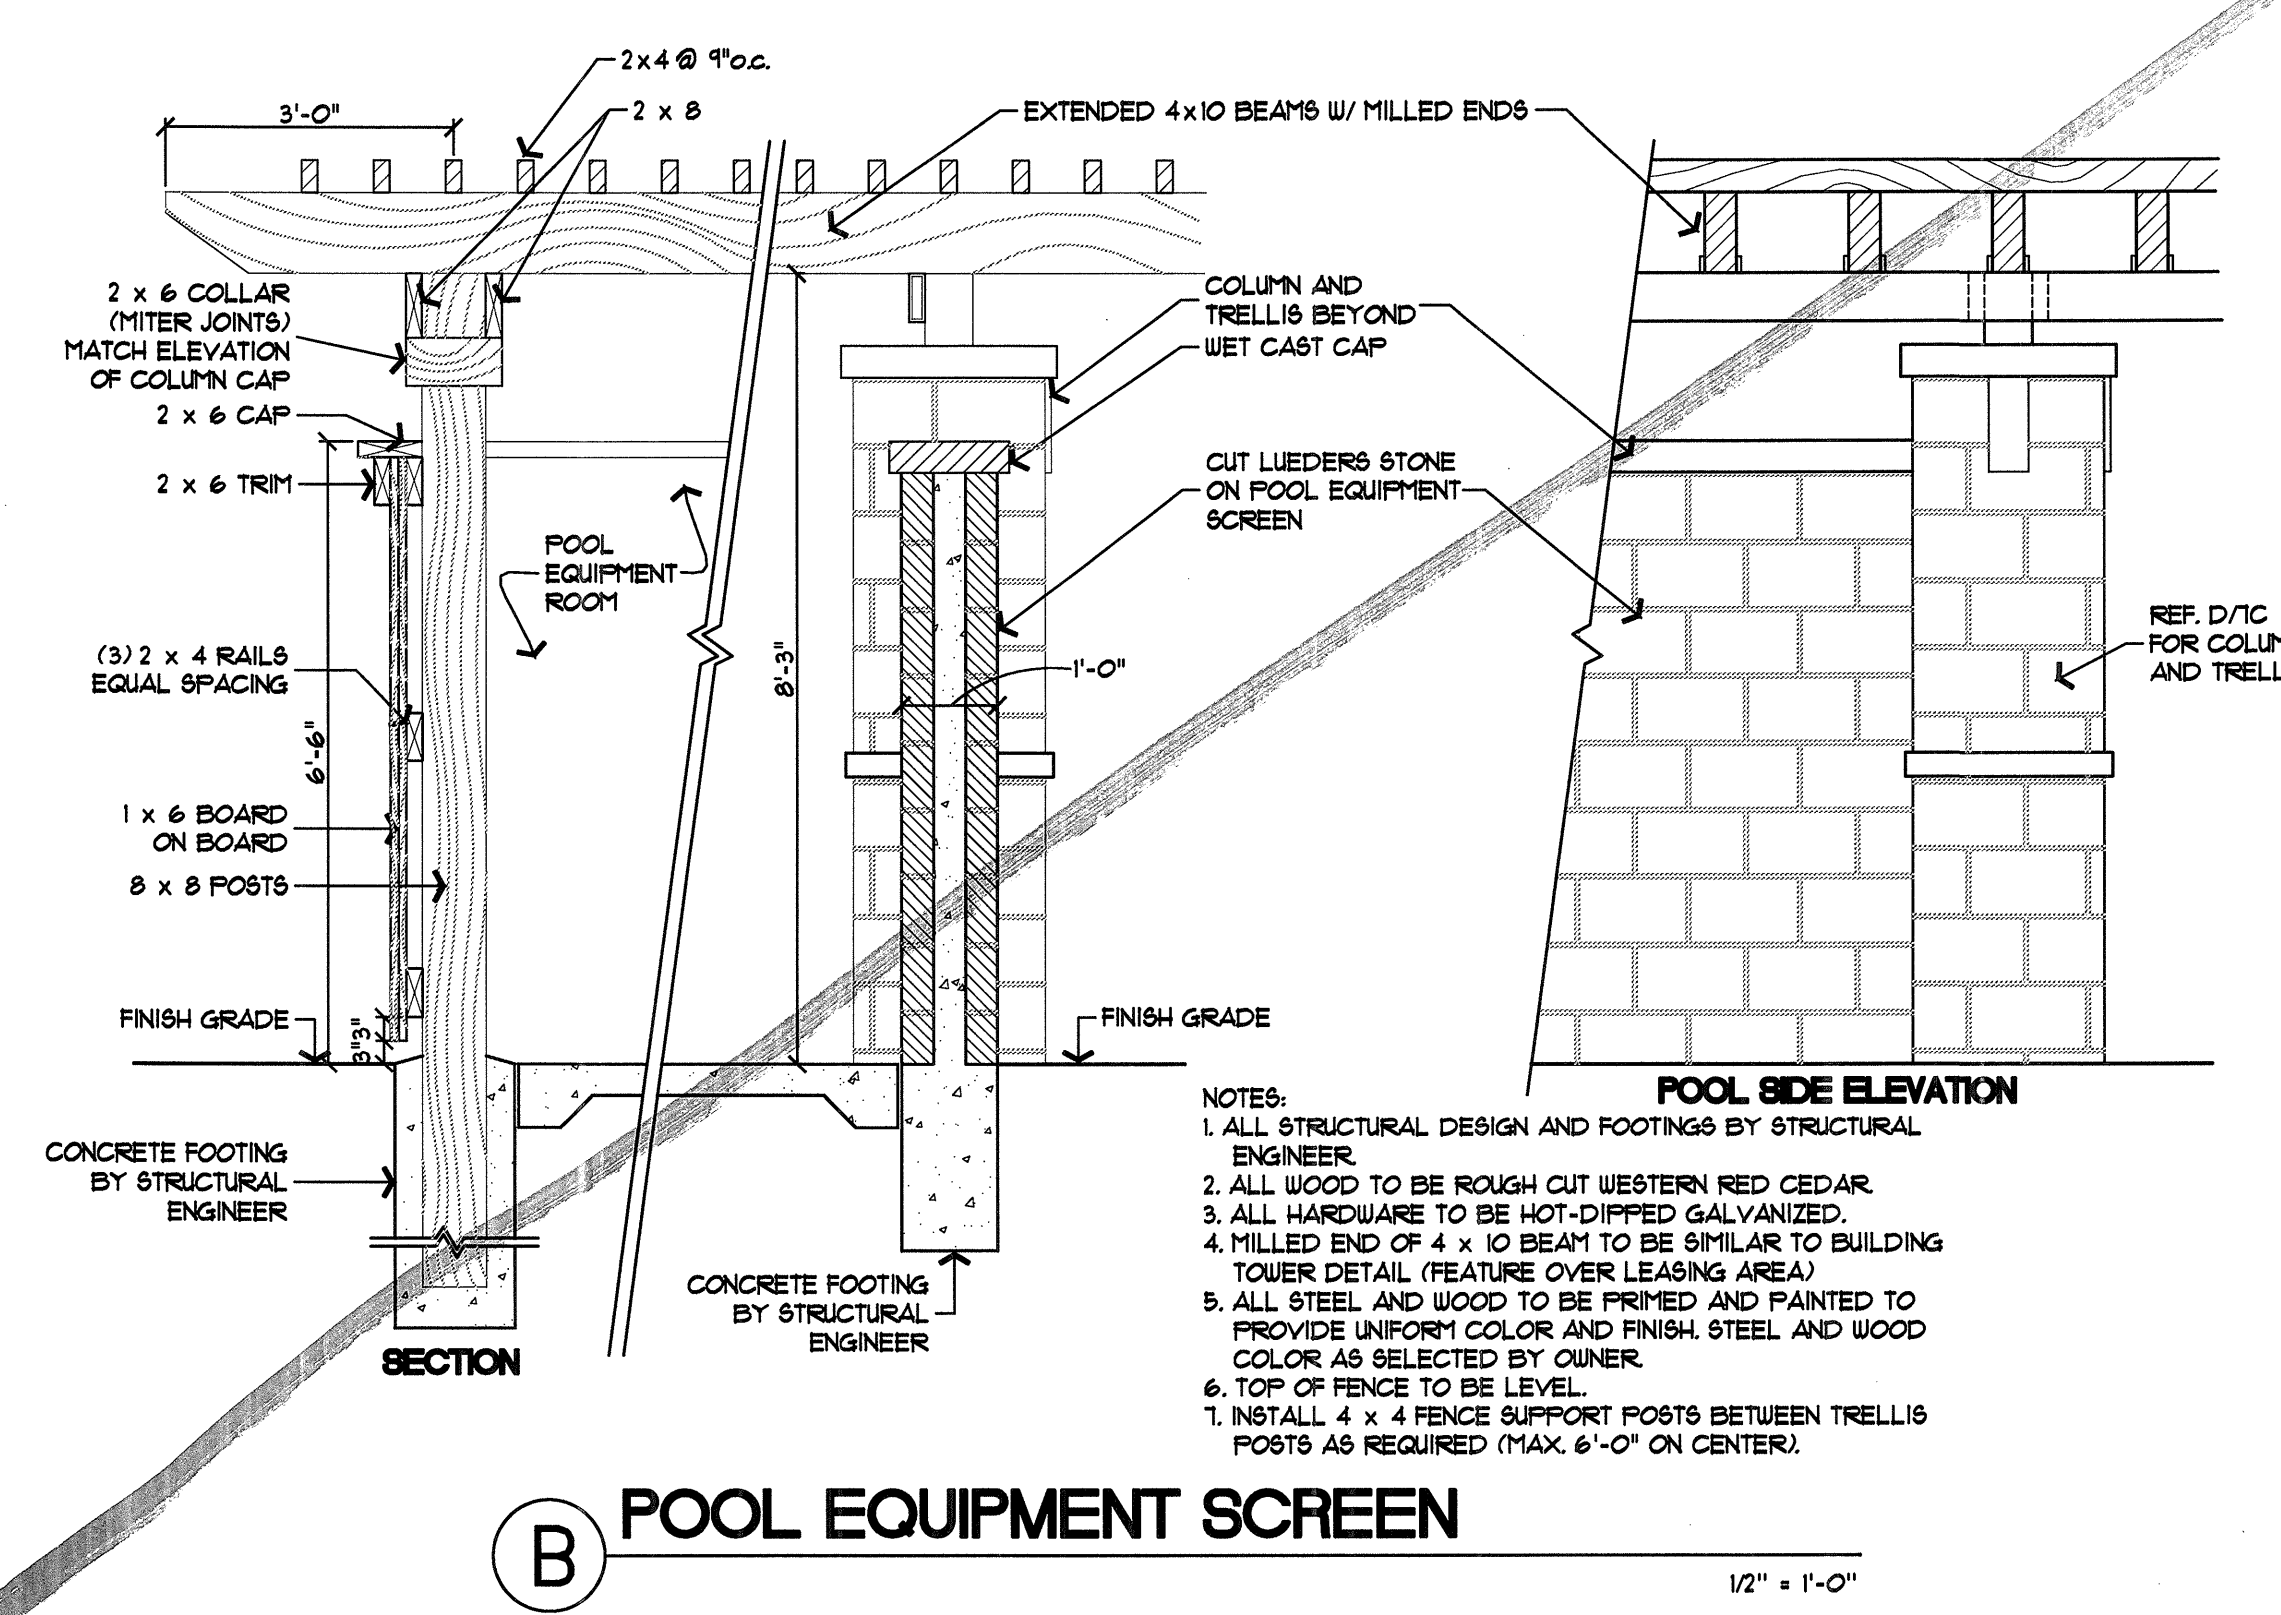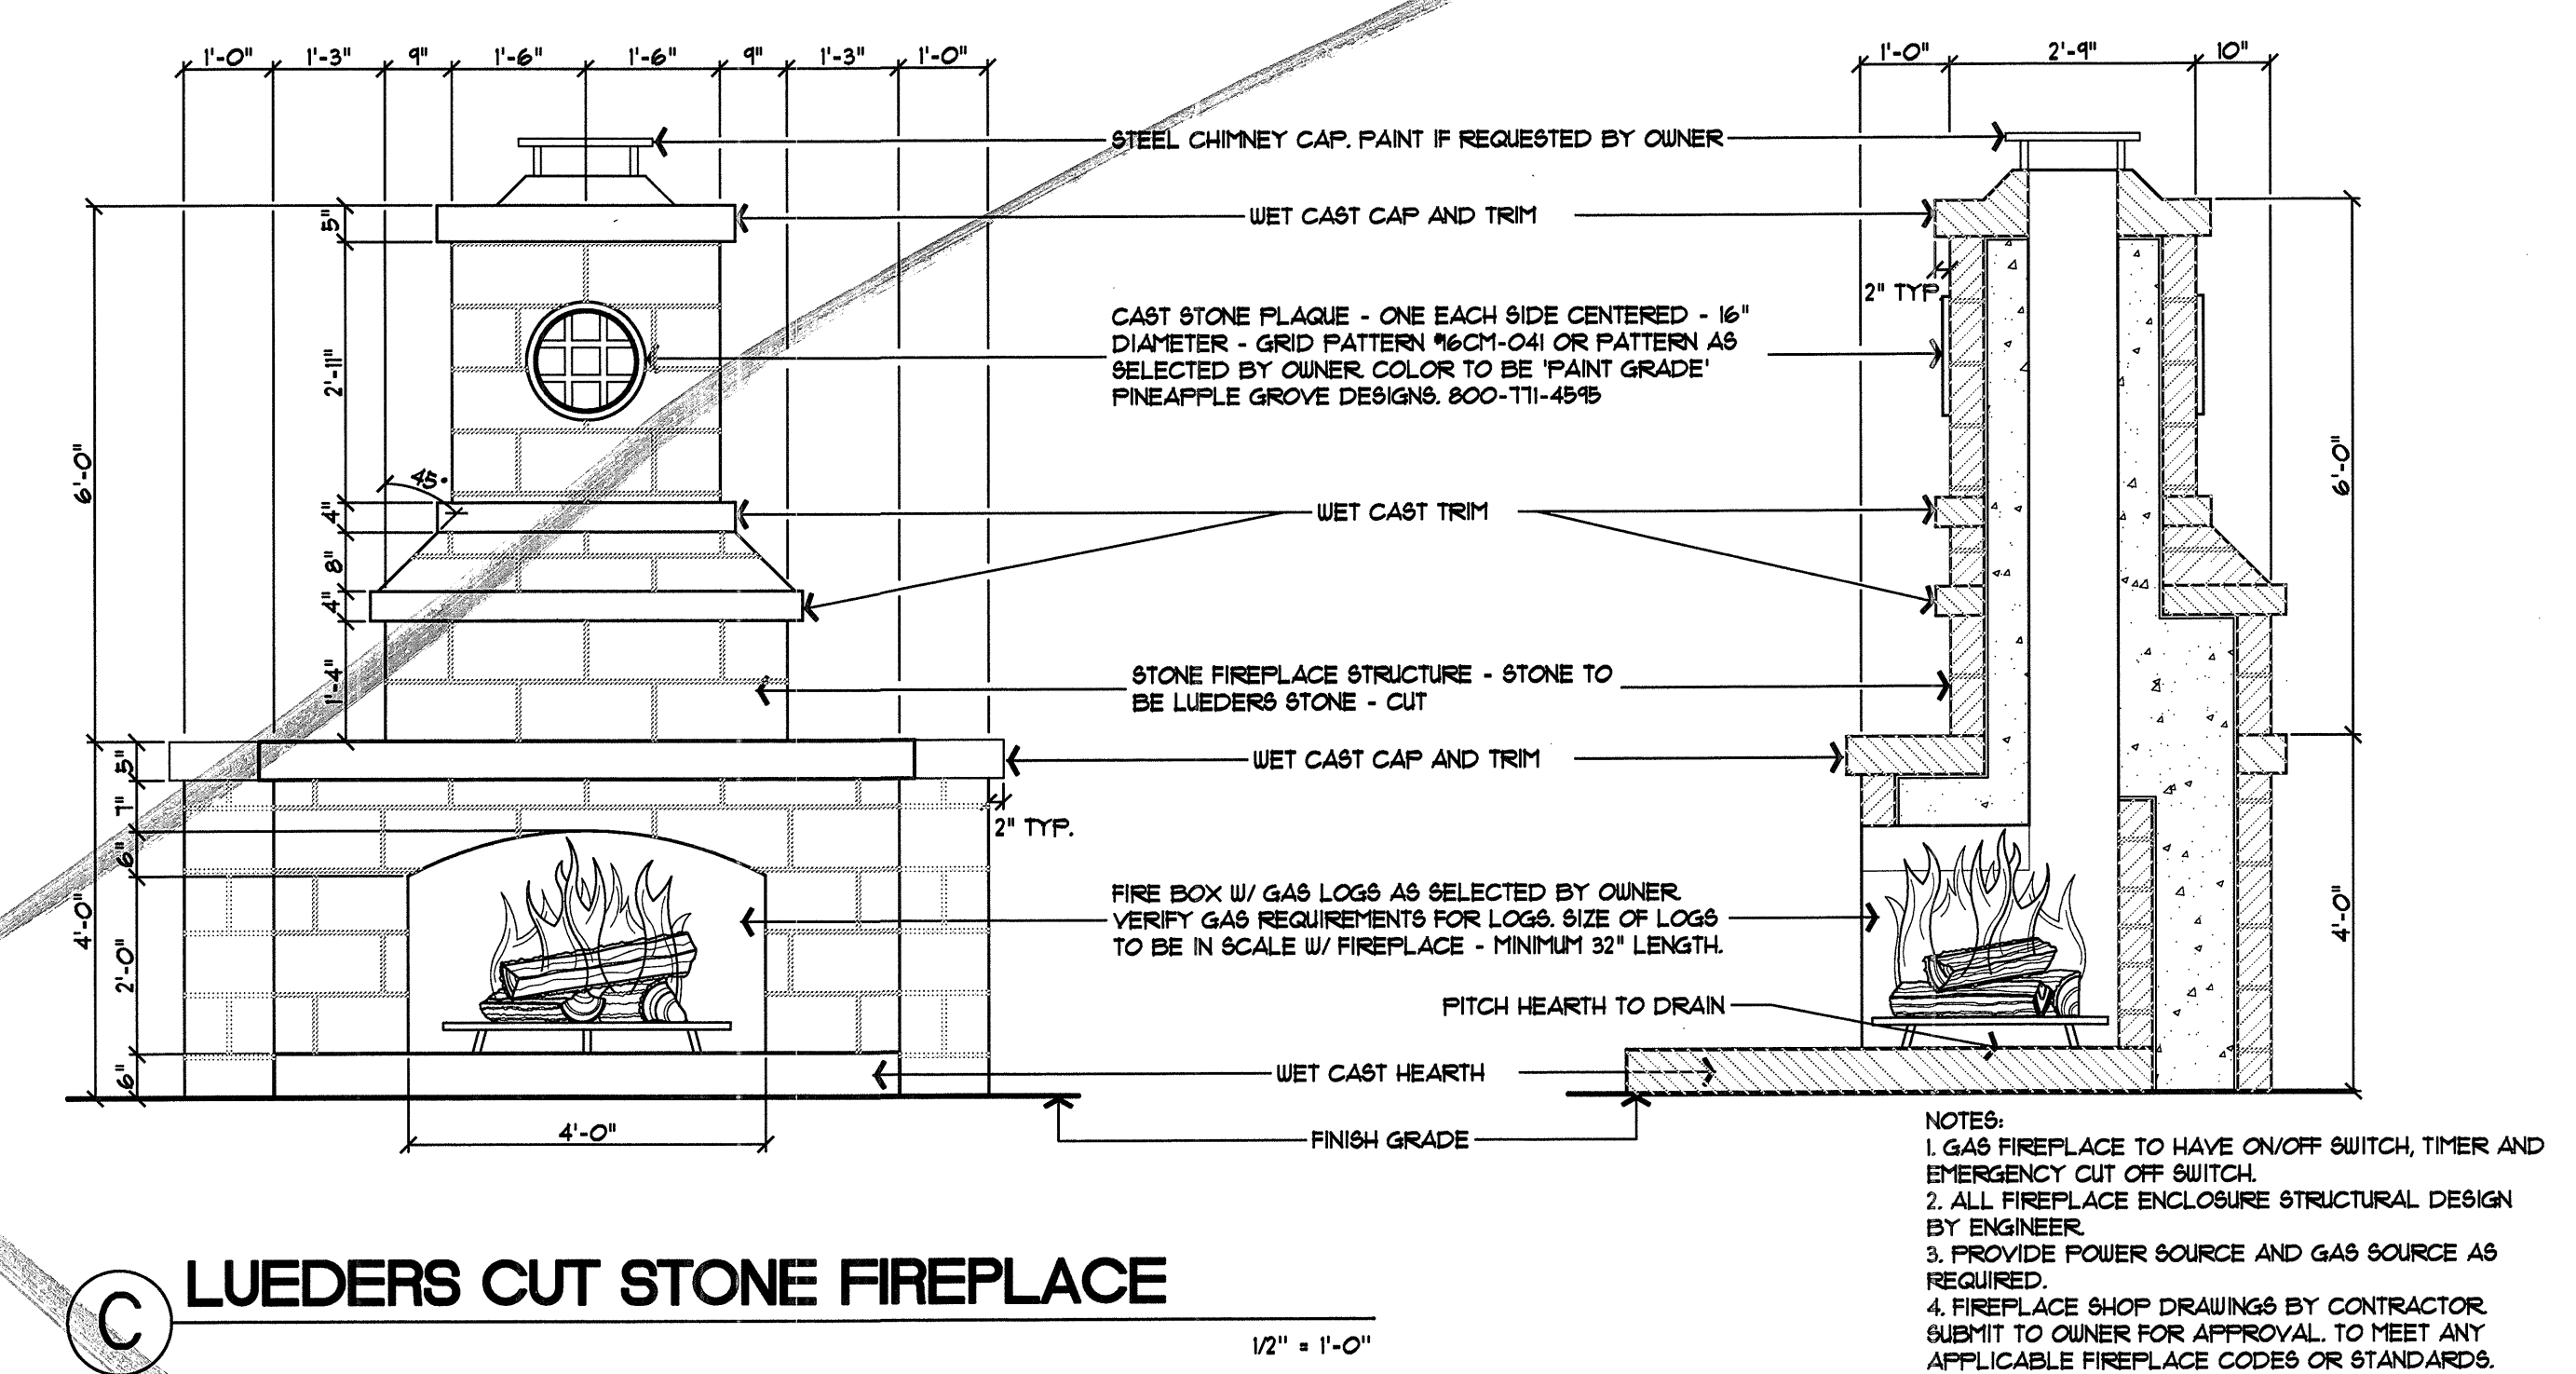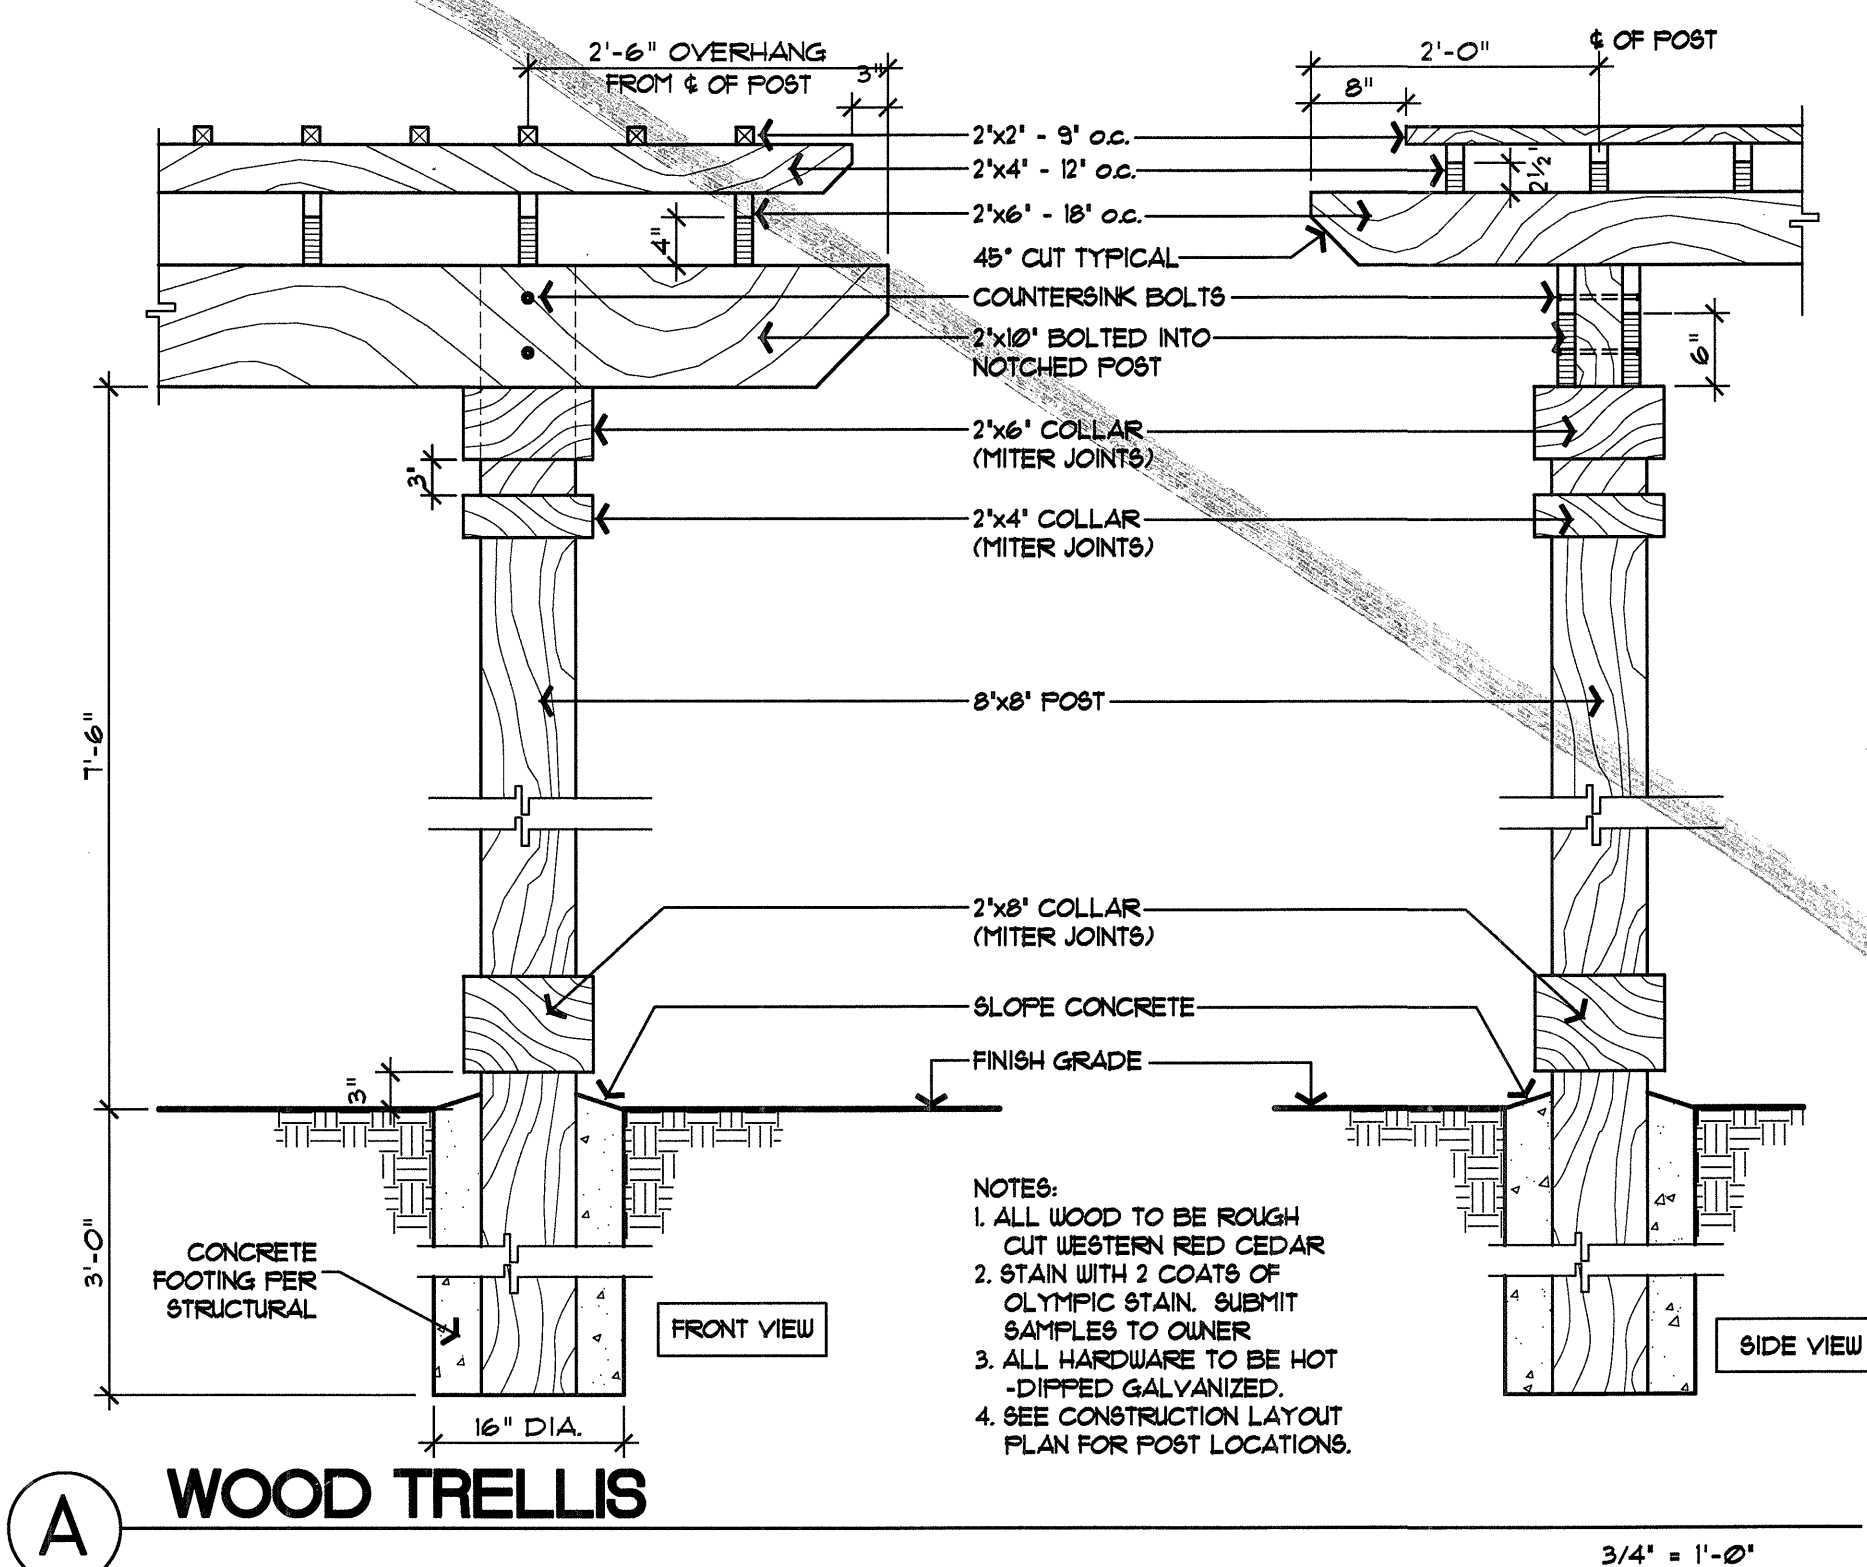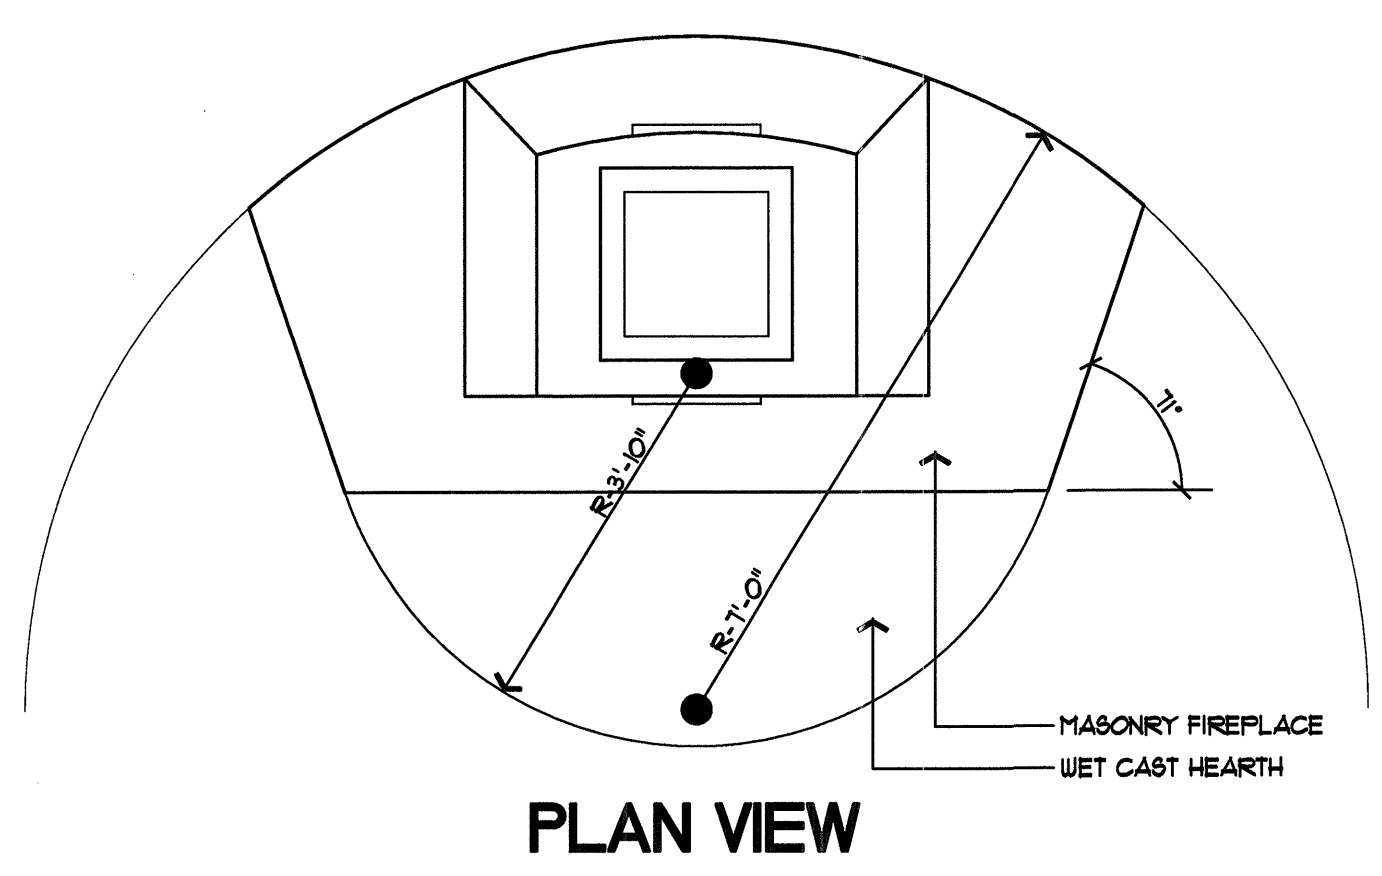

ALTERNATE POOL/FOUNTAIN TILE SIZE:
IF 2x2 TILE IS NOT AVAILABLE, SUBSTITUTE
3x3 FIELD SERIES, BLACK, #1A5 3x3 BLA,
AVAILABLE FROM MASTER TILE, 888-461-8453.
GROUT COLOR TO REMAIN CHARCOAL.