



PLAN VIEW

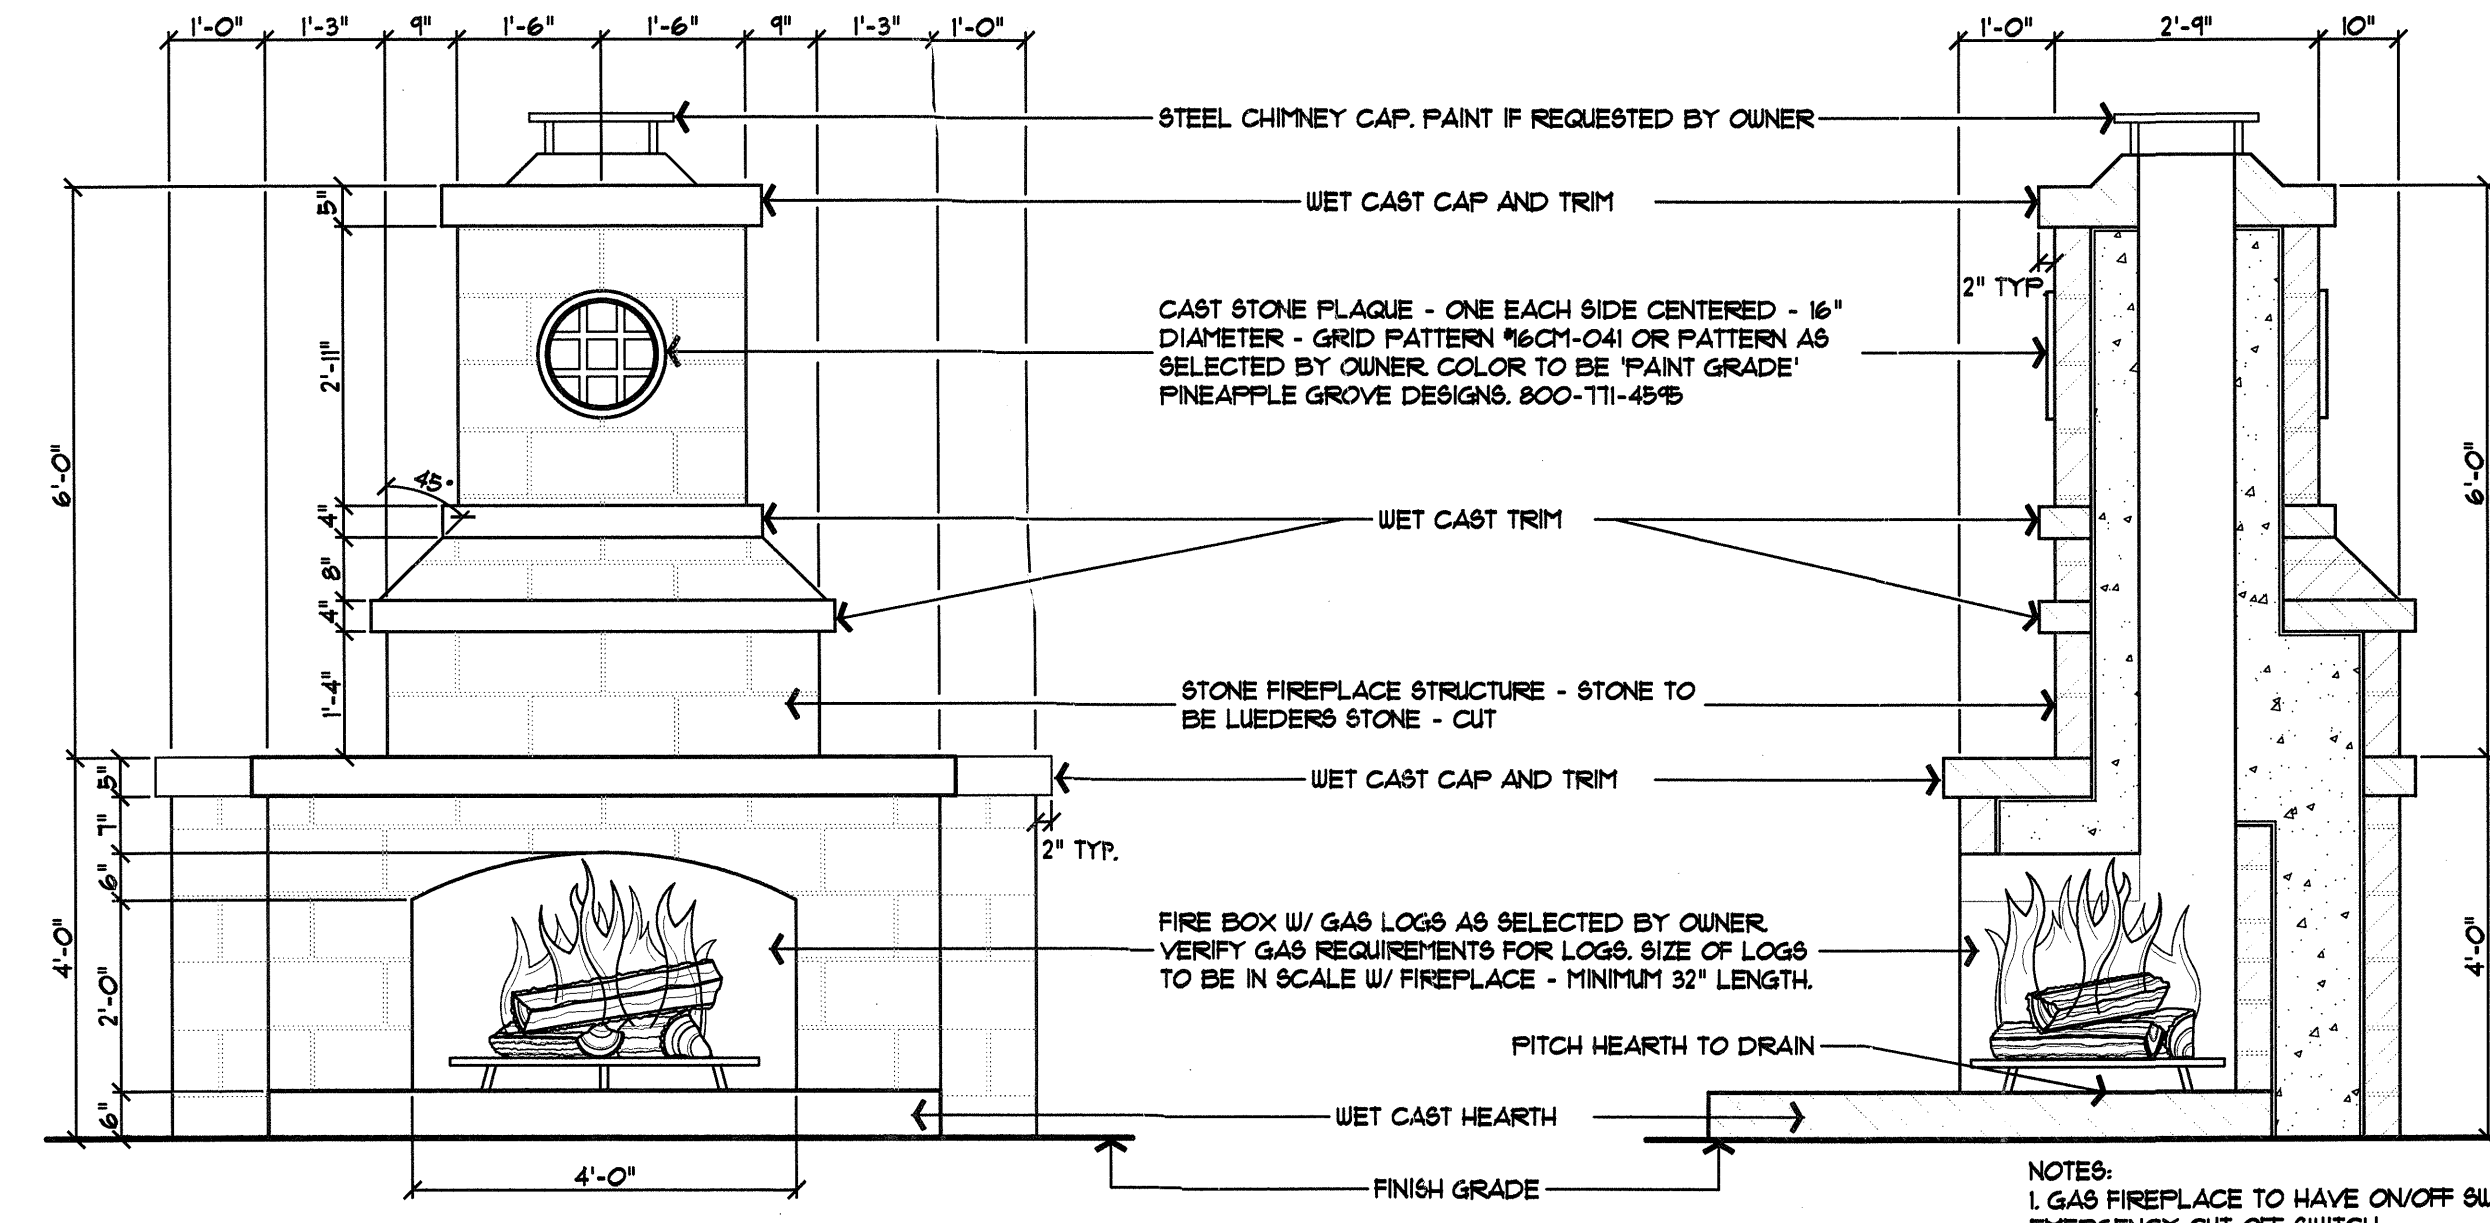


C LUEDERS CUT STONE FIREPLACE

1/2" = 1'-0"

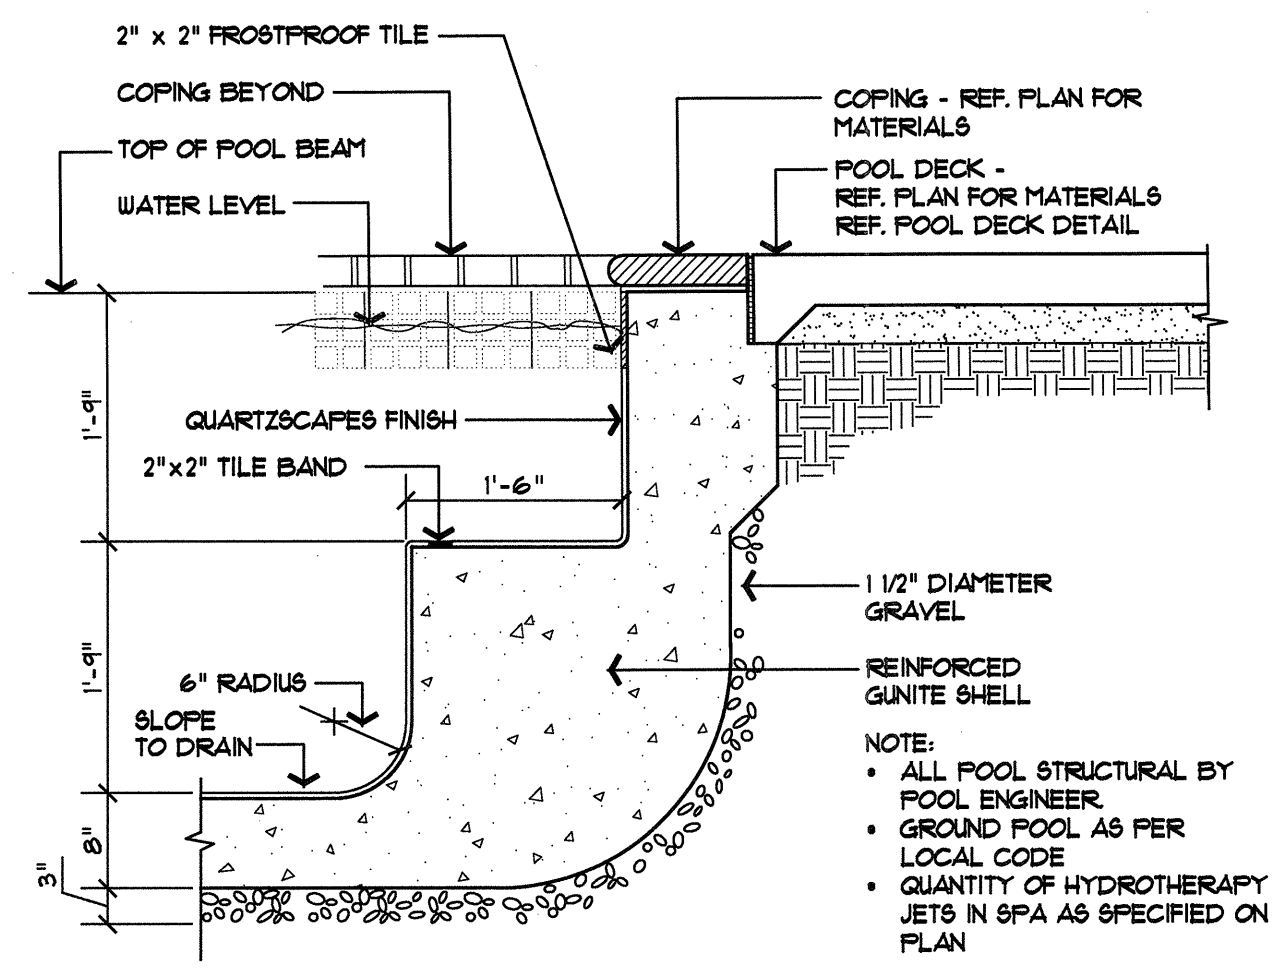


E SPA

3/4" = 1'-0"

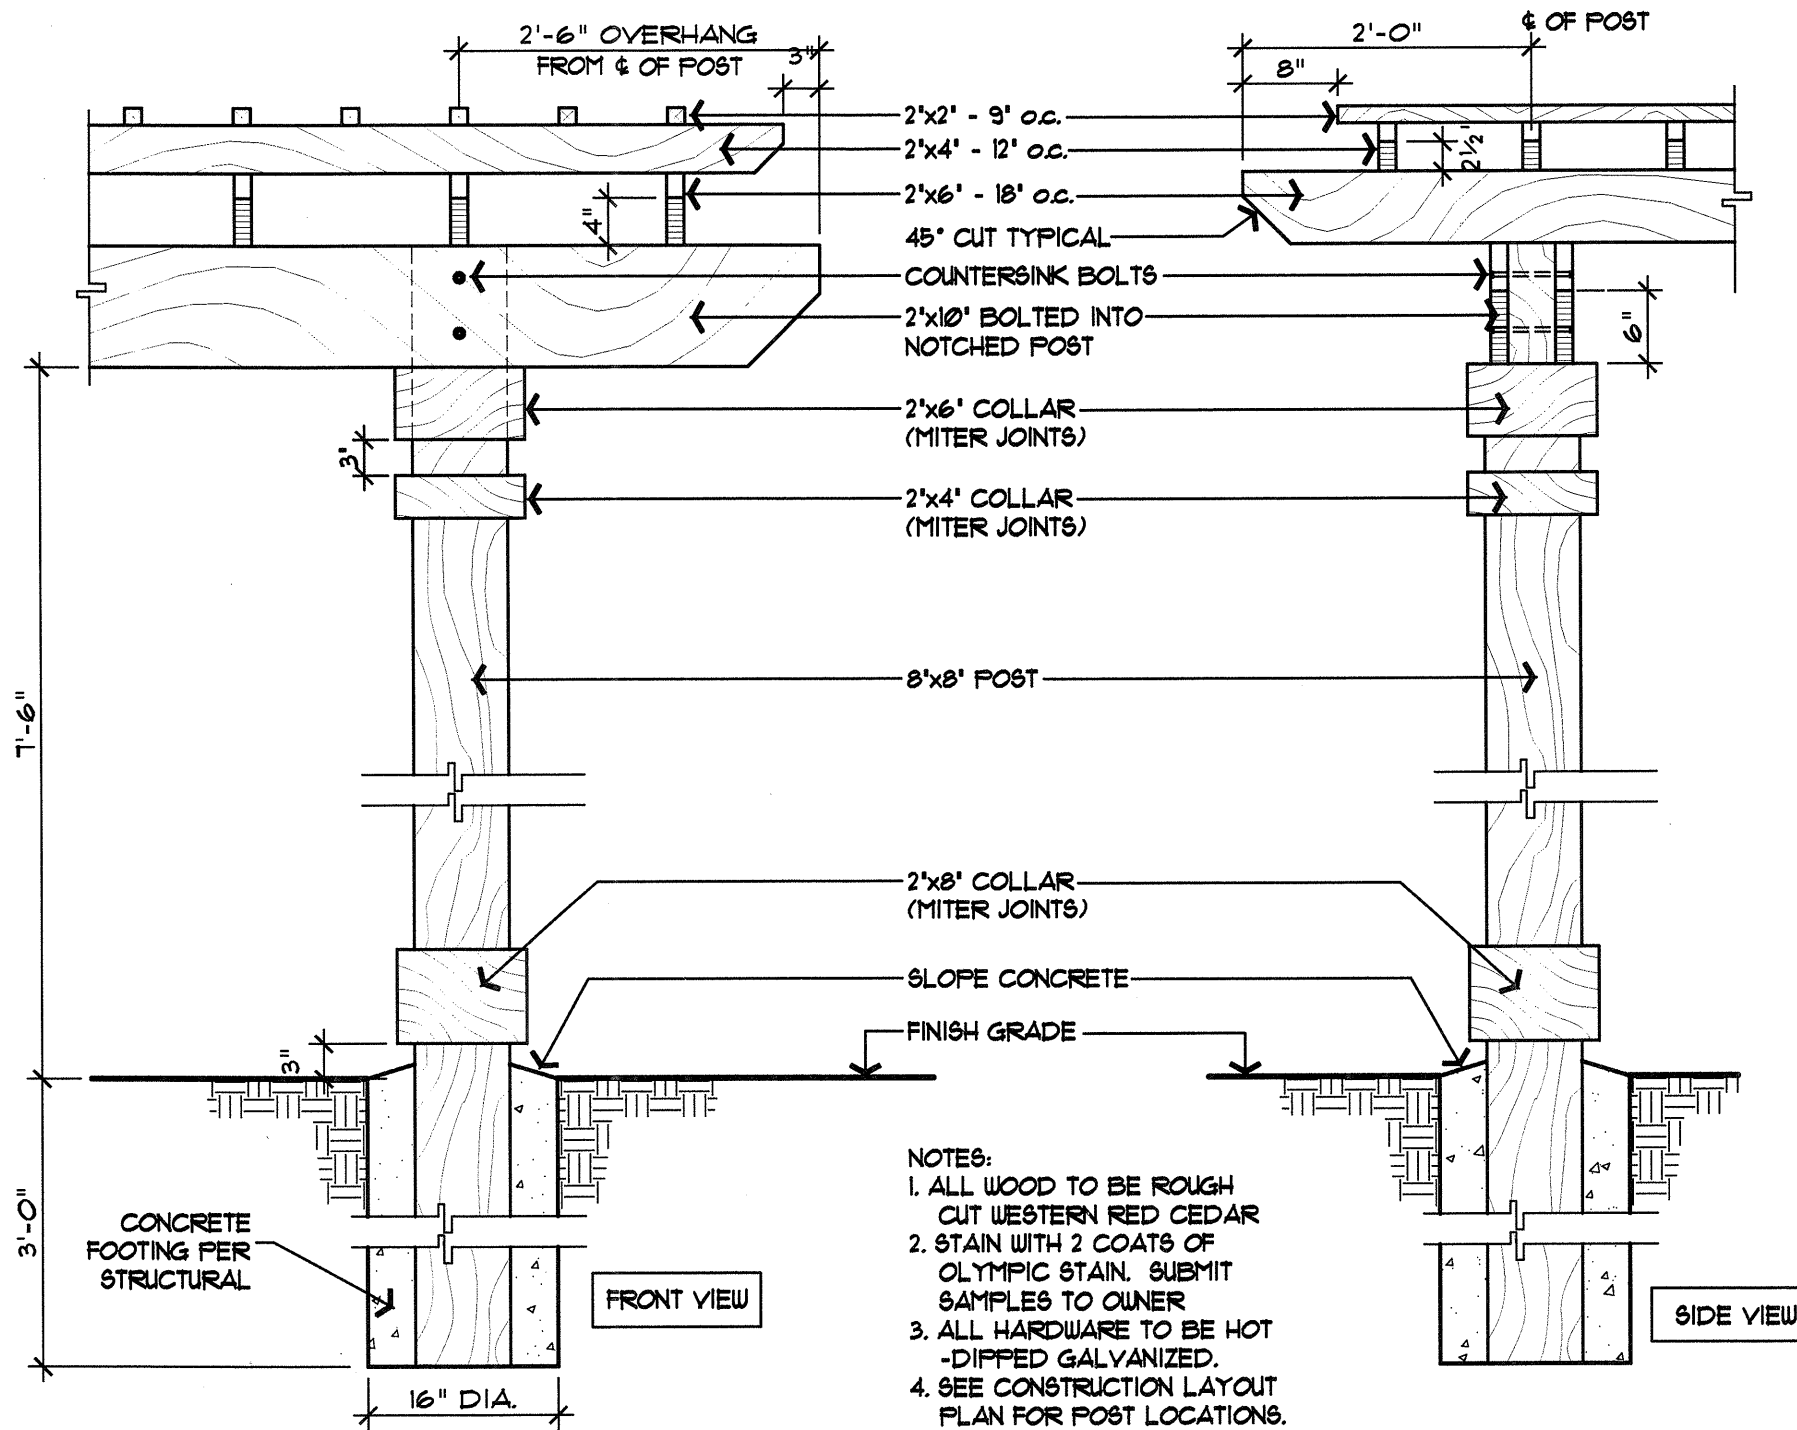


A WOOD TRELLIS

3/4" = 1'-0"

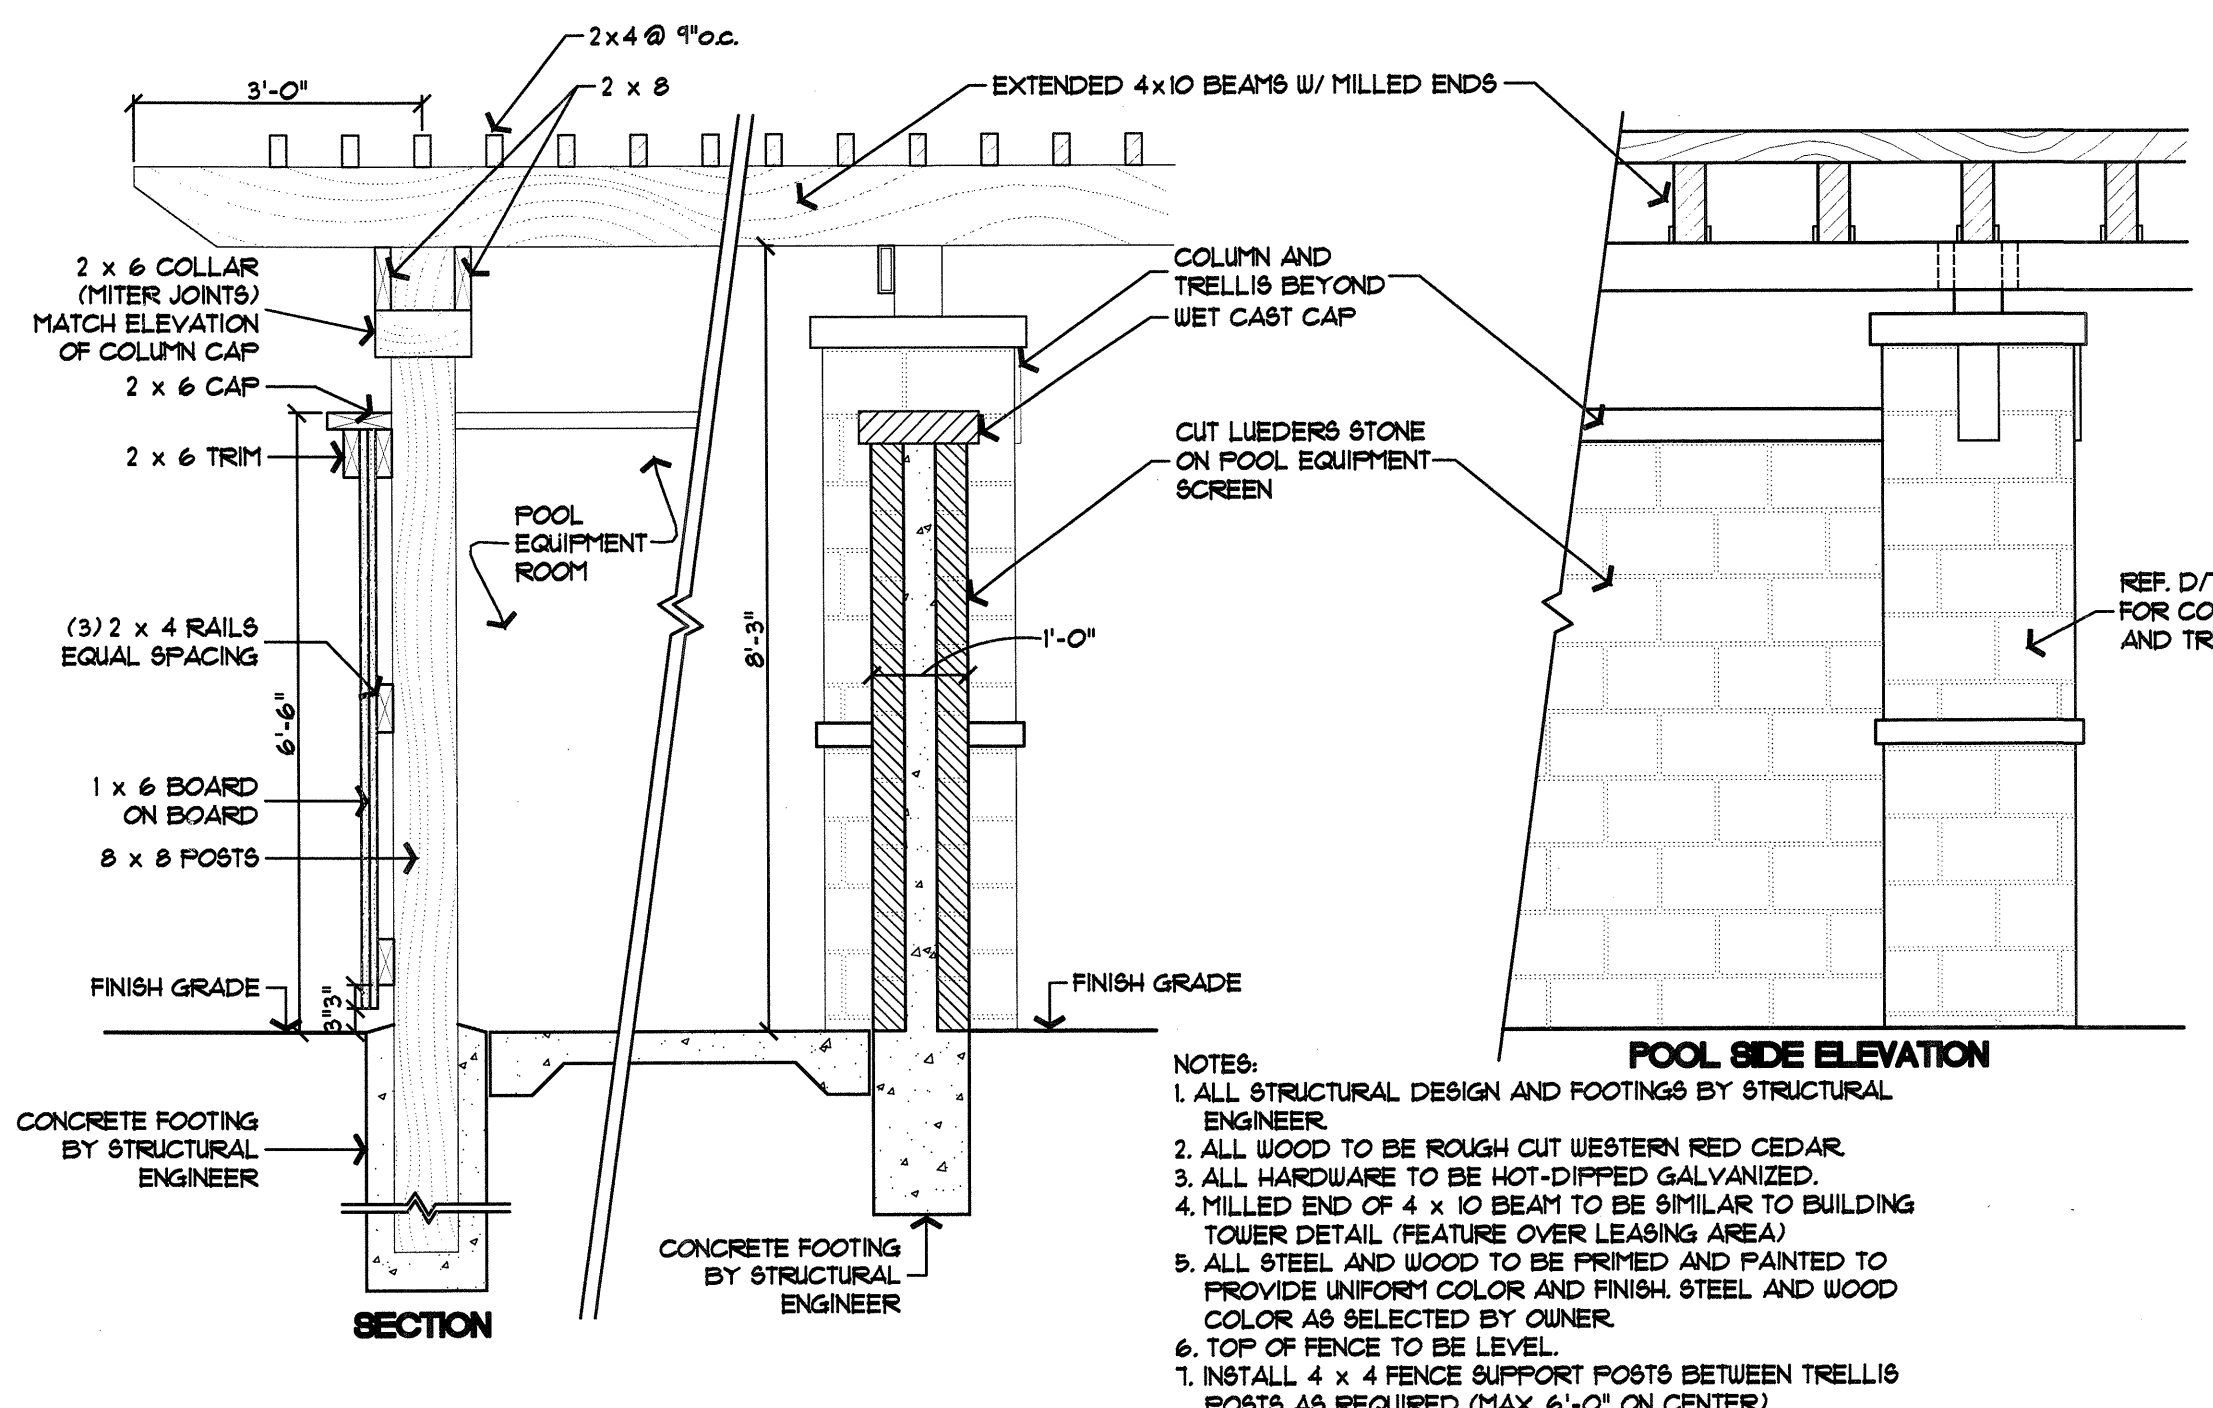

B POOL EQUIPMENT SCREEN


1/2" = 1'-0"

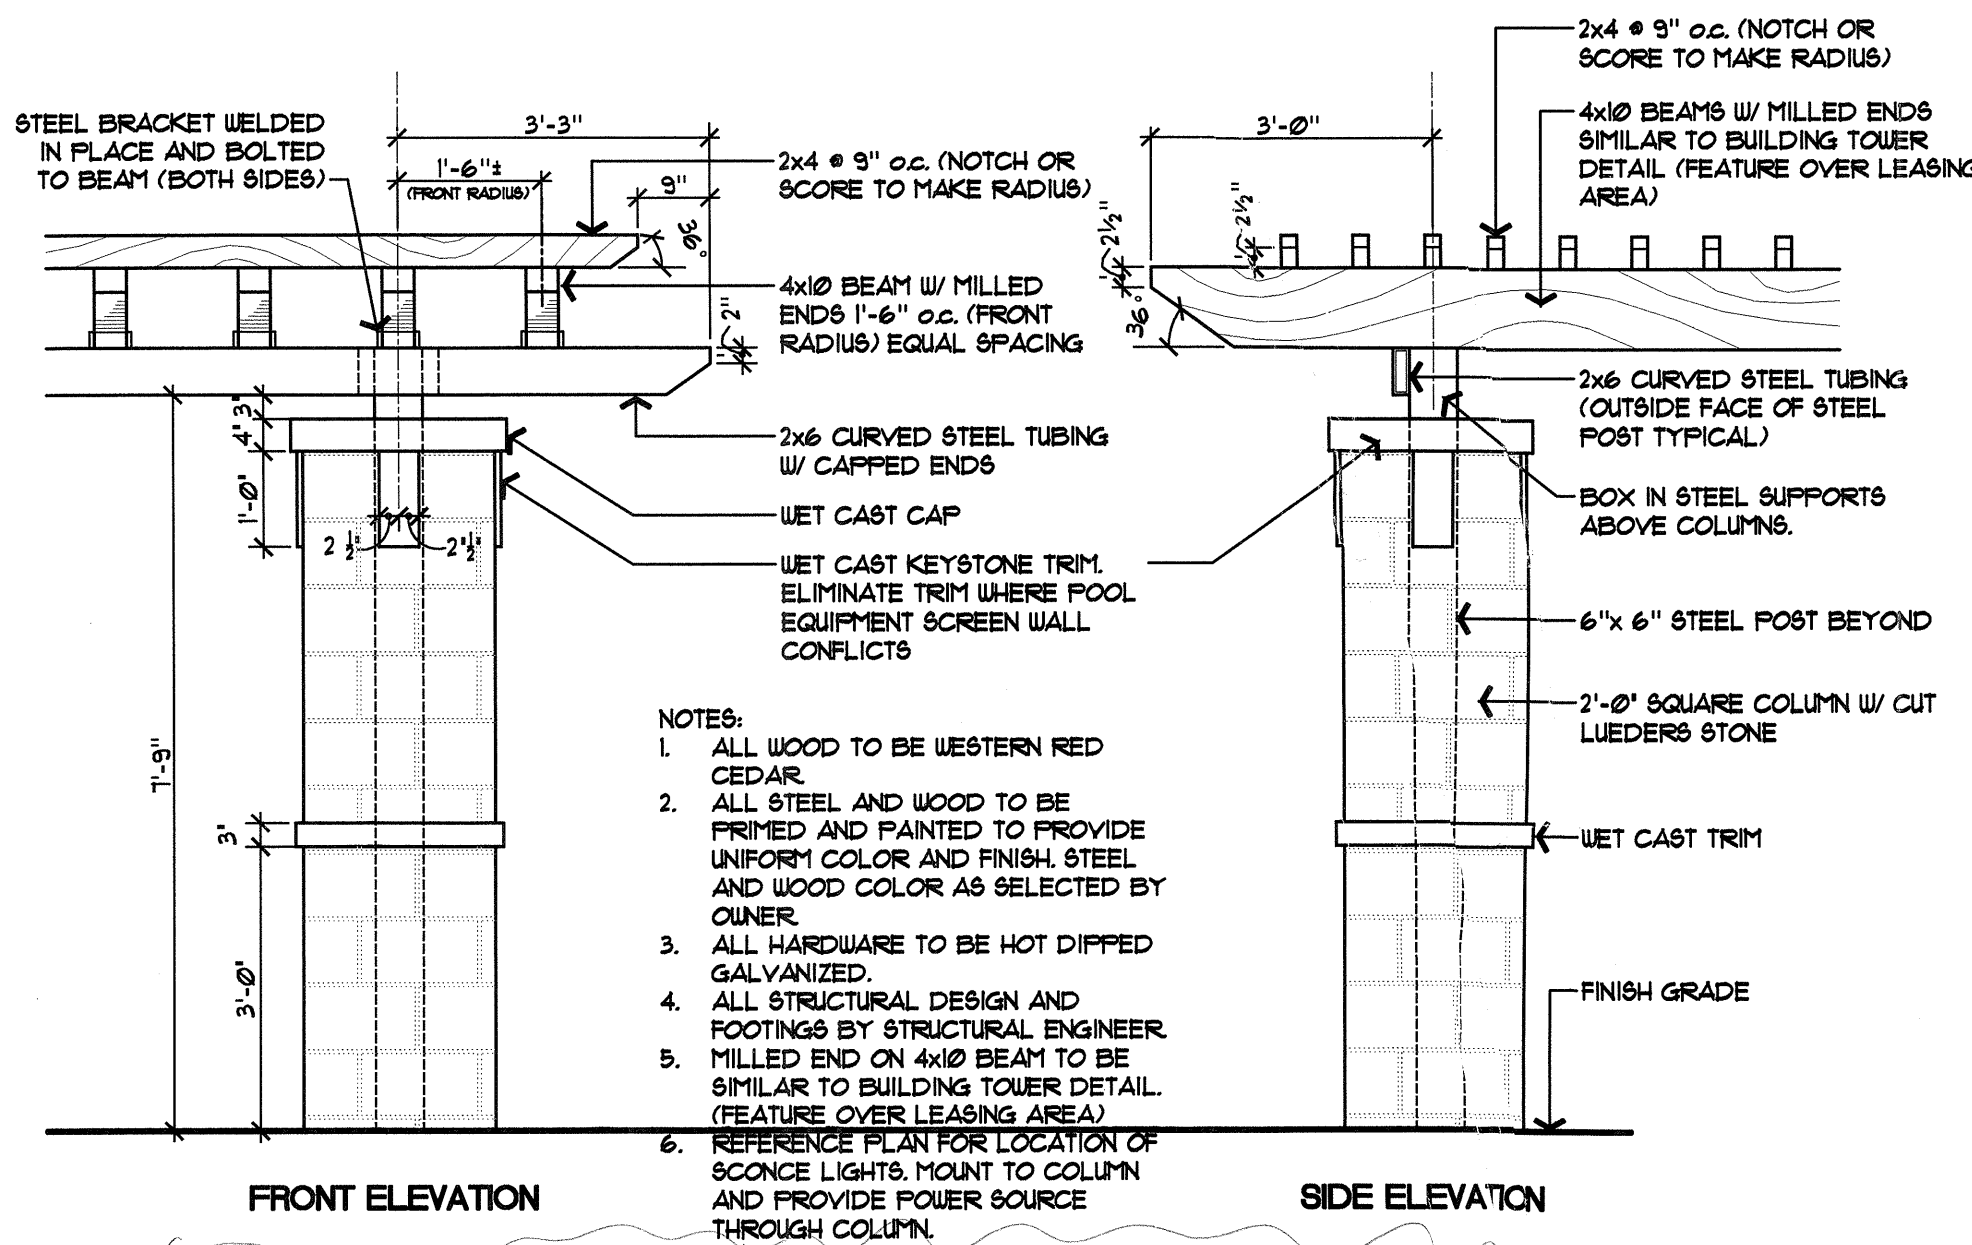

D CURVED STEEL AND WOOD TRELLIS

1/2" = 1'-0"


ALTERNATE POOL/FOUNTAIN TILE SIZE:  
IF 2x2 TILE IS NOT AVAILABLE, SUBSTITUTE  
3x3 FIELD SERIES, BLACK, #MAS 3x3 BLA,  
AVAILABLE FROM MASTER TILE, 888-461-8453.  
GROUT COLOR TO REMAIN CHARCOAL.

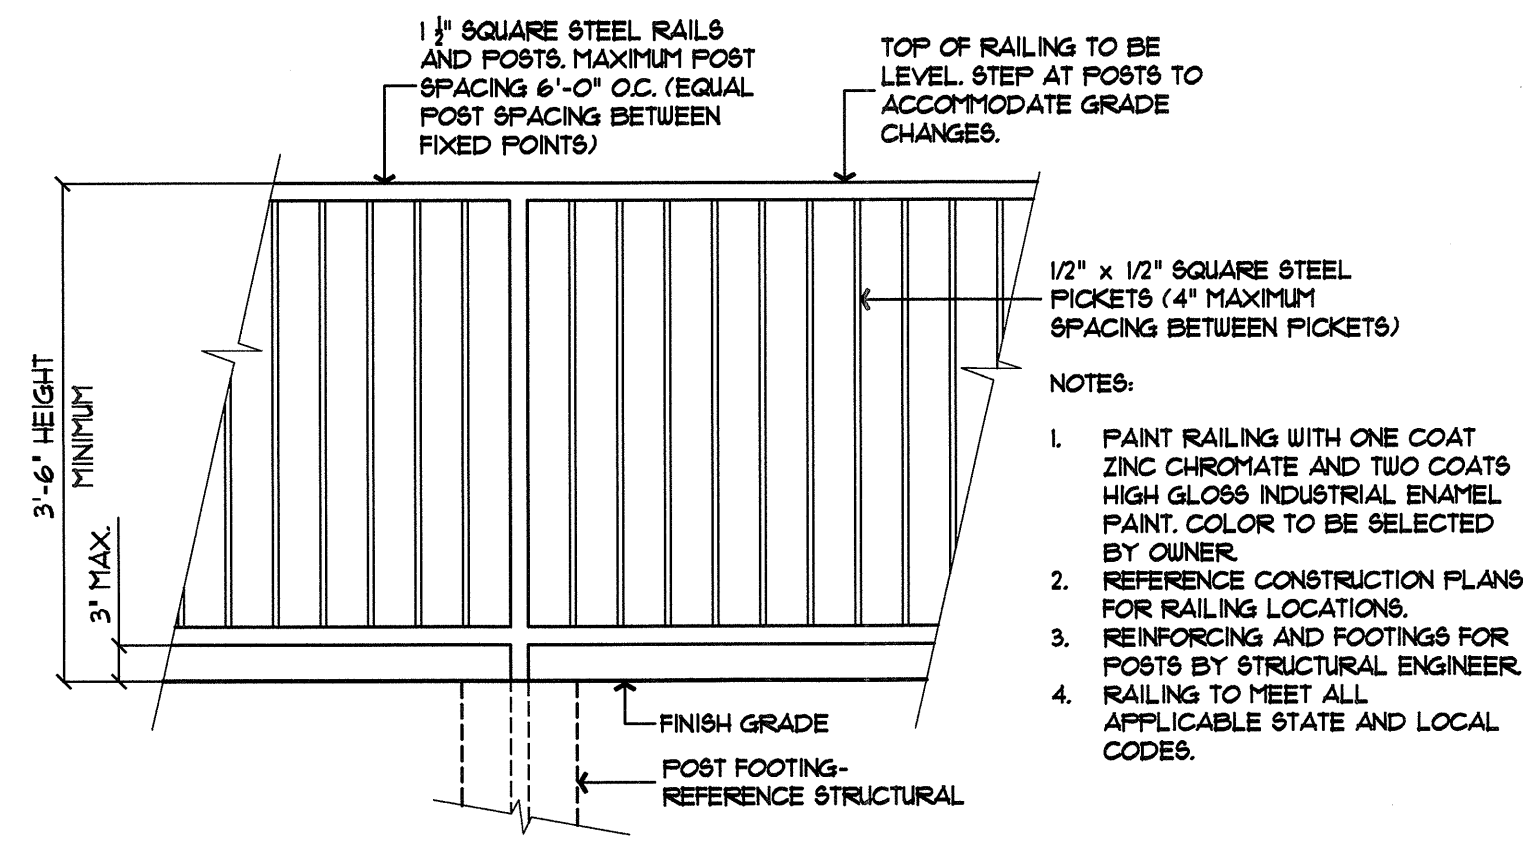

F SAFETY RAILING (STANDARD)

3/4" = 1'-0"

File Name: Keller Springs details.dwg  
Plot Date: 02/02/2012 03:21pm

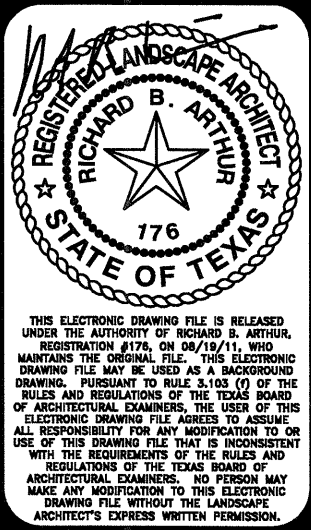

REVISIONS  
02 FEB 2012  
ADD DETAIL F - RAILING

Keller Springs Lofts  
EMBREY PARTNERS, LTD  
ADDISON, TEXAS

SCALE  
AS NOTED

DATE  
19 AUG 2011

TITLE  
CONSTRUCTION DETAILS

SHEET  
7C OF 9