



A FOUNTAIN FEATURE AND ARBOR
RFD 191 + 214
1/2" = 1'-0"


ALTERNATE POOL/FOUNTAIN TILE SIZE:
IF 2x2 TILE IS NOT AVAILABLE, SUBSTITUTE
3x3 FIELD SERIES, BLACK, #MAS 3x3 BLA,
AVAILABLE FROM MASTER TILE, 888-461-8453.
GROUT COLOR TO REMAIN CHARCOAL.

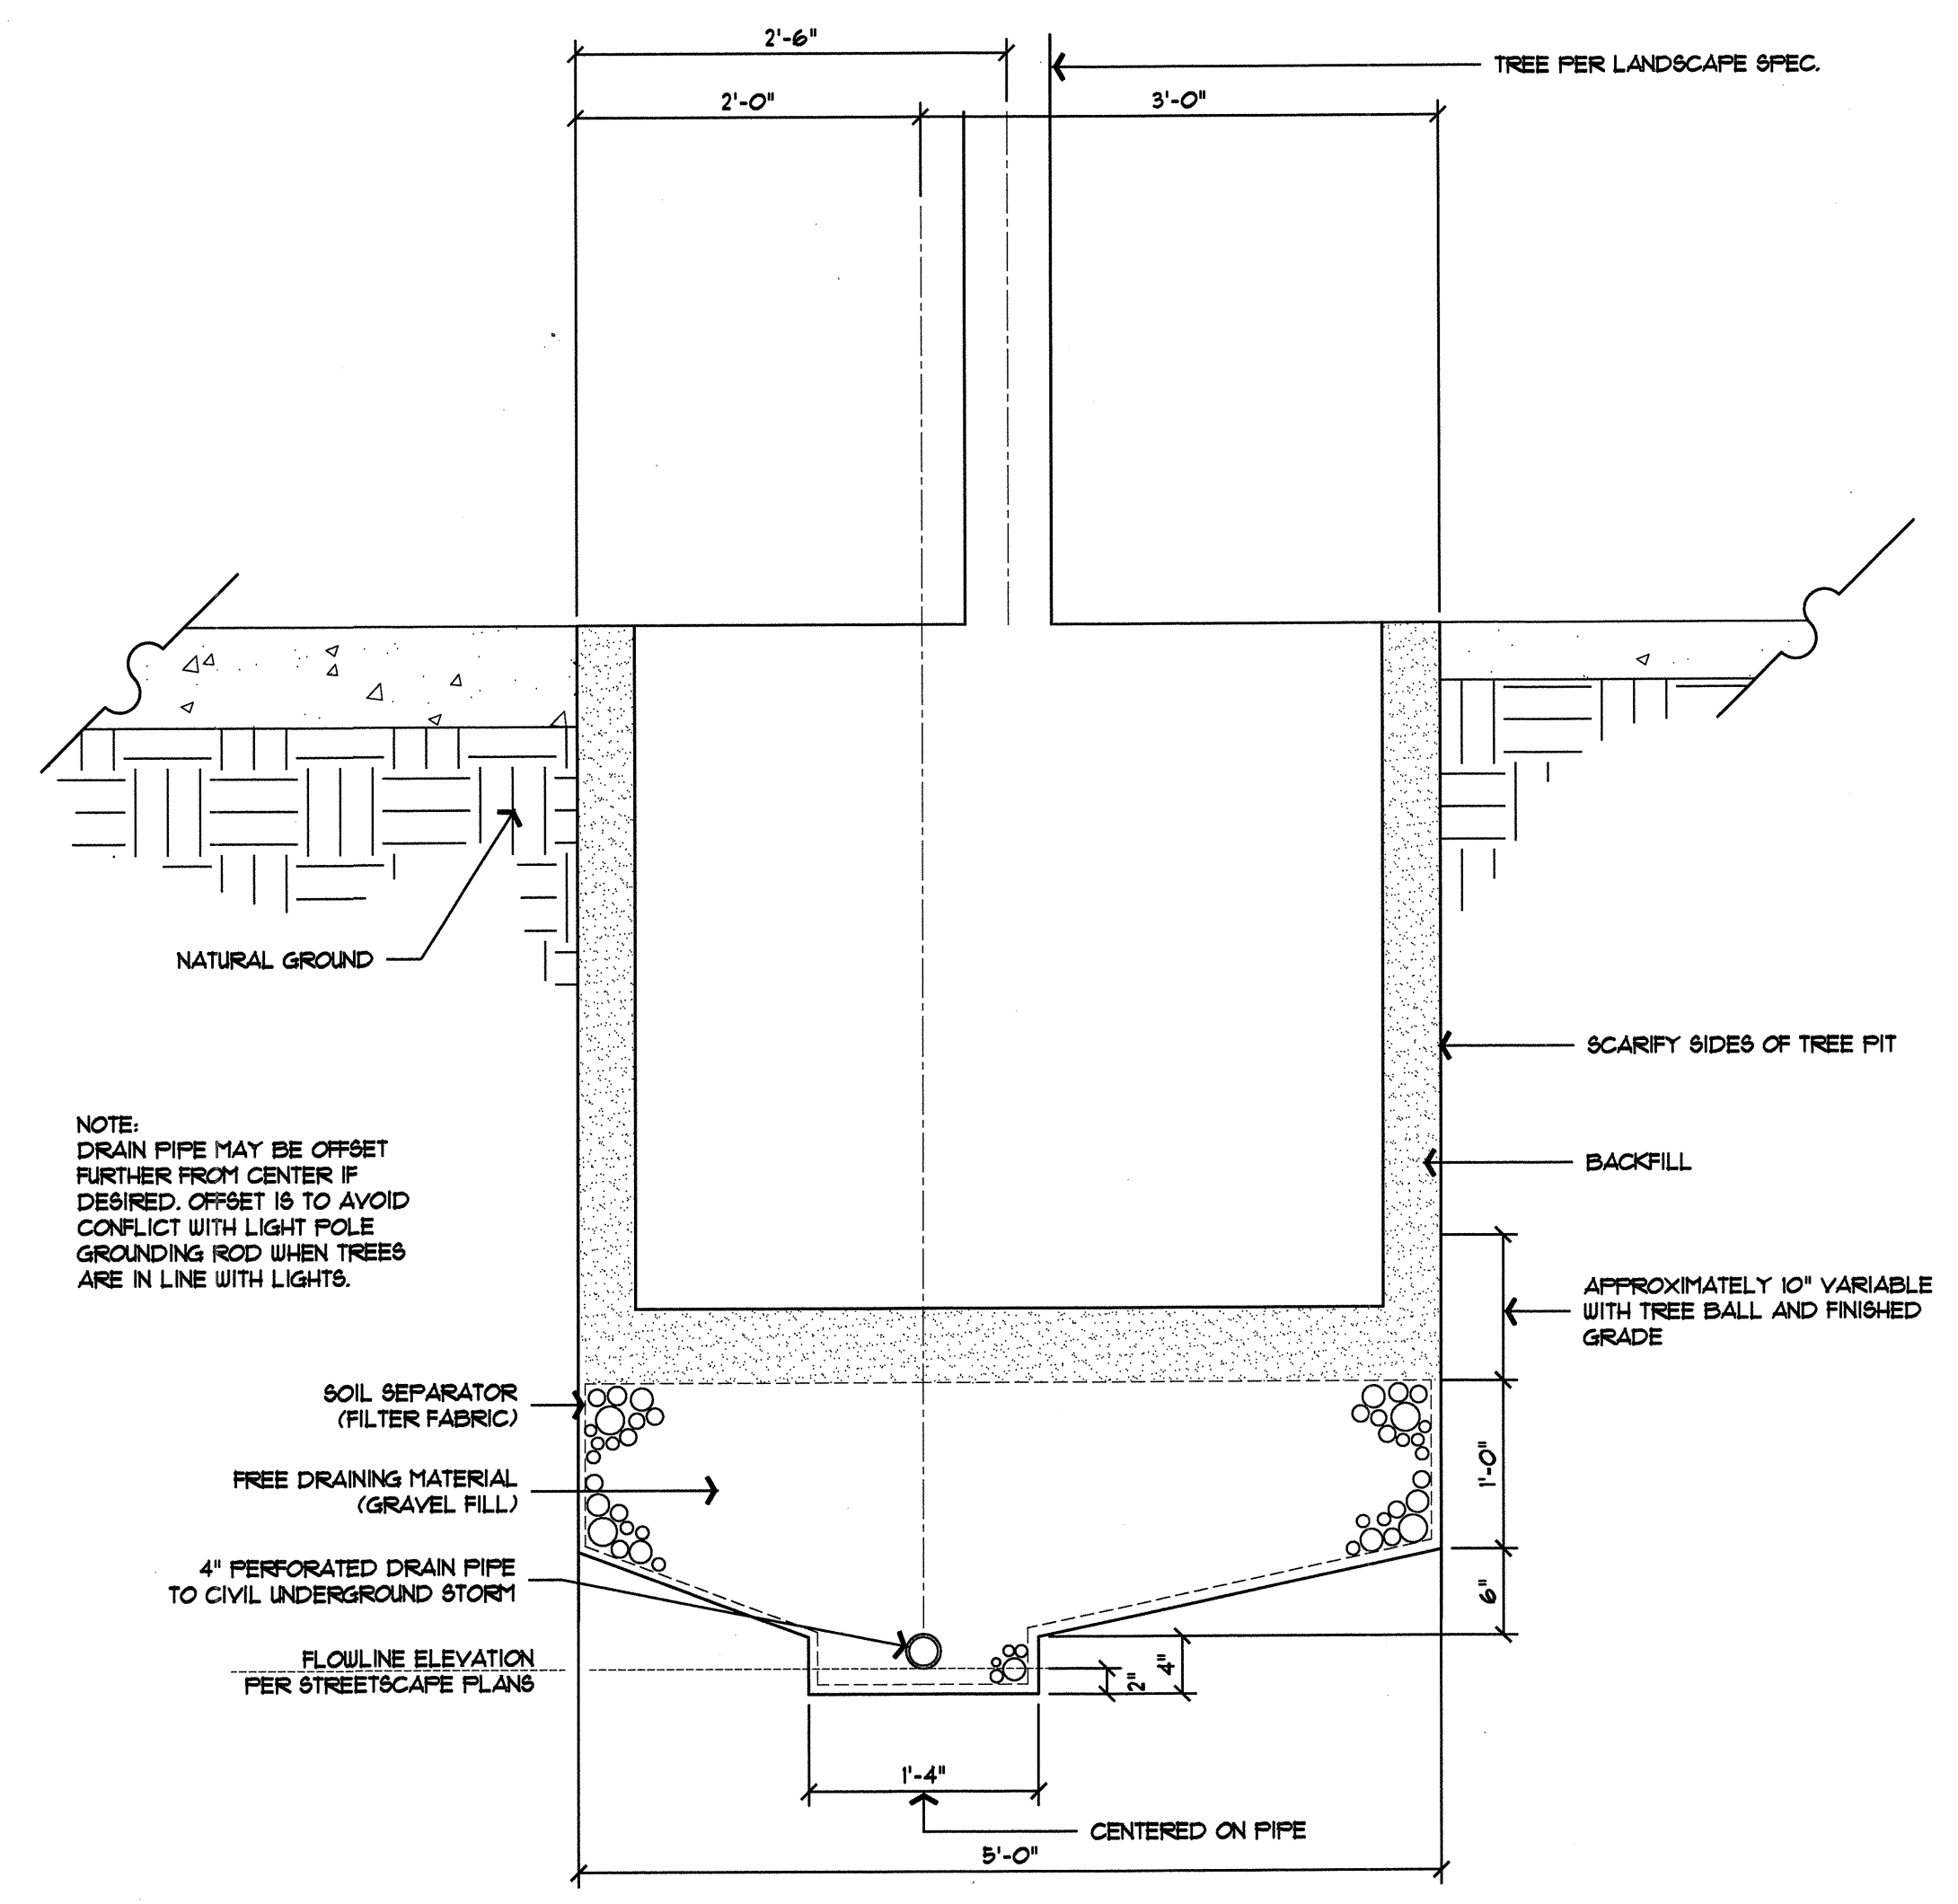

B SUBSURFACE DRAIN SYSTEM DETAIL
(SECTION PERPENDICULAR TO CURB)
1" = 1'-0"

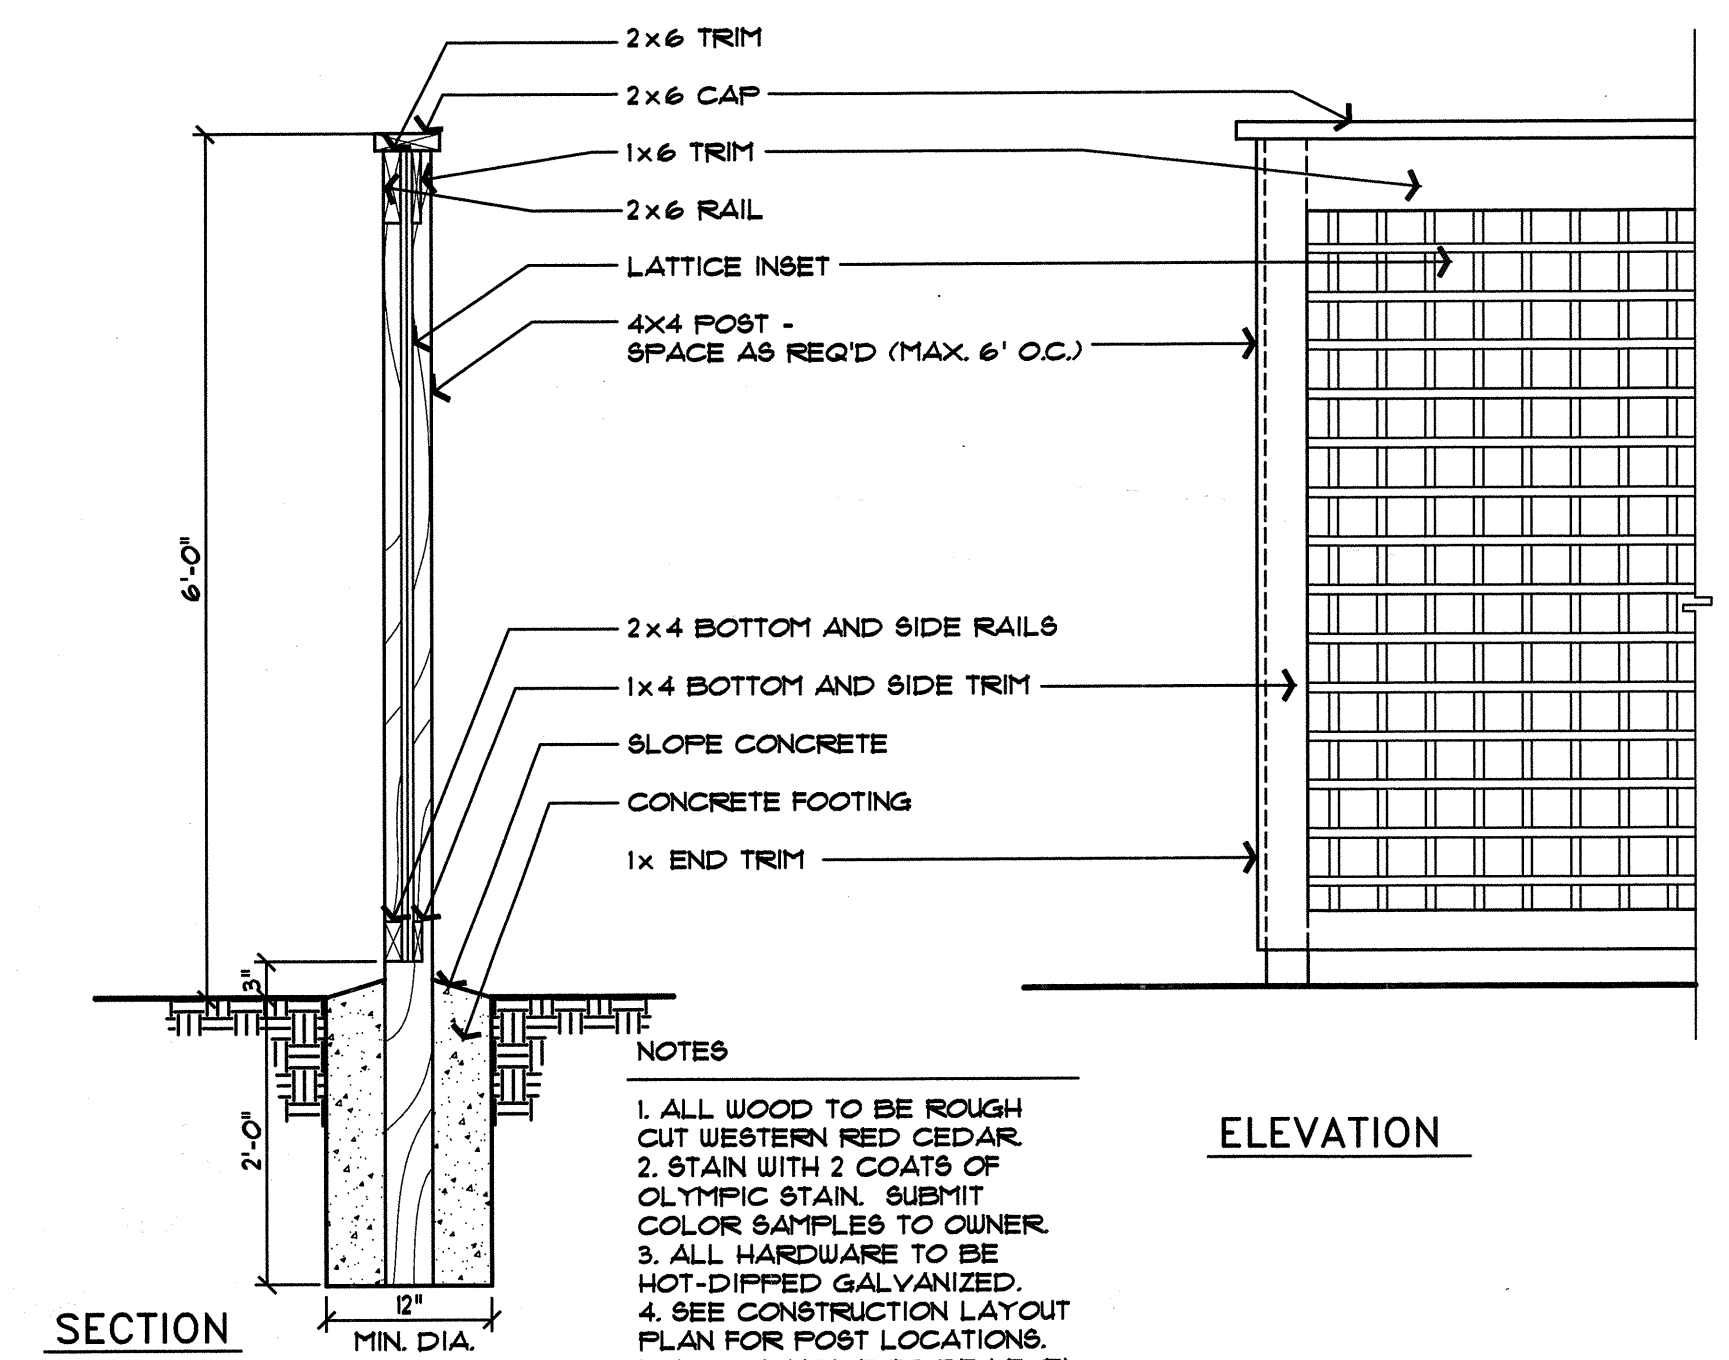

C METER SCREEN
3/4" = 1'-0"

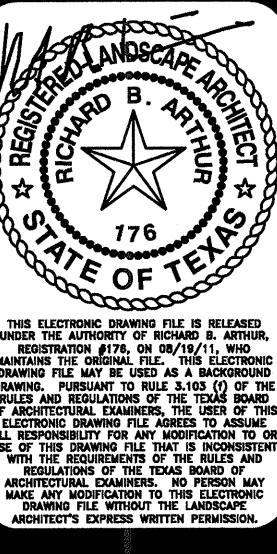

REVISIONS

Keller Springs Lofts
EMBREY PARTNERS, LTD
ADDISON, TEXAS

SCALE
AS NOTED

DATE
19 AUG 2011

TITLE
CONSTRUCTION
DETAILS

SHEET
9C OF 9