

REVISIONS	
1	9-2-2011 DESIGN REVISIONS
2	9-13-2011 ANSI/FHA COMMENTS
3	9-23-2011 DESIGN REVISIONS
4	10-17-2011 CONSTRUCTION ISSUE

KELLER SPRINGS LOFTS

LOFT APARTMENTS IN ADDISON, TEXAS




4144 N. Central Expy.
Suite 855
Dallas, TX 75204
214.520.8878
bgoarchitects.com

DATE
08-05-11


PROJECT
11129

SHEET NUMBER
M-3.0


GARAGE MECHANICAL

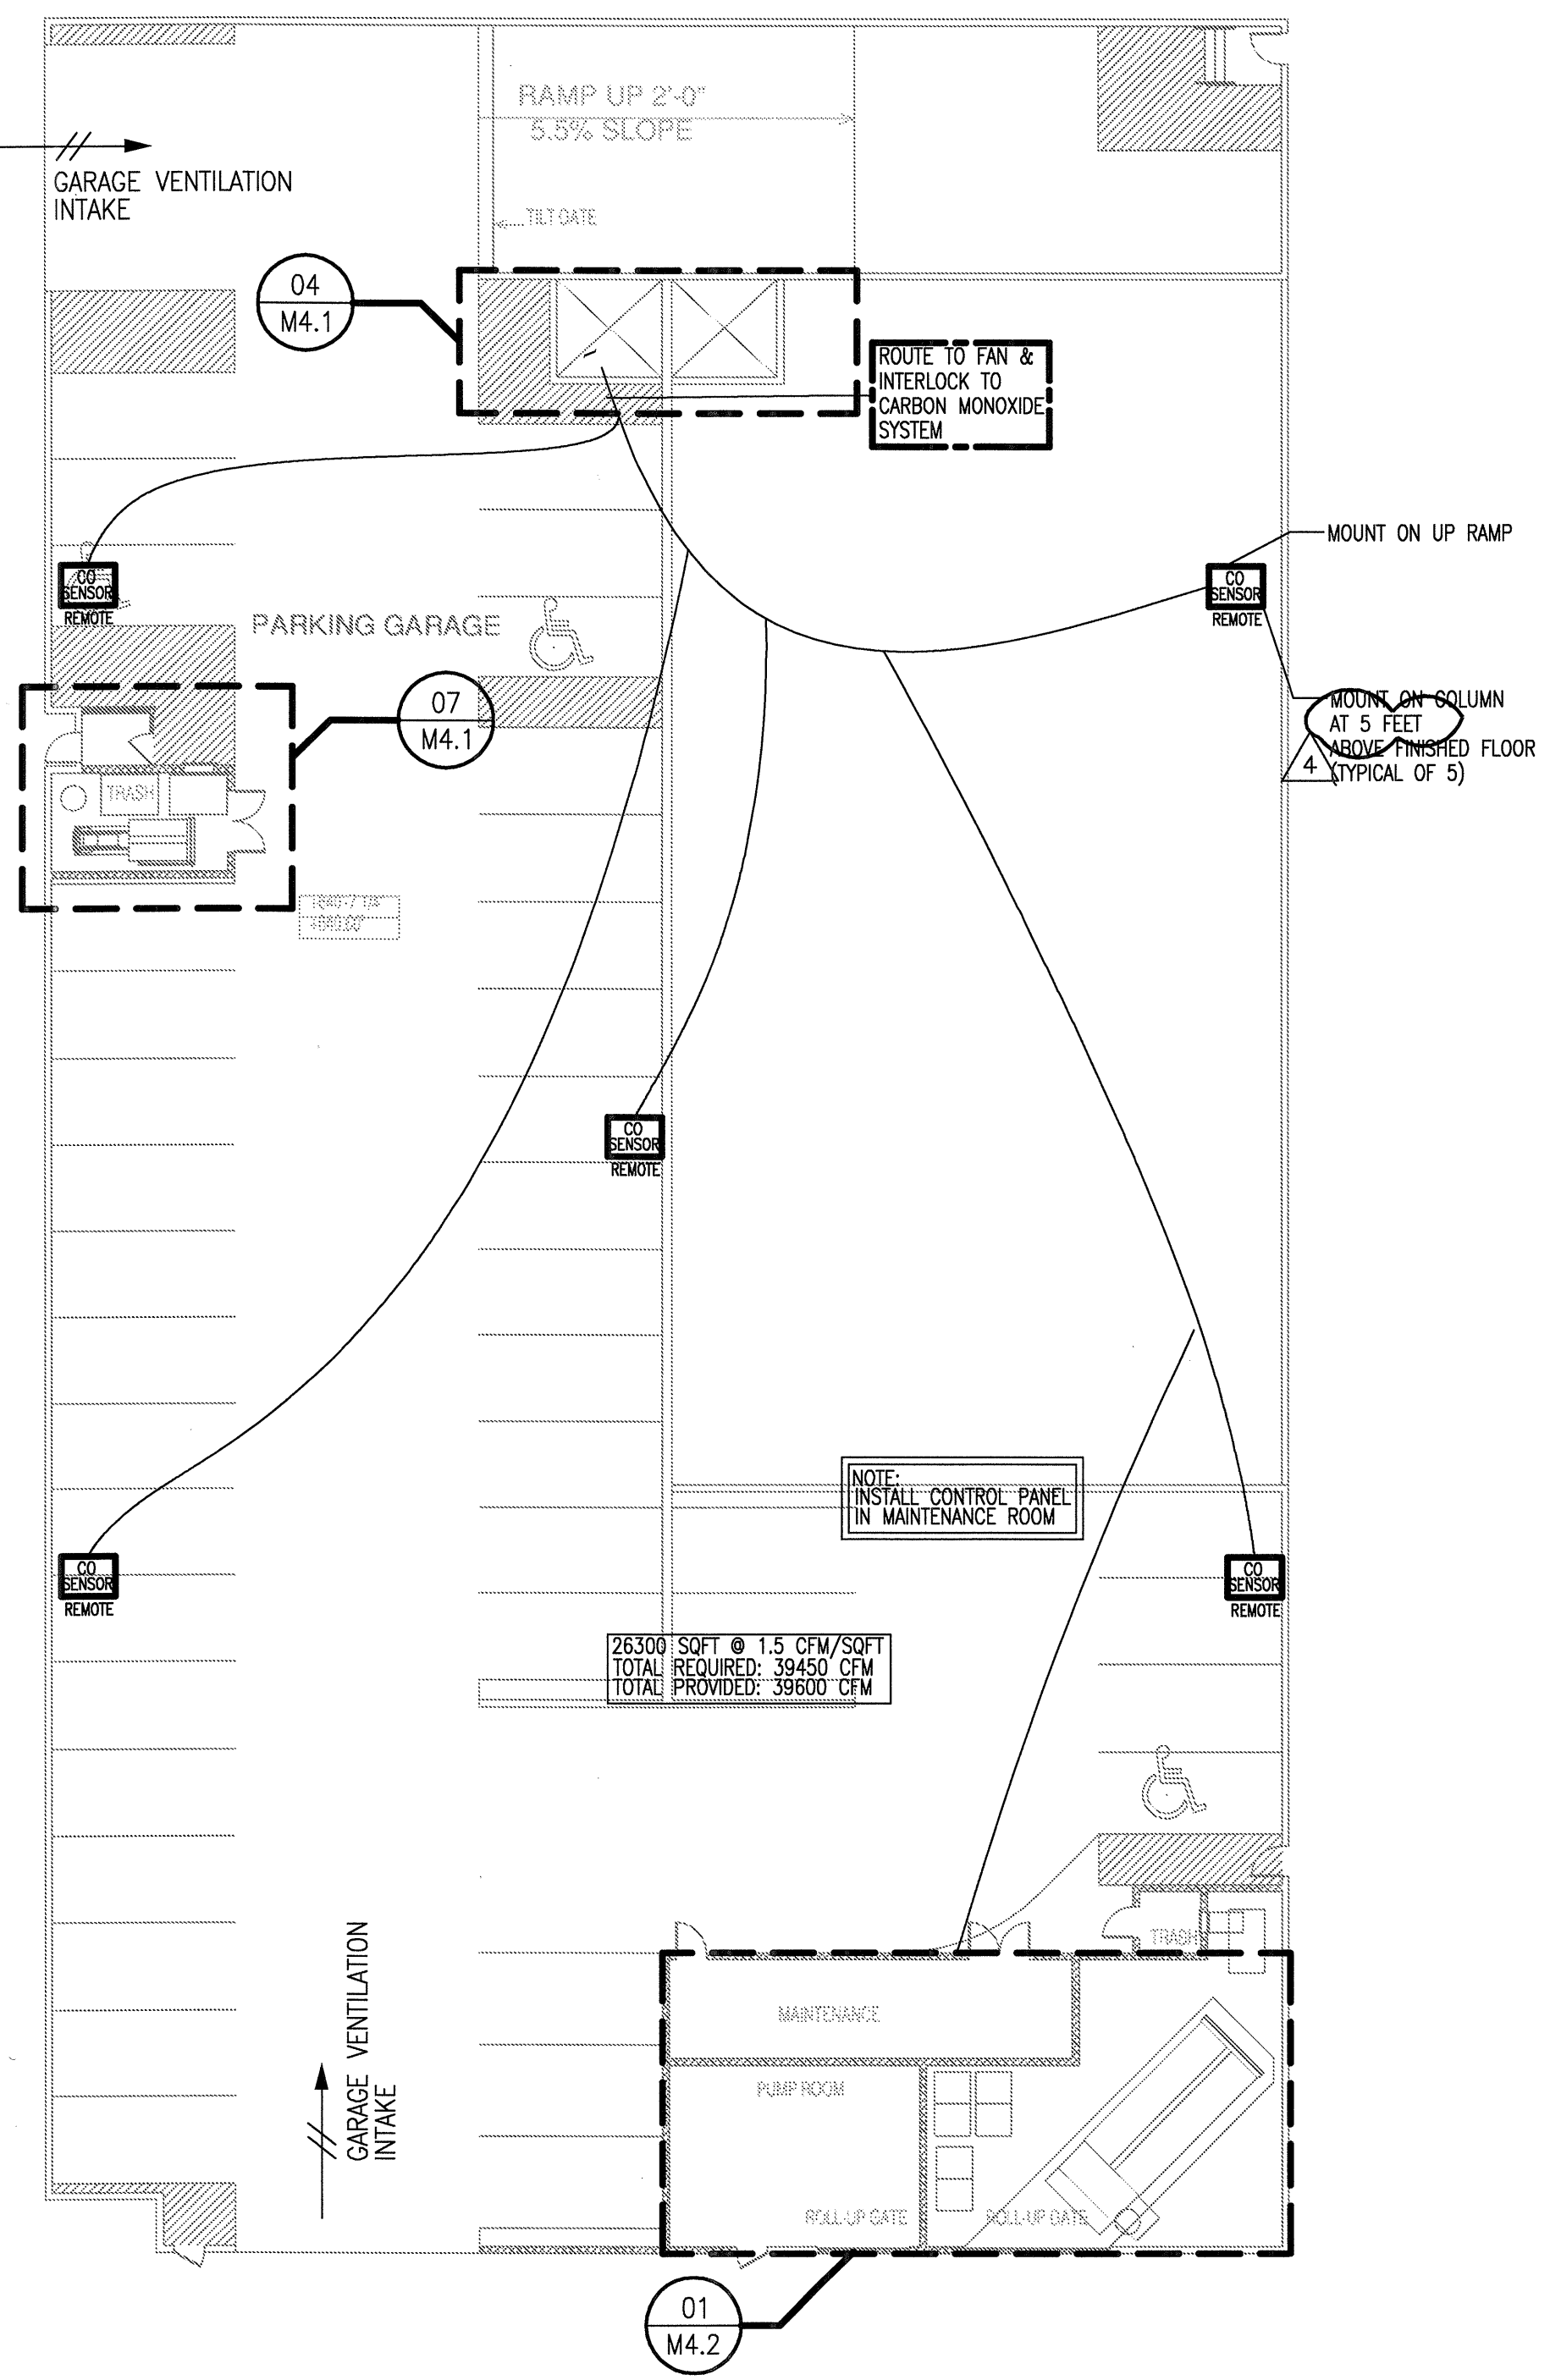

1 1ST FLOOR GARAGE PLAN — MECHANICAL
SCALE: 1/16" = 1'-0"

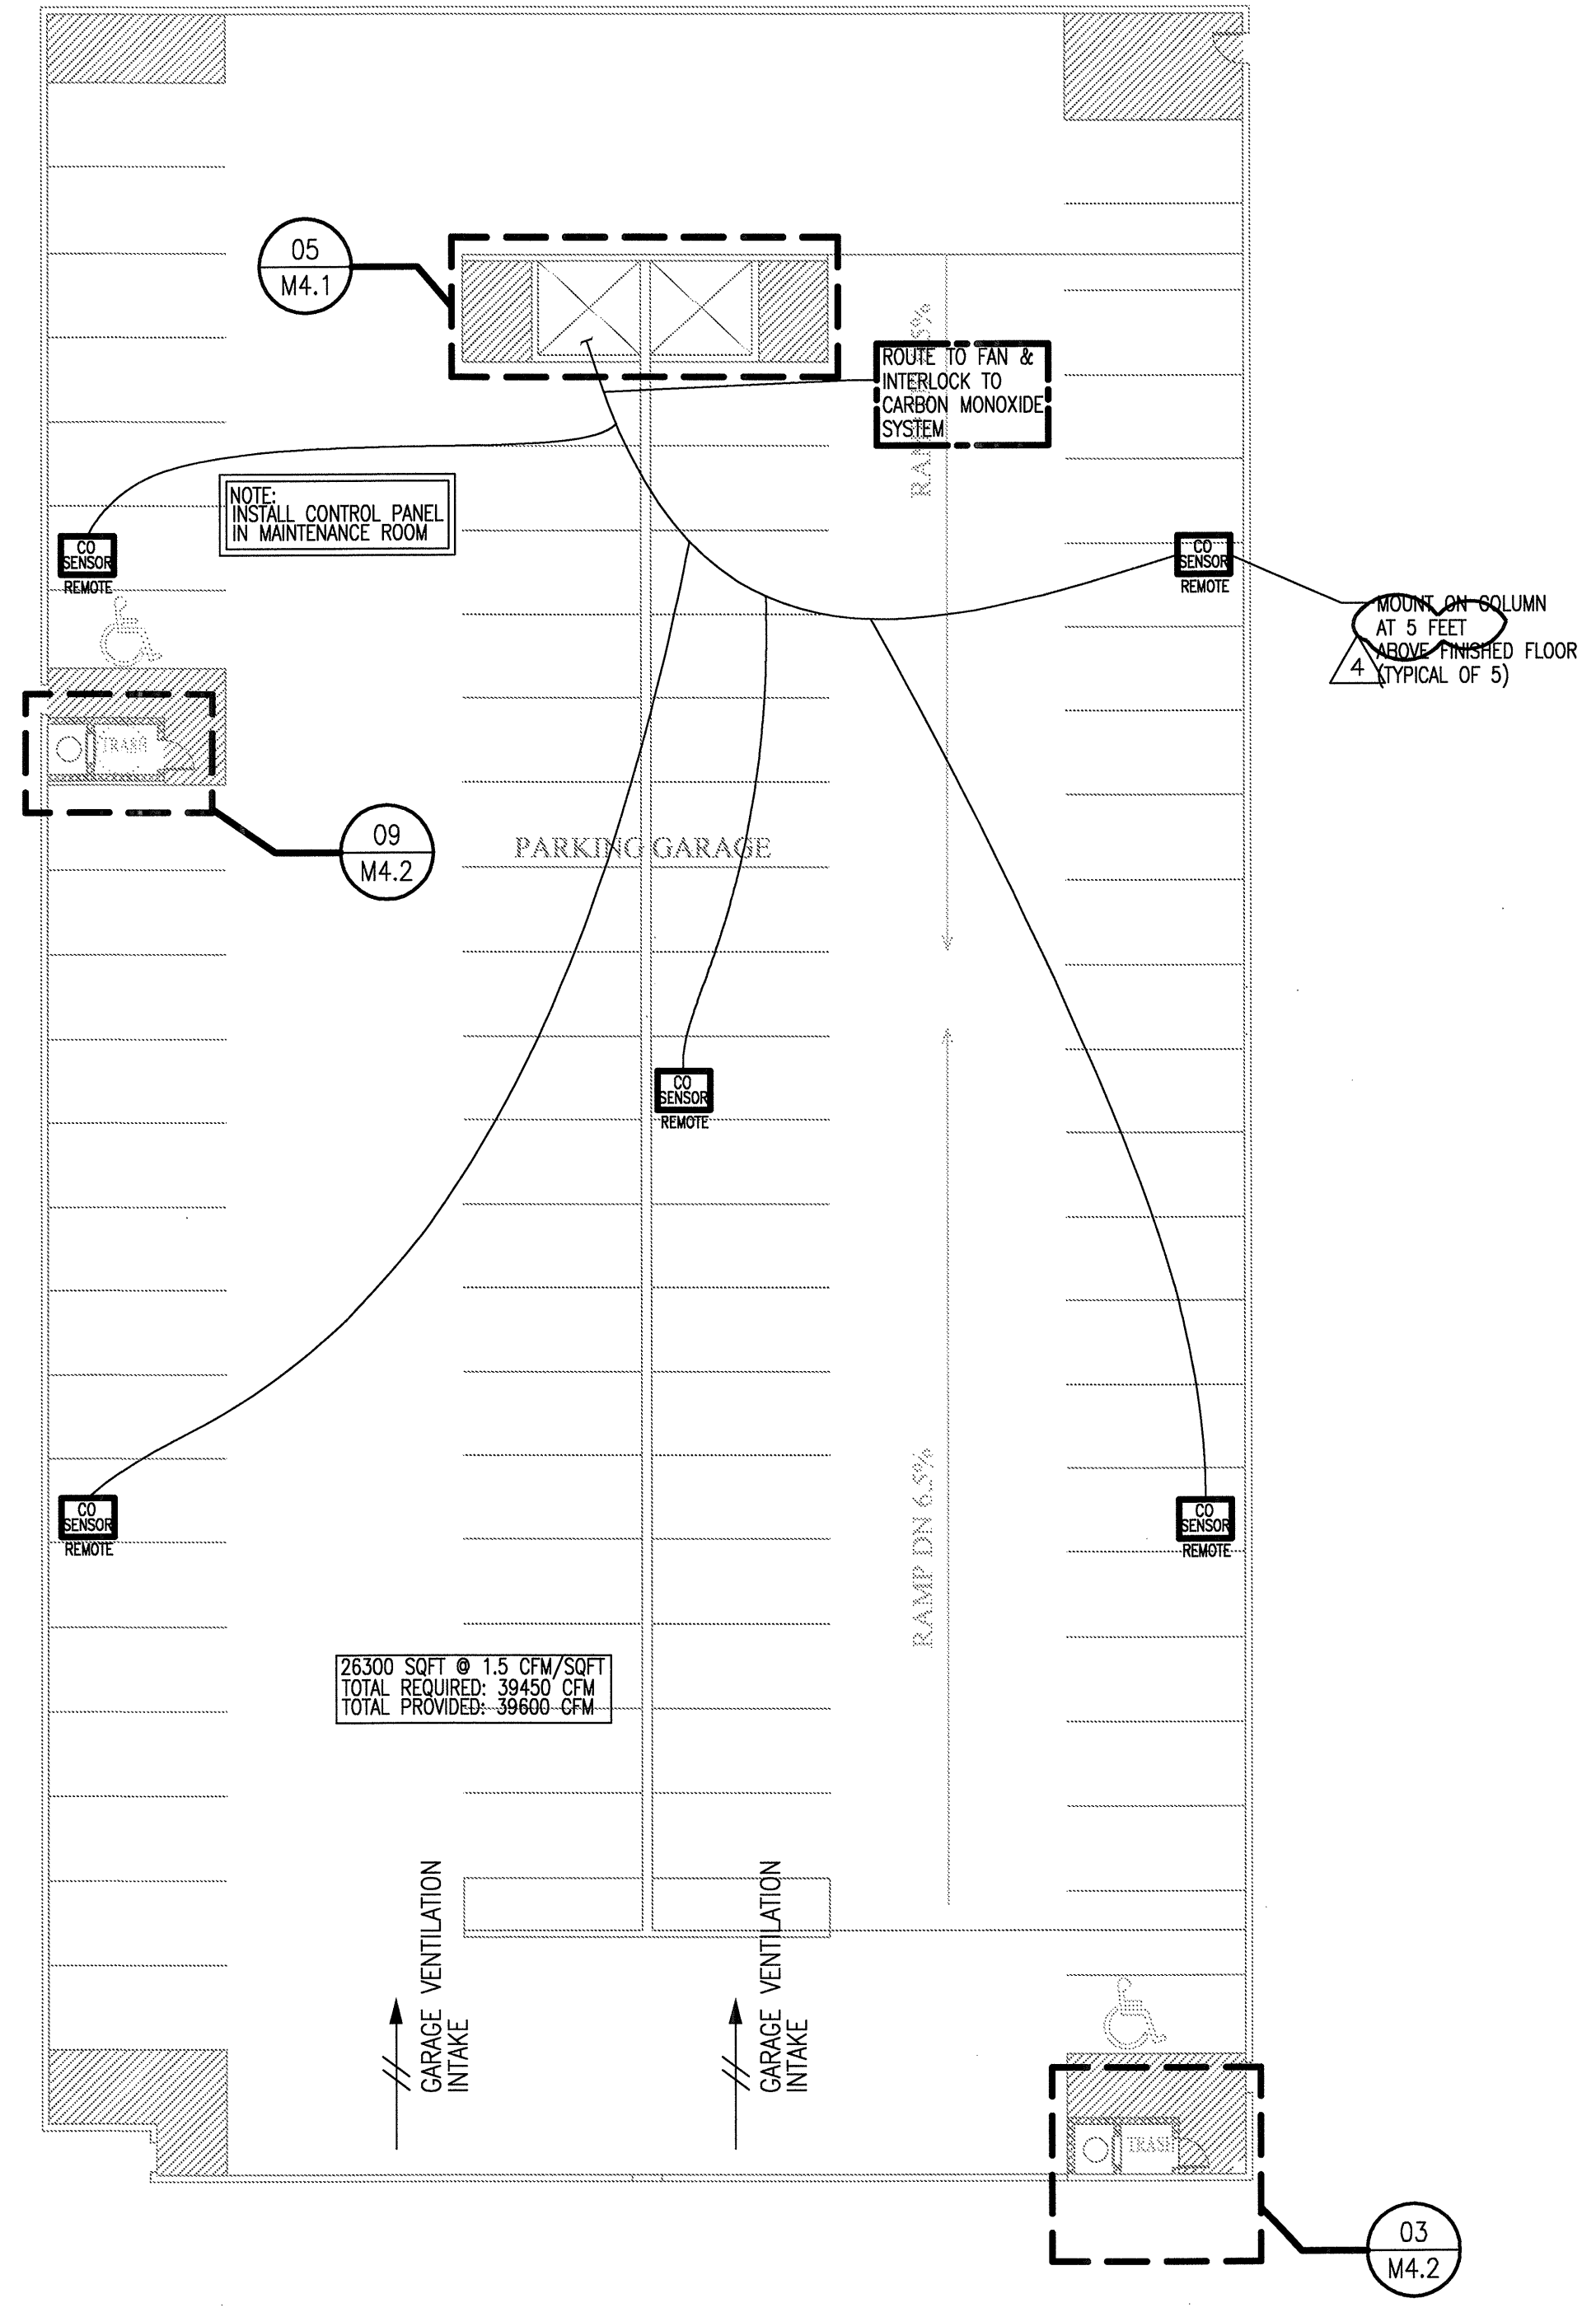

2 2ND FLOOR GARAGE PLAN — MECHANICAL
SCALE: 1/16" = 1'-0"

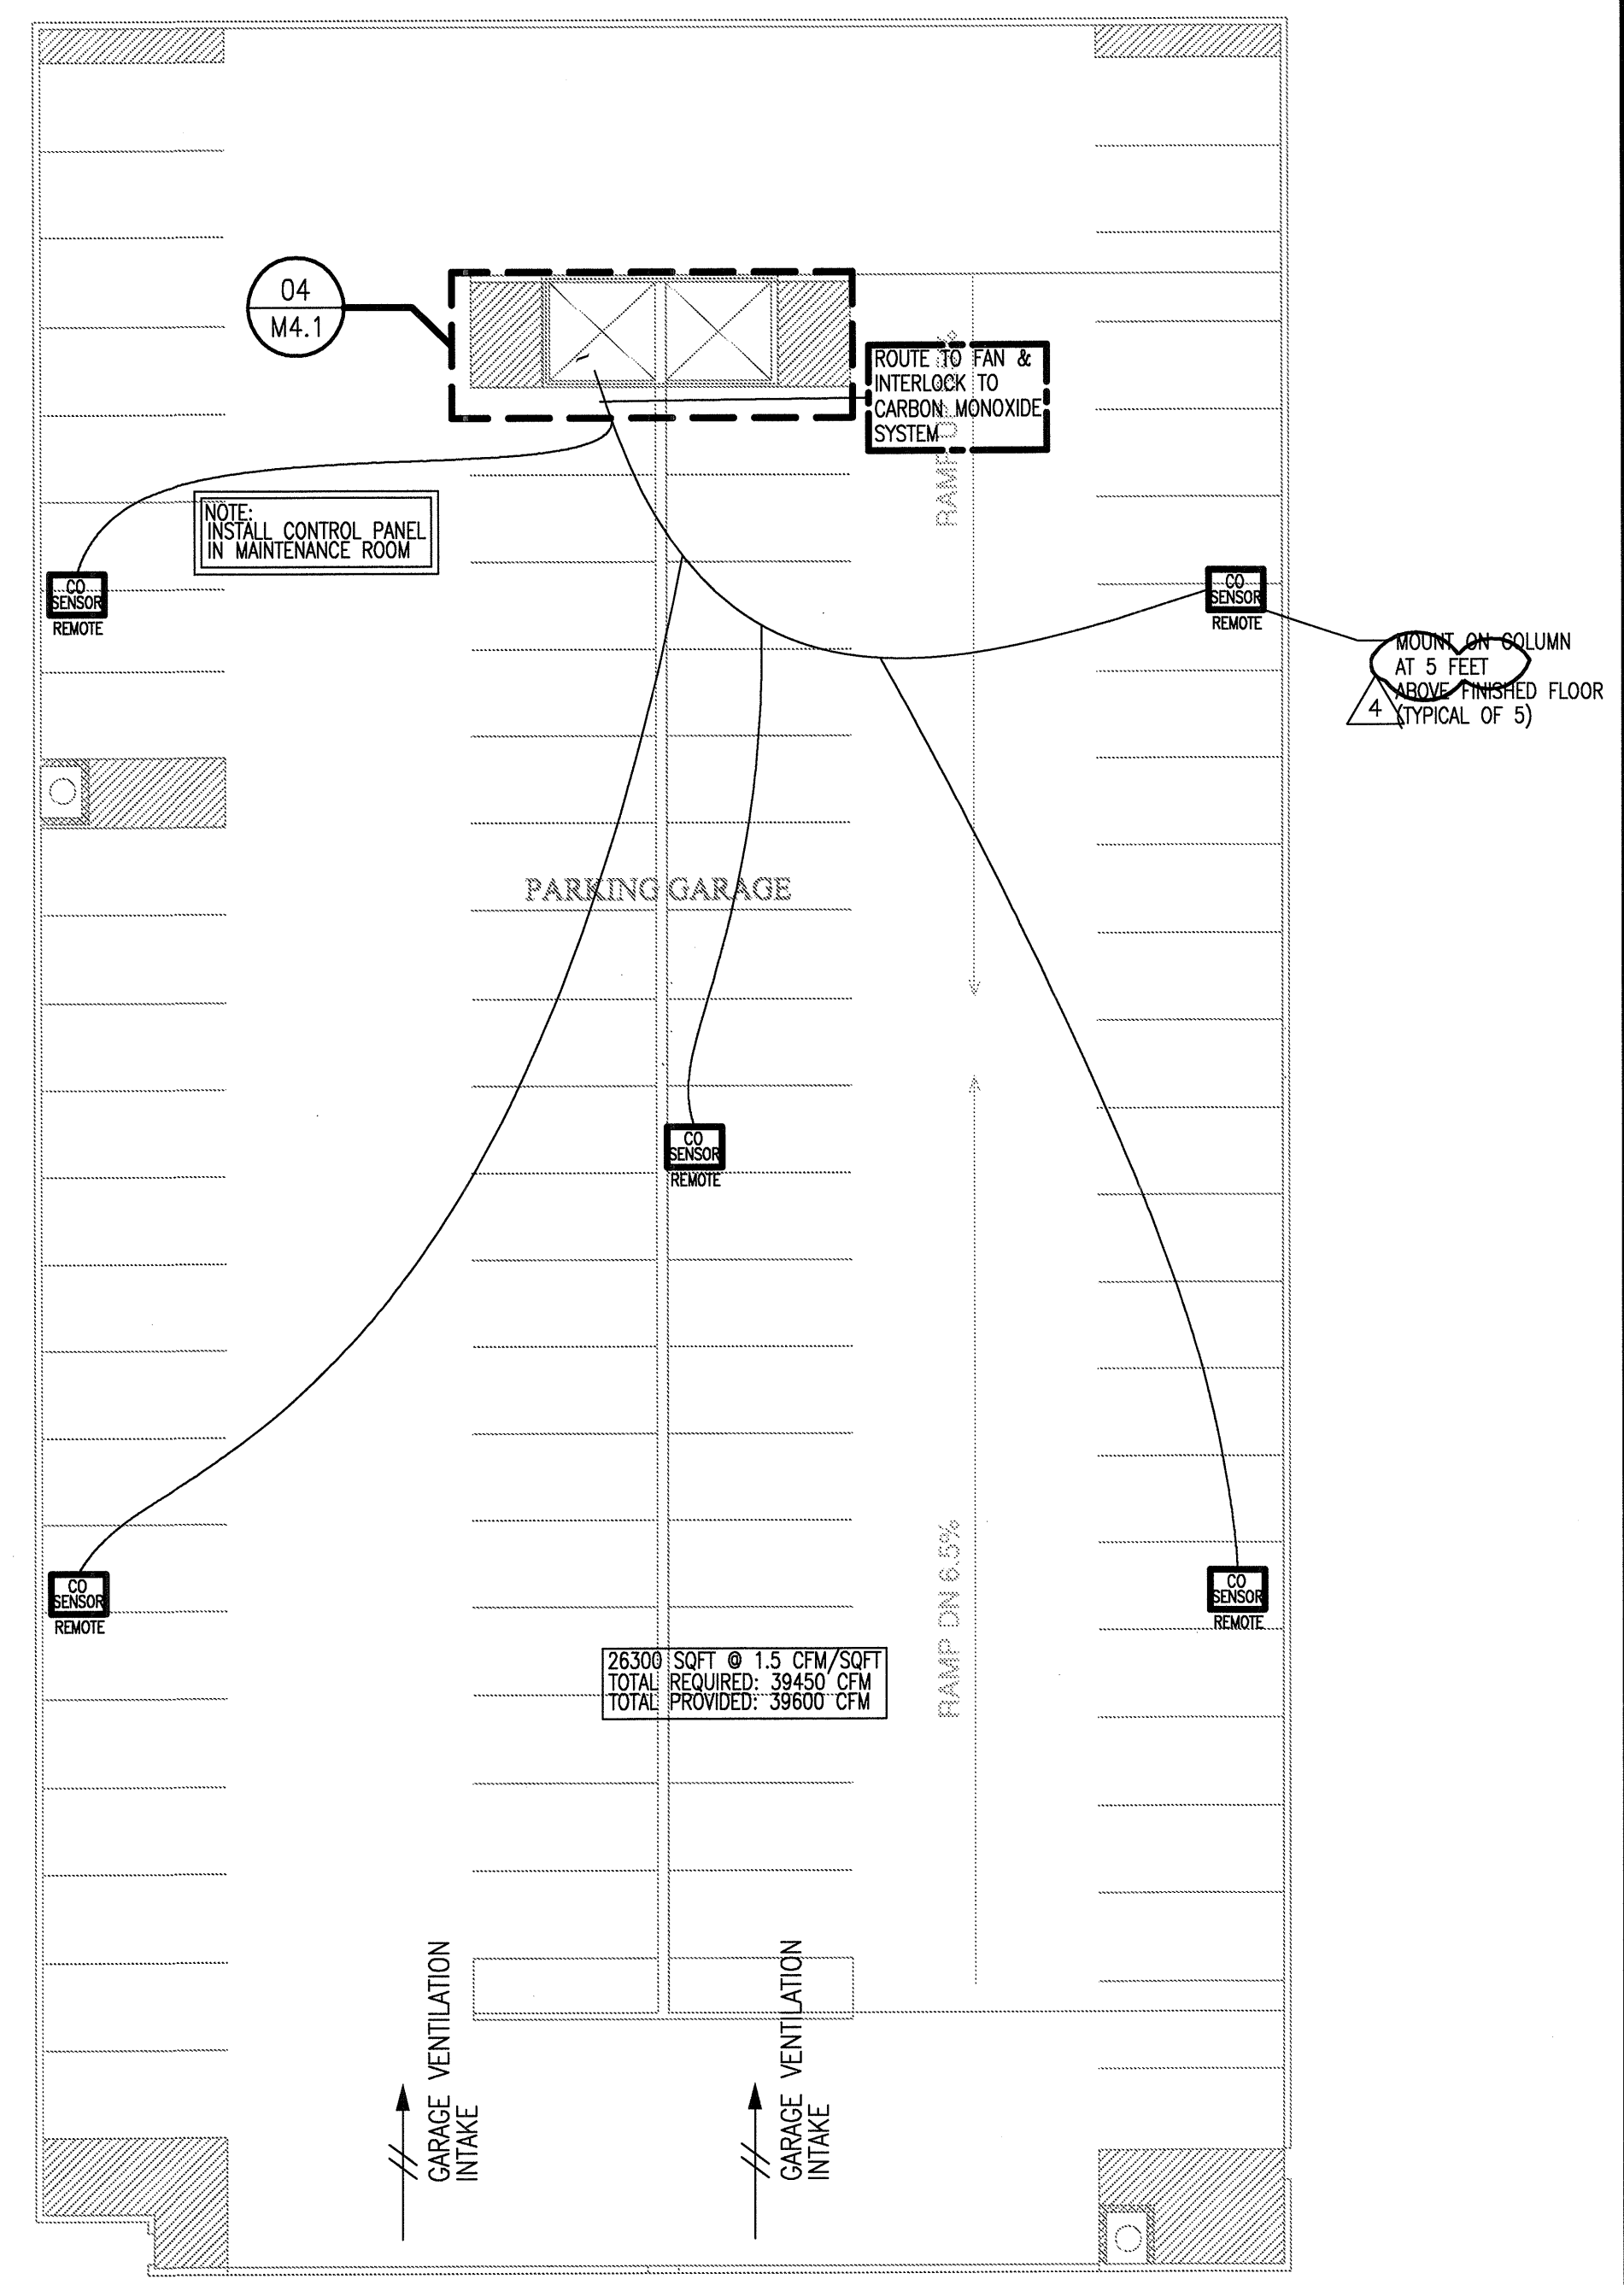

3 3RD FLOOR GARAGE PLAN — MECHANICAL
SCALE: 1/16" = 1'-0"

7th FLOOR IS OPEN ABOVE, NO MECHANICAL VENTING IS REQUIRED.