

REVISIONS

1	9-2-2011	DESIGN REVISIONS
2	9-13-2011	ANSI/FHA COMMENTS
3	9-23-2011	DESIGN REVISIONS
4	10-17-2011	CONSTRUCTION ISSUE
5	12-21-2011	DESIGN REVISIONS
6	1-17-2012	DESIGN REVISIONS
7	2-15-2012	TRANSFORMER REVISIONS
8	3-27-2012	CLUBHOUSE REVISIONS
9	4-17-2012	COORDINATION

**KELLER SPRINGS LOFTS**  
LOFT APARTMENTS IN ADDISON, TEXAS

10	5-15-2012	COORDINATION
11	5-30-2012	SITE COORDINATION
12	6-01-12	LIGHTING REVISIONS
13	6-29-12	SITE COORDINATION
14	9-05-12	CLUB REVISIONS
15	4-19-13	EL. LOBBY REVISIONS




4144 N. Central Expy.  
Suite 855  
Dallas, TX 75204  
214-520-8878  
bgoarchitects.com

DATE  
08-05-11

PROJECT  
11129

SHEET NUMBER  
**M-3.2**  
SECOND FLOOR  
BUILDING  
MECHANICAL

**JSE** Jordan & Skala Engineers  
17855 N. Dallas Parkway, Suite 320  
Dallas, TX 75247-6657  
V: (469) 385-1516 F: (469) 385-1615  
Project Number - 113-0355 Texas Firm Registration # F-4990  
Drawn By: CJH Checked By: AHS

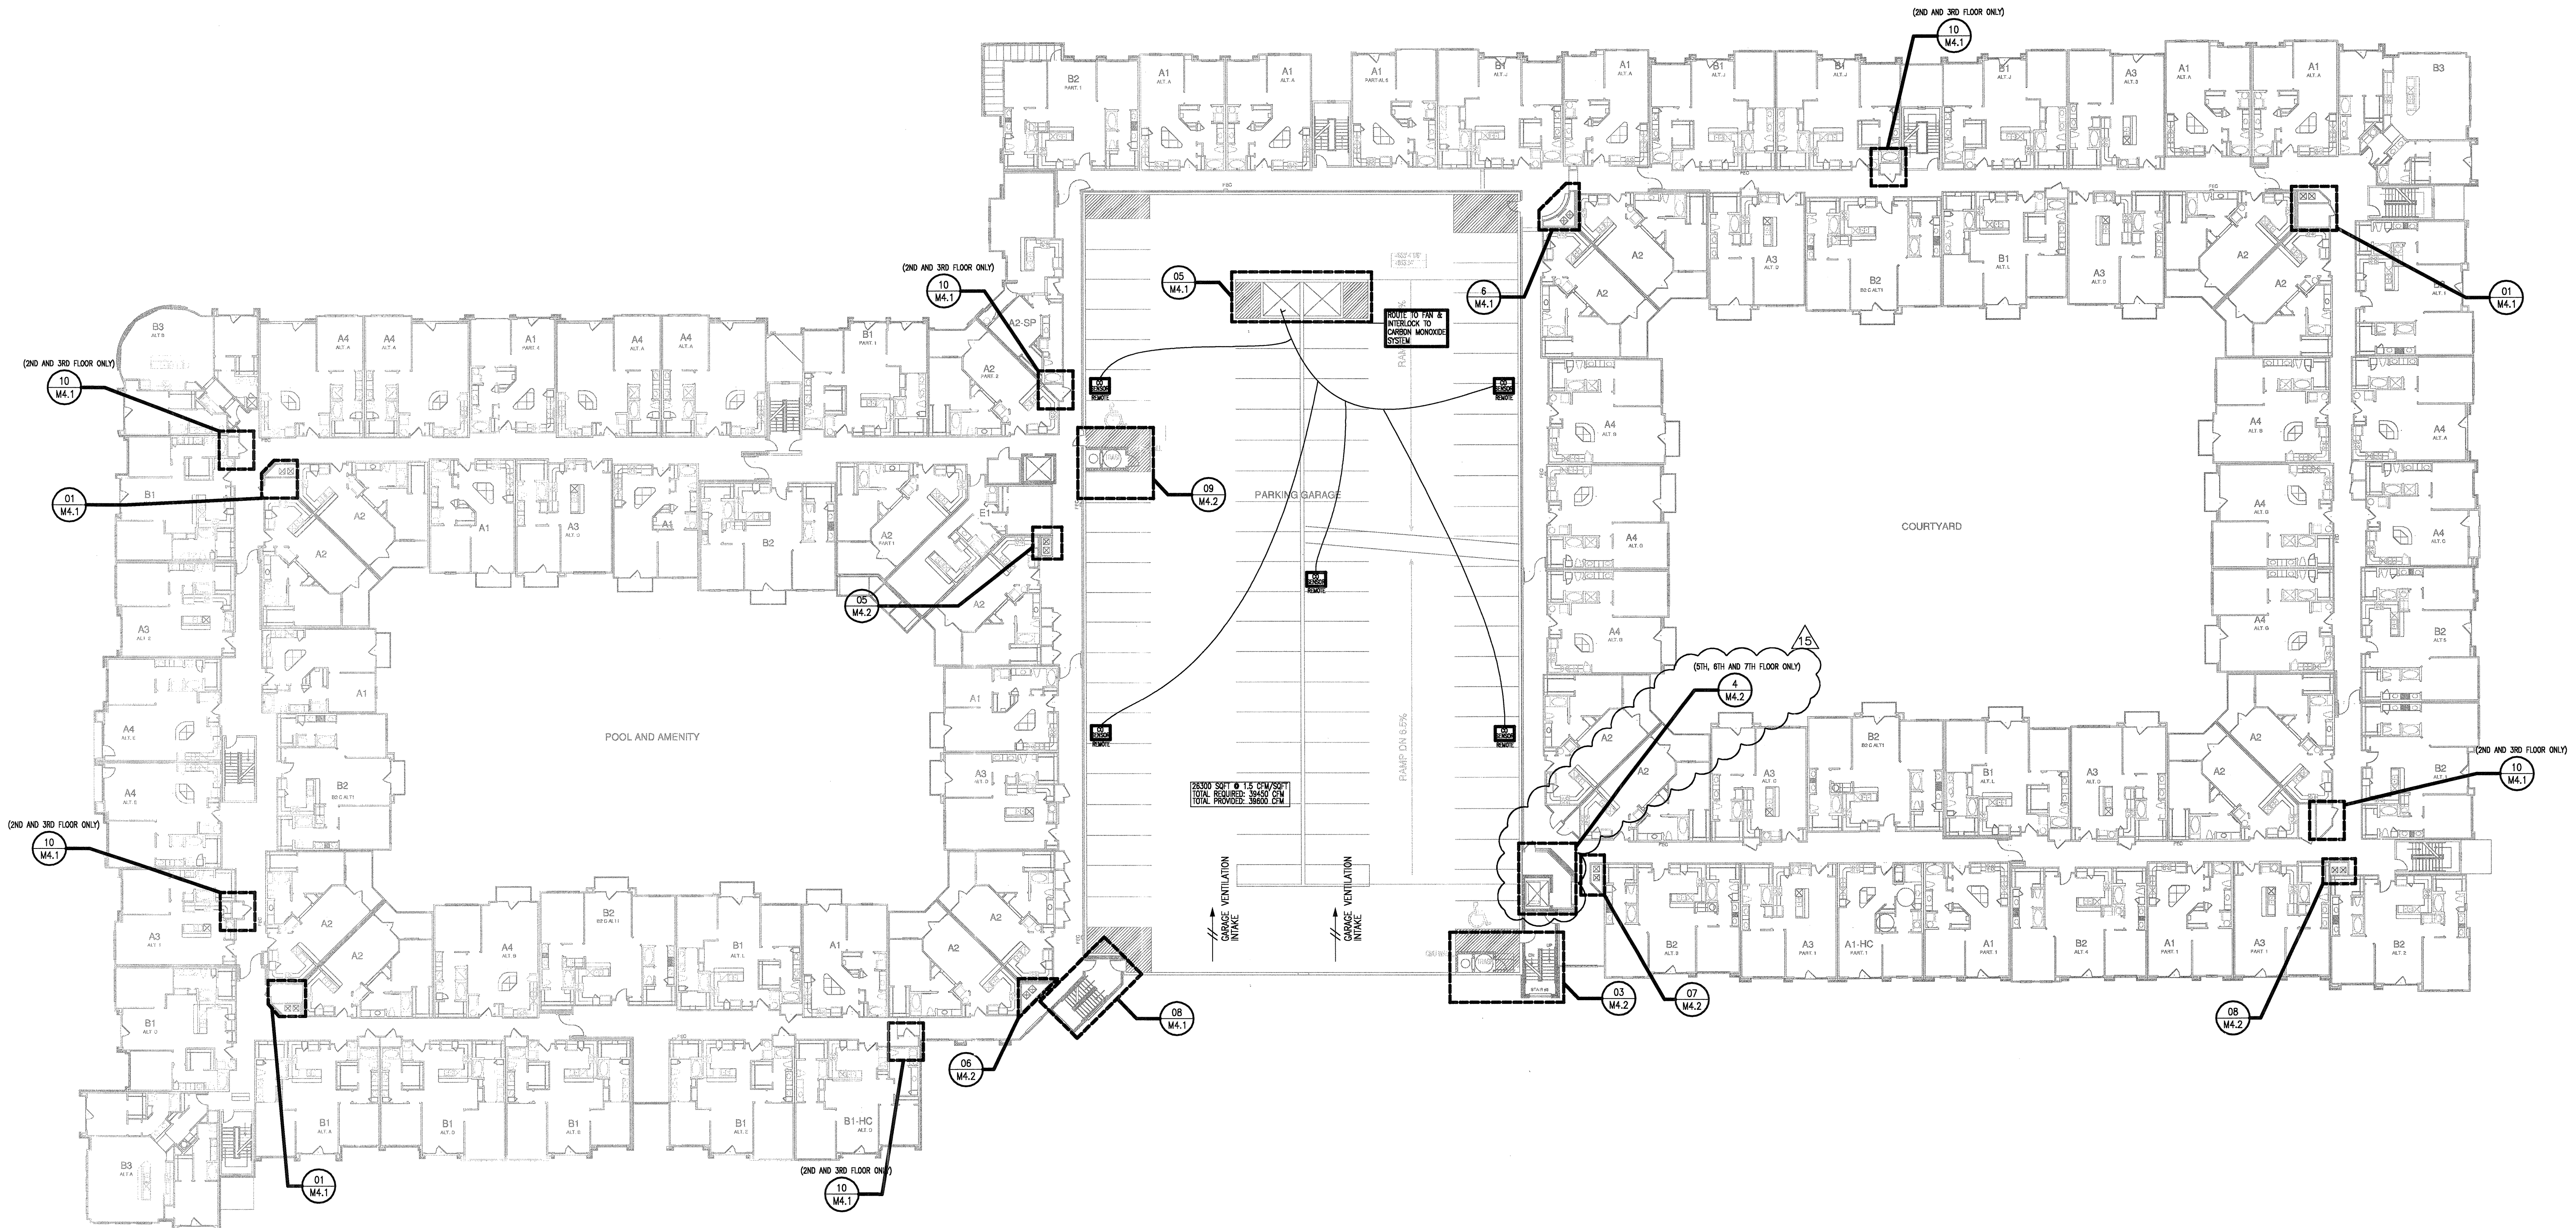

1 OVERALL SECOND-FOURTH FLOOR PLAN  
SCALE: NOT TO SCALE