


PARKING GARAGE

RAMP DN 6.5%

KEYNOTES:

- 1. ROUTE 1" CONDENSATE DRAIN TO HUB DRAIN BELOW ROOF. SEE PLUMBING PLANS FOR EXACT LOCATIONS
 - 2. ALL OUTSIDE AIR INTAKES SHALL MAINTAIN 10'-0" FROM EXHAUST TERMINATIONS AND PLUMBING VENTS.
- NOTES:**
- 1. INSTALL CONDENSERS ON CURB (BY OTHERS).
 - 2. THERE SHALL BE NO ROOF PENETRATIONS WITHIN 4'-0" OF A FIREWALL.
 - 3. COORDINATE REFRIGERANT LINES/ET HOODS AND LINES/ET ROUTING PRIOR TO CONSTRUCTION.
 - 4. ALL EQUIPMENT INSTALLED WITHIN 10'-0" OF A ROOF EDGE SHALL HAVE GUARDS TO COMPLY WITH 2009 IMC SECTION 304.11.

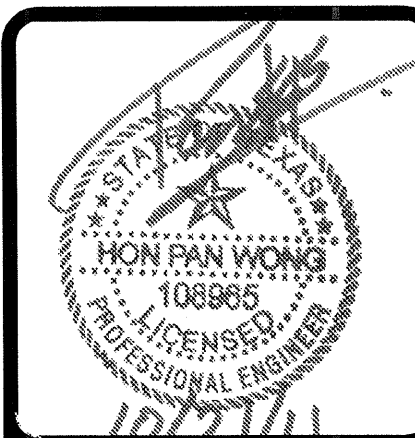

REVISIONS

1	9-2-2011	DESIGN REVISIONS
2	9-13-2011	ANSI/FHA COMMENTS
3	9-23-2011	DESIGN REVISIONS
4	10-17-2011	CONSTRUCTION ISSUE

KELLER SPRINGS LOFTS
 LOFT APARTMENTS IN ADDISON, TEXAS




4144 N. Central Expy.
 Suite 855
 Dallas, TX 75204
 214.520.8878
 bgoarchitects.com

DATE
 08-05-11

PROJECT
 11129

SHEET NUMBER
M-3.5D
 ROOF PLAN
 DIVISION D
 MECHANICAL

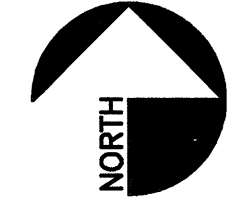

1 DIVISION 'D' ROOF PLAN
 SCALE: 1/8" = 1'-0"

1/2" MC VENT INTAKE HOODS.
 BY ROOFING CONTRACTOR.

ON A
 ON B

