

REVISIONS	
1	9-2-2011 DESIGN REVISIONS
2	9-13-2011 ANSI/FHA COMMENTS
3	9-23-2011 DESIGN REVISIONS
4	10-17-2011 CONSTRUCTION ISSUE

KELLER SPRINGS LOFTS
 LOFT APARTMENTS IN ADDISON, TEXAS


BGO architects
 4144 N. Central Expy.
 Suite 855
 Dallas, TX 75204
 214.520.8878
 bgoarchitects.com

DATE
 08-05-11

PROJECT
 11129


SHEET NUMBER
M-3.5E
 ROOF PLAN
 DIVISION E
 MECHANICAL

JSE Jordan & Skala Engineers
 14240 Midway Road, Suite 350
 Dallas, TX 75244-5138
 Tel: (469) 385-1616 Fax: (469) 385-1615
 Project Number - 113-0355 Texas Firm Registration # F-4990
 Drawn By: CJH Checked By: AHS

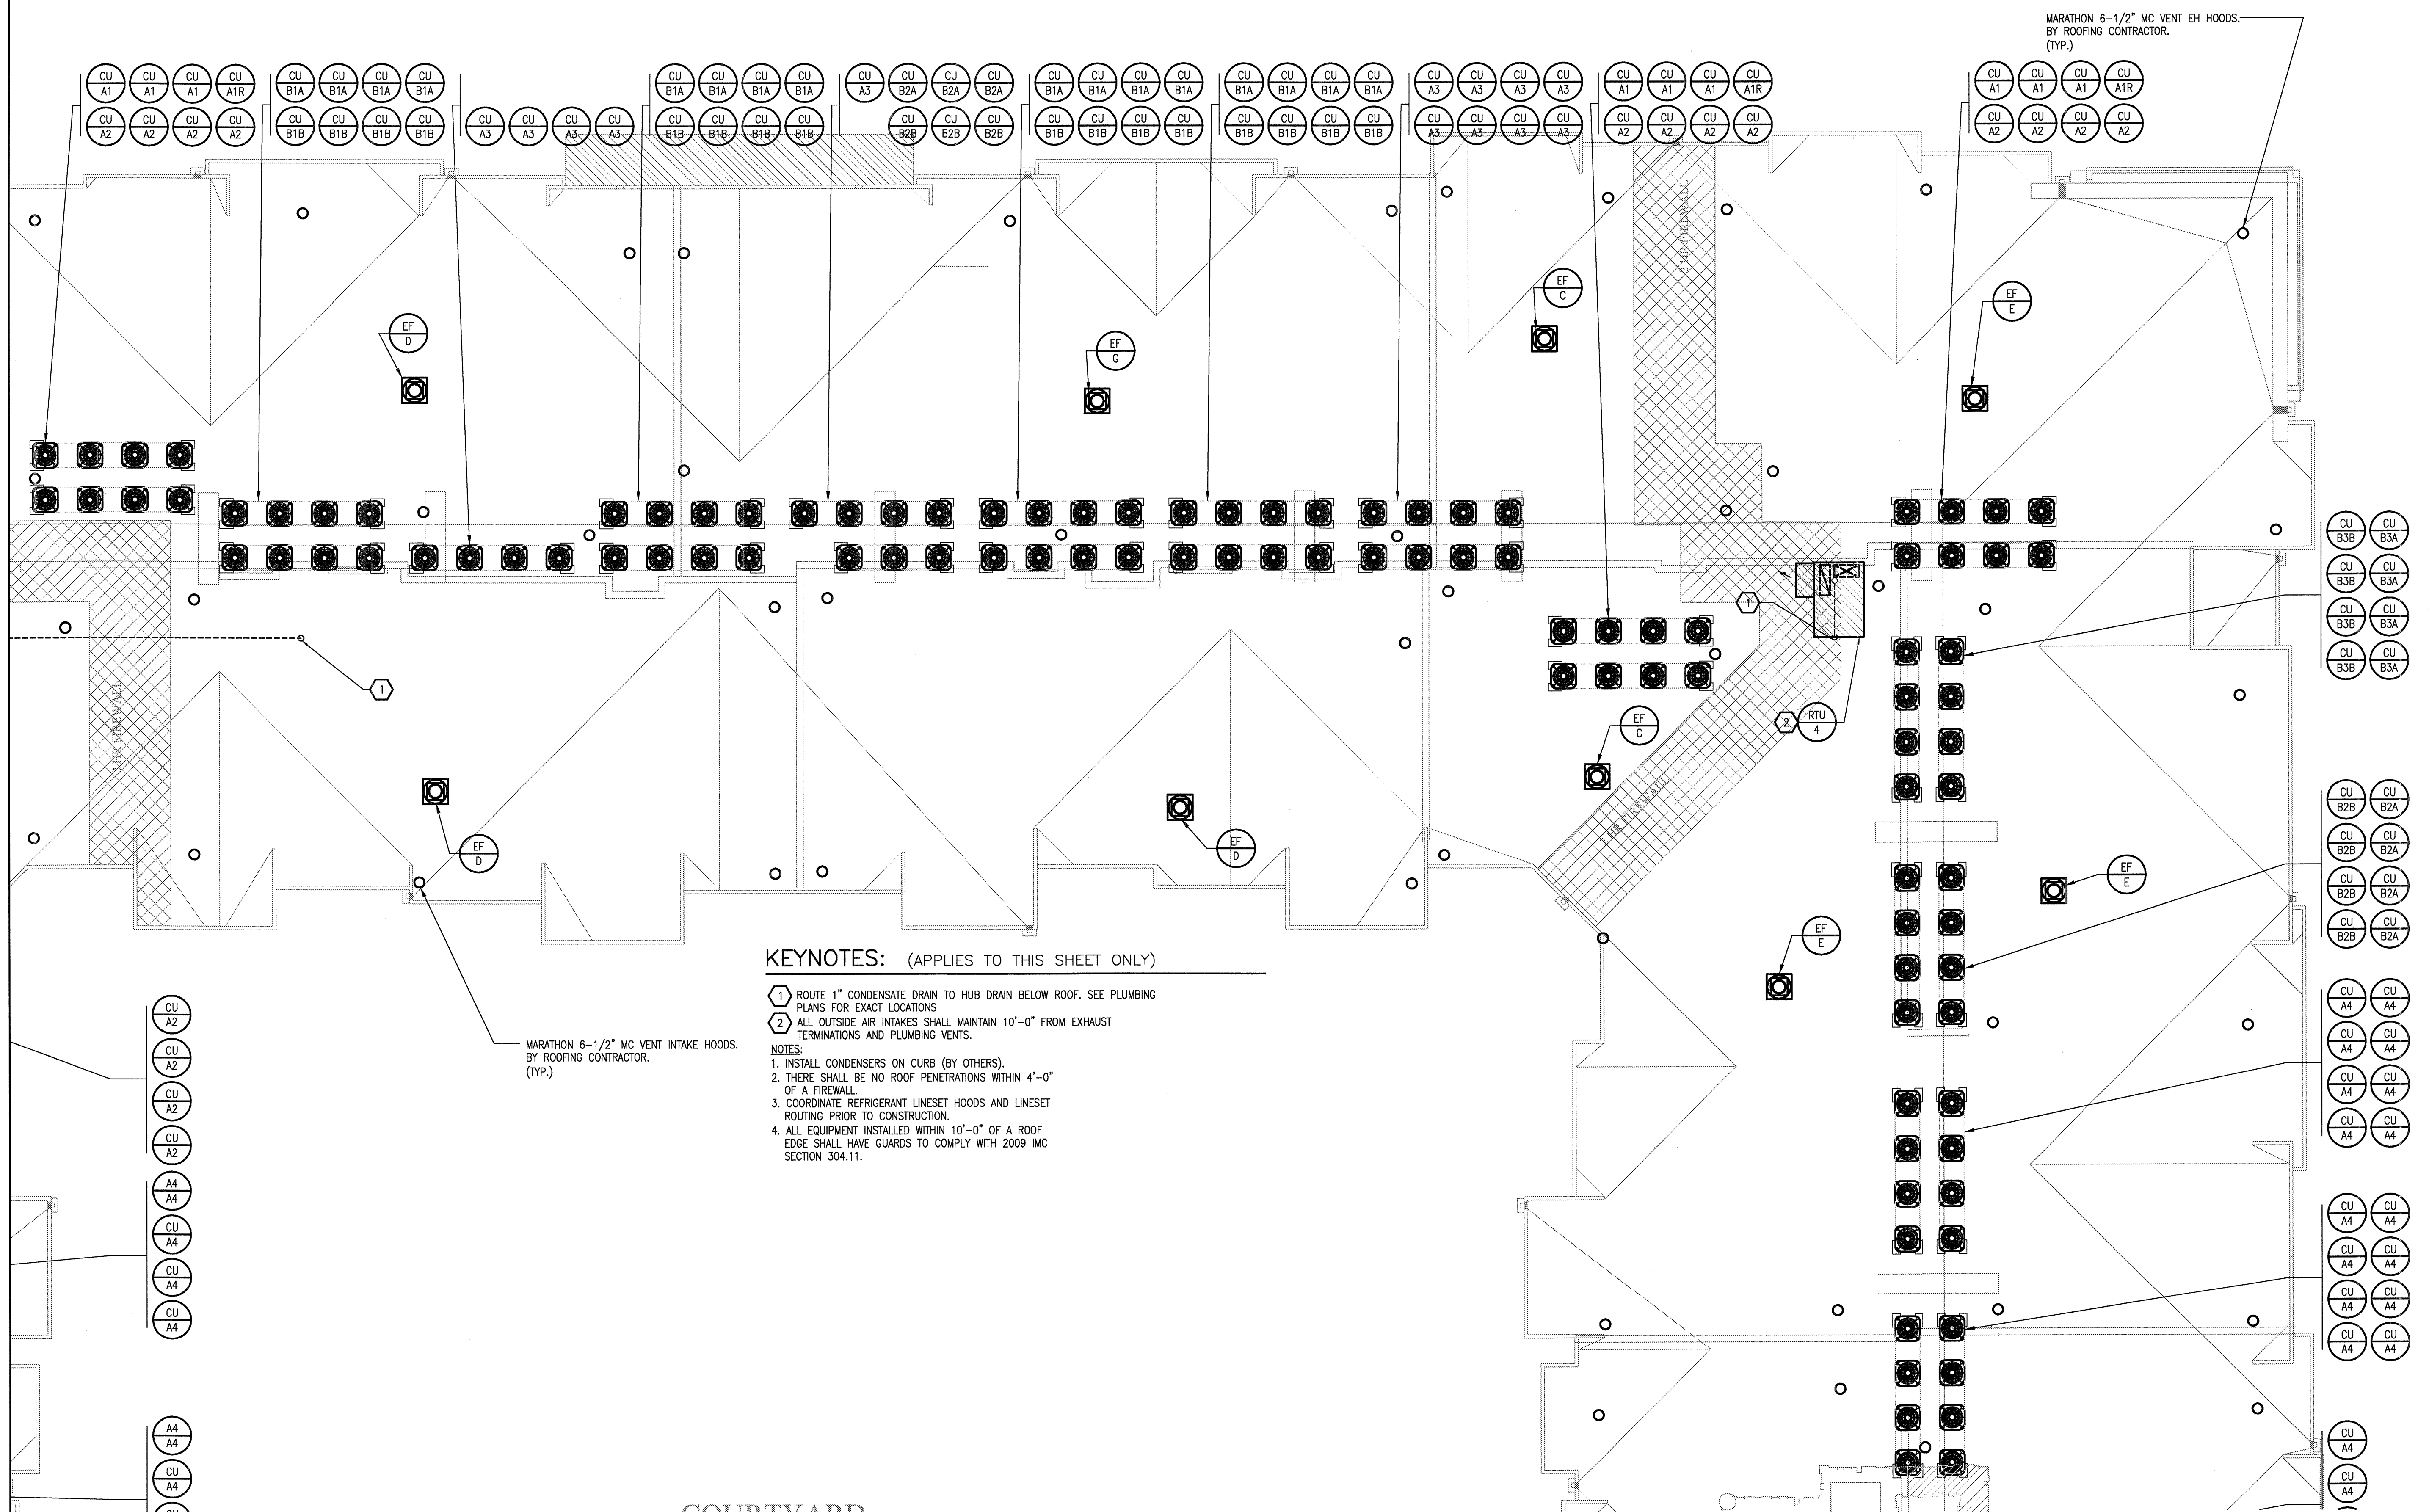

KEYNOTES: (APPLIES TO THIS SHEET ONLY)

- 1 ROUTE 1" CONDENSATE DRAIN TO HUB DRAIN BELOW ROOF. SEE PLUMBING PLANS FOR EXACT LOCATIONS
 - 2 ALL OUTSIDE AIR INTAKES SHALL MAINTAIN 10'-0" FROM EXHAUST TERMINATIONS AND PLUMBING VENTS.
- NOTES:
- 1. INSTALL CONDENSERS ON CURB (BY OTHERS).
 - 2. THERE SHALL BE NO ROOF PENETRATIONS WITHIN 4'-0" OF A FIREWALL.
 - 3. COORDINATE REFRIGERANT LINESET HOODS AND LINESET ROUTING PRIOR TO CONSTRUCTION.
 - 4. ALL EQUIPMENT INSTALLED WITHIN 10'-0" OF A ROOF EDGE SHALL HAVE GUARDS TO COMPLY WITH 2009 IMC SECTION 304.11.

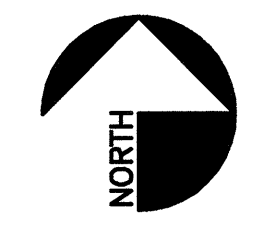

1 DIVISION 'E' ROOF PLAN
 SCALE: 1/8" = 1'-0"

4