



KEYNOTES: (APPLIES TO THIS SHEET ONLY)


① ROUTE 1" CONDENSATE DRAIN TO HUB DRAIN.

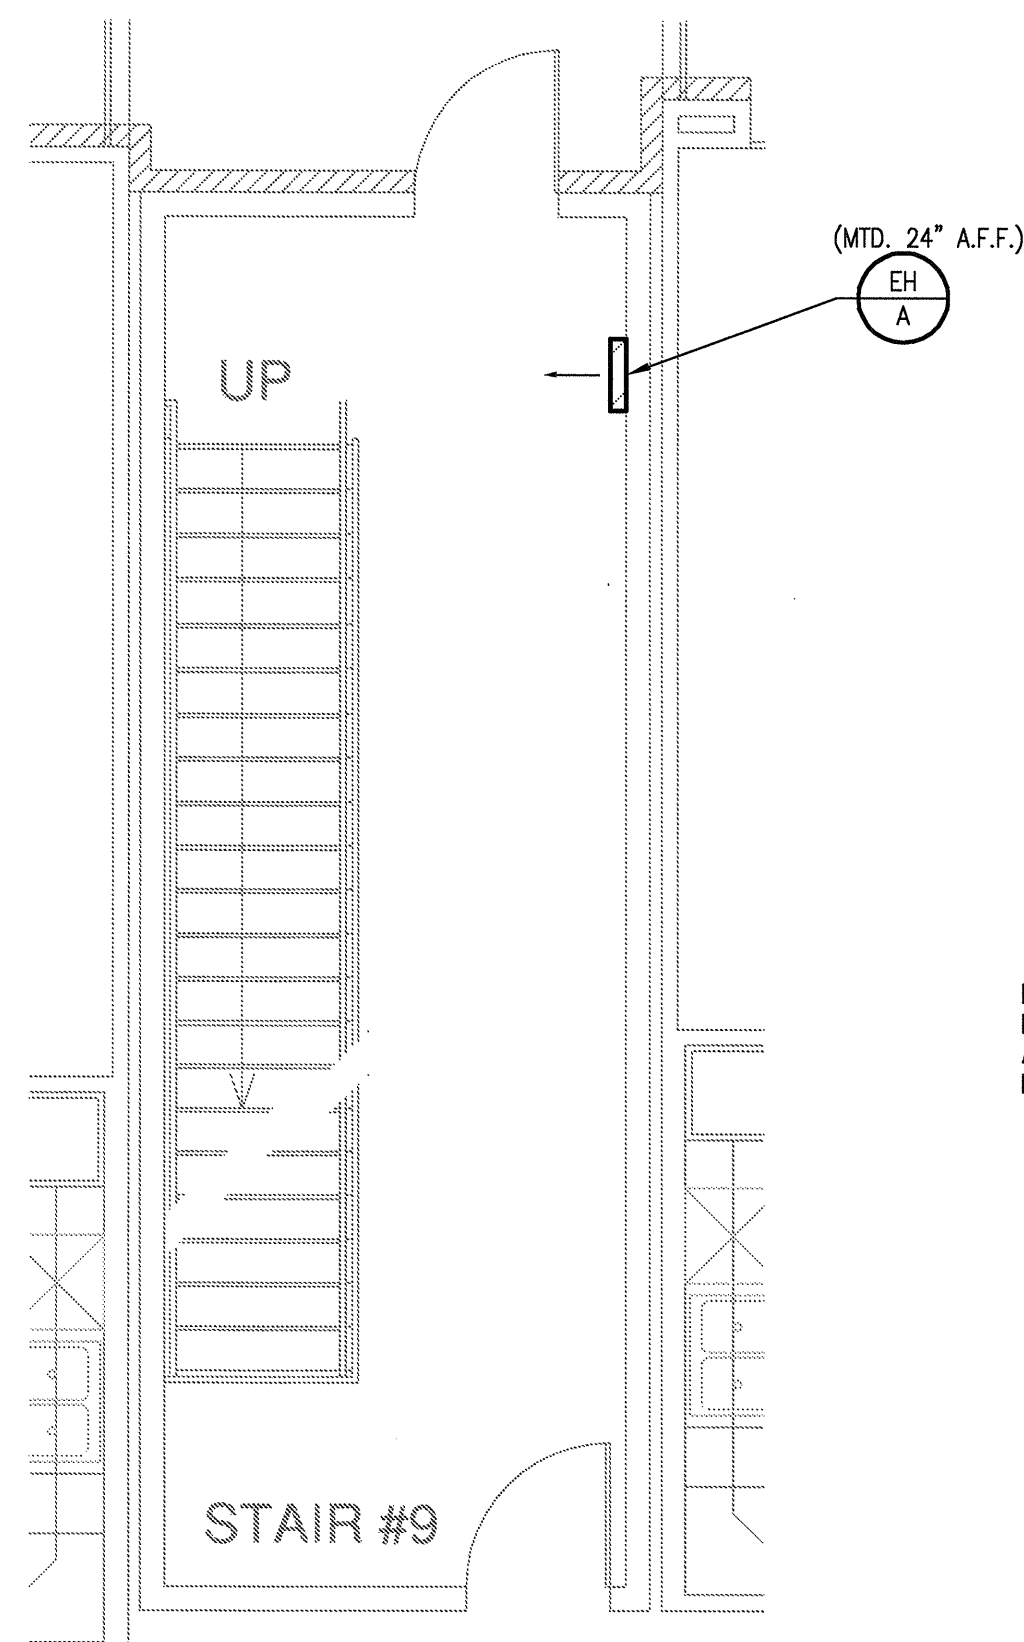


3 STAIRWELL—MECHANICAL  
SCALE: 1/4" = 1'-0"

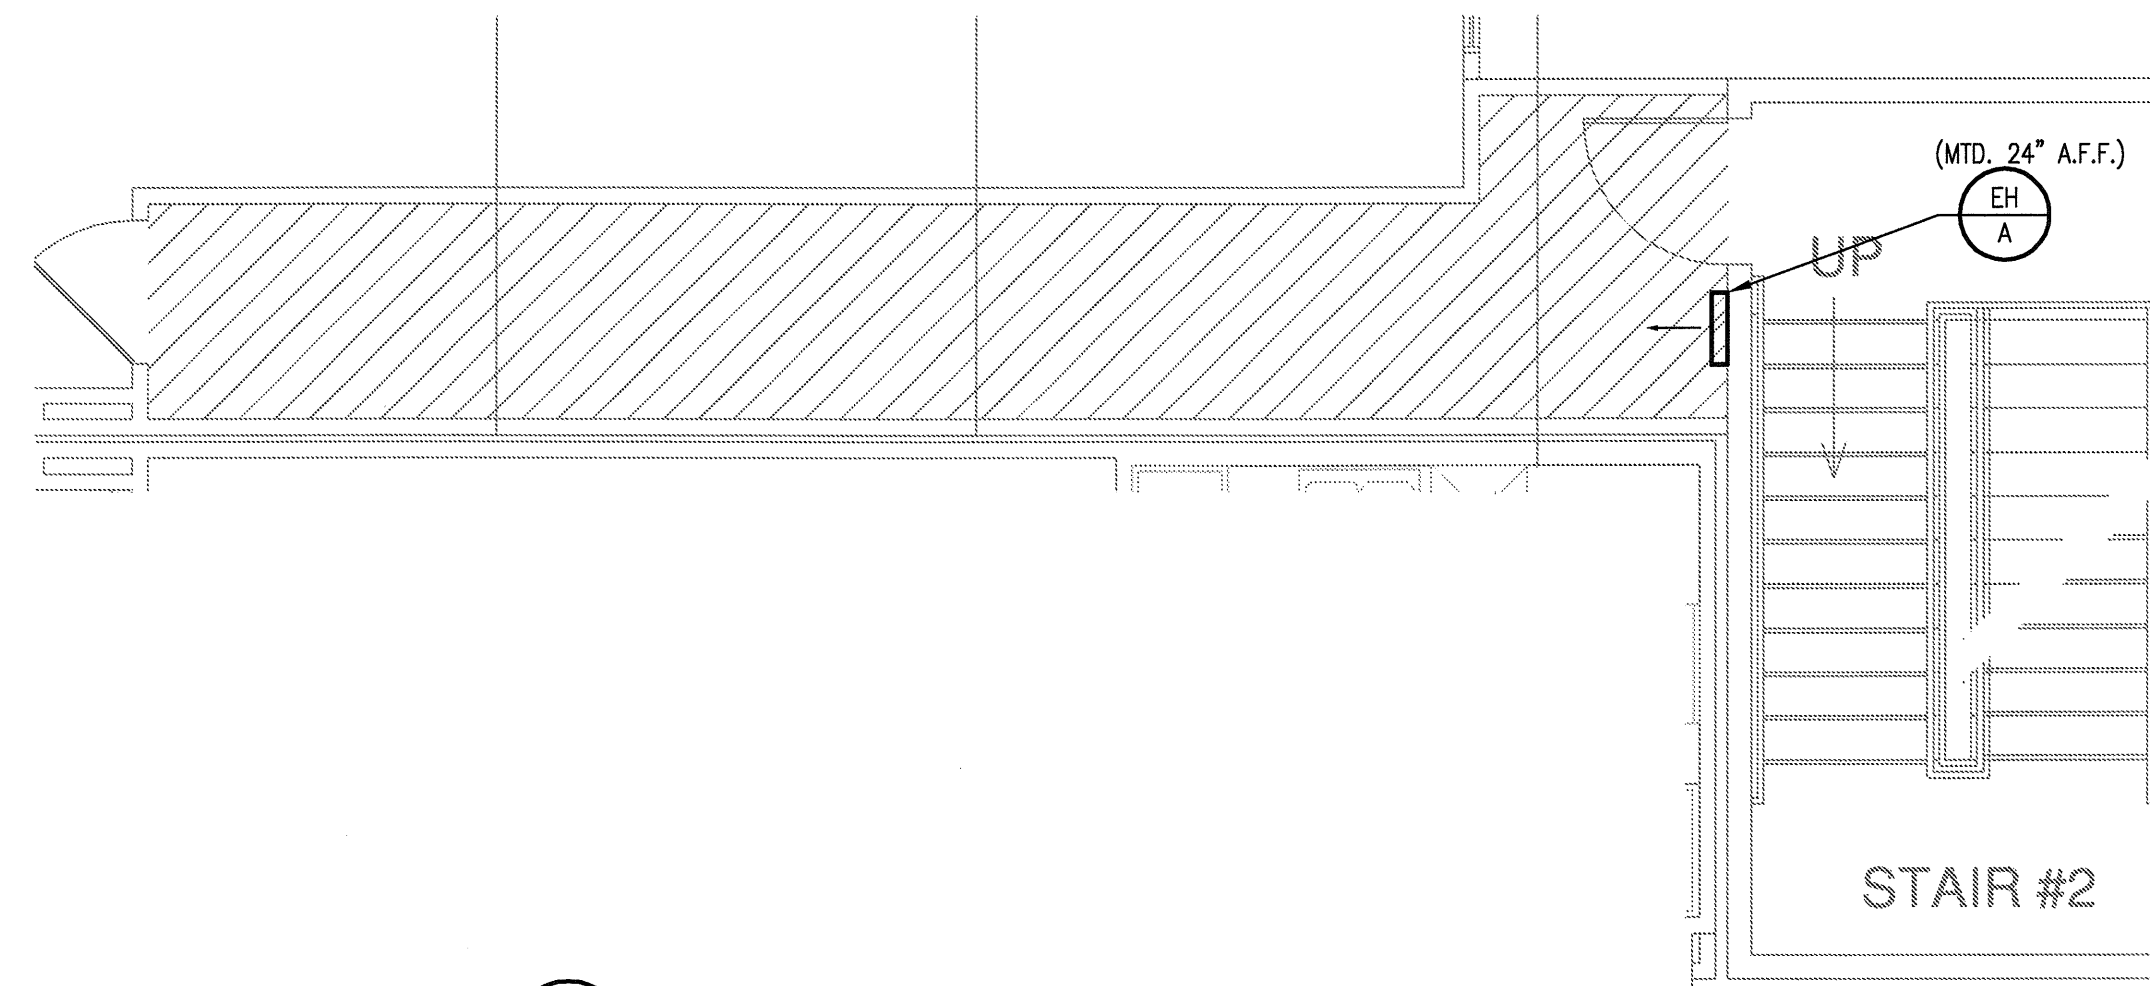


2 STAIRWELL—MECHANICAL  
SCALE: 1/4" = 1'-0"

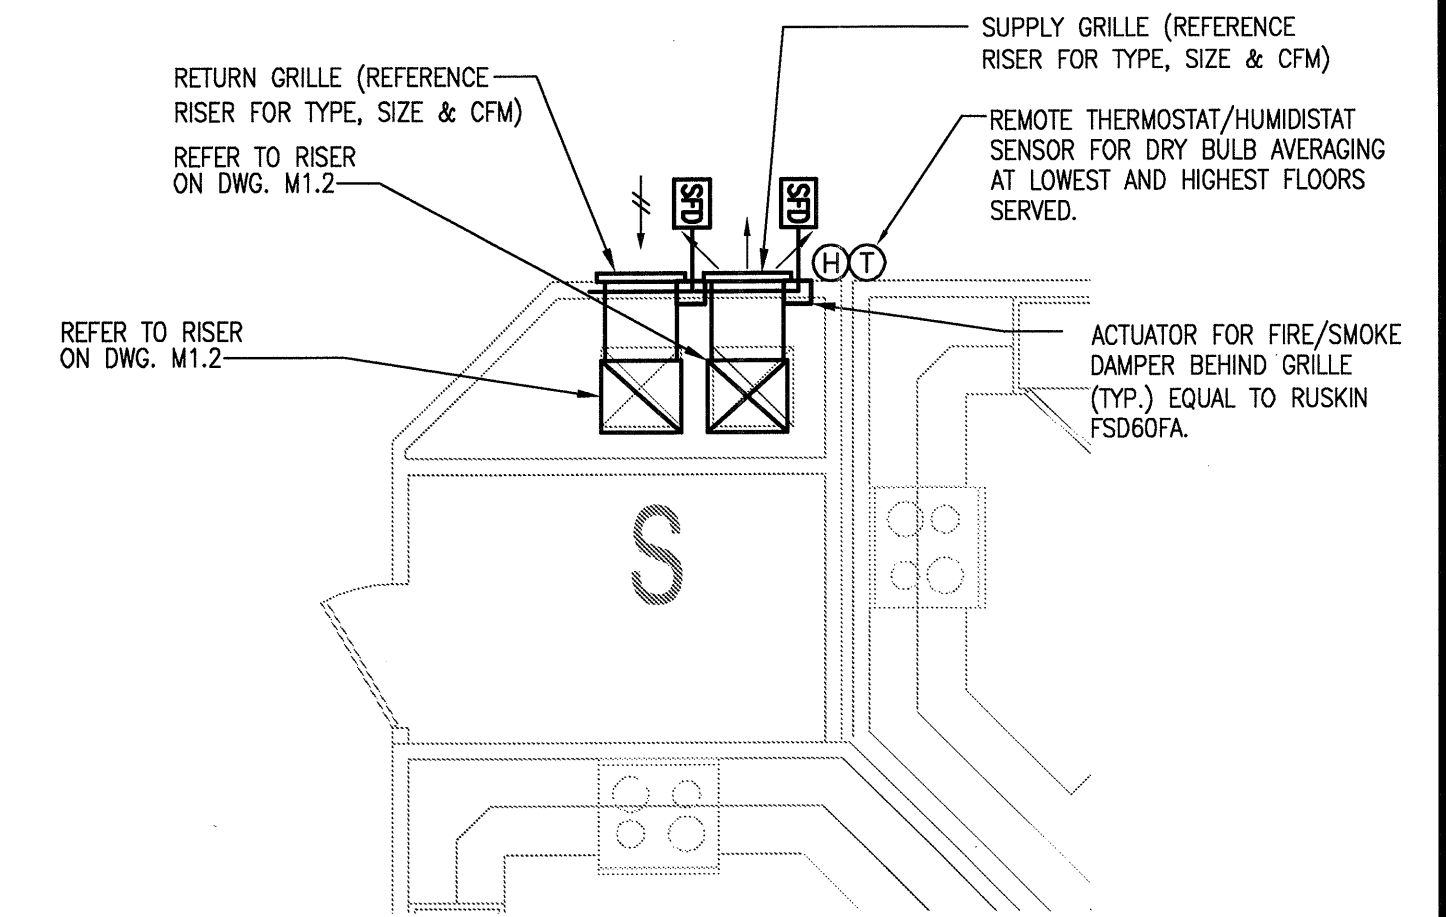


1 CORRIDOR PRESSURIZATION —MECHANICAL  
SCALE: 1/4" = 1'-0"

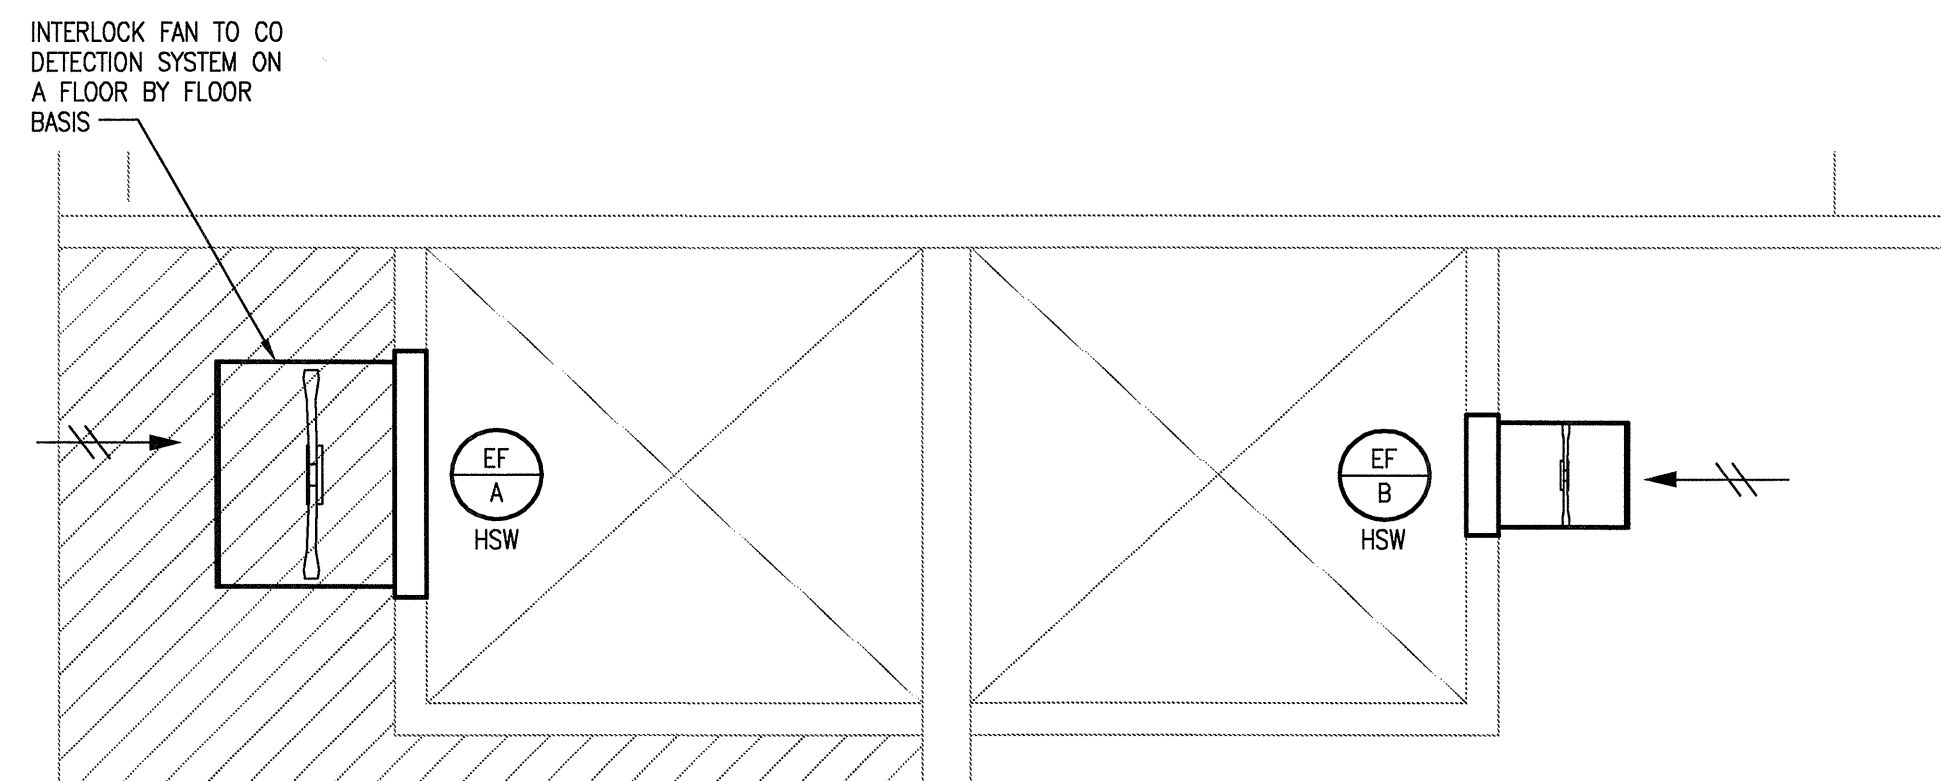


5 GARAGE VENTING—MECHANICAL  
SCALE: 1/4" = 1'-0" 2nd, 4th, 6th FLOORS

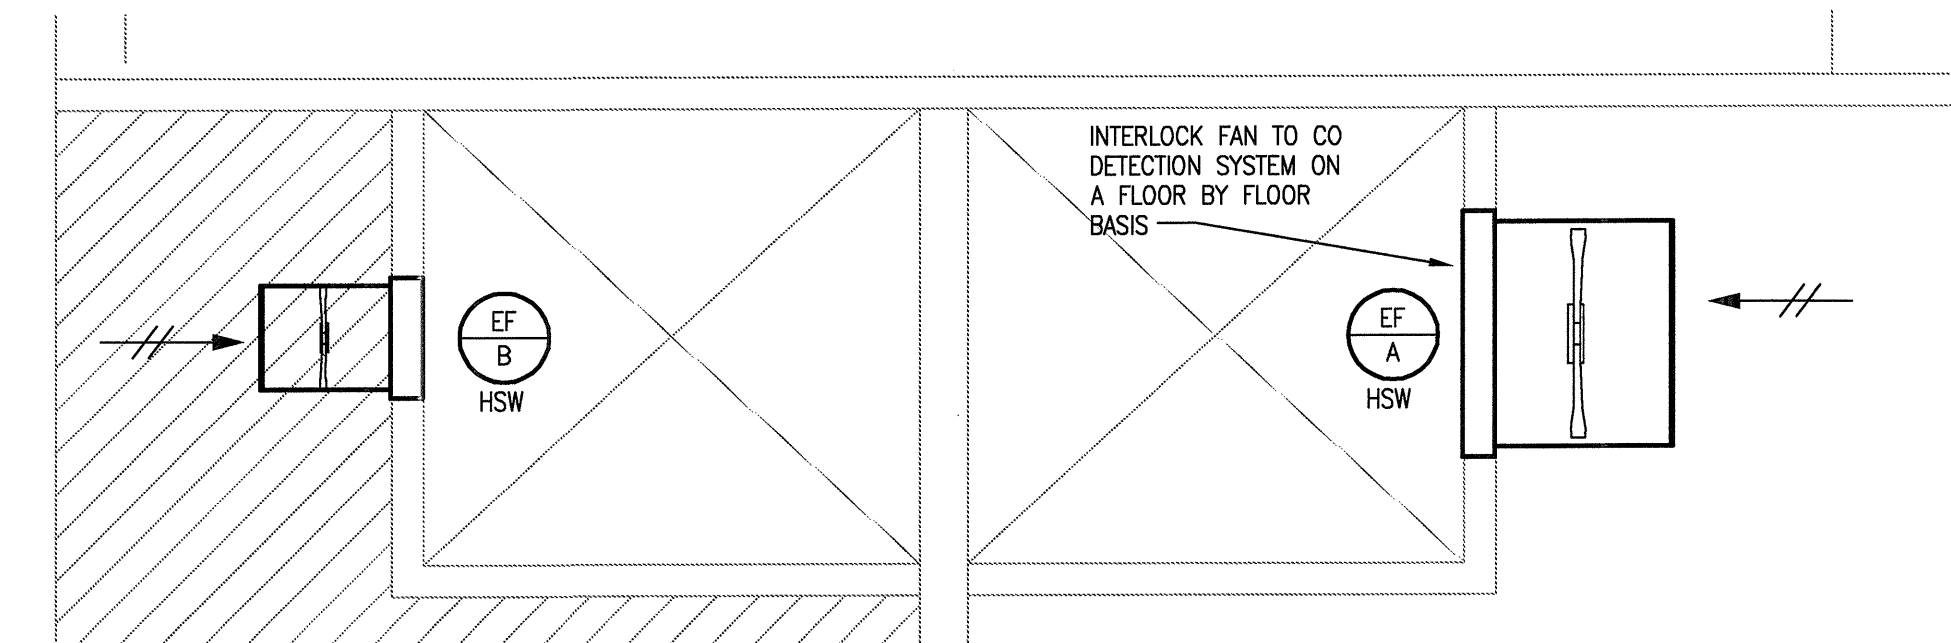


4 GARAGE VENTING—MECHANICAL  
SCALE: 1/4" = 1'-0" 1st, 3rd, 5th FLOORS

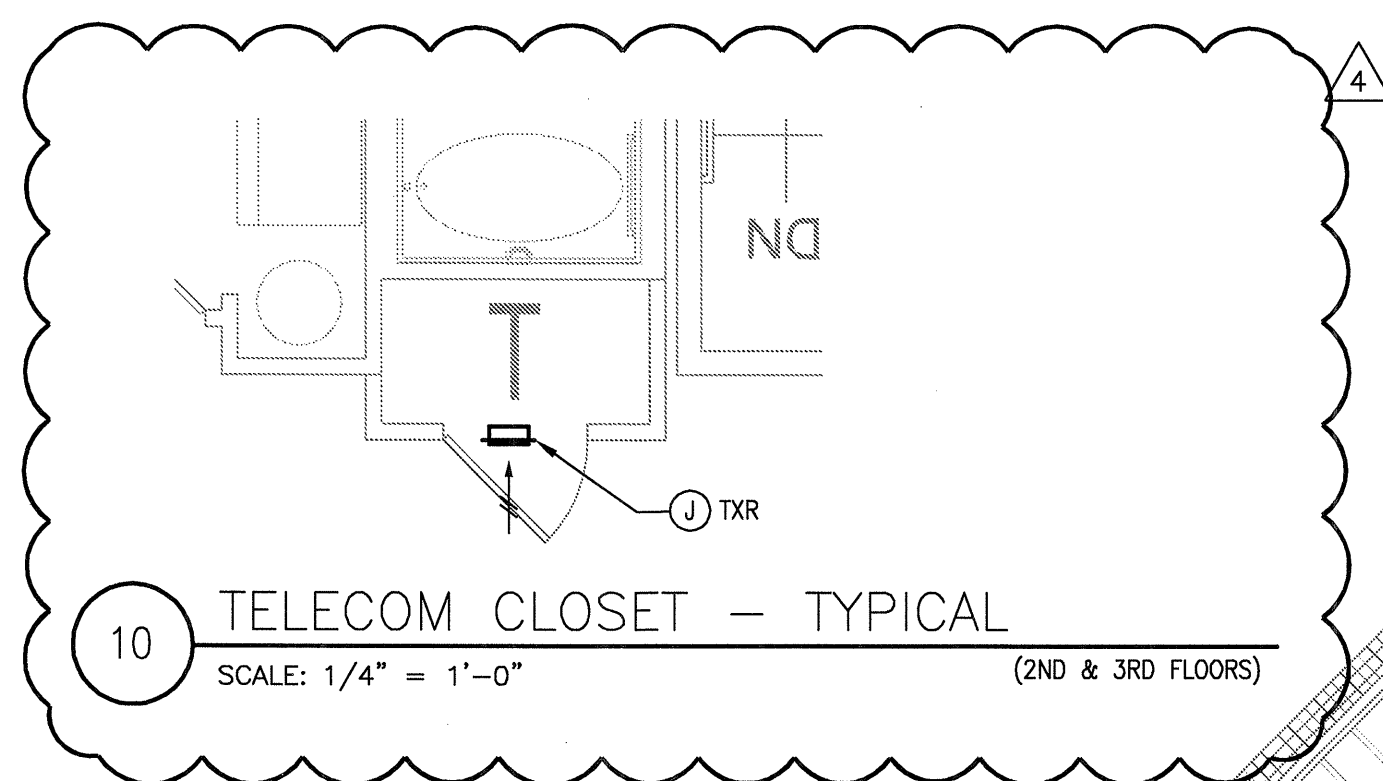


10 TELECOM CLOSET — TYPICAL  
SCALE: 1/4" = 1'-0" (2ND & 3RD FLOORS)

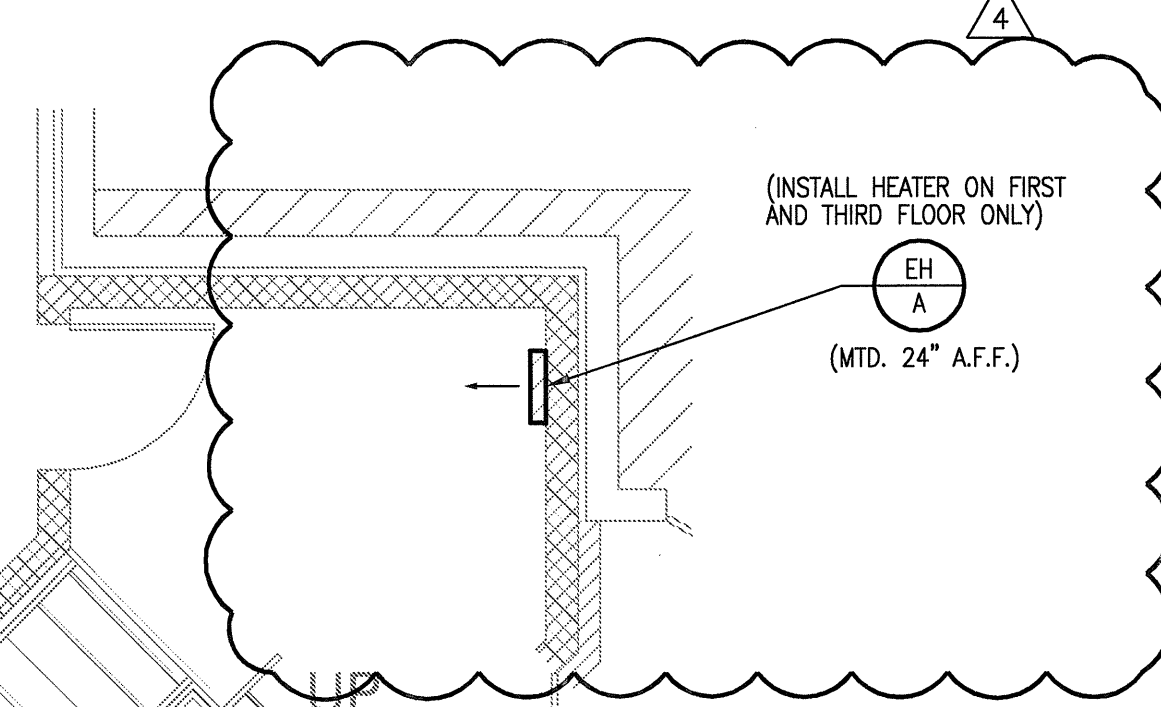


8 STAIRWELL—MECHANICAL  
SCALE: 1/4" = 1'-0"

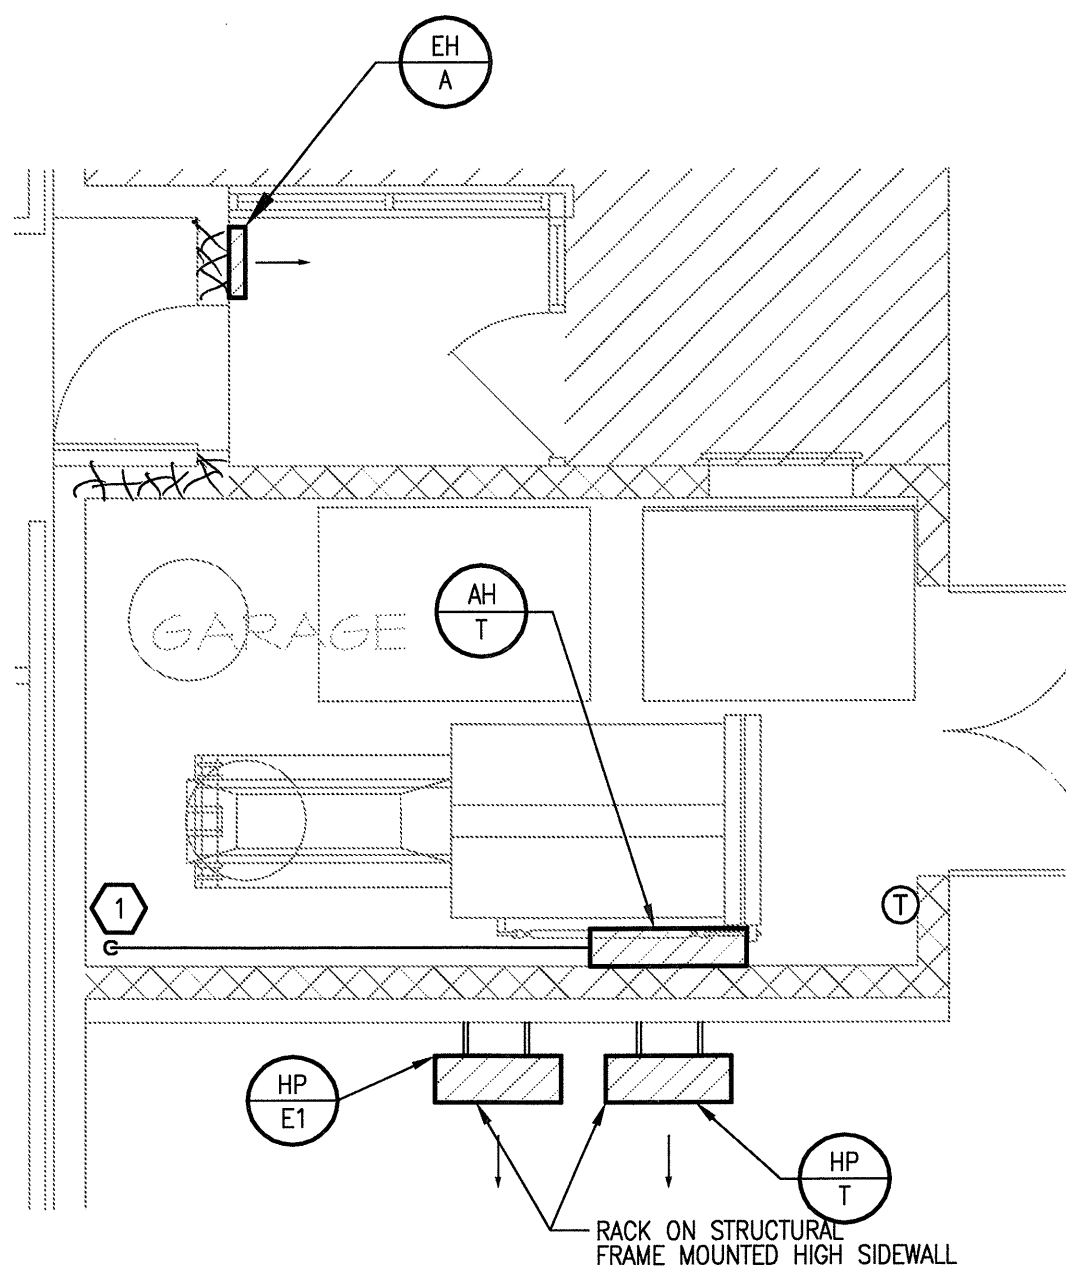

7 TRASH—MECHANICAL  
SCALE: 1/4" = 1'-0" 1st FLOOR

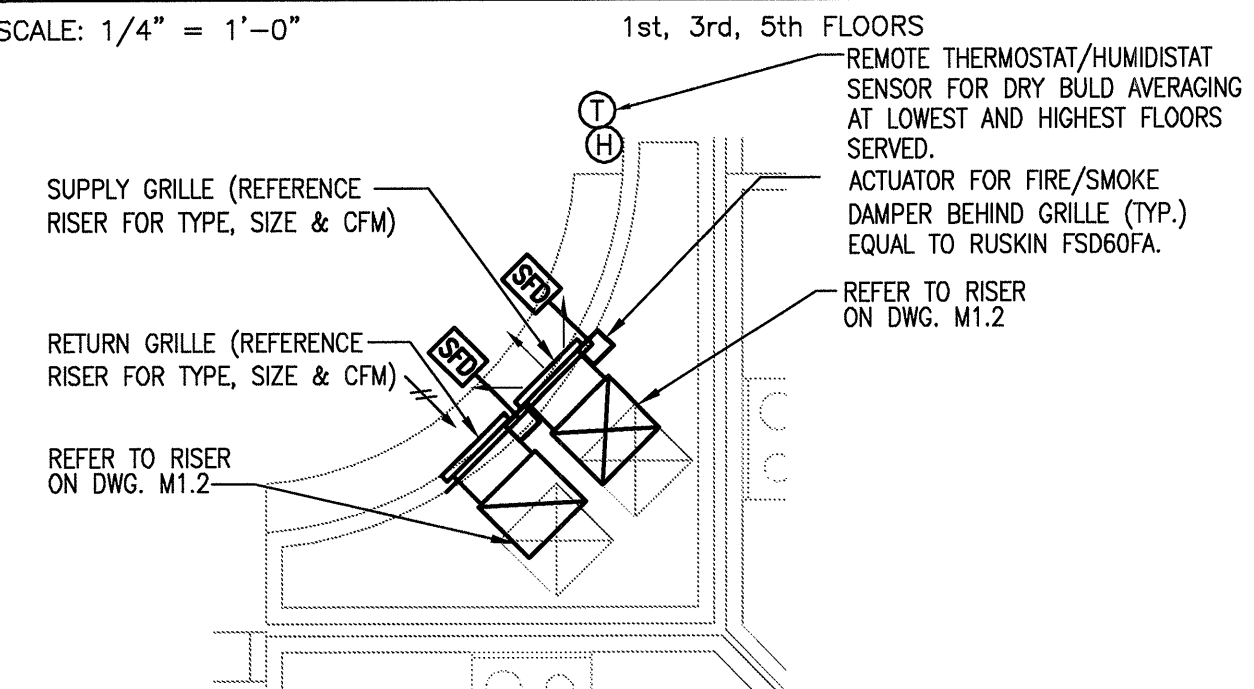

6 CORRIDOR PRESSURIZATION —MECHANICAL  
SCALE: 1/4" = 1'-0"

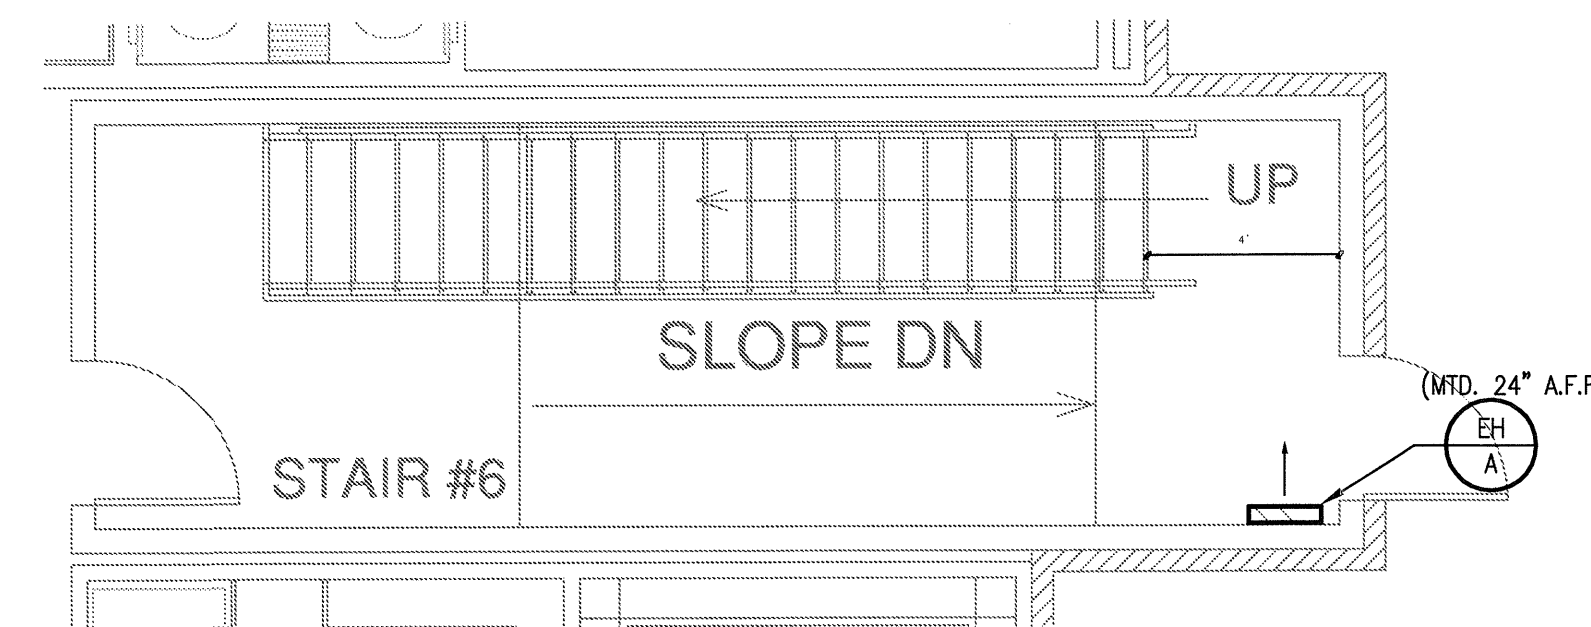

9 STAIRWELL—MECHANICAL  
SCALE: 1/4" = 1'-0"



REVISIONS	
1	9-2-2011 DESIGN REVISIONS
2	9-13-2011 ANSI/FHA COMMENTS
3	9-23-2011 DESIGN REVISIONS
4	10-17-2011 CONSTRUCTION ISSUE

**KELLER SPRINGS LOFTS**  
LOFT APARTMENTS IN ADDISON, TEXAS

**BGO architects**  
4144 N. Central Expy. Suite 855  
Dallas, TX 75204  
214.520.8878  
bgoarchitects.com

DATE  
08-05-11

PROJECT  
11129

SHEET NUMBER

**M-4.1**  
PART PLANS  
MECHANICAL

**JSE** Jordan & Skala Engineers  
14245 Midway Road, Suite 330  
Dallas, TX 75244-5138  
Tel: 469-383-3616 Fax: 469-383-1615  
Project Number - 113-0355 Texas Firm Registration # F-4990  
Drawn By: CHH Checked By: AHS